



Basement

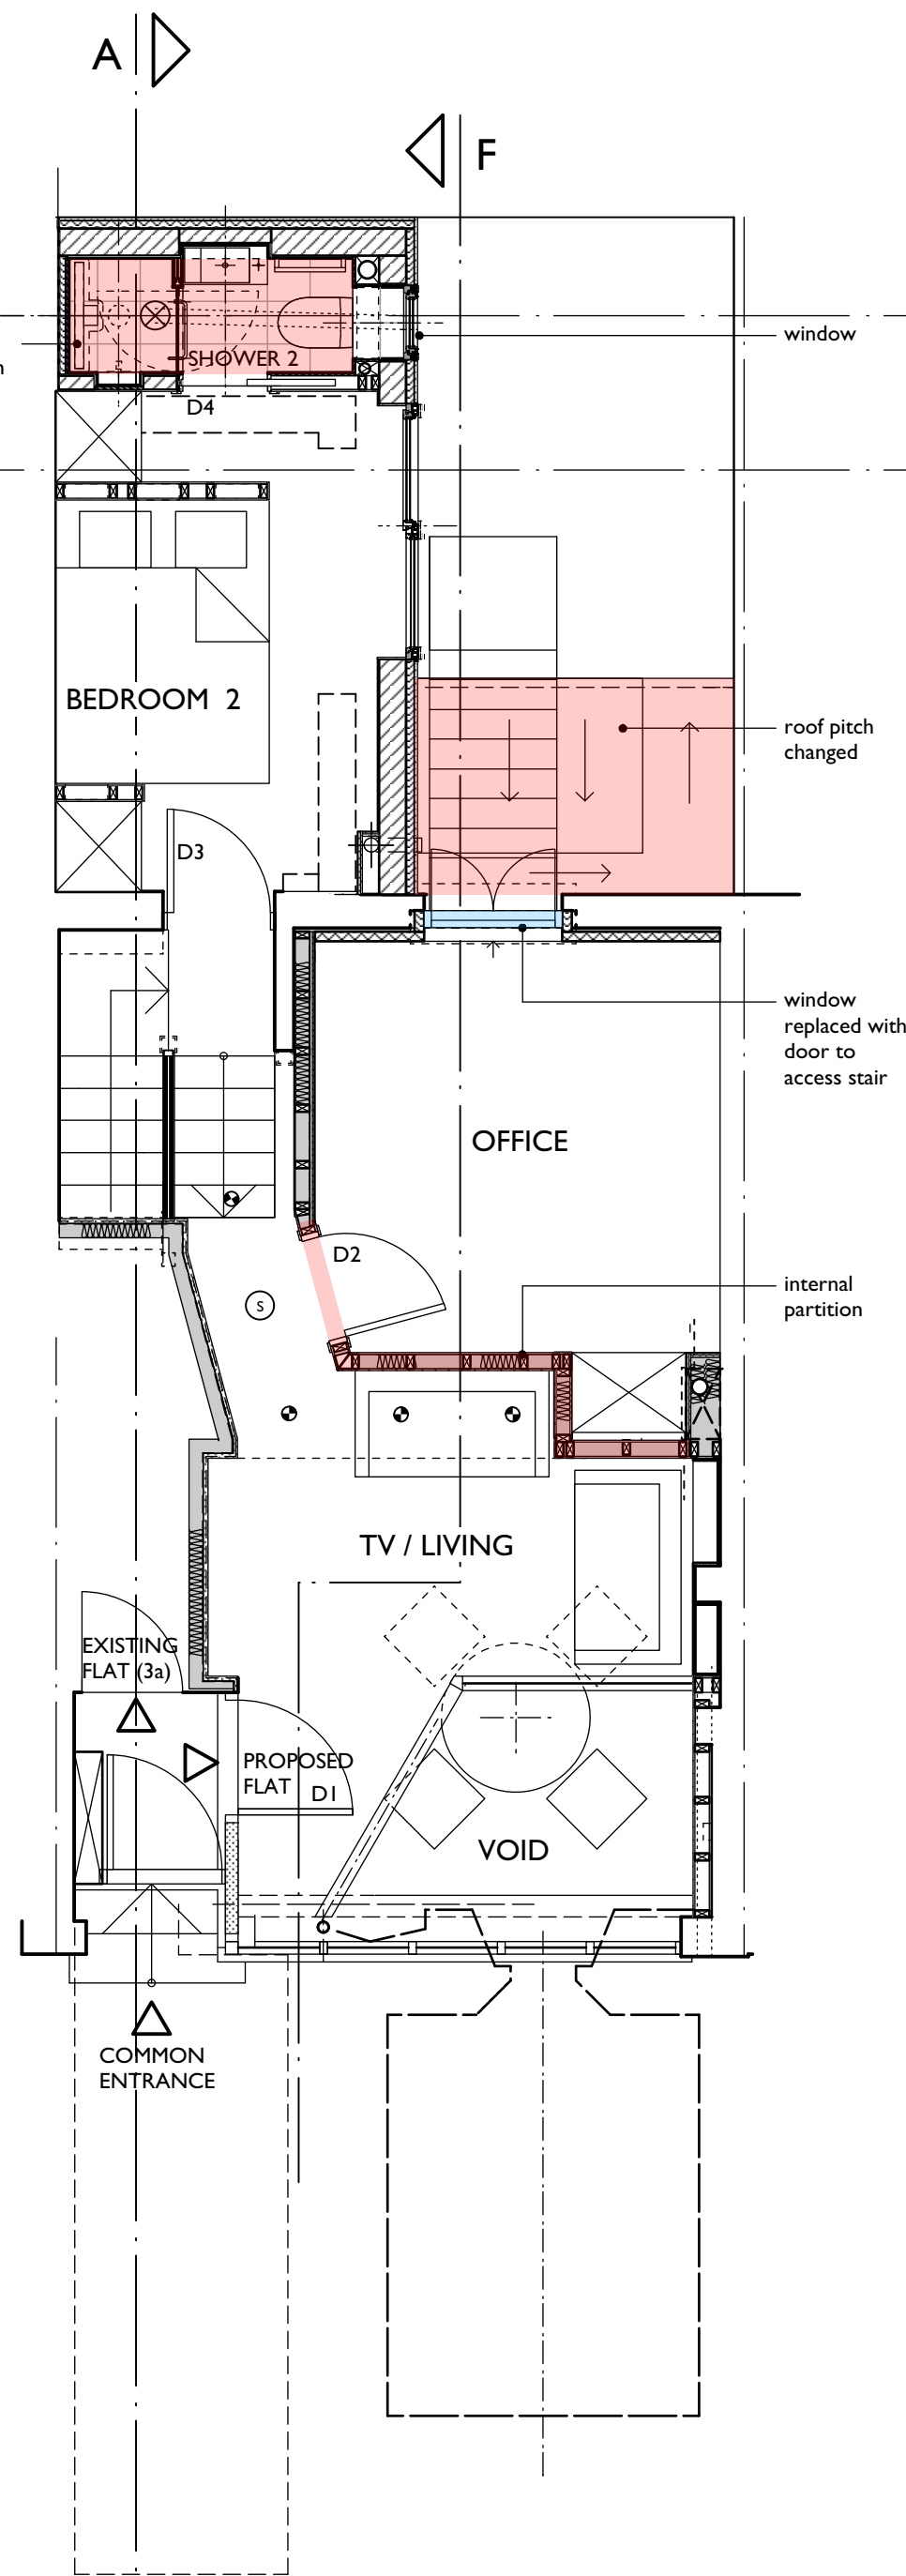

Ground Floor Plan

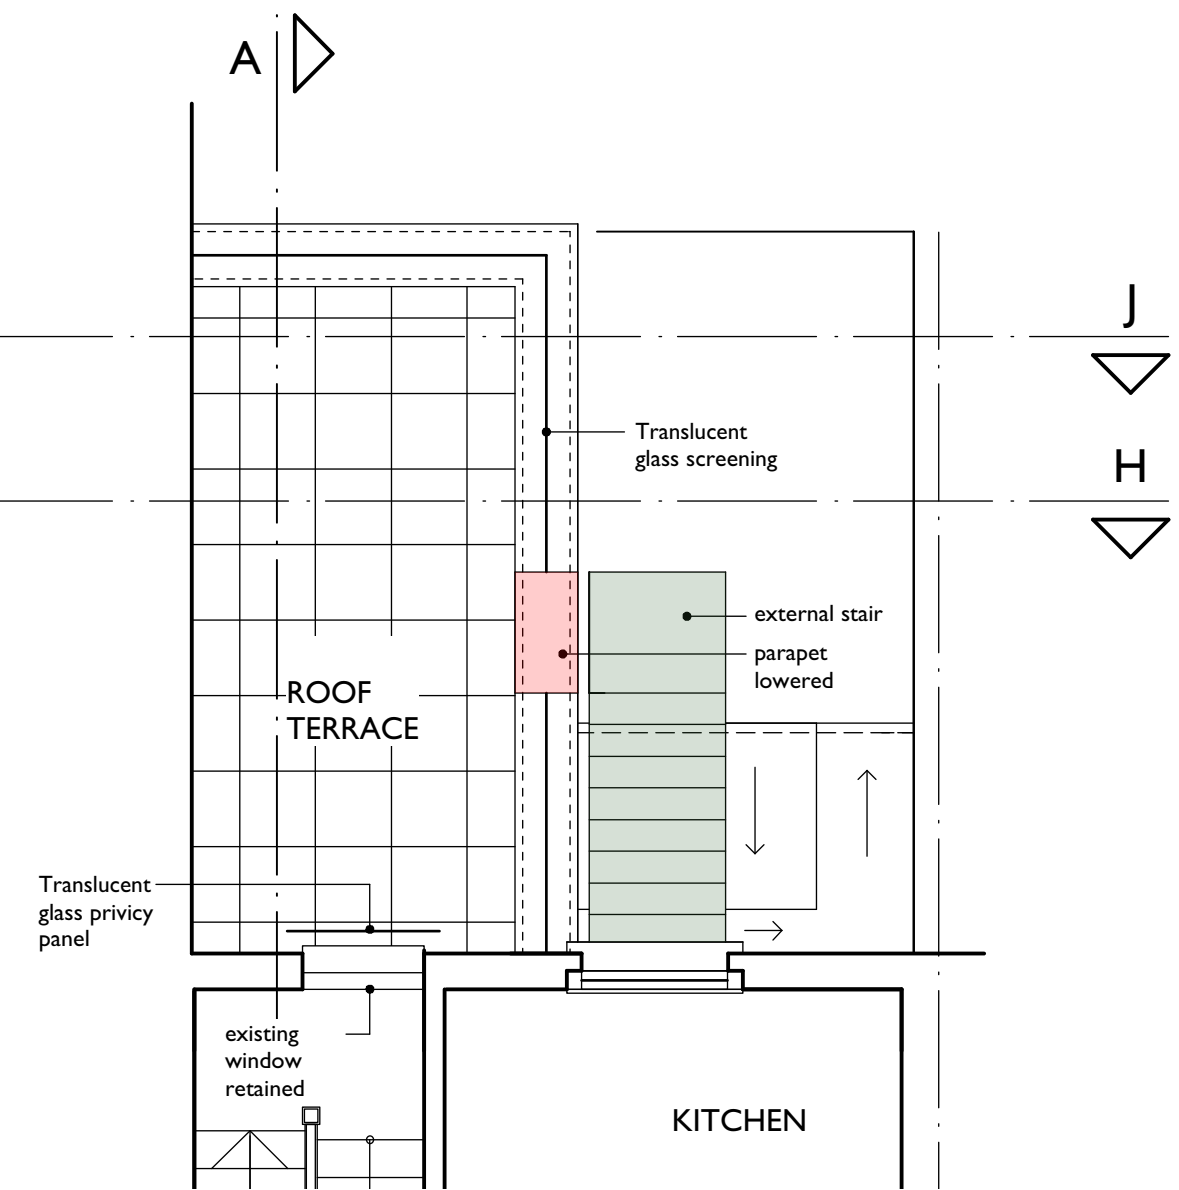


First Floor Plan
(First Floor Flat)



- A - WORK COMPLETED BY 7 May 2013
 - internal plan changes
 - roof pitch change
 - section of parapet lowered
- B - WORK COMPLETED BY 27 February 2014
 - external stairs
- C - WORK COMPLETED BY 21 March 2017
 - doors to external stairs
- D - WORK COMPLETED BY 21 July 2017
 - glass privacy screens
- E - WORK COMPLETED BY 17 October 2017
 - slatted timber privacy screens

ROBERT DEARMAN
ARCHITECT


PROJECT	CLIENT	SCALE	DATE	DRAWN
3 Mansfield Road, London, NW3 2JD	R Dearman	1:50	May 24	RD
DRAWING TITLE	PROJECT NO	/ DRAWING NO / REV		
As Built Floor Plans		37 / B 01		

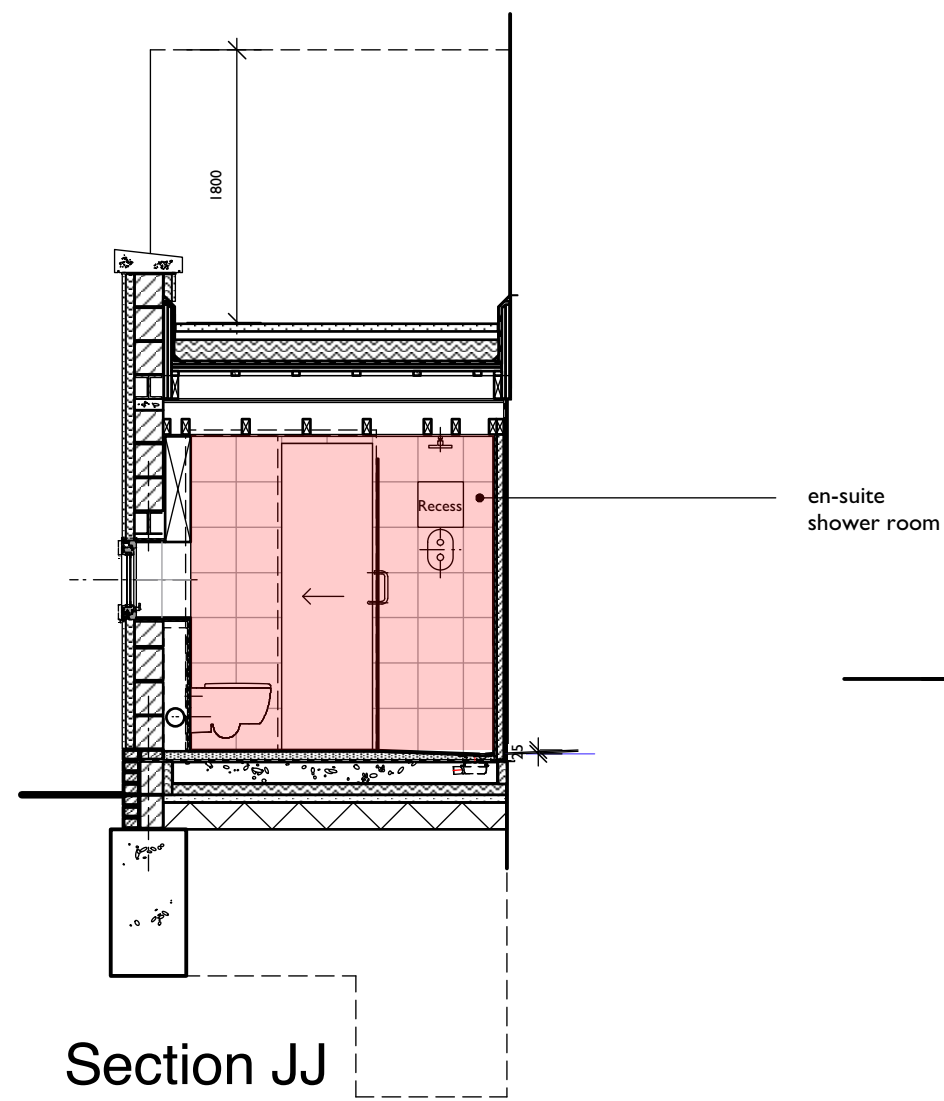

Section FF

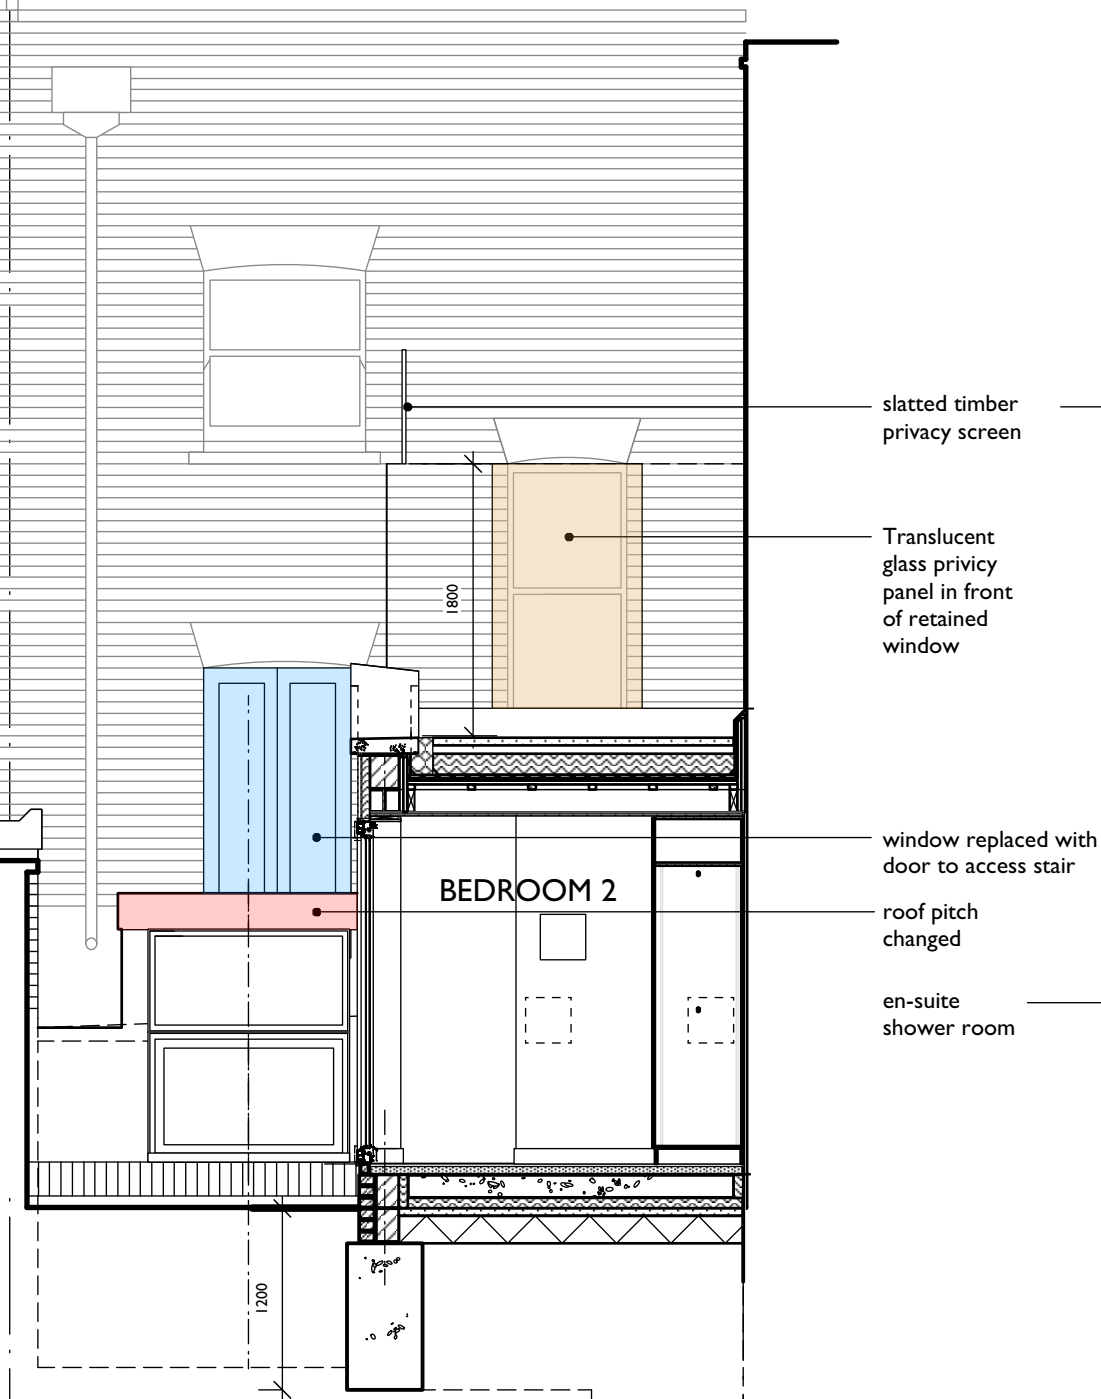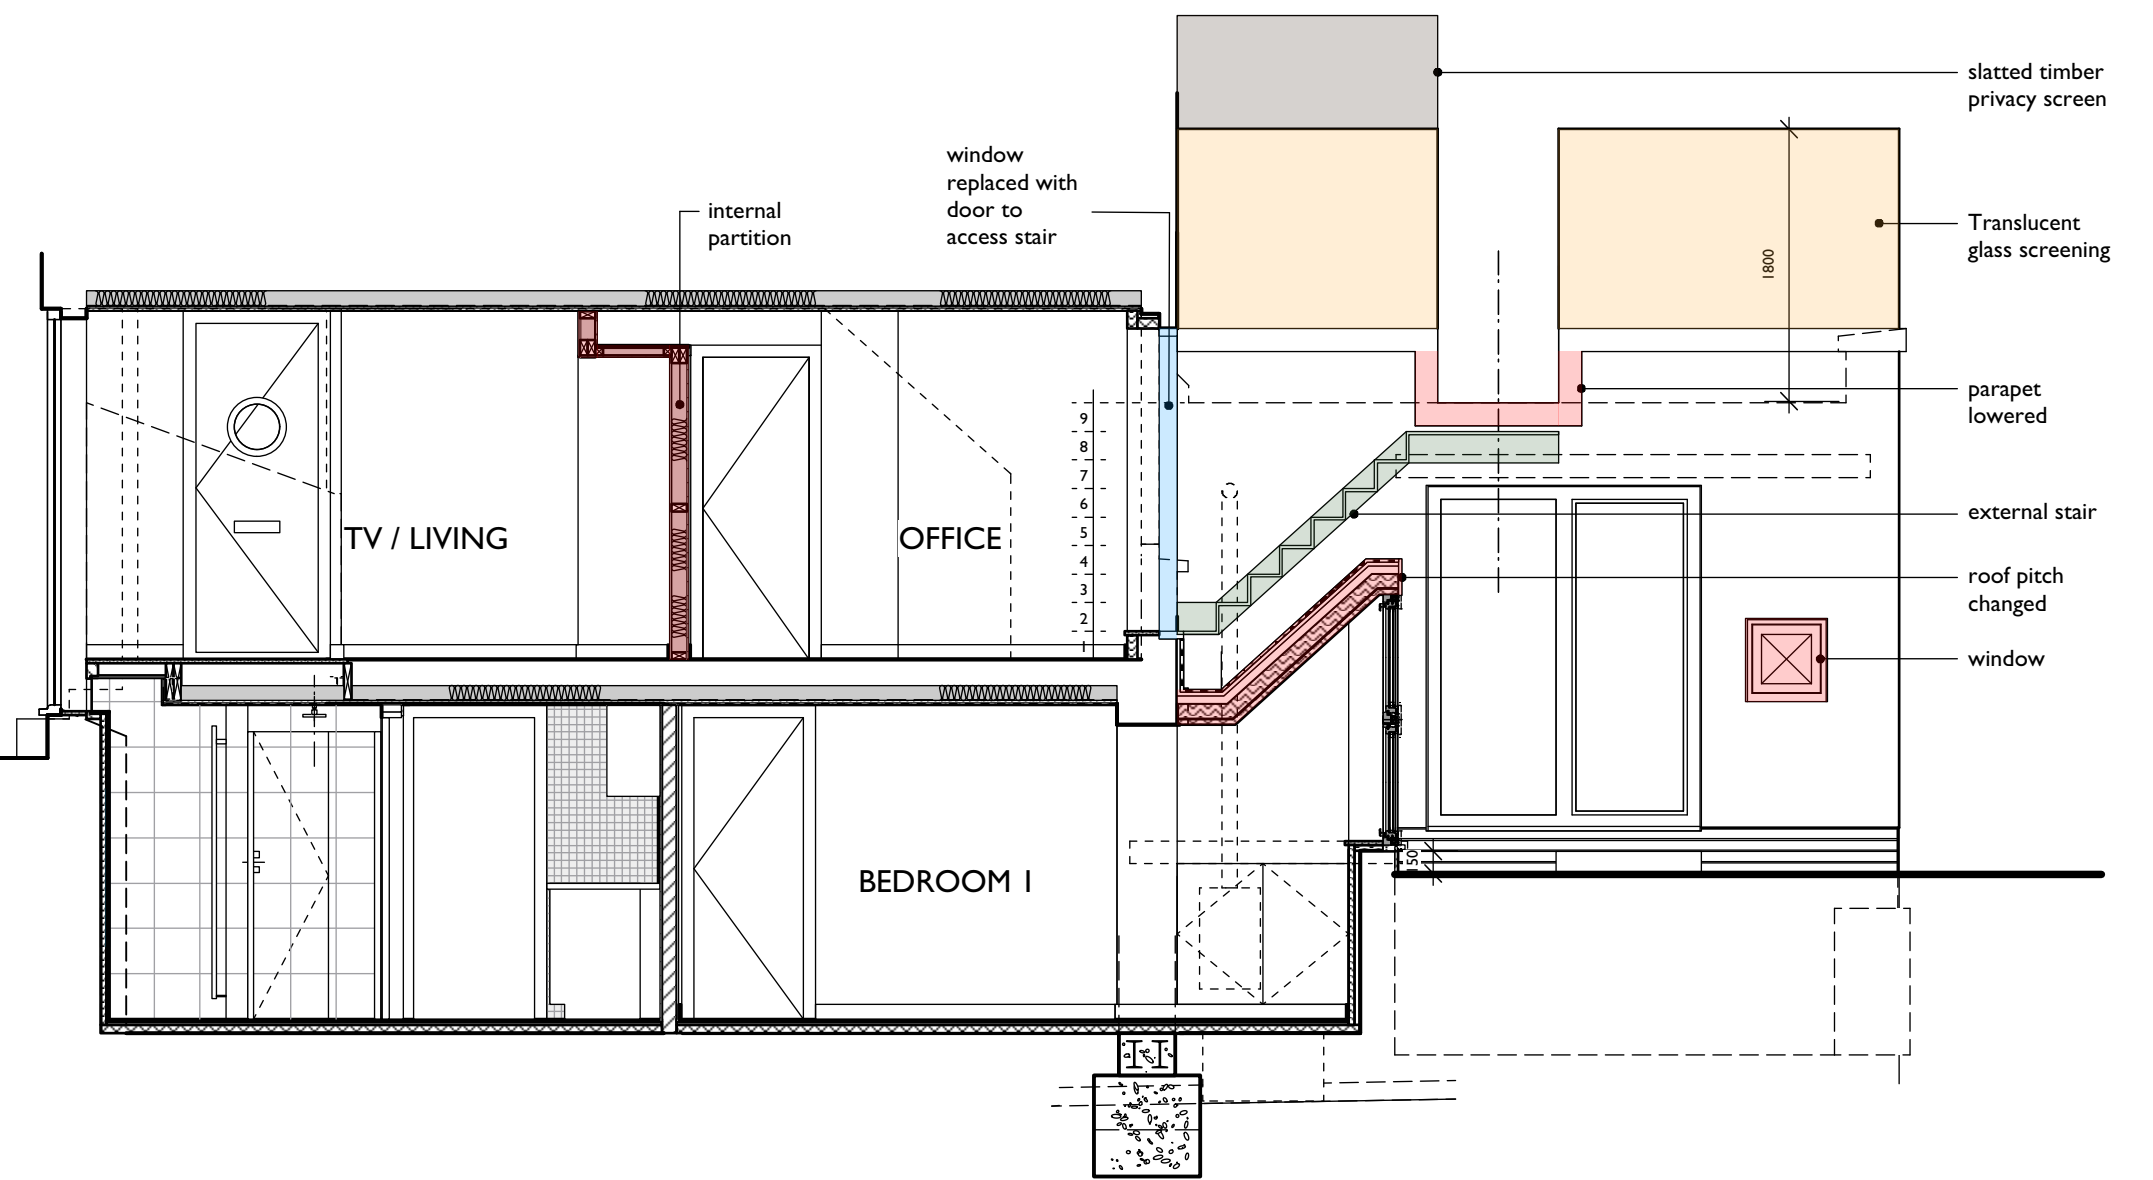

Section AA

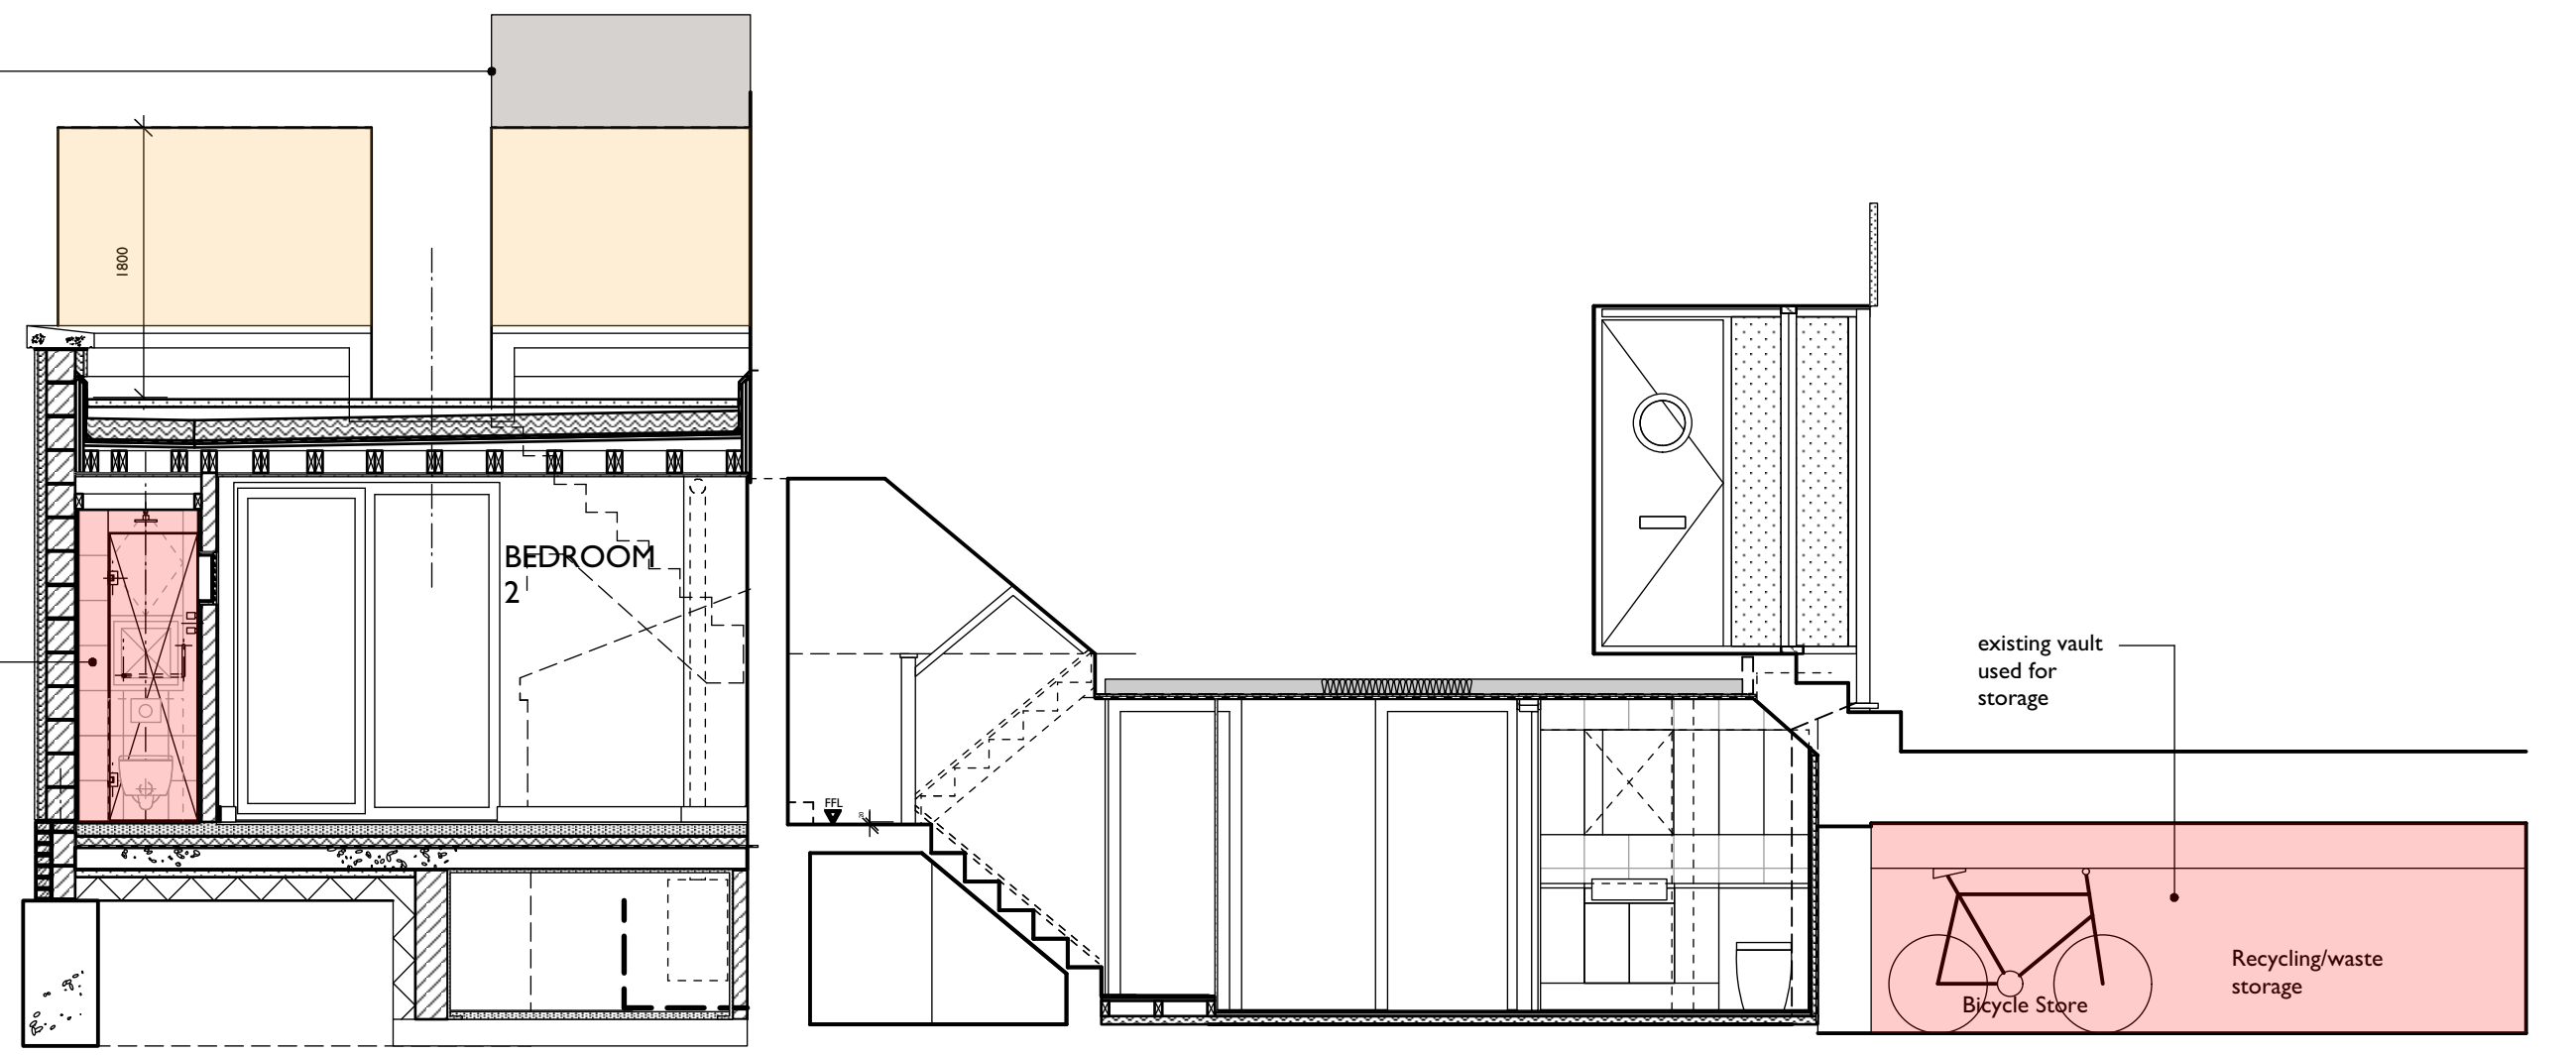

ROBERT DEARMAN
ARCHITECT

PROJECT	CLIENT	SCALE	DATE	DRAWN
3 Mansfield Road, London, NW3 2JD	R Dearman	1:50	May 24	RD
DRAWING TITLE	PROJECT NO	/ DRAWING NO/ REV		
As Built Elevations, Sections AA, FF, HH & JJ		37 / B 02		