


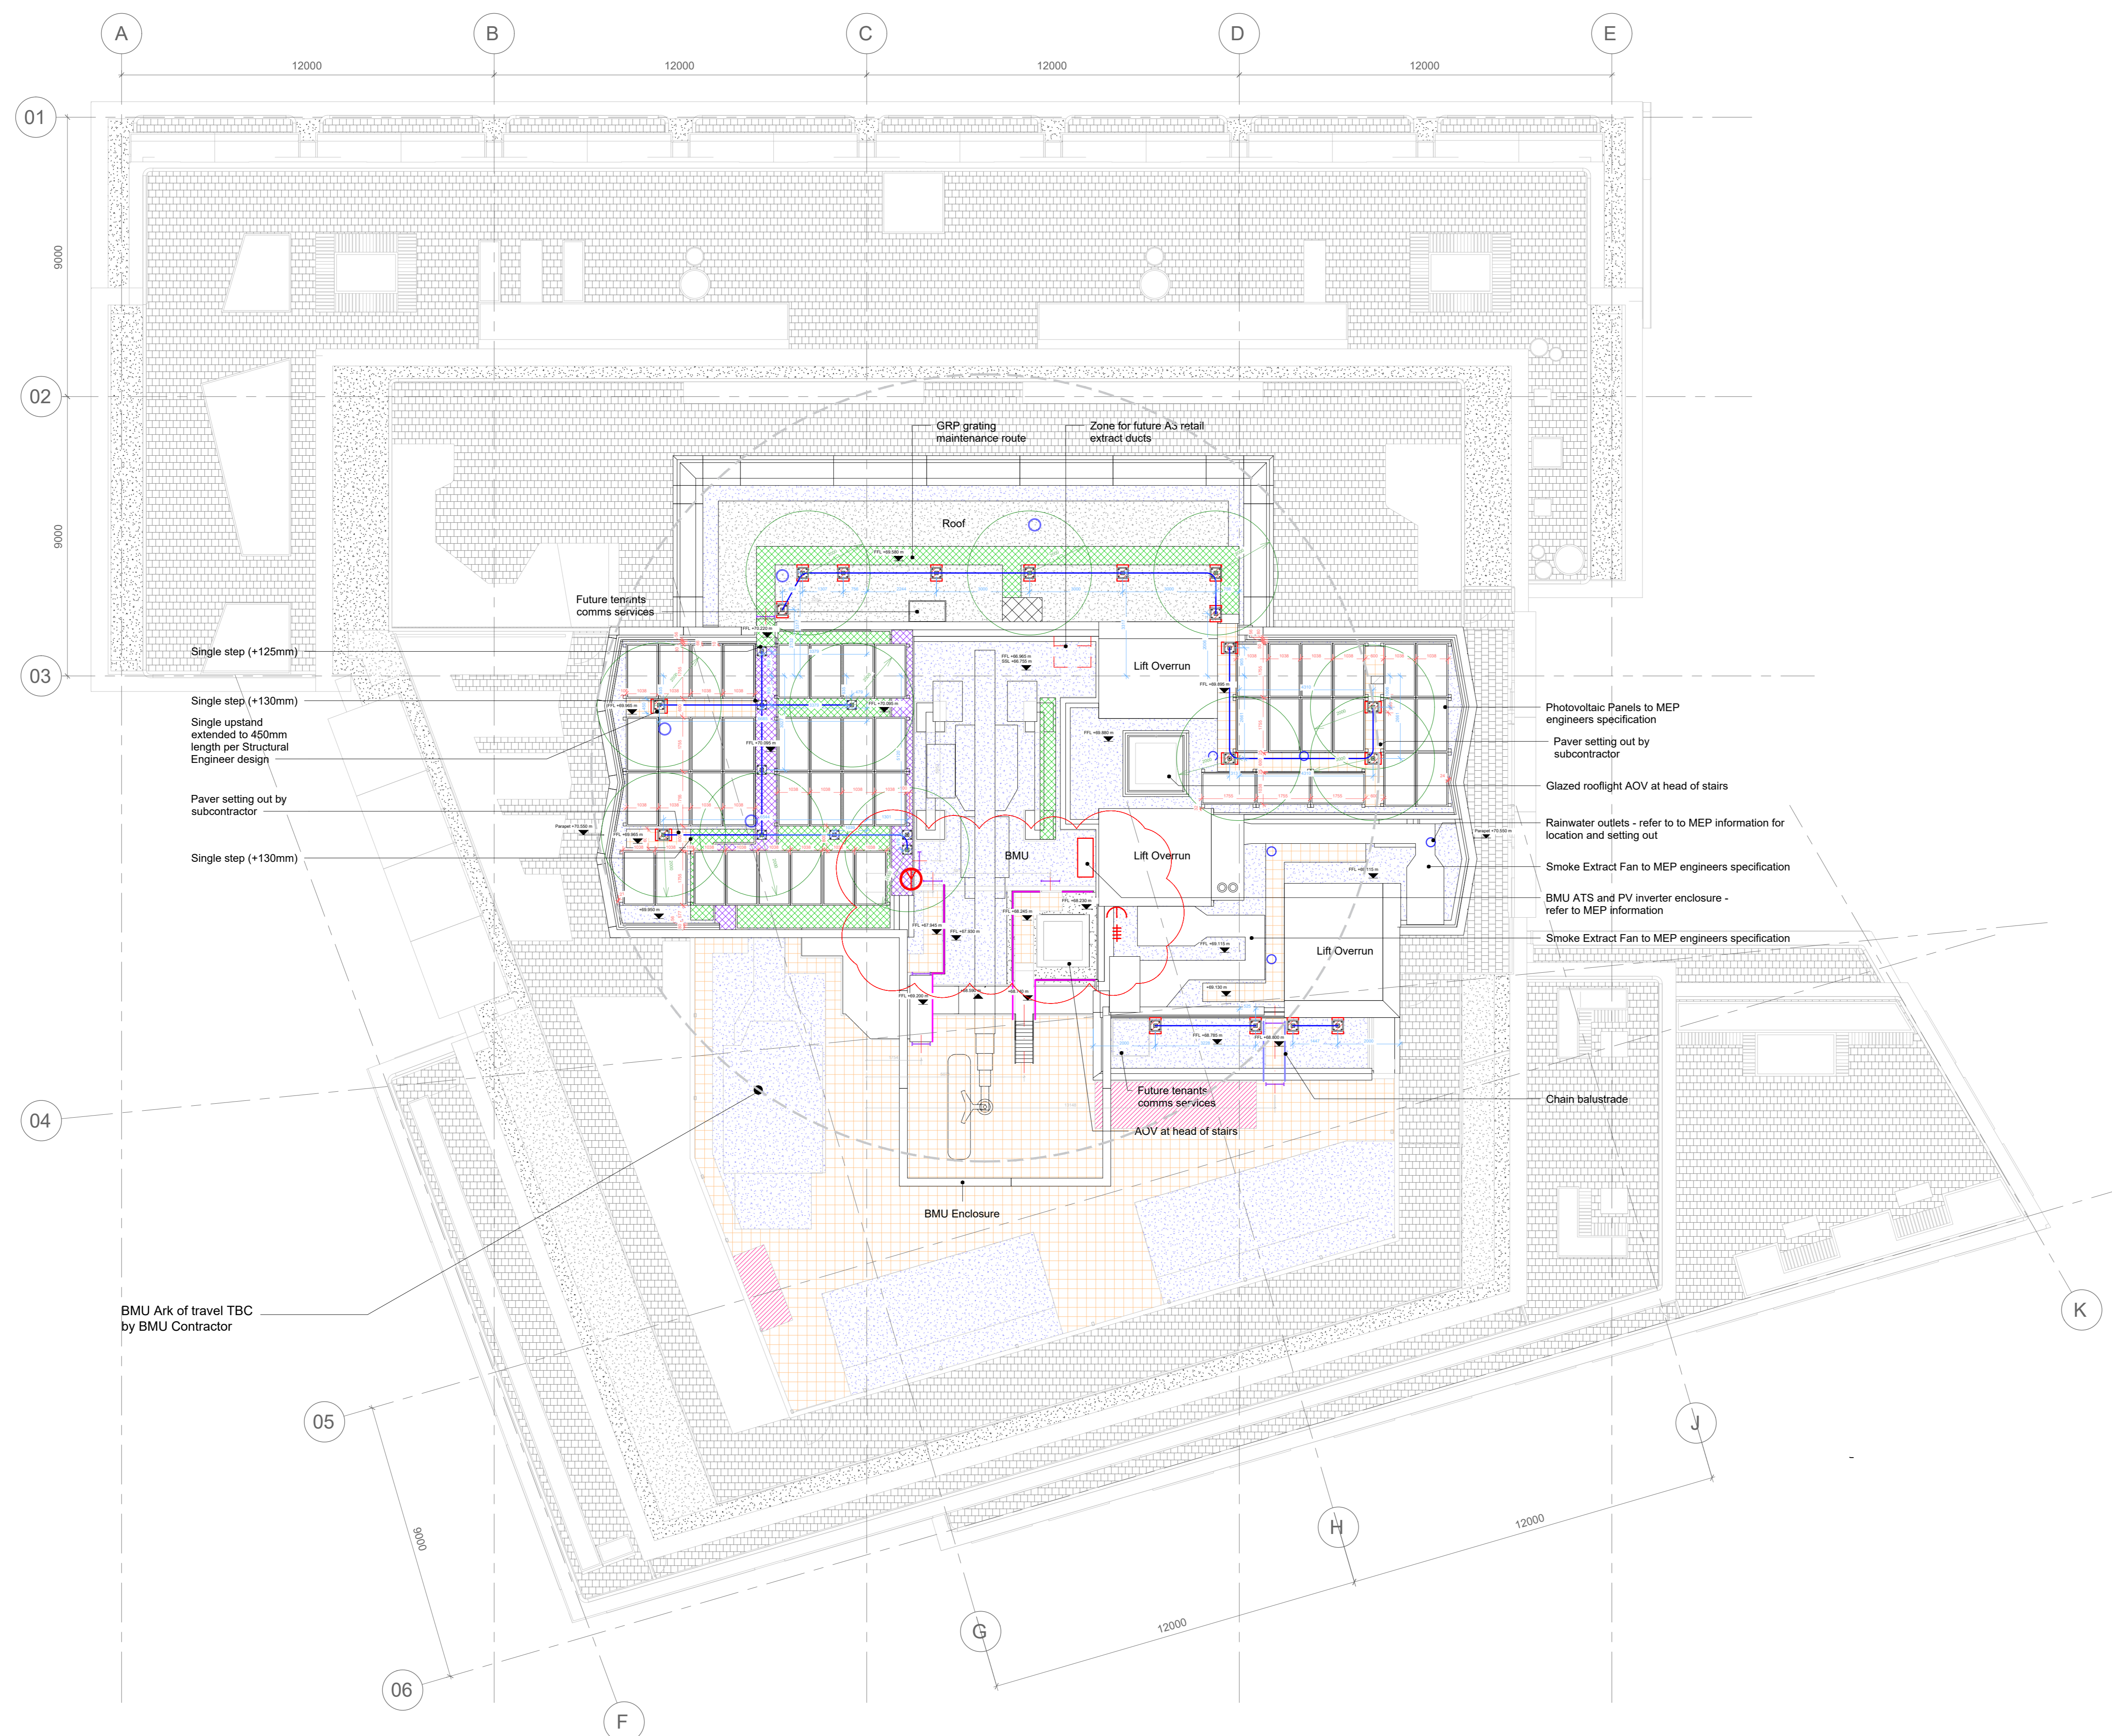


10th FLOOR ROOF COMMS KEY

-  ANTENNA
-  SATELITE DISH
-  AERIAL



REV	DATE	DESCRIPTION	BY
C3	13.04.24	Antenna & Satellite dish added for planning	PW
T2	13.10.23	Tender - Antenna removed	PW
T1	22.09.23	Tender - Updated COMS	PW

CLIENT
GSK

PROJECT TITLE
London Office - GSK

DRAWING TITLE
Planning - As Built Roof Plan
Antenna location

DATE
21.04.23

SCALE 1:100 @ A0
DRAWN JB
CHECKED LP

PENSON

TELEPHONE +44 - 207 403 8047
WEBSITE www.penson.co

PROJECT NO 3314
DRAWING NO I-X17
REVISION C3