



GROUND FLOOR

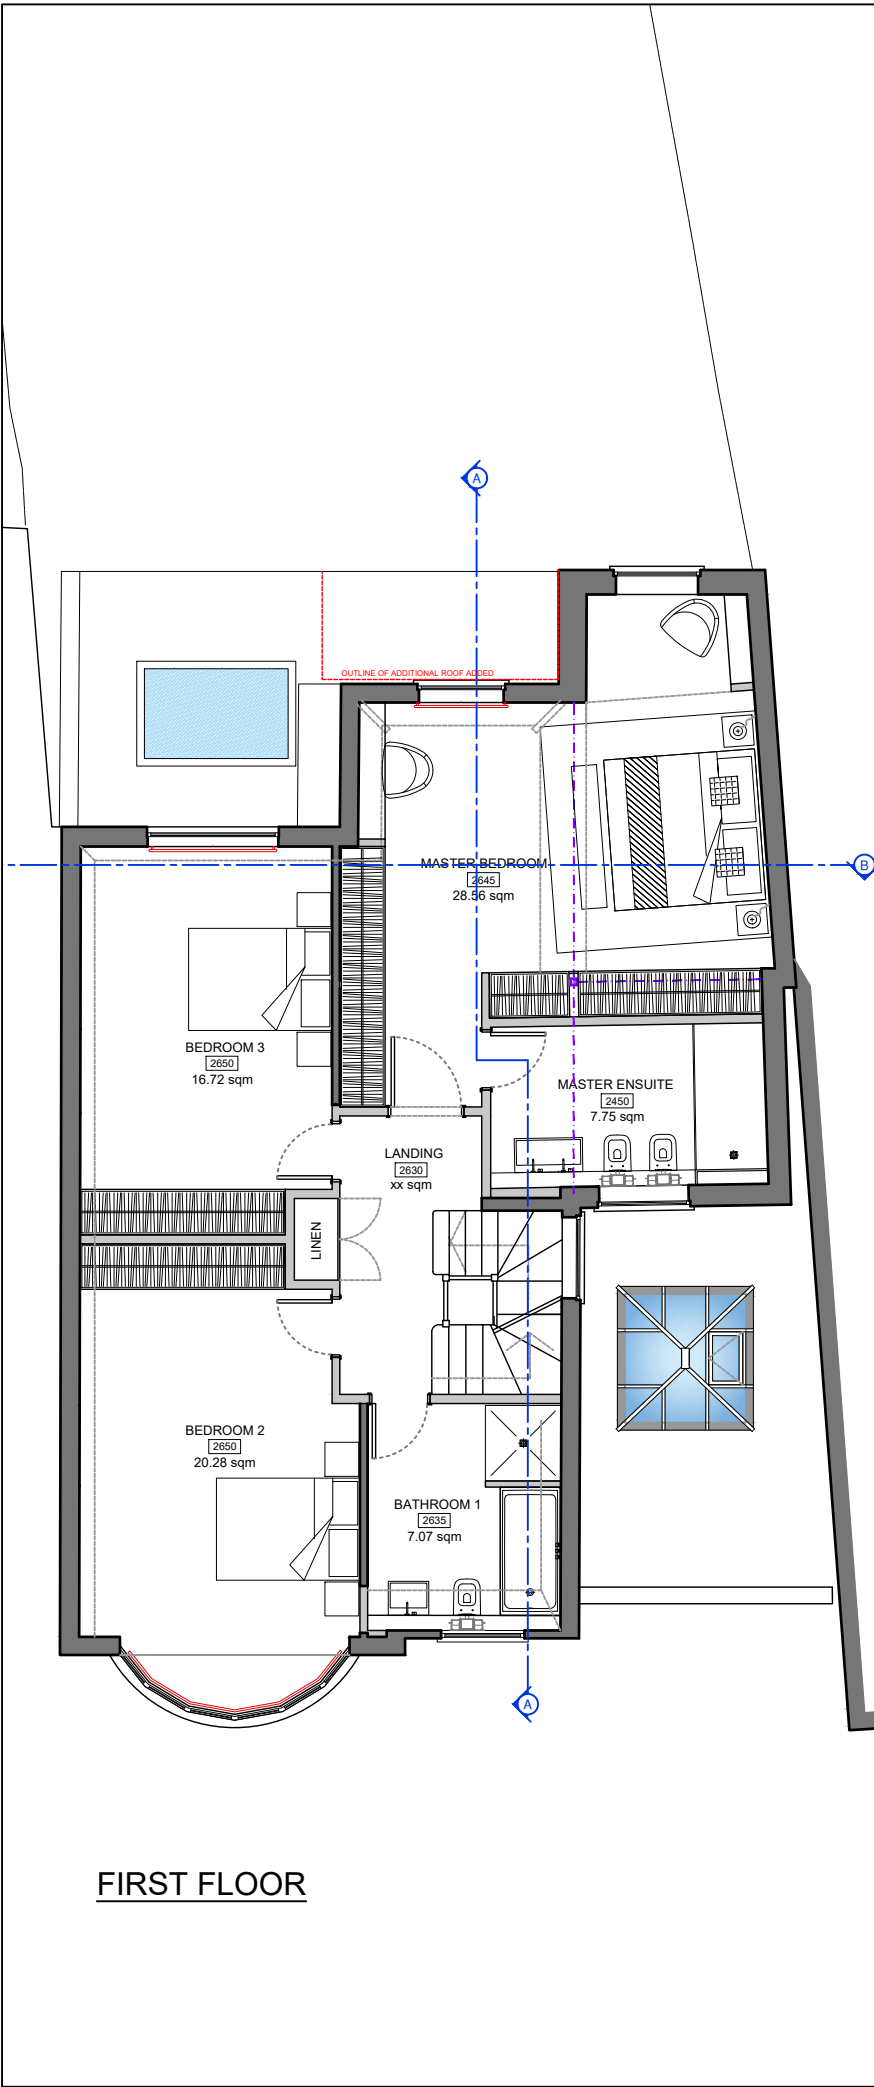

FIRST FLOOR

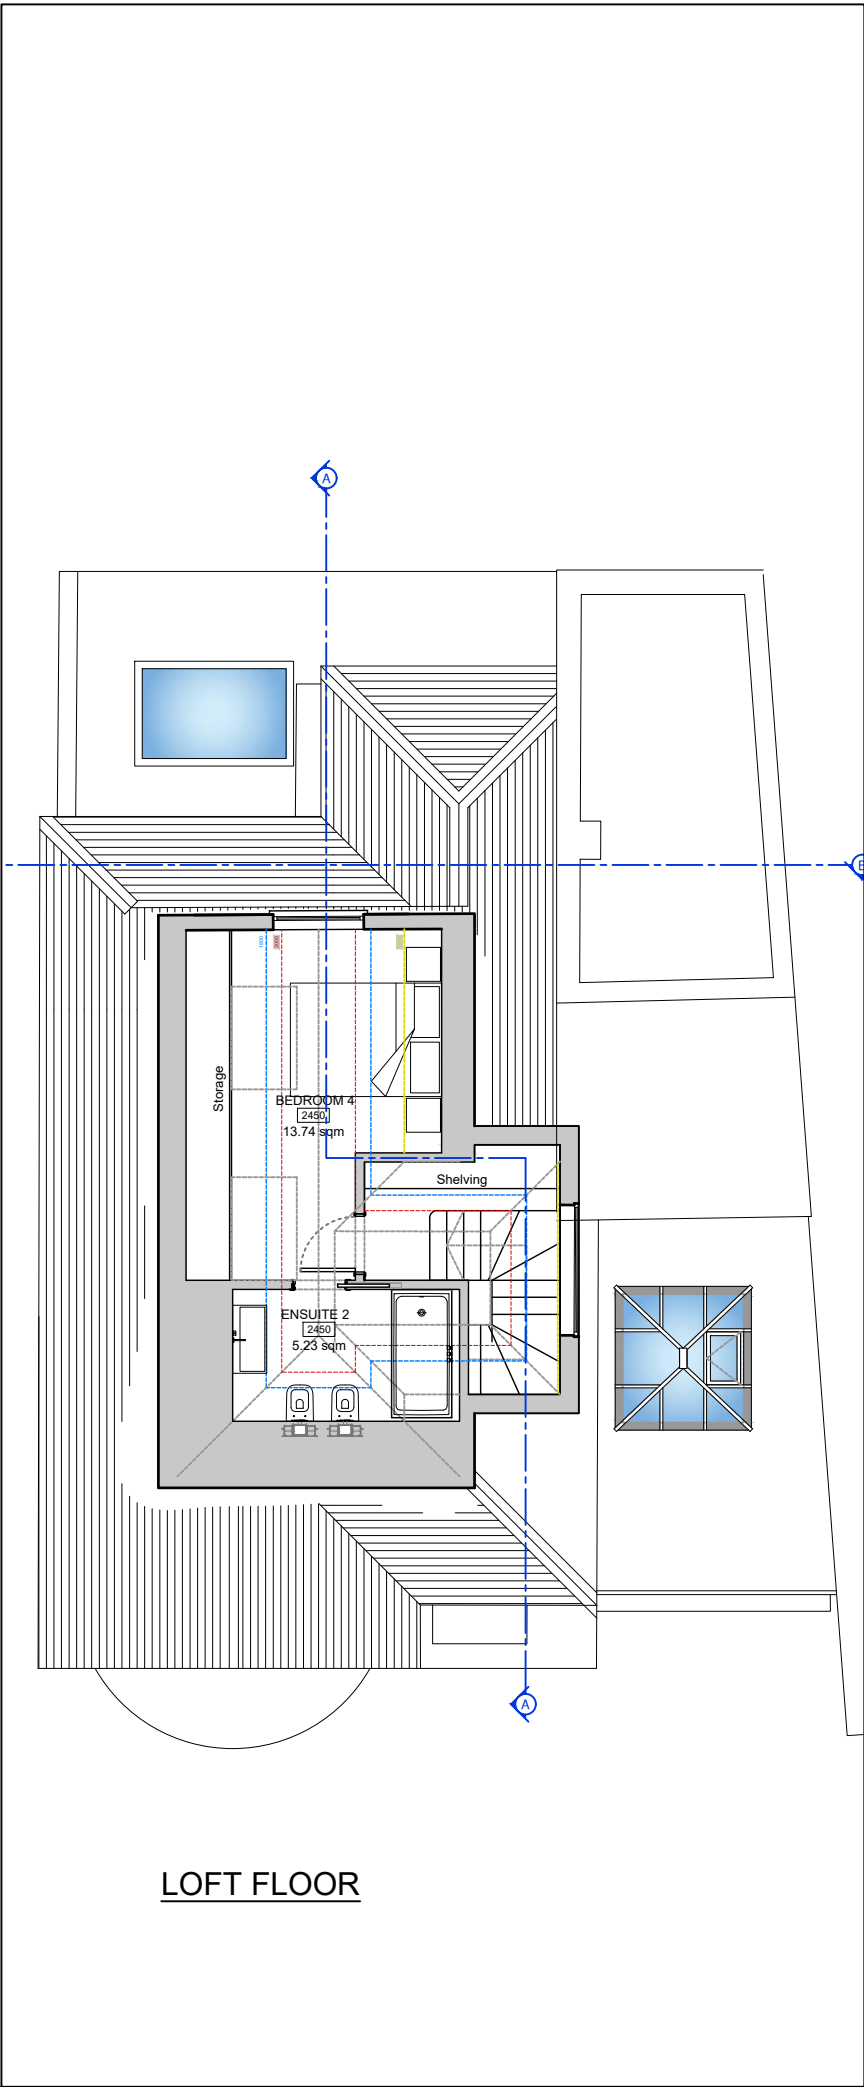

LOFT FLOOR

NOTES

THIS DRAWING IS THE COPYRIGHT OF THE ARCHITECTS AND MAY NOT BE REPRODUCED WITHOUT PERMISSION

THE CONTRACTOR IS RESPONSIBLE FOR CHECKING DIMENSIONS, TOLERANCES AND REFERENCE. ANY DISCREPANCIES TO BE CHECKED BEFORE PROCEEDING WITH THE WORKS

WHERE AN ITEM IS COVERED BY DRAWINGS TO DIFFERENT SCALES, THE LARGER SCALE DRAWING IS TO BE WORKED TO

DO NOT SCALE FROM DRAWING. FIGURED DIMENSIONS TO BE WORKED TO AT ALL TIMES

ALL WORK AND MATERIALS TO BE IN ACCORDANCE WITH THE BUILDING REGULATIONS AND TO COMPLY WITH THE RELEVANT CODES OF PRACTICE AND BRITISH STANDARDS

0

5

PLANNING

Copyright TRACE Architects Ltd 220

trace

ARCHITECTS

Basement Studio
263 The Vale
London
W3 7QA
TEL 0208 611 2946

1 The Hermitage
Eastfield Lane
Goring Heath
RG8 7SU
TEL 01491 579 544

E-MAIL office@tracearchitects.co.uk
www.tracearchitects.co.uk

DATE

-

CLIENT:

-

DRAWN

-

Mr Enrico Canzio

CHECKED

-

SCALE@A3

1:100

REFURBISHMENT OF PROPERTY

PROPOSED Floorplans

ADDRESS:
27 Hillway, Highgate, LONDON
N6 6QB




JOB No

1161

DRAWING NUMBER

PL01A

A3 Sheet

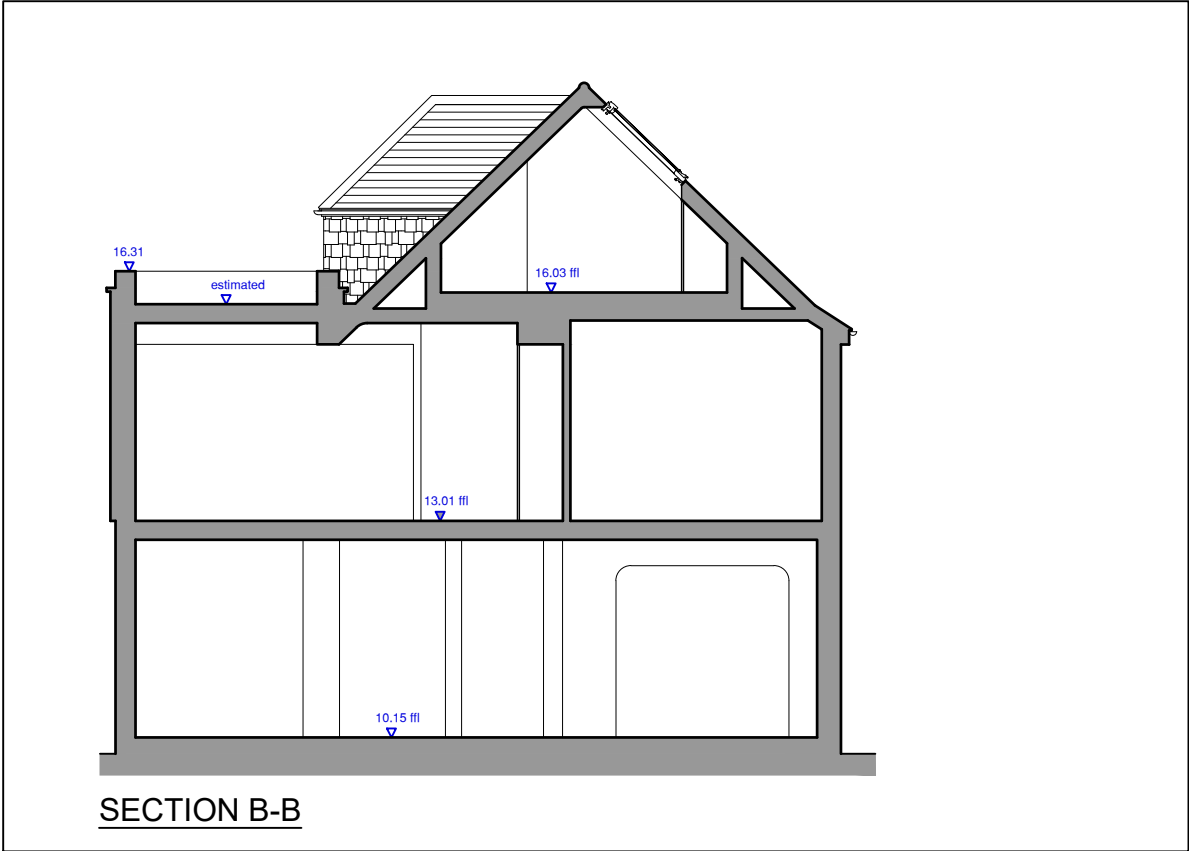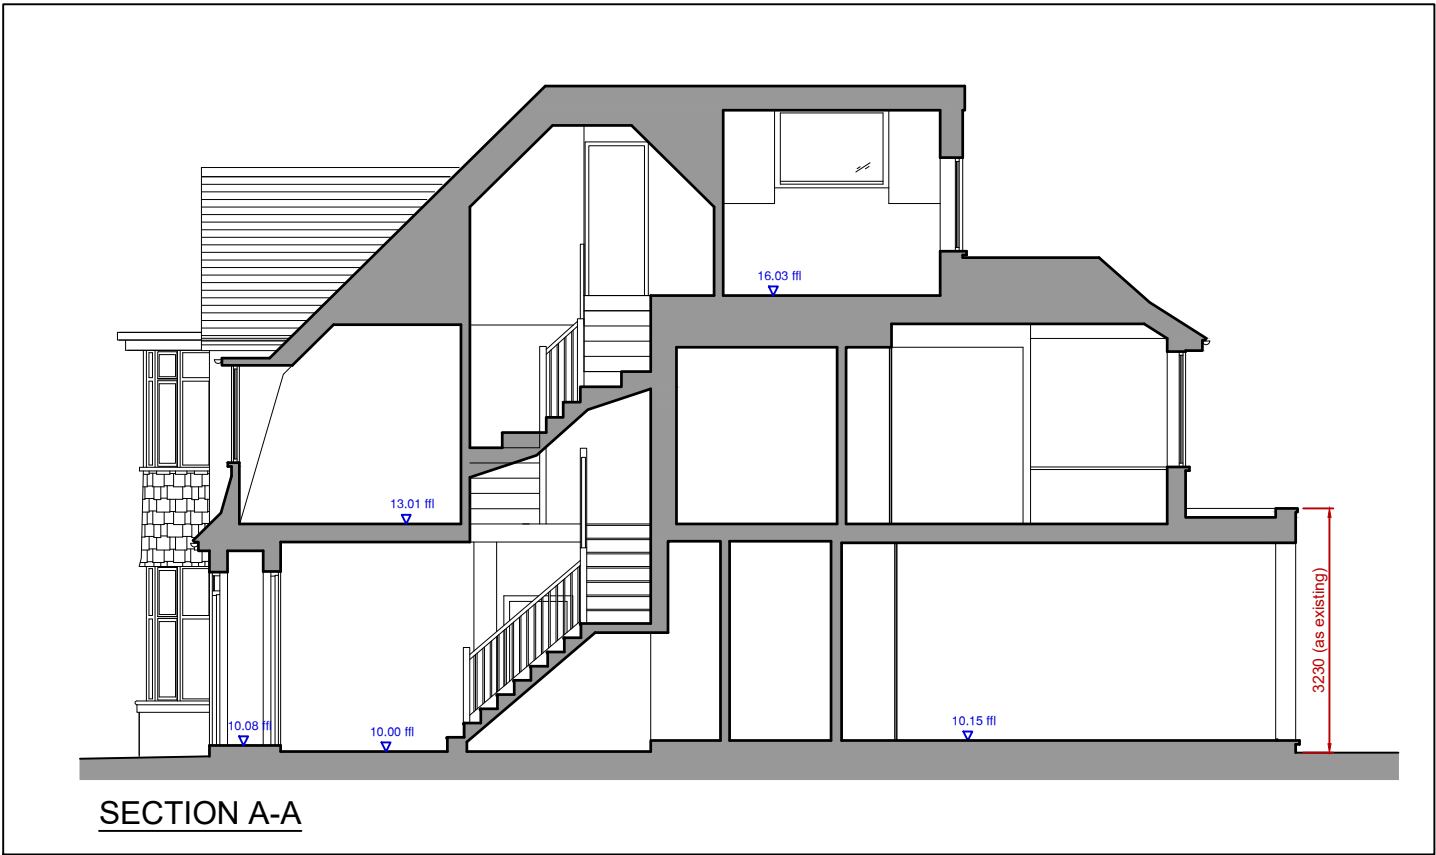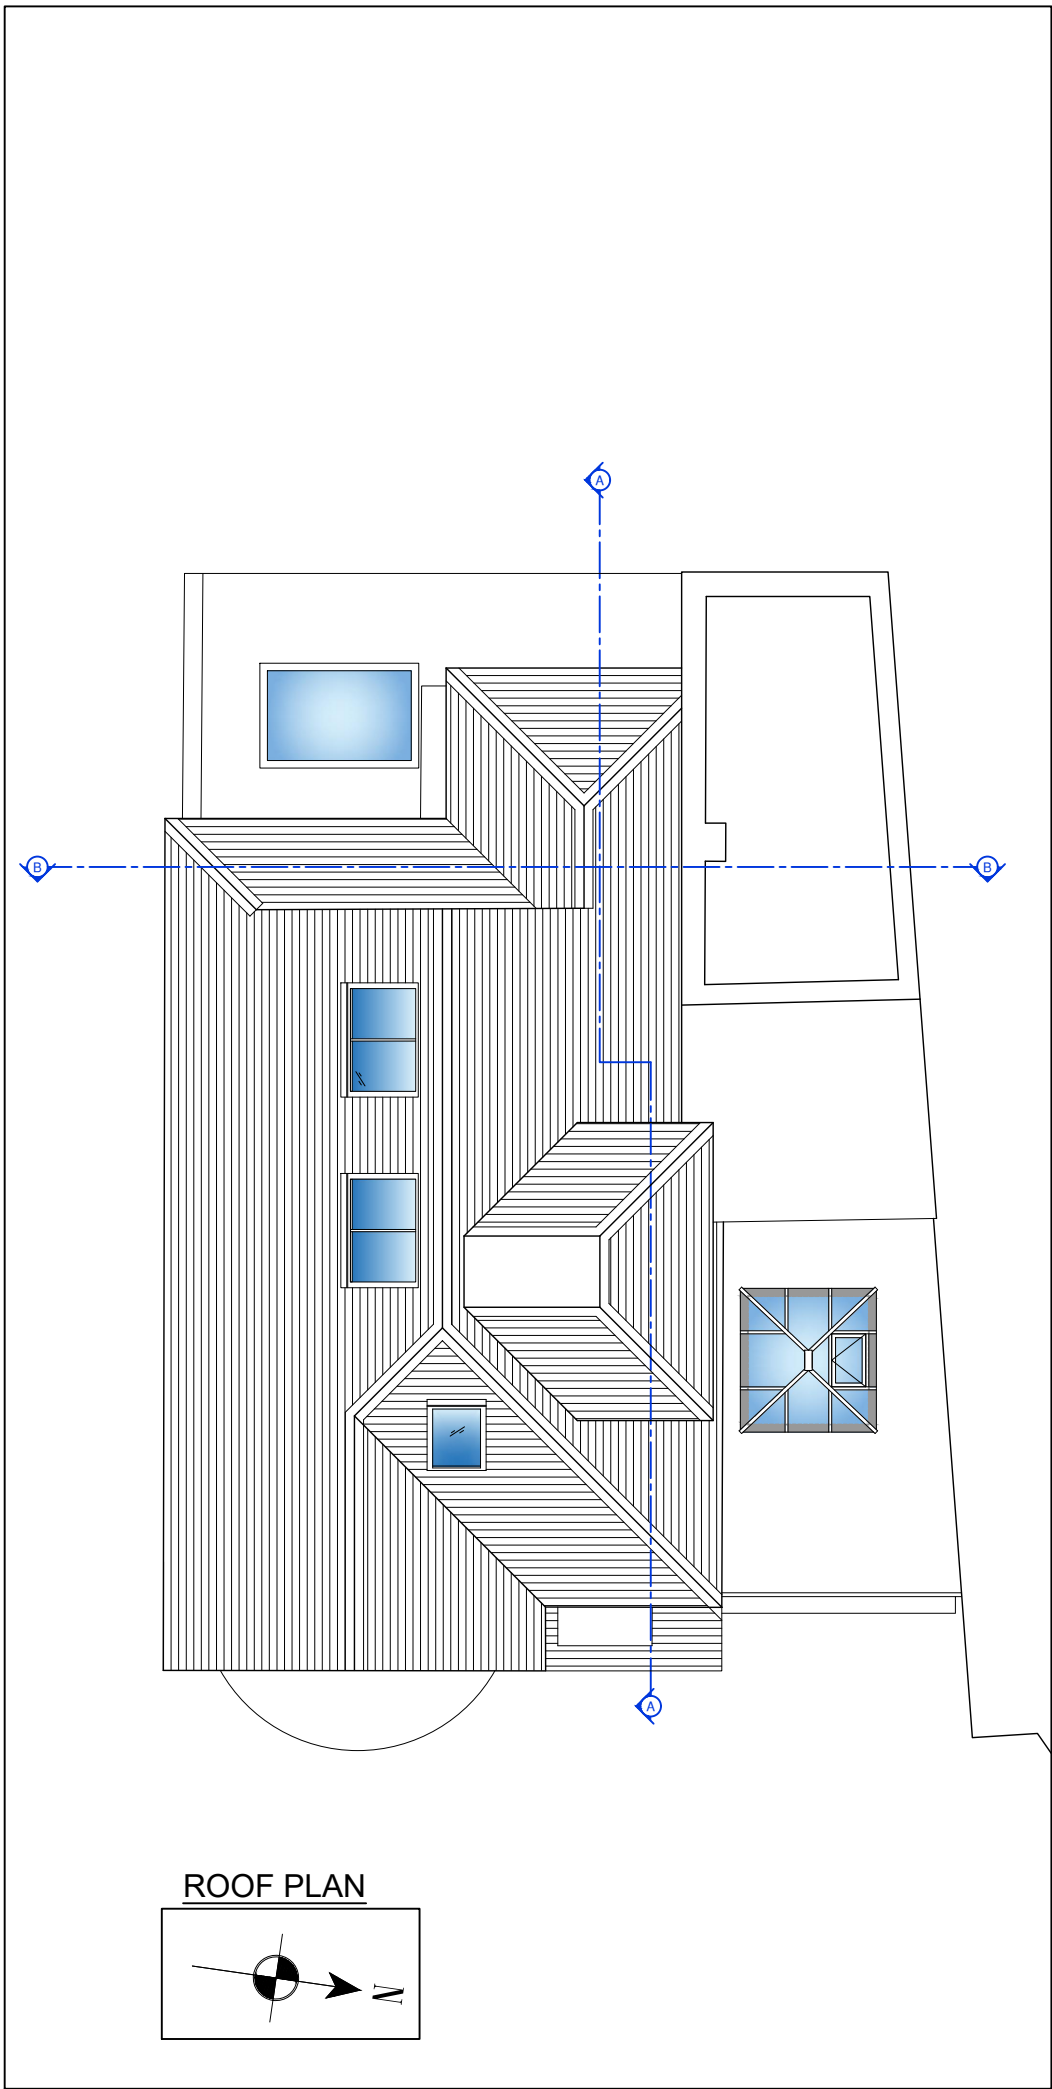

NOTES

THIS DRAWING IS THE COPYRIGHT OF THE ARCHITECTS AND MAY NOT BE REPRODUCED WITHOUT PERMISSION

THE CONTRACTOR IS RESPONSIBLE FOR CHECKING DIMENSIONS, TOLERANCES AND REFERENCE. ANY DISCREPANCIES TO BE CHECKED BEFORE PROCEEDING WITH THE WORKS

WHERE AN ITEM IS COVERED BY DRAWINGS TO DIFFERENT SCALES, THE LARGER SCALE DRAWING IS TO BE WORKED TO

DO NOT SCALE FROM DRAWING. FIGURED DIMENSIONS TO BE WORKED TO AT ALL TIMES

ALL WORK AND MATERIALS TO BE IN ACCORDANCE WITH THE BUILDING REGULATIONS AND TO COMPLY WITH THE RELEVANT CODES OF PRACTICE AND BRITISH STANDARDS



PLANNING

© Copyright TRACE Architects Ltd 220


trace
ARCHITECTS

Basement Studio
263 The Vale
London
W3 7QA
TEL 0208 611 2946
E-MAIL office@tracearchitects.co.uk
www.tracearchitects.co.uk


1 The Hermitage
Eastfield Lane
Goring Heath
RG8 7SU
TEL 01491 579 544

DATE	-	CLIENT:
DRAWN	-	Mr Enrico Canzio
CHECKED	-	
SCALE@A3	1:100	


REFURBISHMENT OF PROPERTY	
PROPOSED Roof Plan & Sections	
ADDRESS: 27 Hillway, Highgate, LONDON N6 6QB	
JOB No	DRAWING NUMBER
1161	PL02A
A3 Sheet	

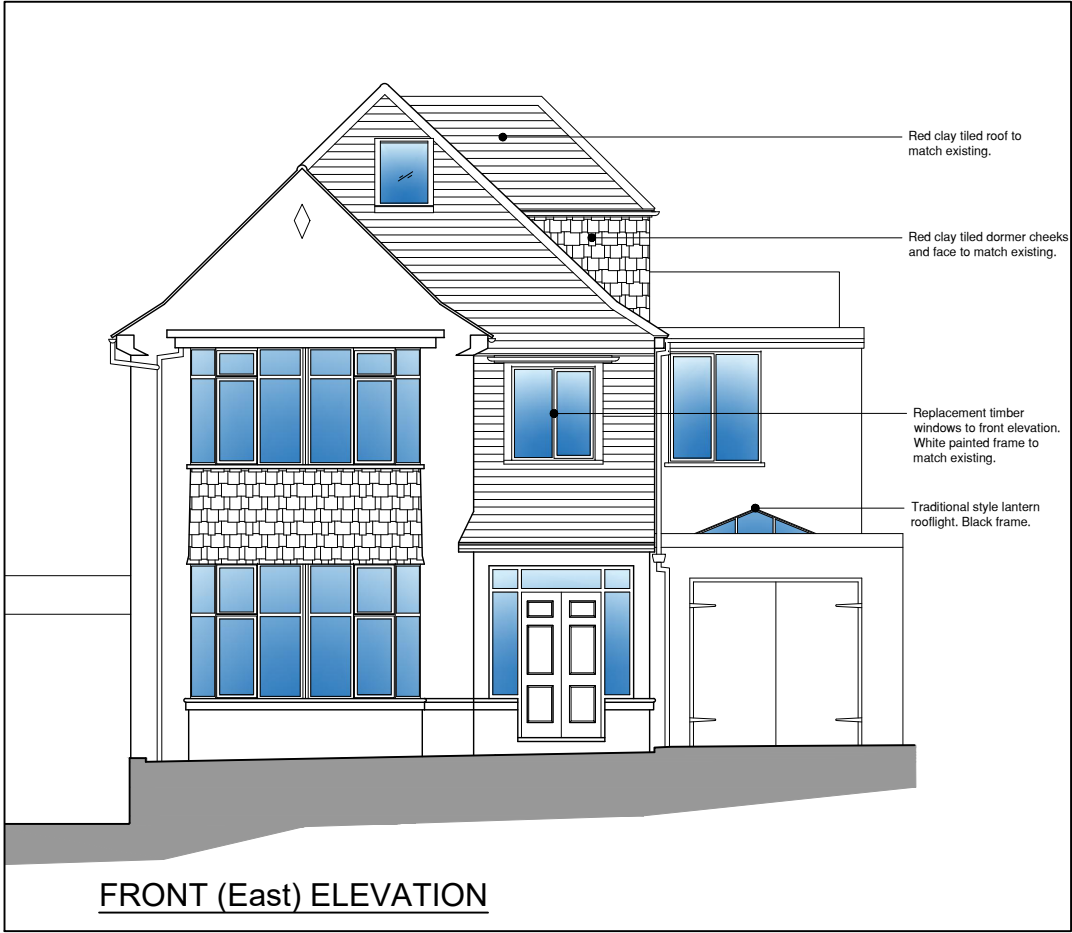


FRONT (East) ELEVATION

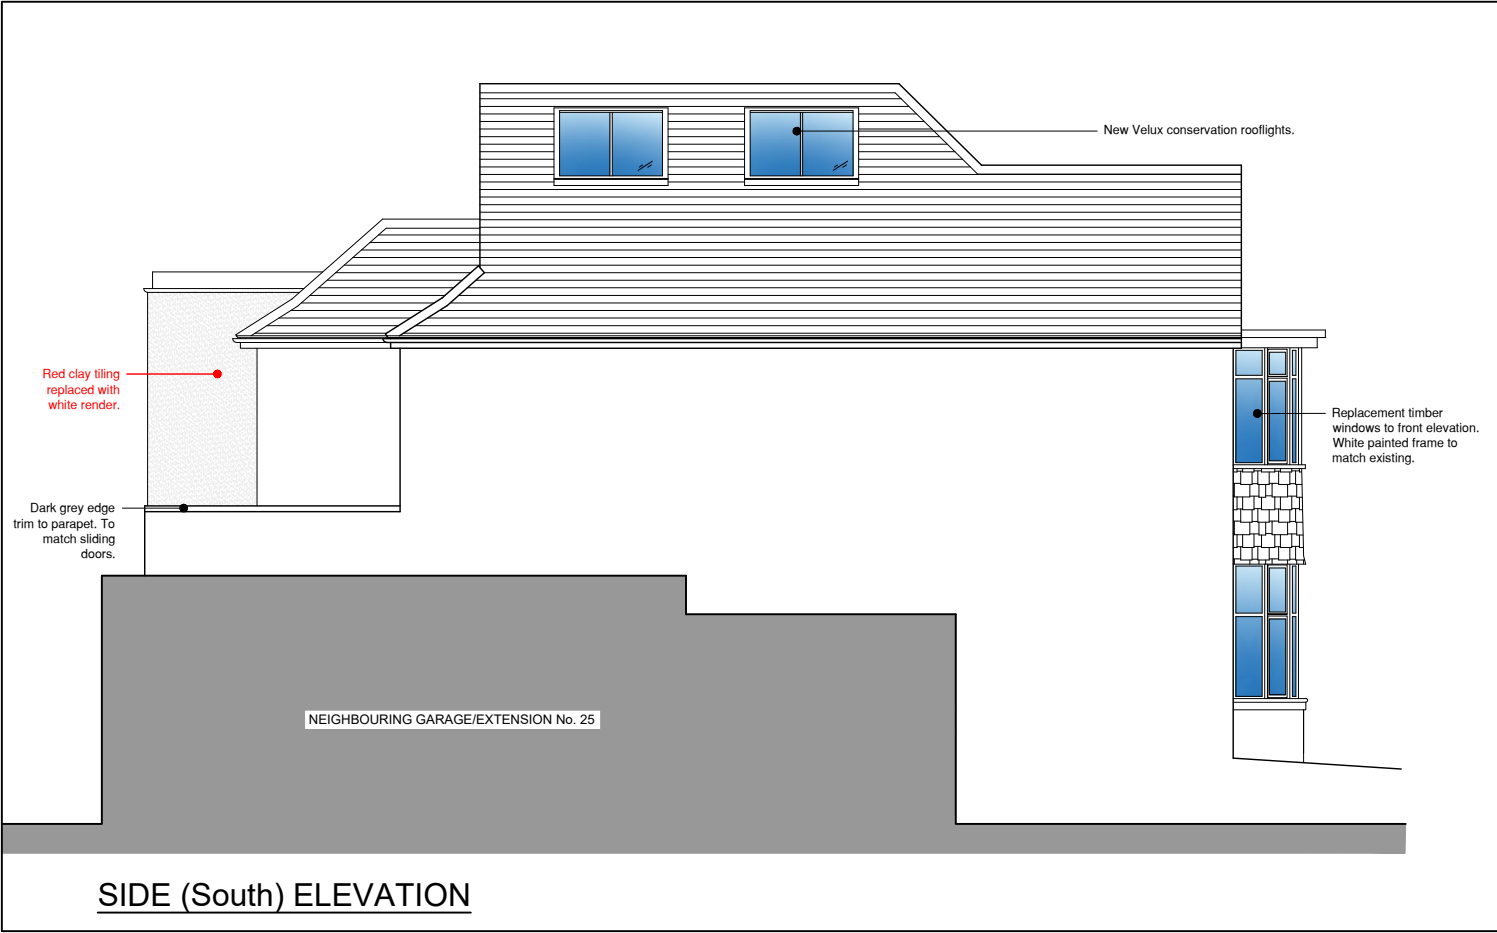

SIDE (South) ELEVATION

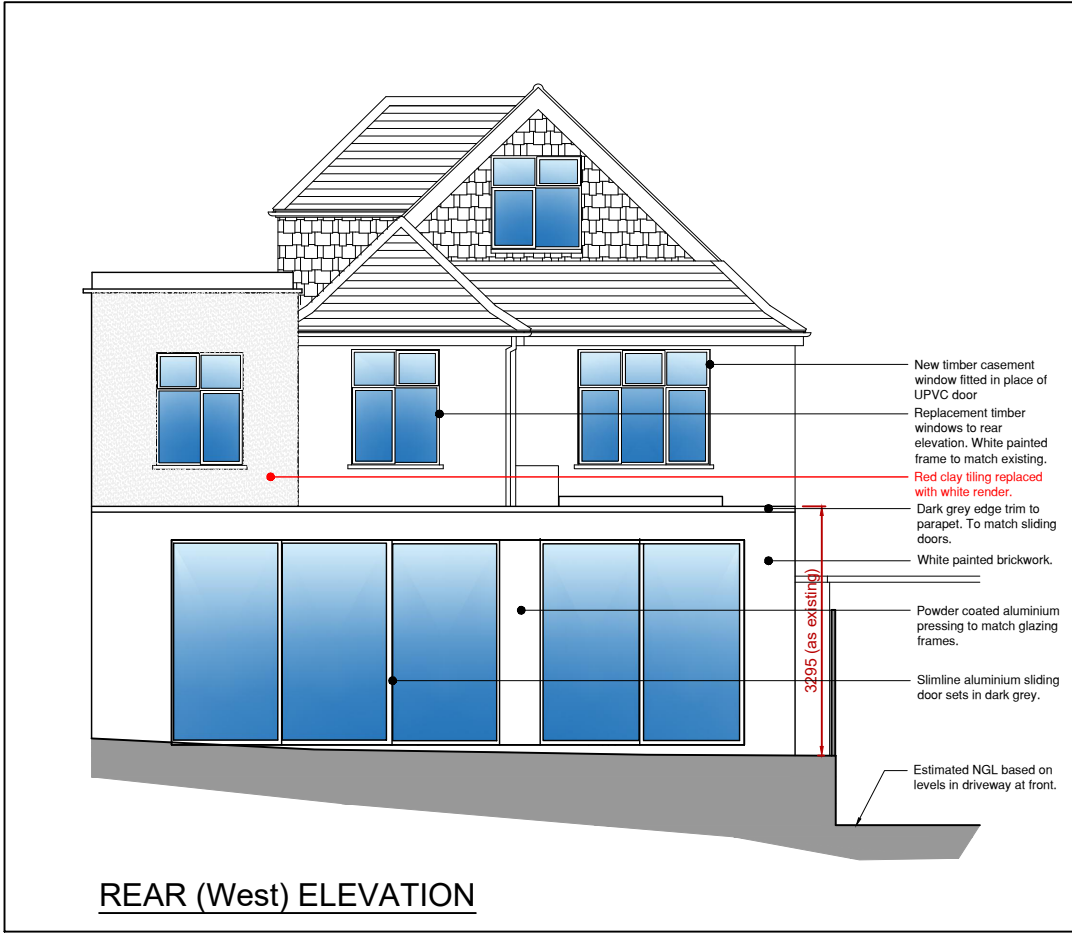

REAR (West) ELEVATION

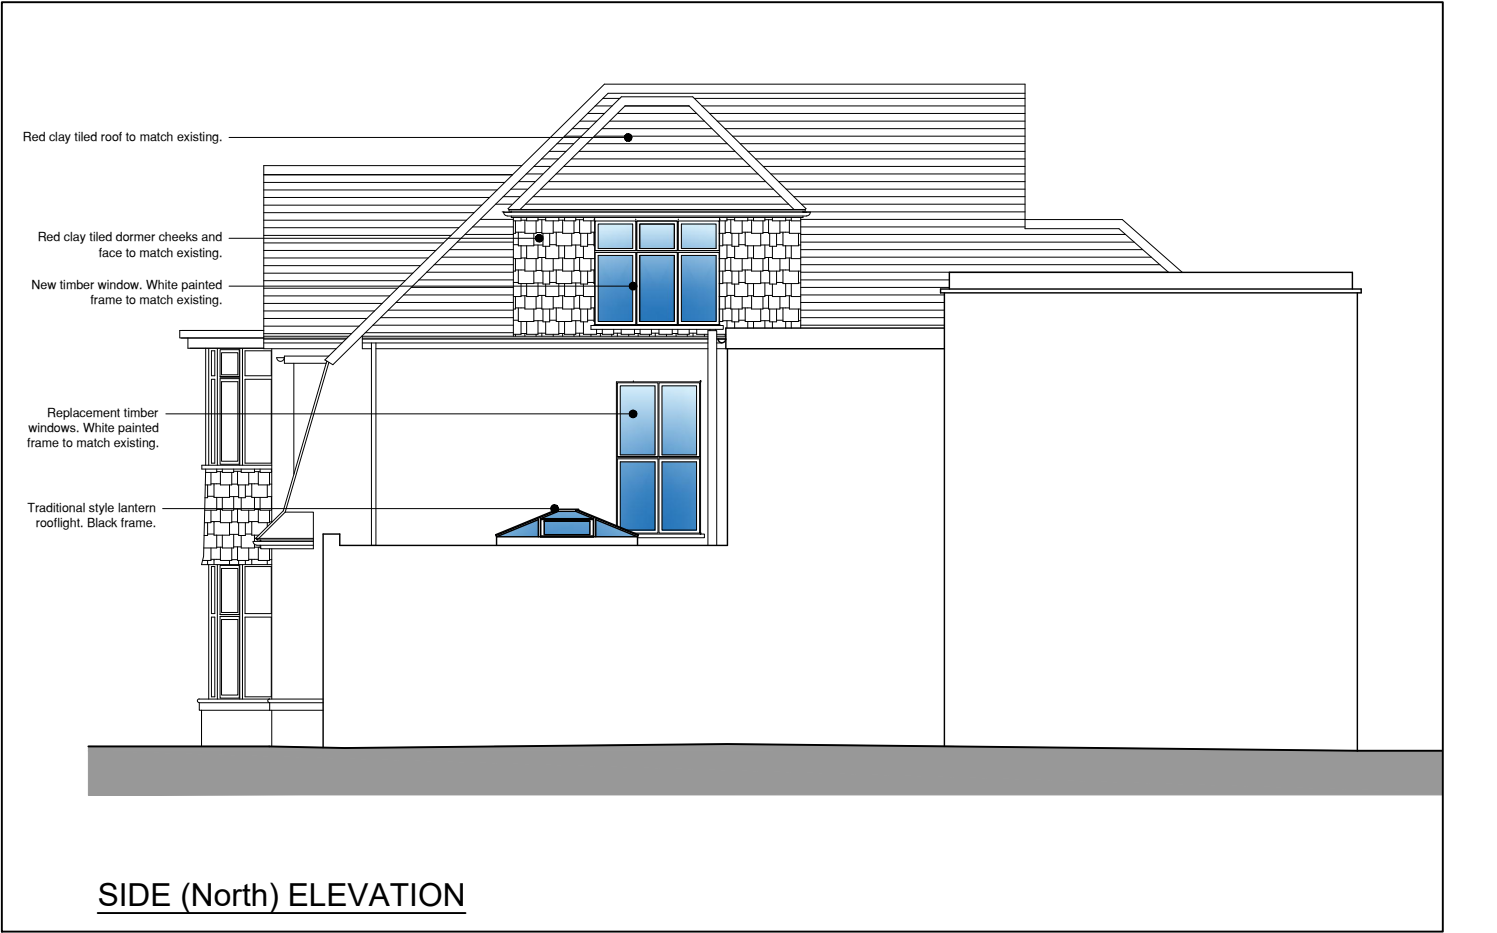

SIDE (North) ELEVATION

NOTES

THIS DRAWING IS THE COPYRIGHT OF THE ARCHITECTS AND MAY NOT BE REPRODUCED WITHOUT PERMISSION

THE CONTRACTOR IS RESPONSIBLE FOR CHECKING DIMENSIONS, TOLERANCES AND REFERENCE. ANY DISCREPANCIES TO BE CHECKED BEFORE PROCEEDING WITH THE WORKS

WHERE AN ITEM IS COVERED BY DRAWINGS TO DIFFERENT SCALES, THE LARGER SCALE DRAWING IS TO BE WORKED TO

~~DO NOT SCALE FROM DRAWING. FIGURED DIMENSIONS TO BE WORKED TO AT ALL TIMES~~

ALL WORK AND MATERIALS TO BE IN ACCORDANCE WITH THE BUILDING REGULATIONS AND TO COMPLY WITH THE RELEVANT CODES OF PRACTICE AND BRITISH STANDARDS

0

5

PLANNING

© Copyright TRACE Architects Ltd 220

trace

ARCHITECTS

Basement Studio
263 The Vale
London
W3 7QA
TEL 0208 611 2946

1 The Hermitage
Eastfield Lane
Goring Heath
RG8 7SU
TEL 01491 579 544
E-MAIL office@tracearchitects.co.uk
www.tracearchitects.co.uk

DATE

-

CLIENT:

DRAWN

-

Mr Enrico Canzio

CHECKED

-

SCALE@A3

1:100

REFURBISHMENT OF PROPERTY

PROPOSED Elevations

ADDRESS:

27 Hillway, Highgate, LONDON
N6 6QB



JOB No

1161

DRAWING NUMBER

PL03 revB

A3 Sheet

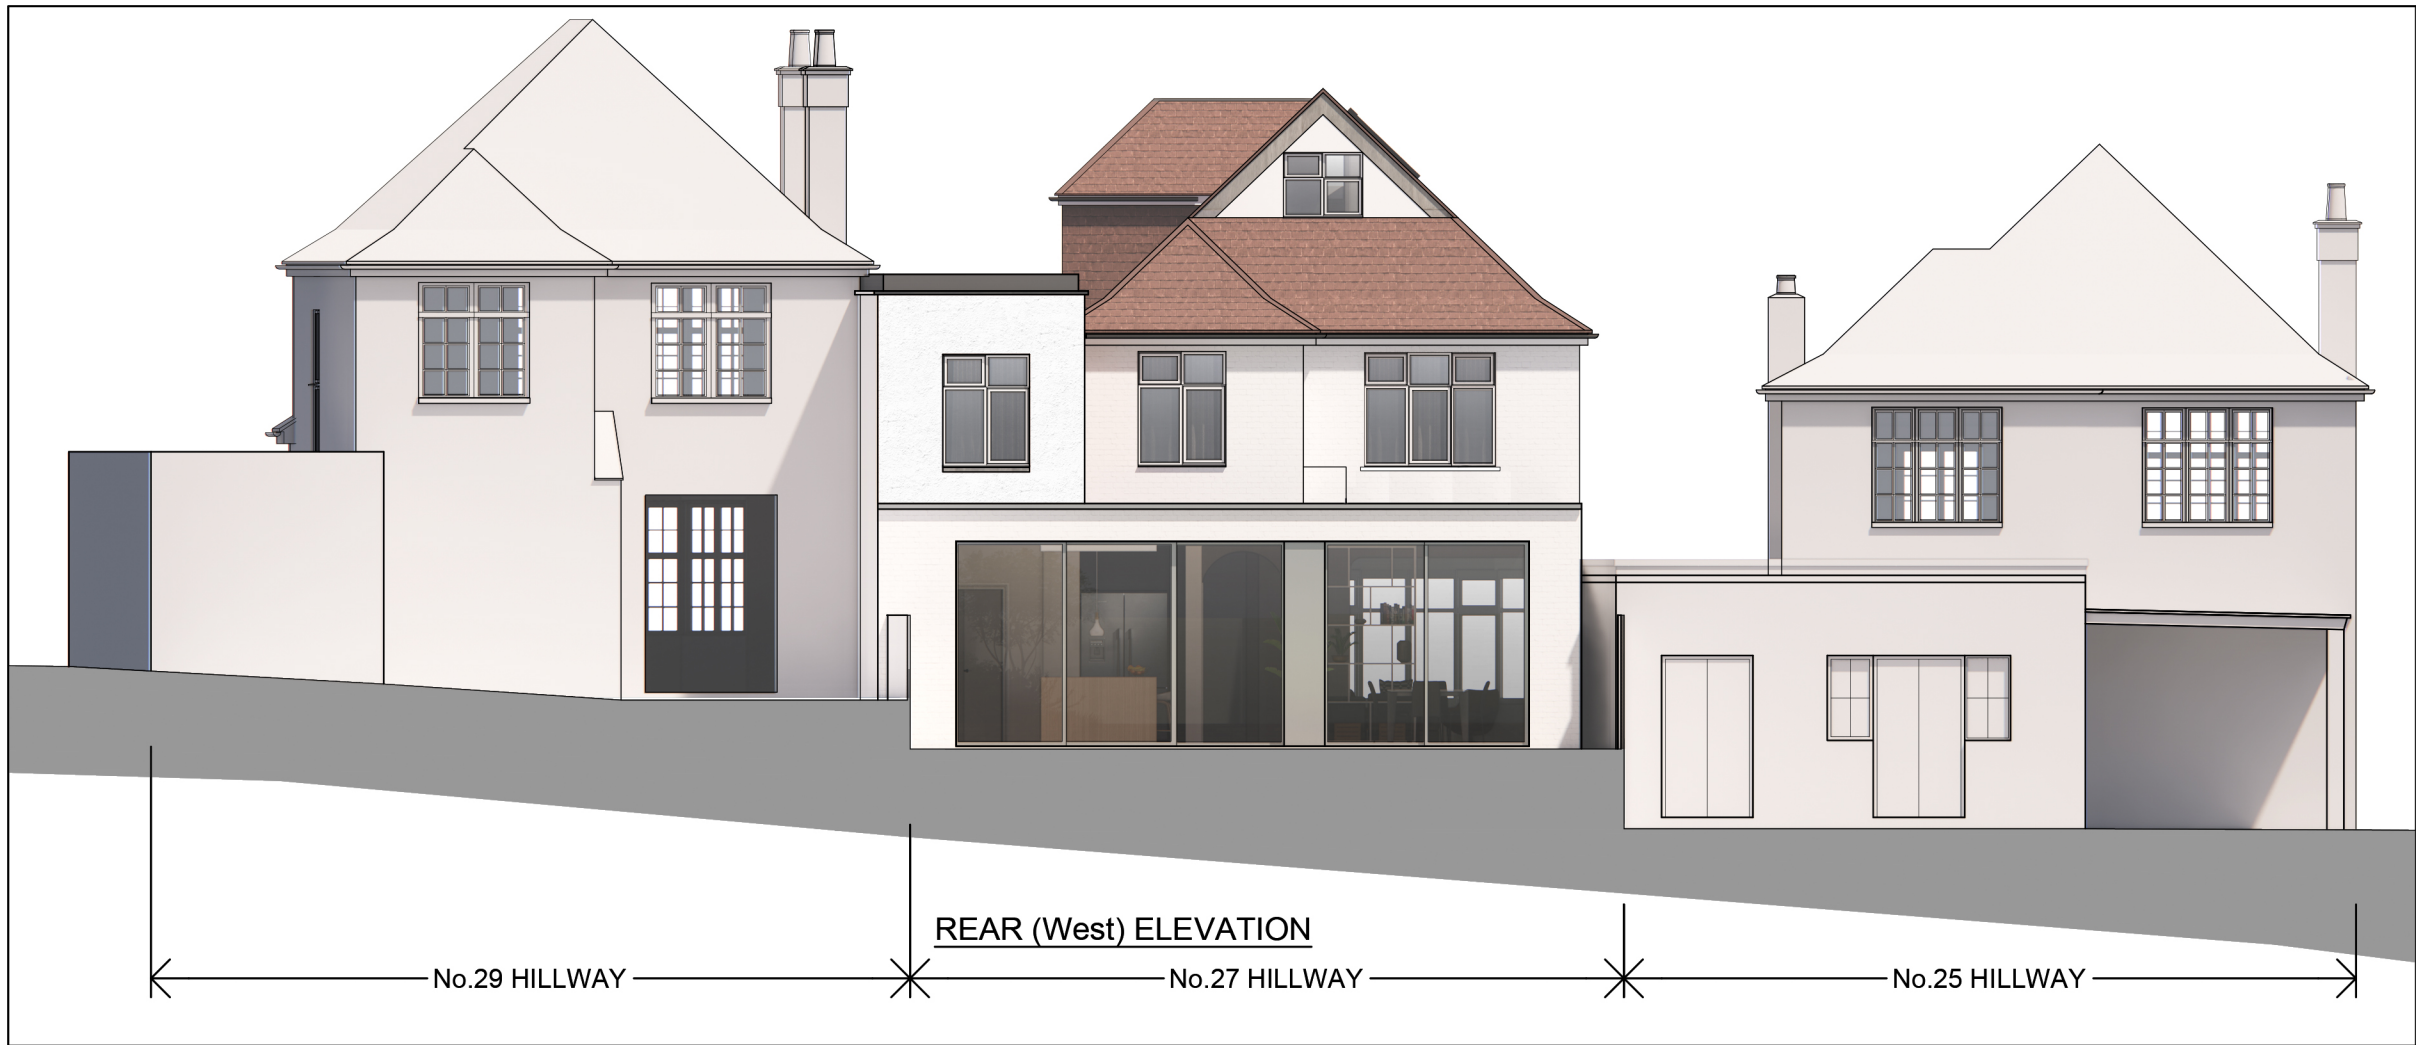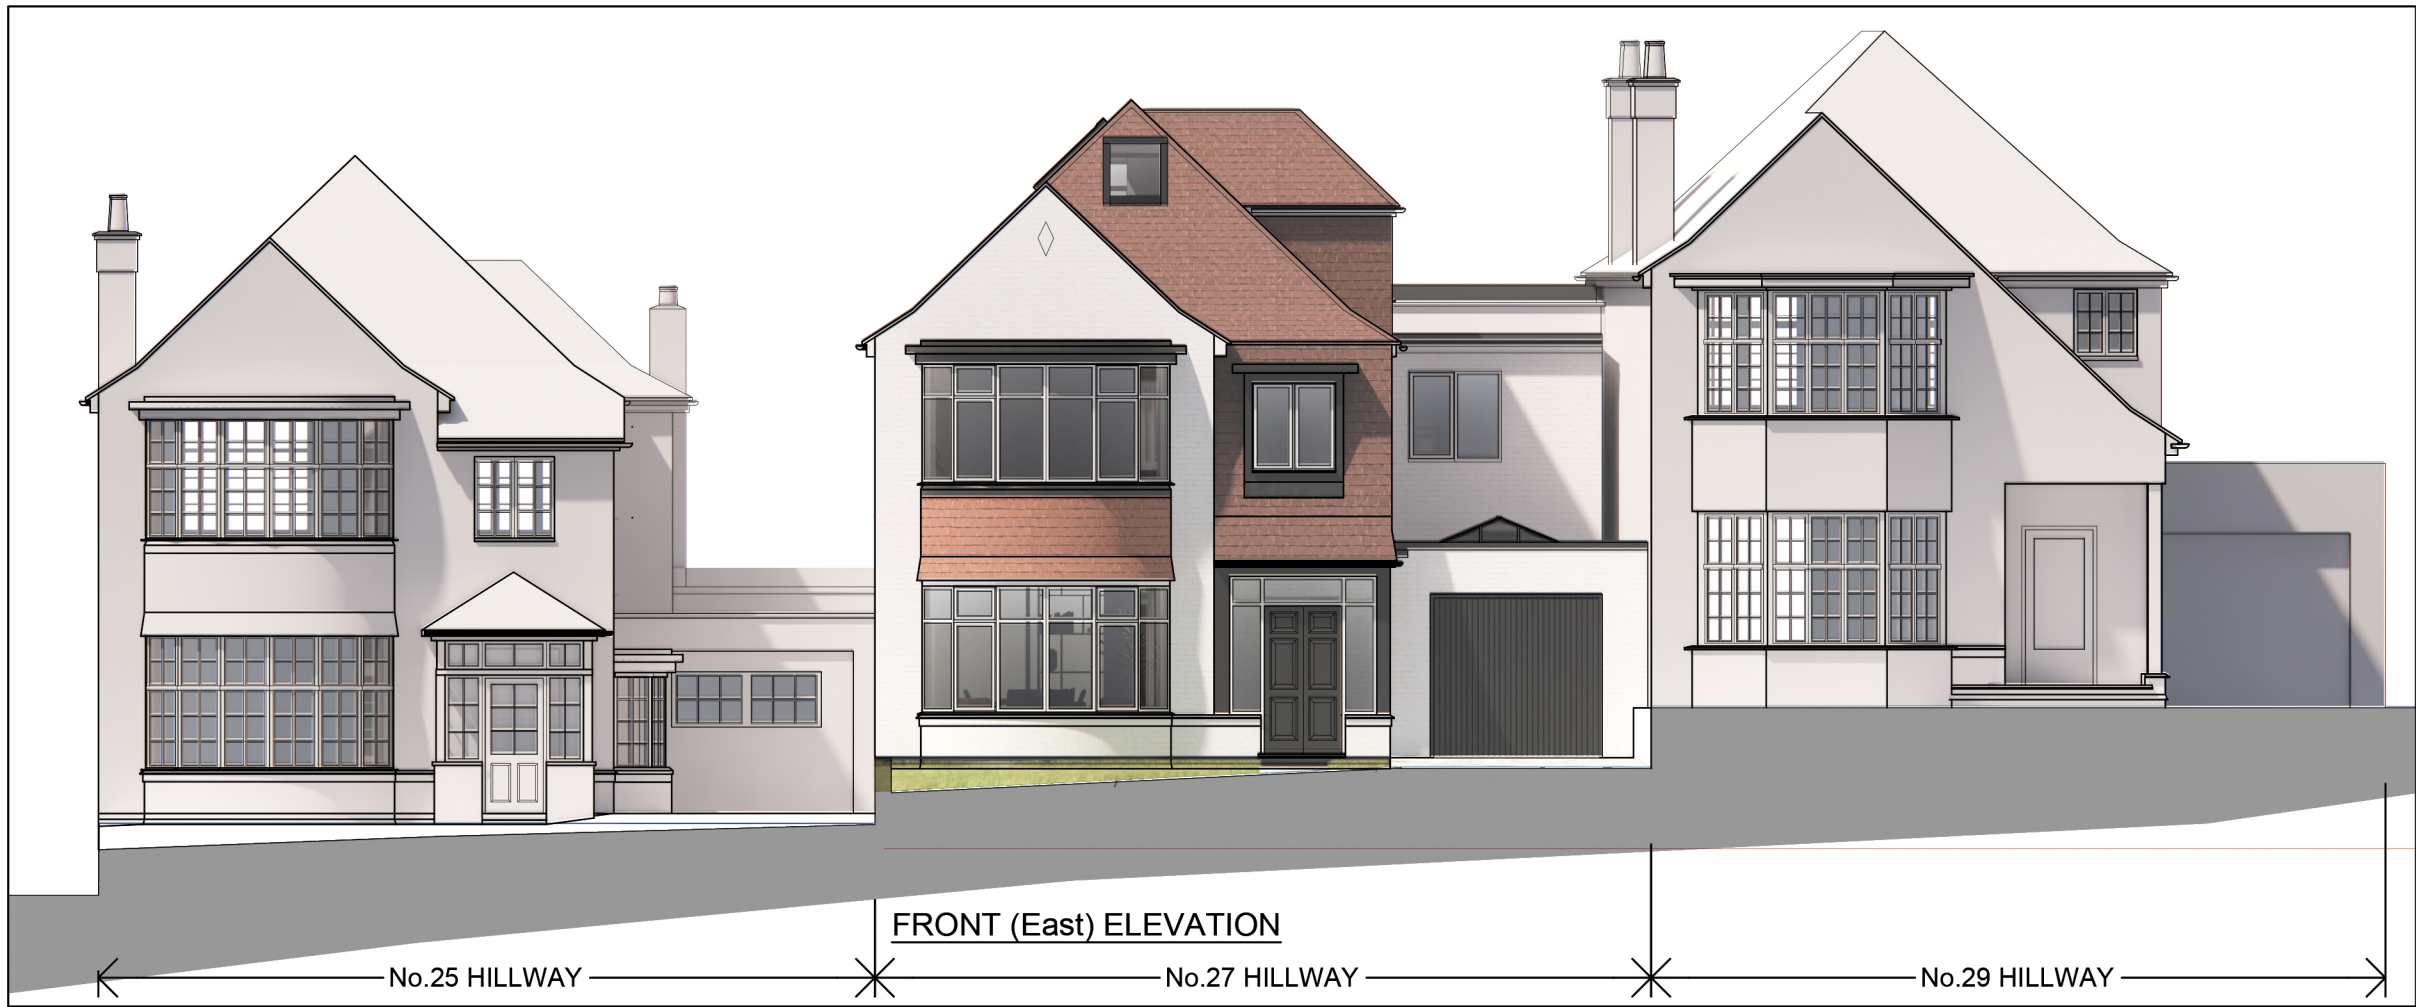

NOTES

THIS DRAWING IS THE COPYRIGHT OF THE ARCHITECTS AND MAY NOT BE REPRODUCED WITHOUT PERMISSION

THE CONTRACTOR IS RESPONSIBLE FOR CHECKING DIMENSIONS, TOLERANCES AND REFERENCE. ANY DISCREPANCIES TO BE CHECKED BEFORE PROCEEDING WITH THE WORKS

WHERE AN ITEM IS COVERED BY DRAWINGS TO DIFFERENT SCALES, THE LARGER SCALE DRAWING IS TO BE WORKED TO

~~DO NOT SCALE FROM DRAWING. FIGURED DIMENSIONS TO BE WORKED TO AT ALL TIMES~~

ALL WORK AND MATERIALS TO BE IN ACCORDANCE WITH THE BUILDING REGULATIONS AND TO COMPLY WITH THE RELEVANT CODES OF PRACTICE AND BRITISH STANDARDS

05

PLANNING

©

Copyright TRACE Architects Ltd 220

trace

ARCHITECTS

Basement Studio
263 The Vale
London
W3 7QA
TEL 0208 611 2946

1 The Hermitage
Eastfield Lane
Goring Heath
RG8 7SU
TEL 01491 579 544

E-MAIL office@tracearchitects.co.uk
www.tracearchitects.co.uk

DATE

-

CLIENT:

Mr Enrico Canzio

DRAWN

-

CHECKED

-

SCALE@A3

1:100

REFURBISHMENT OF PROPERTY

PROPOSED

Street Elevations Front & Rear

ADDRESS:

27 Hillway, Highgate, LONDON
N6 6QB

JOB No

1161

DRAWING NUMBER

PL04 revB

A3 Sheet