


**Notes**  
Do not scale from this drawing. To be read in conjunction with all relevant Architects', Services and Structural Engineers' information. Architect to be immediately notified of discrepancies. Copyright belongs to Urbanist Architecture Ltd.

- - - - Boundary Line

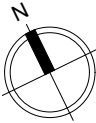

**Urbanist Architecture**  
2 Little Thames Walk London SE8 3FB  
Tel: 0203 793 7878  
info@urbanistarchitecture.co.uk  
www.urbanistarchitecture.co.uk

**Project Description**


**Site Address**  
128 Camden Road London NW1 9EE

**Drawing Name**  
Lease Plan  
Approved Site Plan


**Drawing Status:** Planning


**Scale:** 1/200 @A3    **Drawn:** SM  
**Date:** 24/05/2024    **Checked:** RC

Drawing no							
project	originator	zone	level	type	role	no.	rev
215- NW19EE	-	URB	-	ZZ	-	XX - DR - A - 1011	- R1

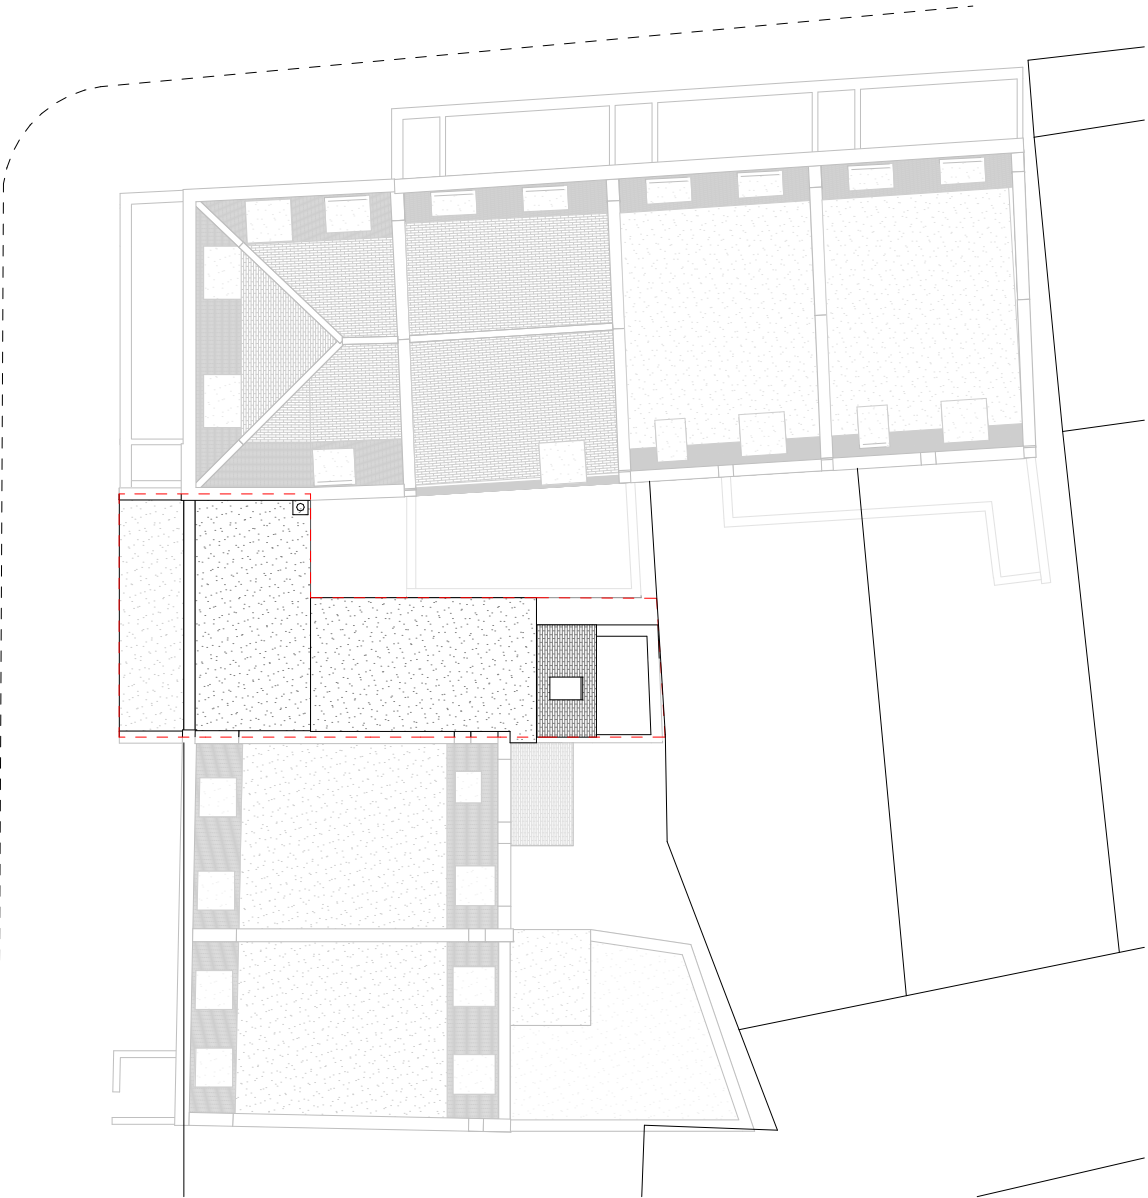


As Built Site Plan  
Scale:1:200

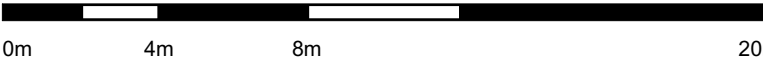

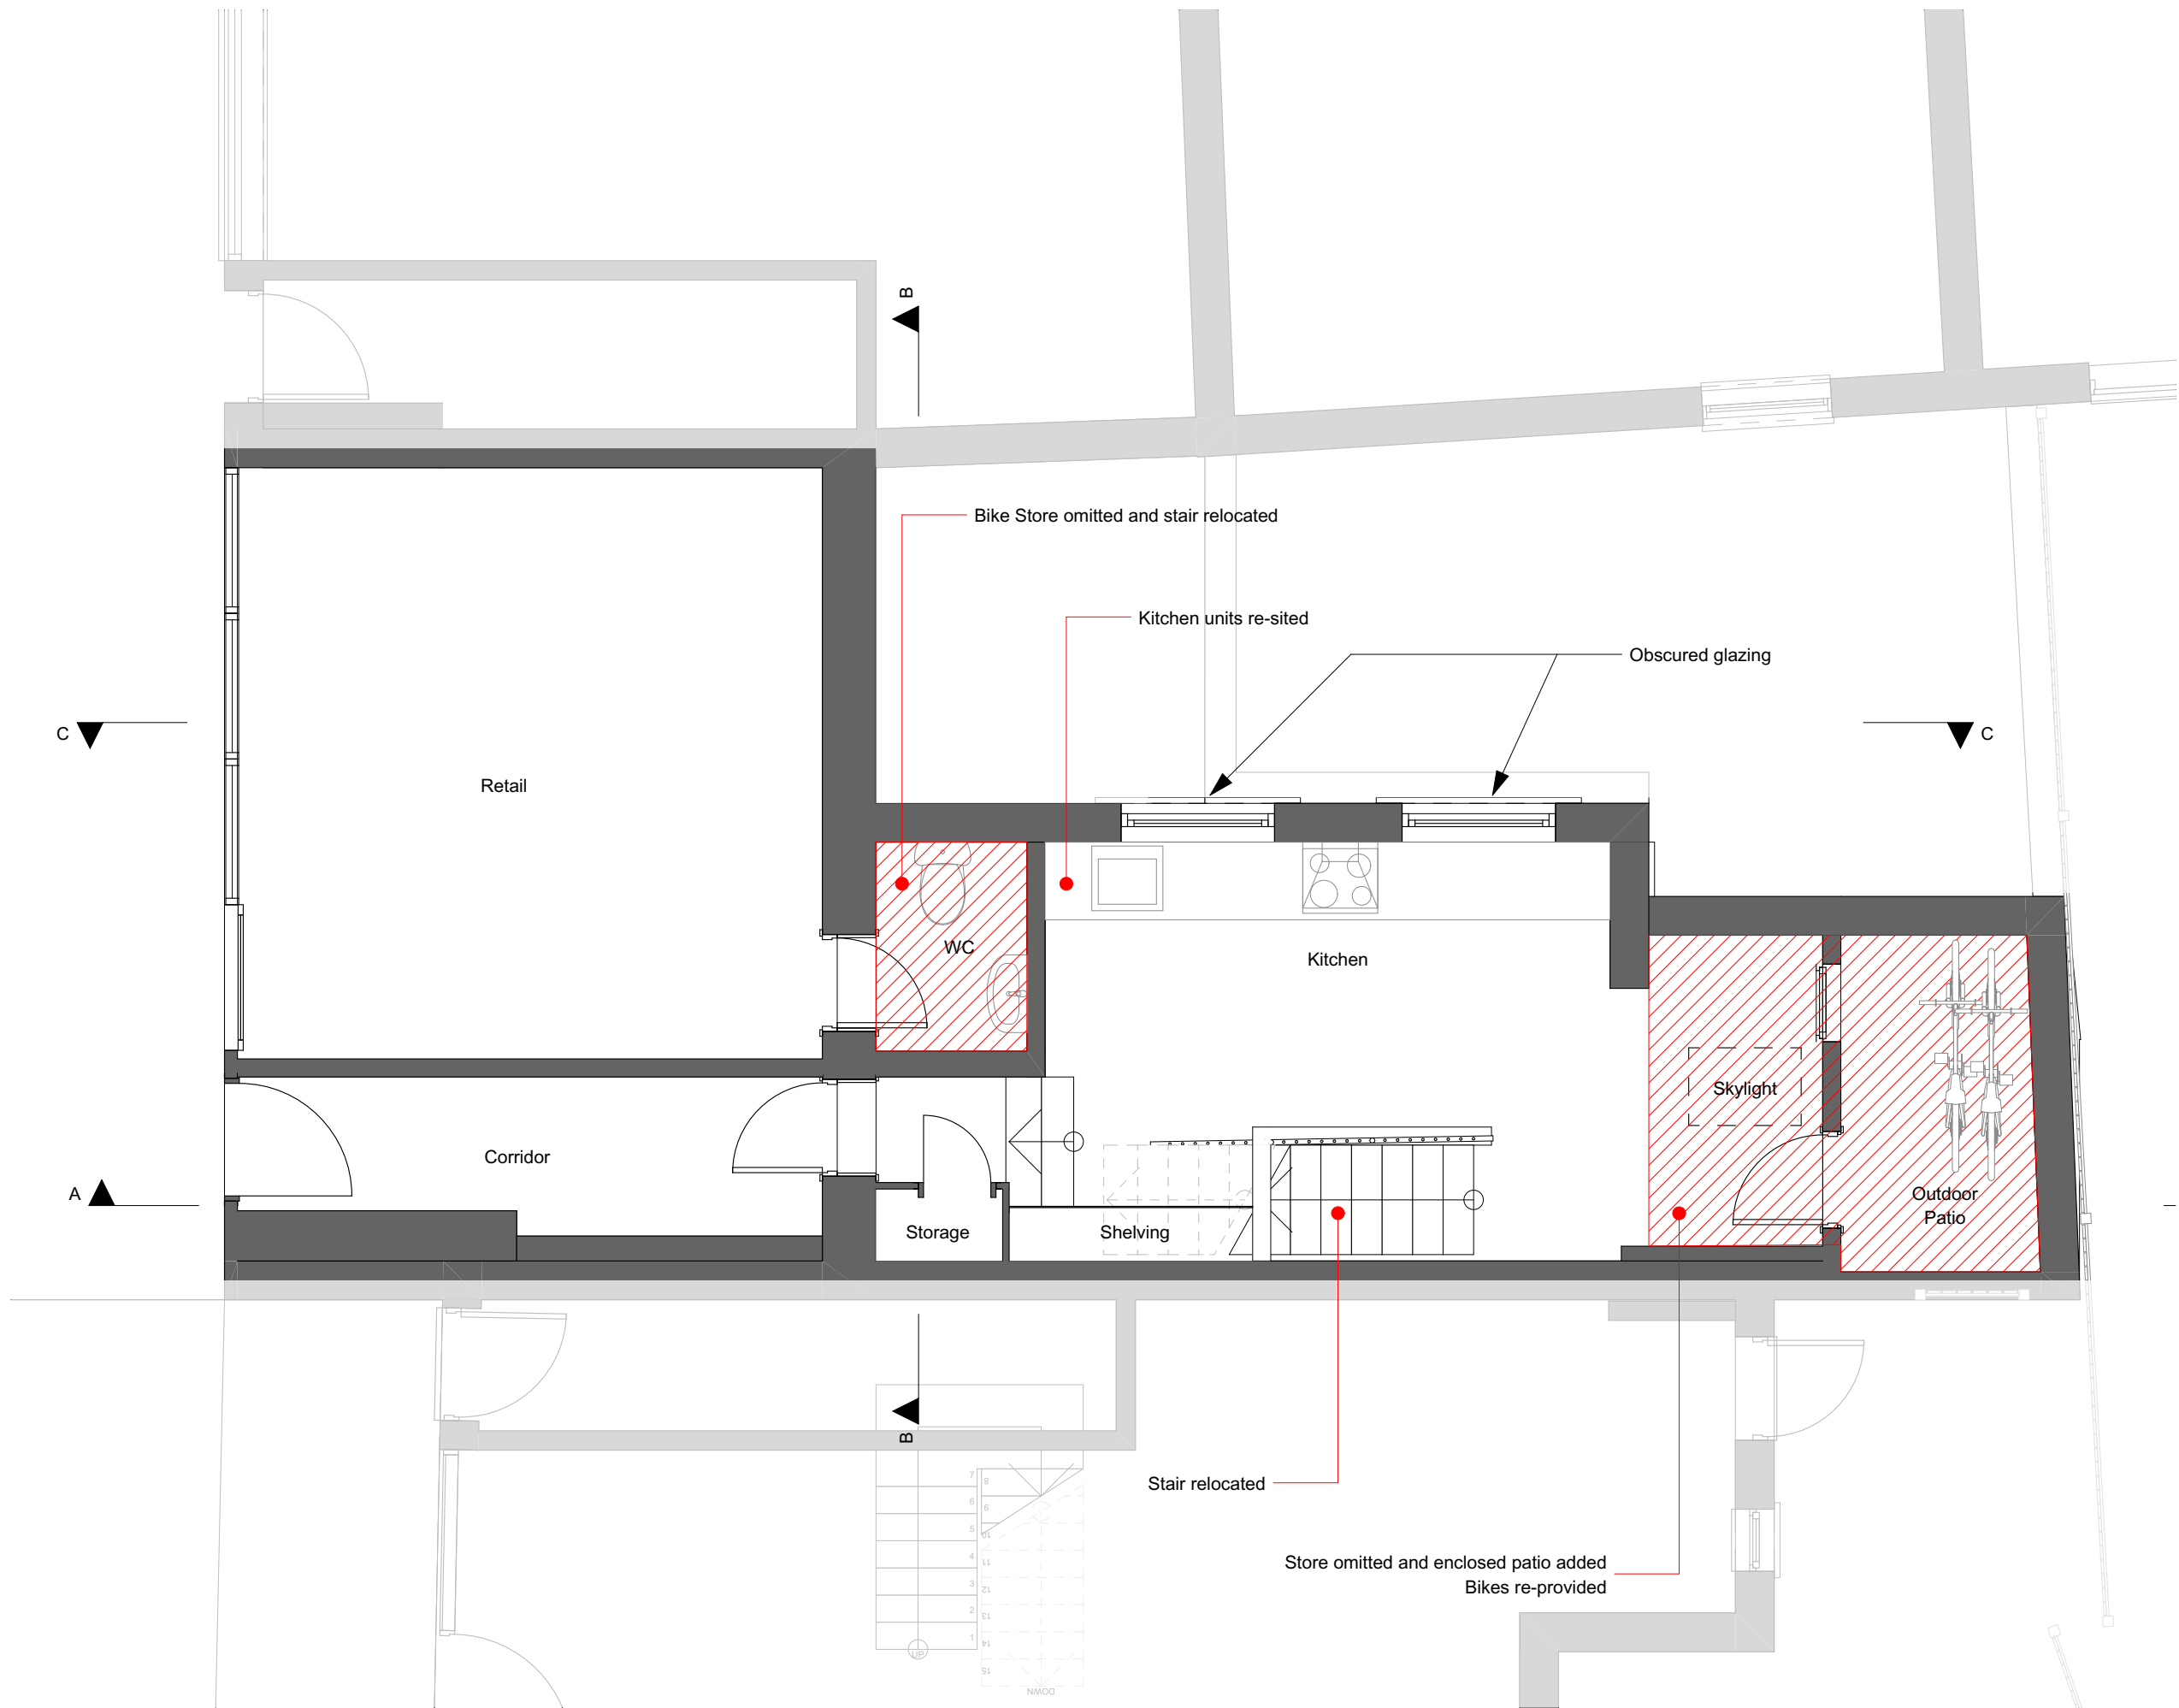

**Notes**  
Do not scale from this drawing. To be read in conjunction with all relevant Architects', Services and Structural Engineers' information. Architect to be immediately notified of discrepancies. Copyright belongs to Urbanist Architecture Ltd.

- Boundary Line
- Area Amended

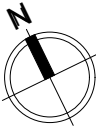

**Urbanist Architecture**

2 Little Thames Walk London SE8 3FB

Tel: 0203 793 7878

info@urbanistarchitecture.co.uk

www.urbanistarchitecture.co.uk

**Project Description**

**Site Address**

128 Camden Road London NW1 9EE

**Drawing Name**

Plans As built  
Ground Floor

**Drawing Status:** Planning

**Scale:** 1/50 @A3


**Drawn:** SMC

**Date:** 24/05/2024

**Checked:** BS

**Drawing no**


project	originator	zone	level	type	role	no.	rev
215-	-	URB	-	ZZ	-	00 - DR - A -102103-	R1 NW19EE

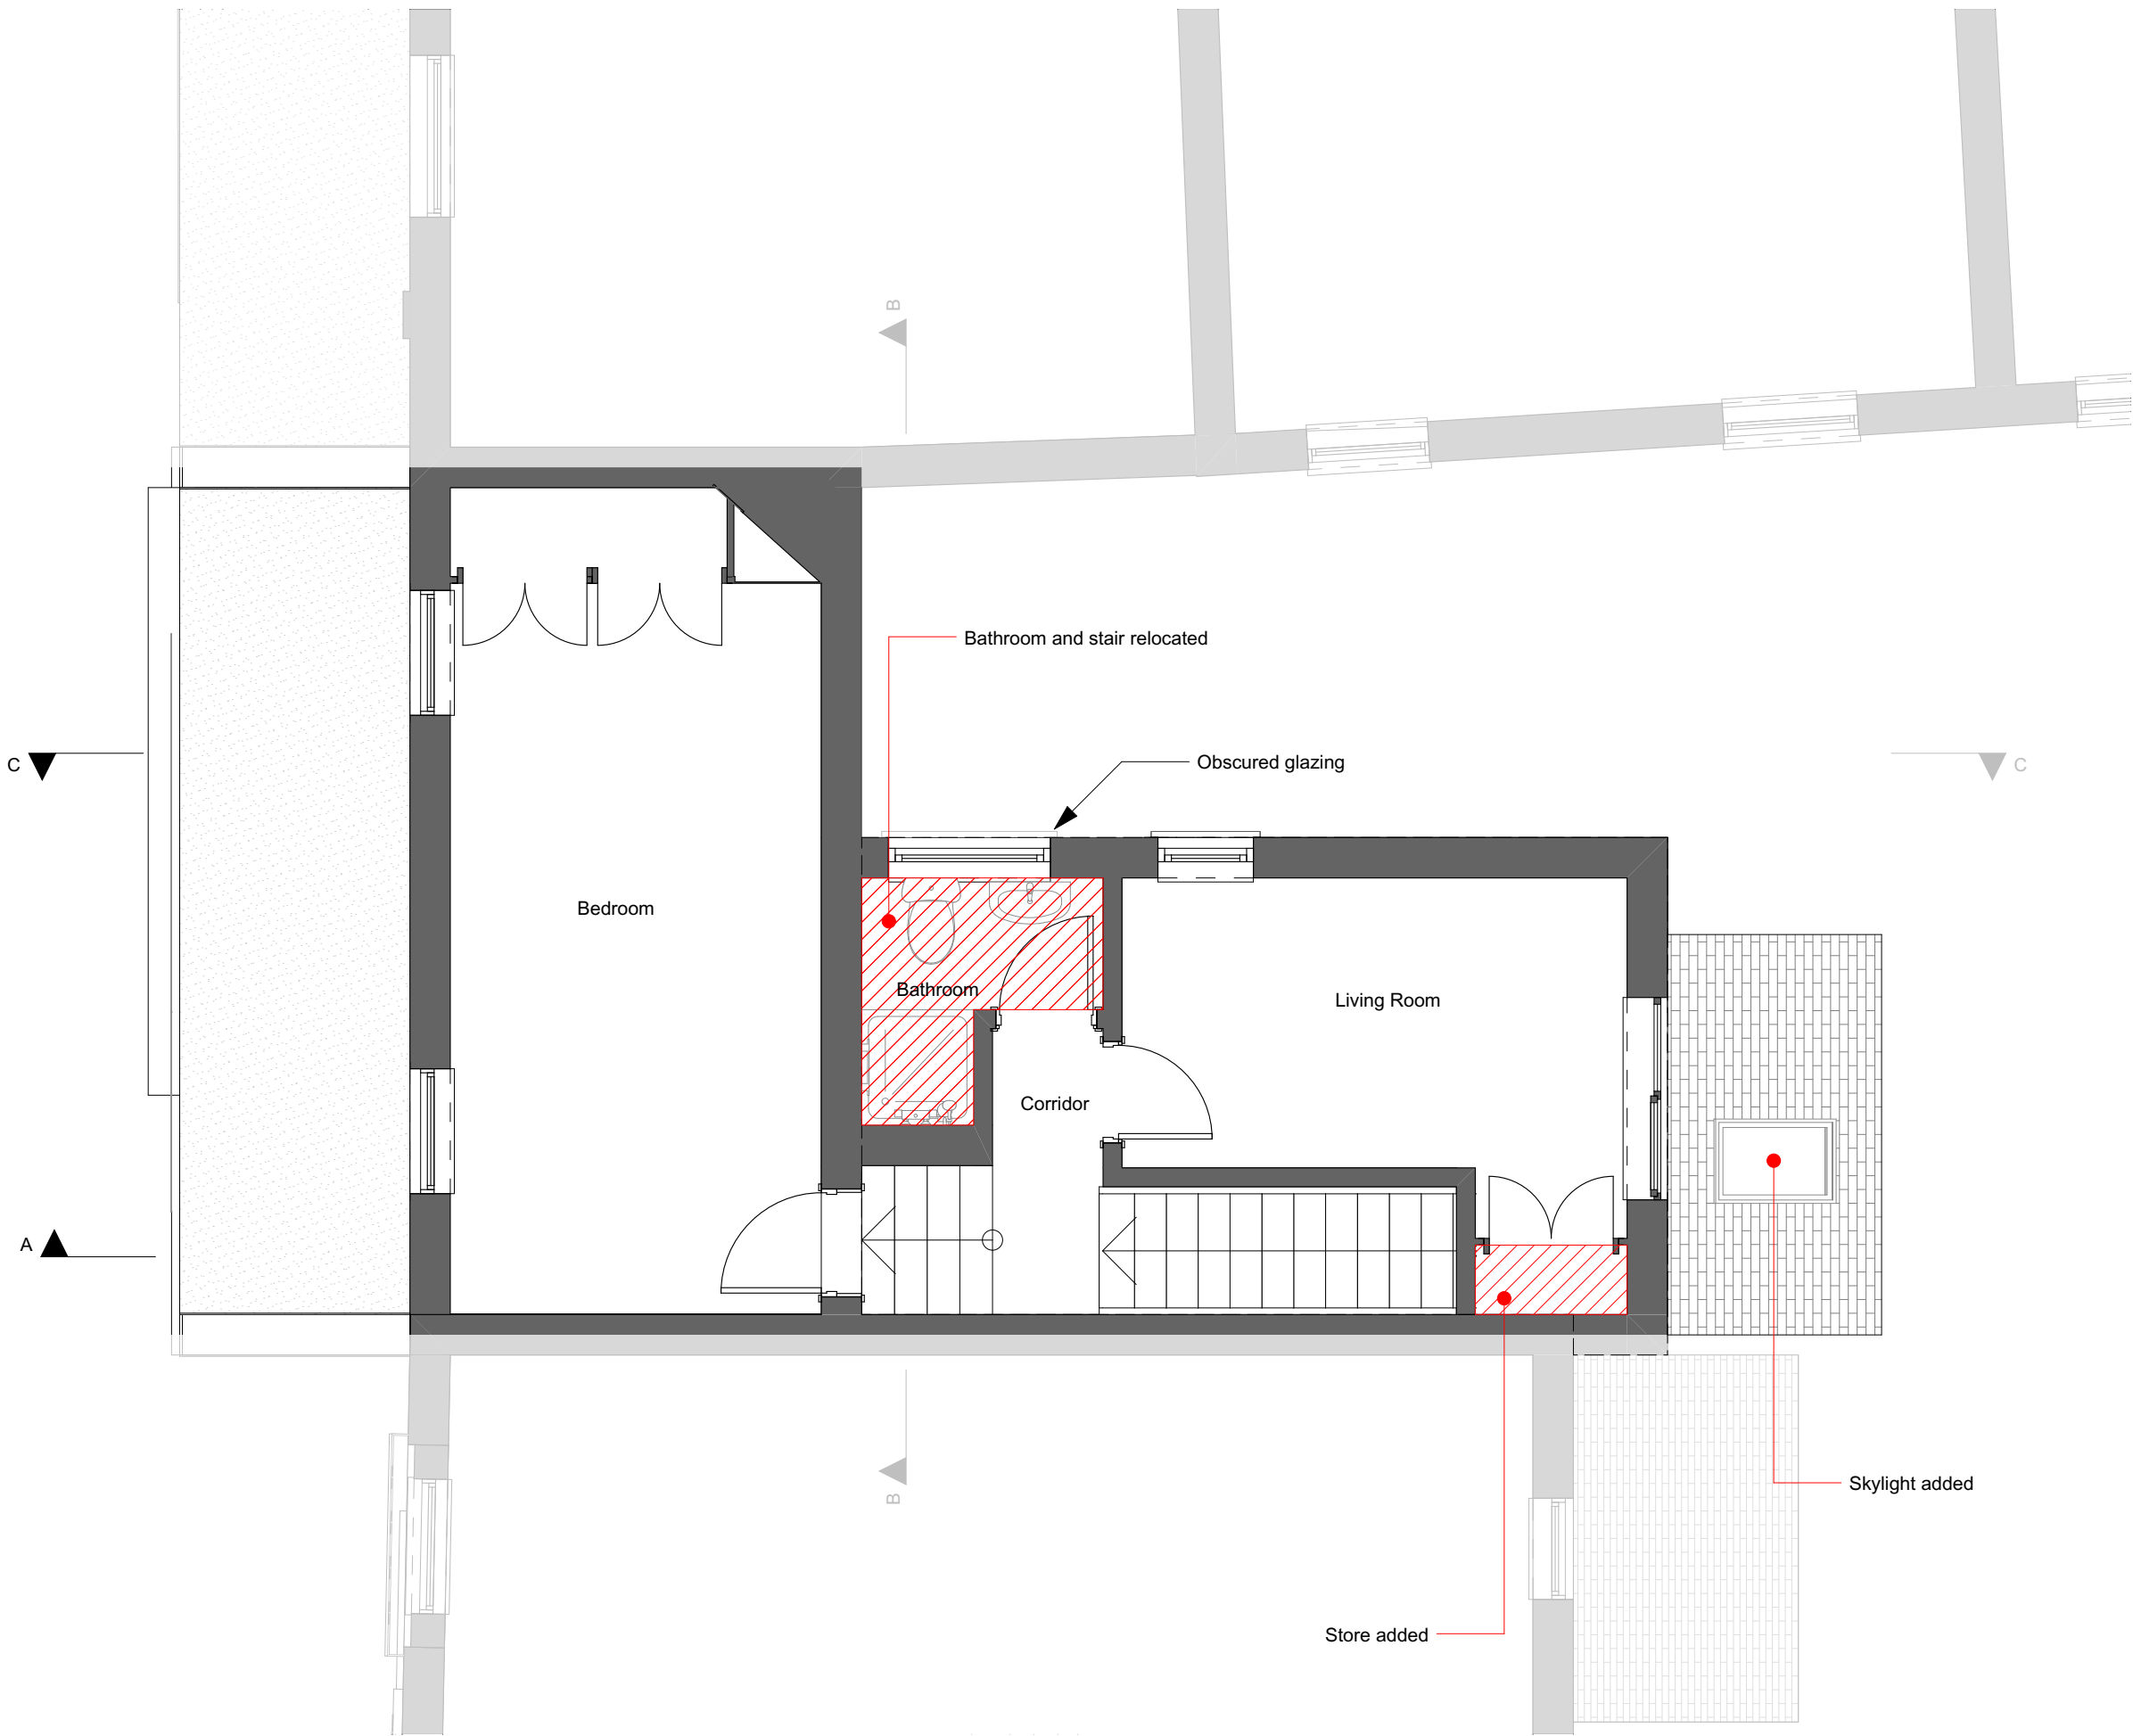

**Notes**  
Do not scale from this drawing. To be read in conjunction with all relevant Architects', Services and Structural Engineers' information. Architect to be immediately notified of discrepancies. Copyright belongs to Urbanist Architecture Ltd.

--- Boundary Line

Area Amended

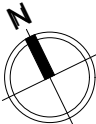

**Urbanist Architecture**

2 Little Thames Walk London SE8 3FB

Tel: 0203 793 7878

info@urbanistarchitecture.co.uk

www.urbanistarchitecture.co.uk

**Project Description**

**Site Address**

128 Camden Road London NW1 9EE

**Drawing Name**

Plans As built  
First Floor

**Drawing Status:** Planning

**Scale:** 1/50 @A3

**Drawn:** SMC


**Date:** 24/05/2024


**Checked:** BS

**Drawing no**

project	originator	zone	level	type	role	no.	rev
215-	-	URB	-	ZZ	-	01 - DR - A	-102104- R1 NW19EE


First Floor  
Scale: 1:50

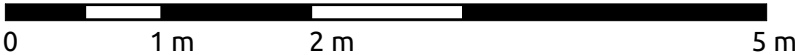

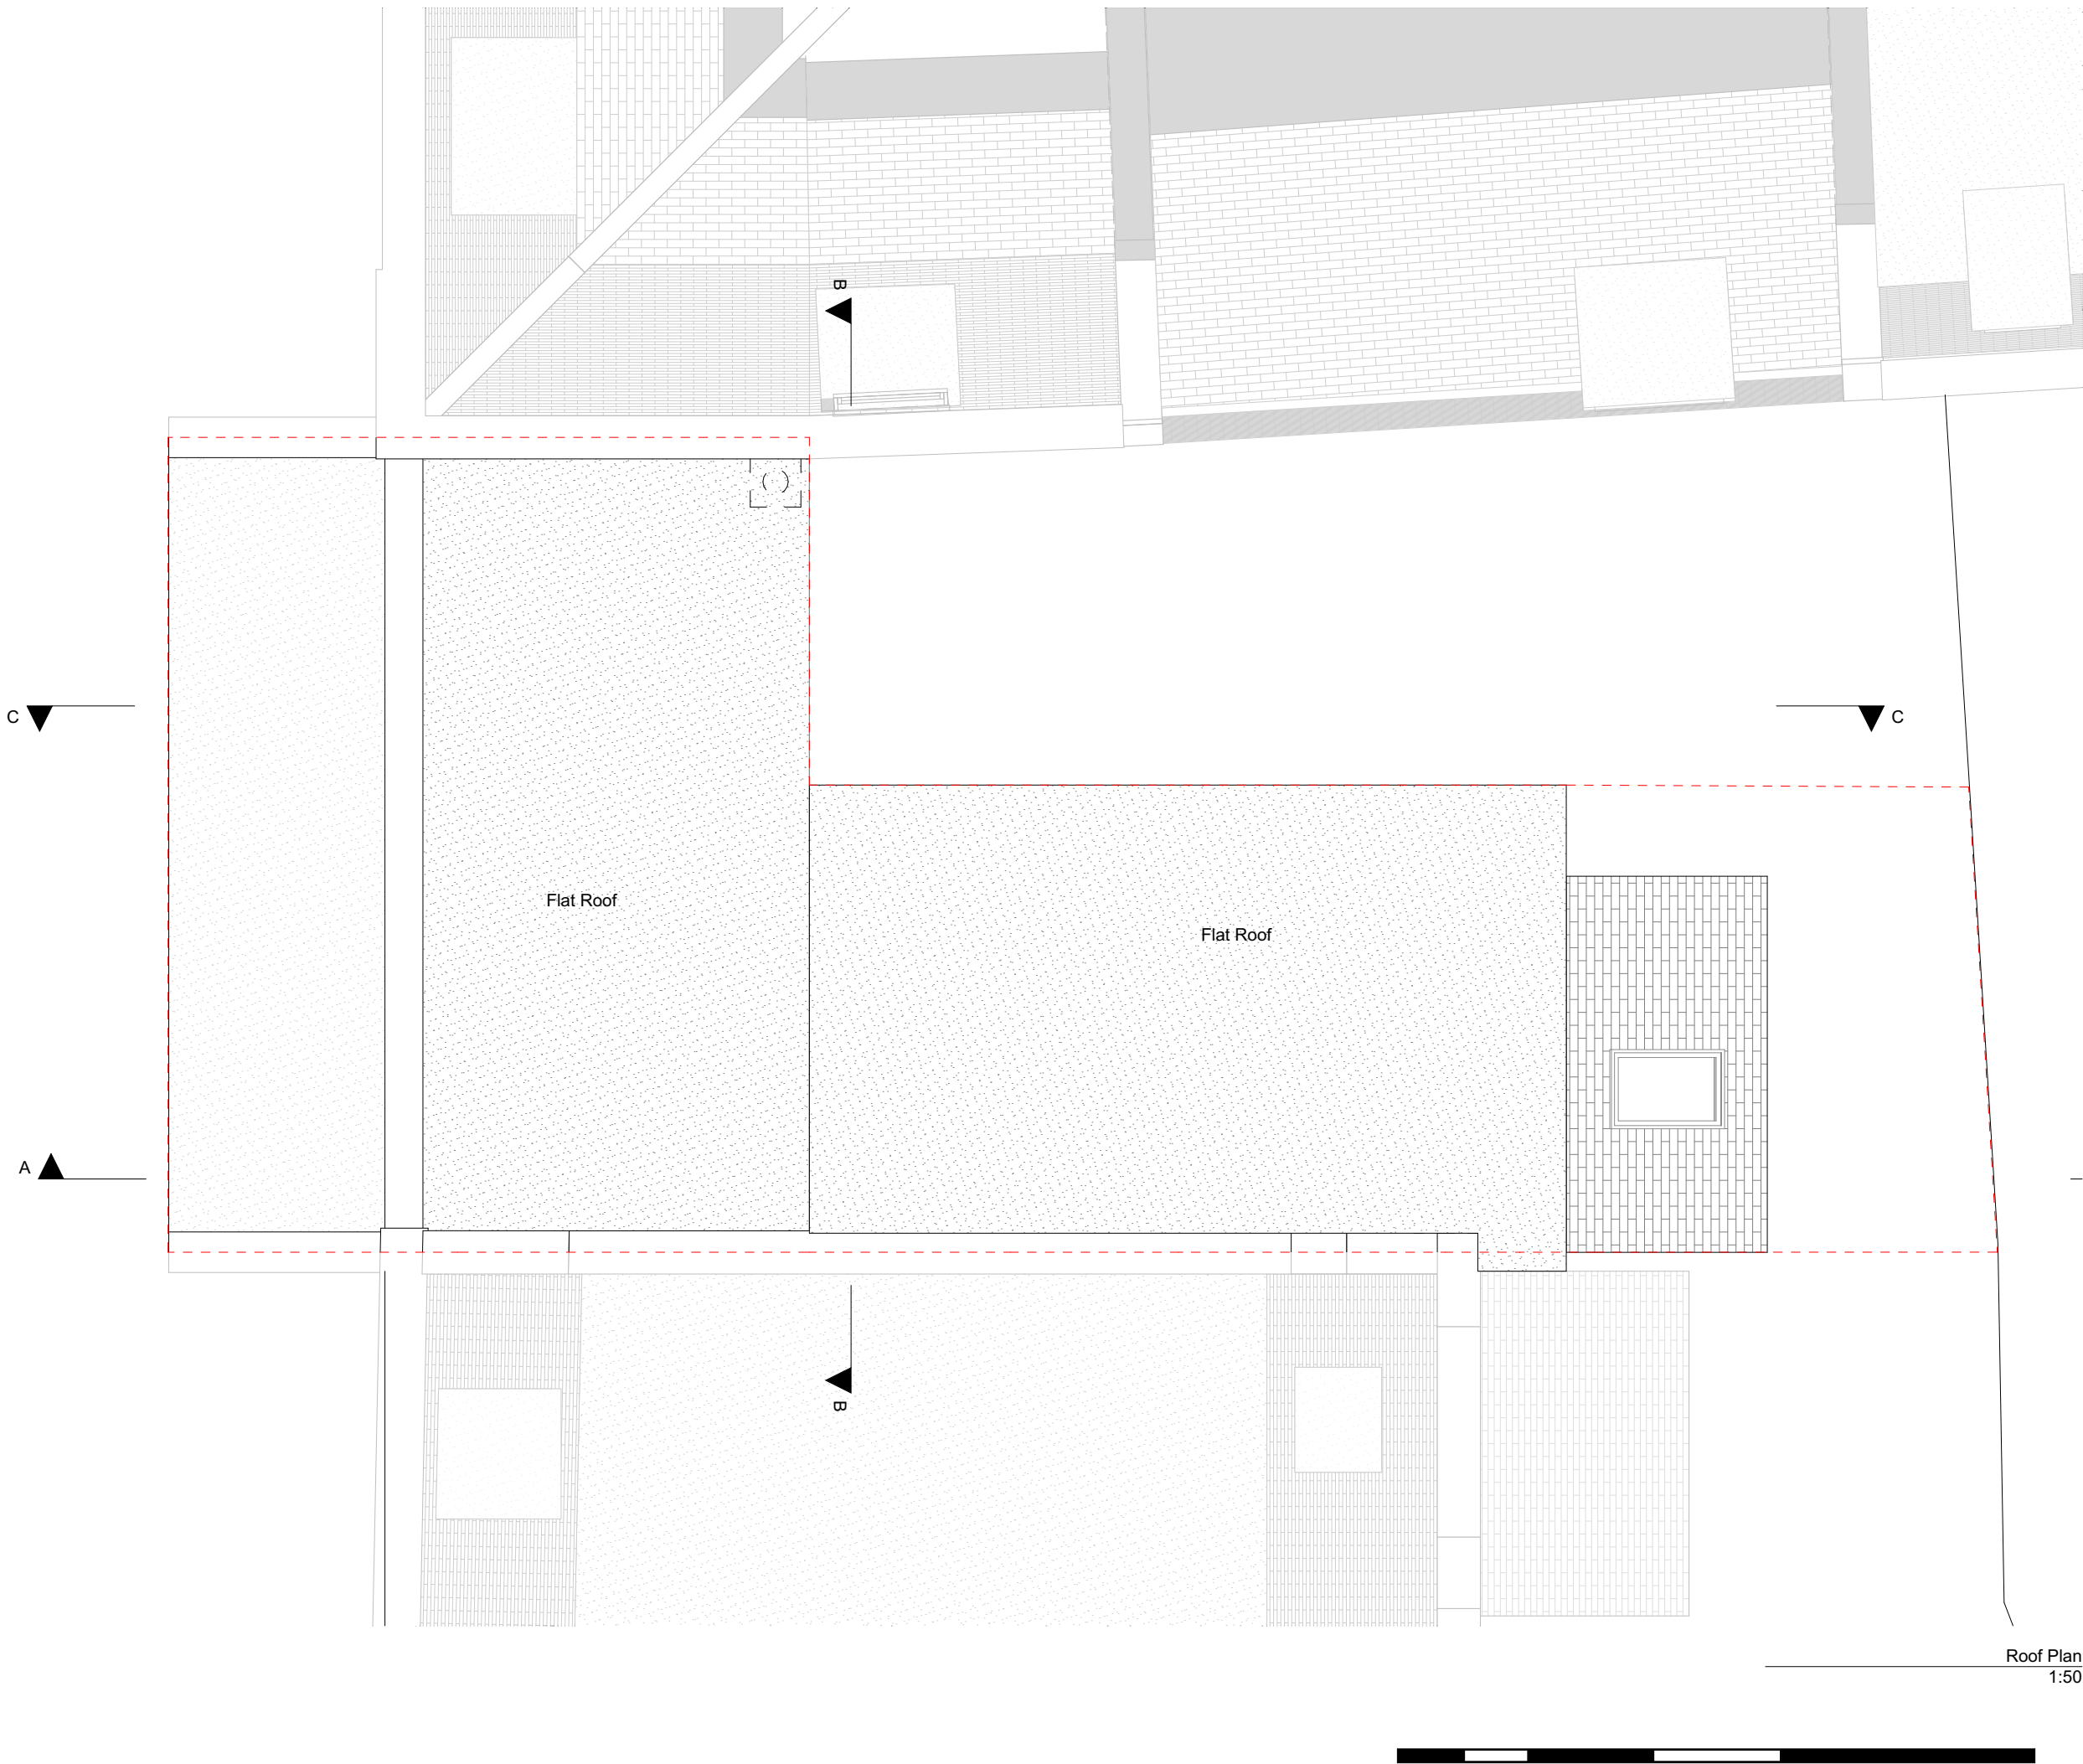

**Notes**  
Do not scale from this drawing. To be read in conjunction with all relevant Architects', Services and Structural Engineers' information. Architect to be immediately notified of discrepancies. Copyright belongs to Urbanist Architecture Ltd.

--- Boundary Line

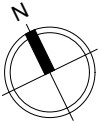

**Urbanist Architecture**  
2 Little Thames Walk London SE8 3FB  
Tel: 0203 793 7878  
info@urbanistarchitecture.co.uk  
www.urbanistarchitecture.co.uk

**Project Description**

**Site Address**  
128 Camden Road London NW1 9EE

**Drawing Name**  
Plans As built  
Roof Plan


**Drawing Status:** Planning

**Scale:** 1/50 @A3 **Drawn:** SMC  
**Date:** 24/05/2024 **Checked:** BS

Drawing no							
project	originator	zone	level	type	role	no.	rev
215-	-	URB	-	ZZ	-	02 - DR - A	-102105- R1 NW19EE

**Notes**  
Do not scale from this drawing. To be read in conjunction with all relevant Architects', Services and Structural Engineers' information. Architect to be immediately notified of discrepancies. Copyright belongs to Urbanist Architecture Ltd.

- - - Boundary Line

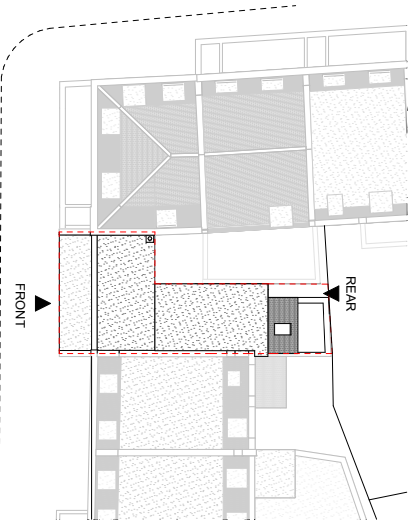

**Urbanist Architecture**  
2 Little Thames Walk London SE8 3FB  
Tel: 0203 793 7878  
info@urbanistarchitecture.co.uk  
www.urbanistarchitecture.co.uk

**Project Description**

**Site Address**  
128 Camden Road London NW1 9EE

**Drawing Name**  
Elevations As Built  
As Built Front Elevation

**Drawing Status:** Planning


**Scale:** 1/100 @A3 **Drawn:** SMC  
**Date:** 24/05/2024 **Checked:** BS

Drawing no							
project	originator	zone	level	type	role	no.	rev
215-	-	URB	-	ZZ	-	XX - DR - A -102201-	R1 NW19EE



**Notes**  
Do not scale from this drawing. To be read in conjunction with all relevant Architects', Services and Structural Engineers' information. Architect to be immediately notified of discrepancies. Copyright belongs to Urbanist Architecture Ltd.

- - - - Boundary Line

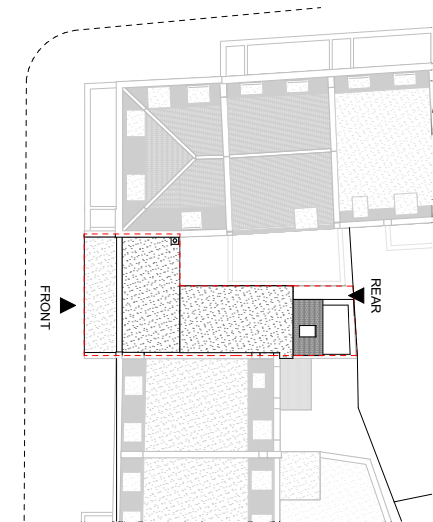

**Urbanist Architecture**

2 Little Thames Walk London SE8 3FB  
Tel: 0203 793 7878  
info@urbanistarchitecture.co.uk  
www.urbanistarchitecture.co.uk

**Project Description**


**Site Address**  
128 Camden Road London NW1 9EE

**Drawing Name**  
Elevations As Built  
As Built Rear Elevation


**Drawing Status:** Planning

**Scale:** 1/100 @A3 **Drawn:** SMC  
**Date:** 24/05/2024 **Checked:** BS

Drawing no							
project	originator	zone	level	type	role	no.	rev
215-	-	URB	-	ZZ	-	XX	-
DR	-	A	-	102202-	R1	NW19EE	


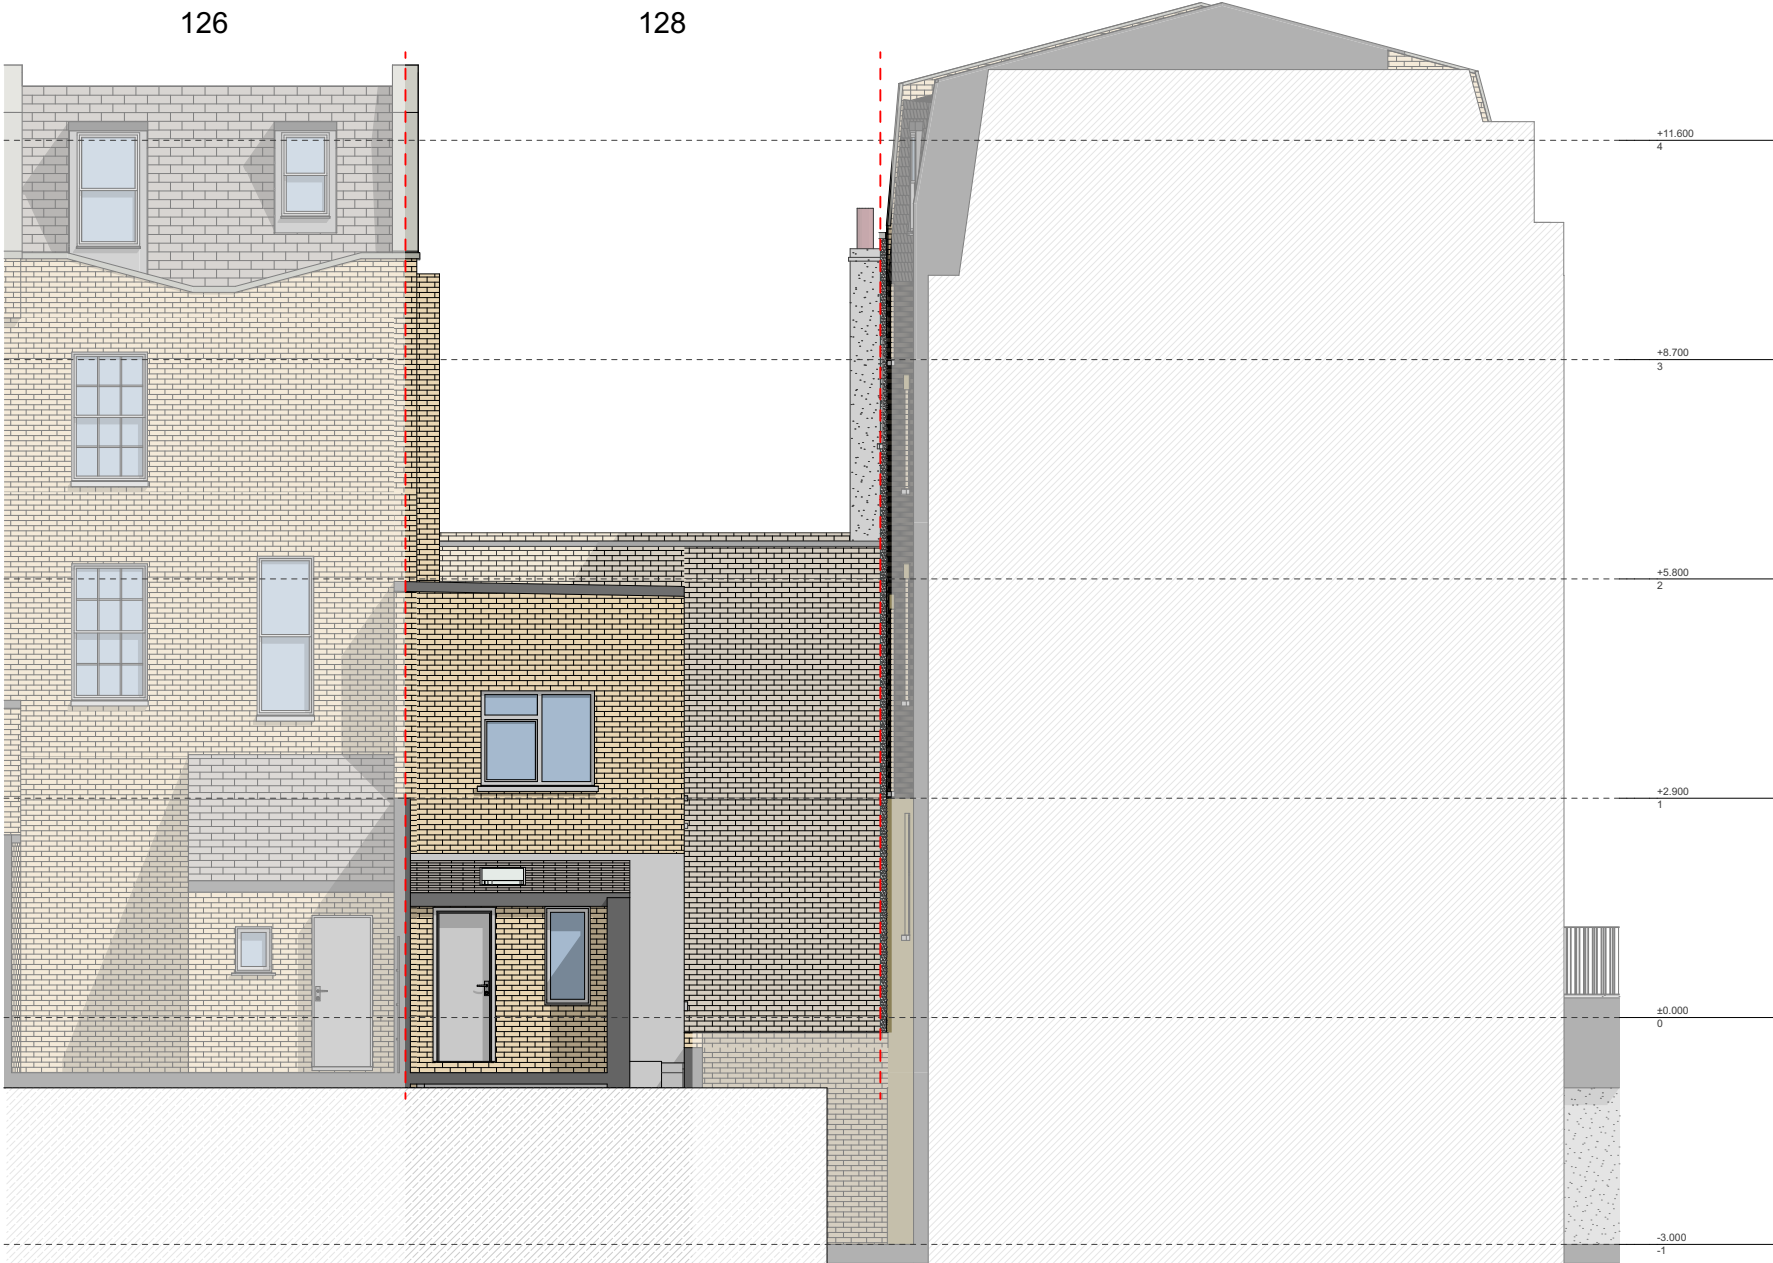


As Built Rear Elevation  
1:100

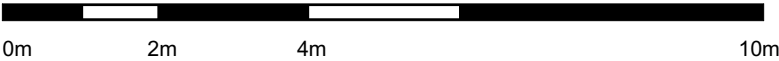


**Notes**  
Do not scale from this drawing. To be read in conjunction with all relevant Architects', Services and Structural Engineers' information. Architect to be immediately notified of discrepancies. Copyright belongs to Urbanist Architecture Ltd.

- - - Boundary Line

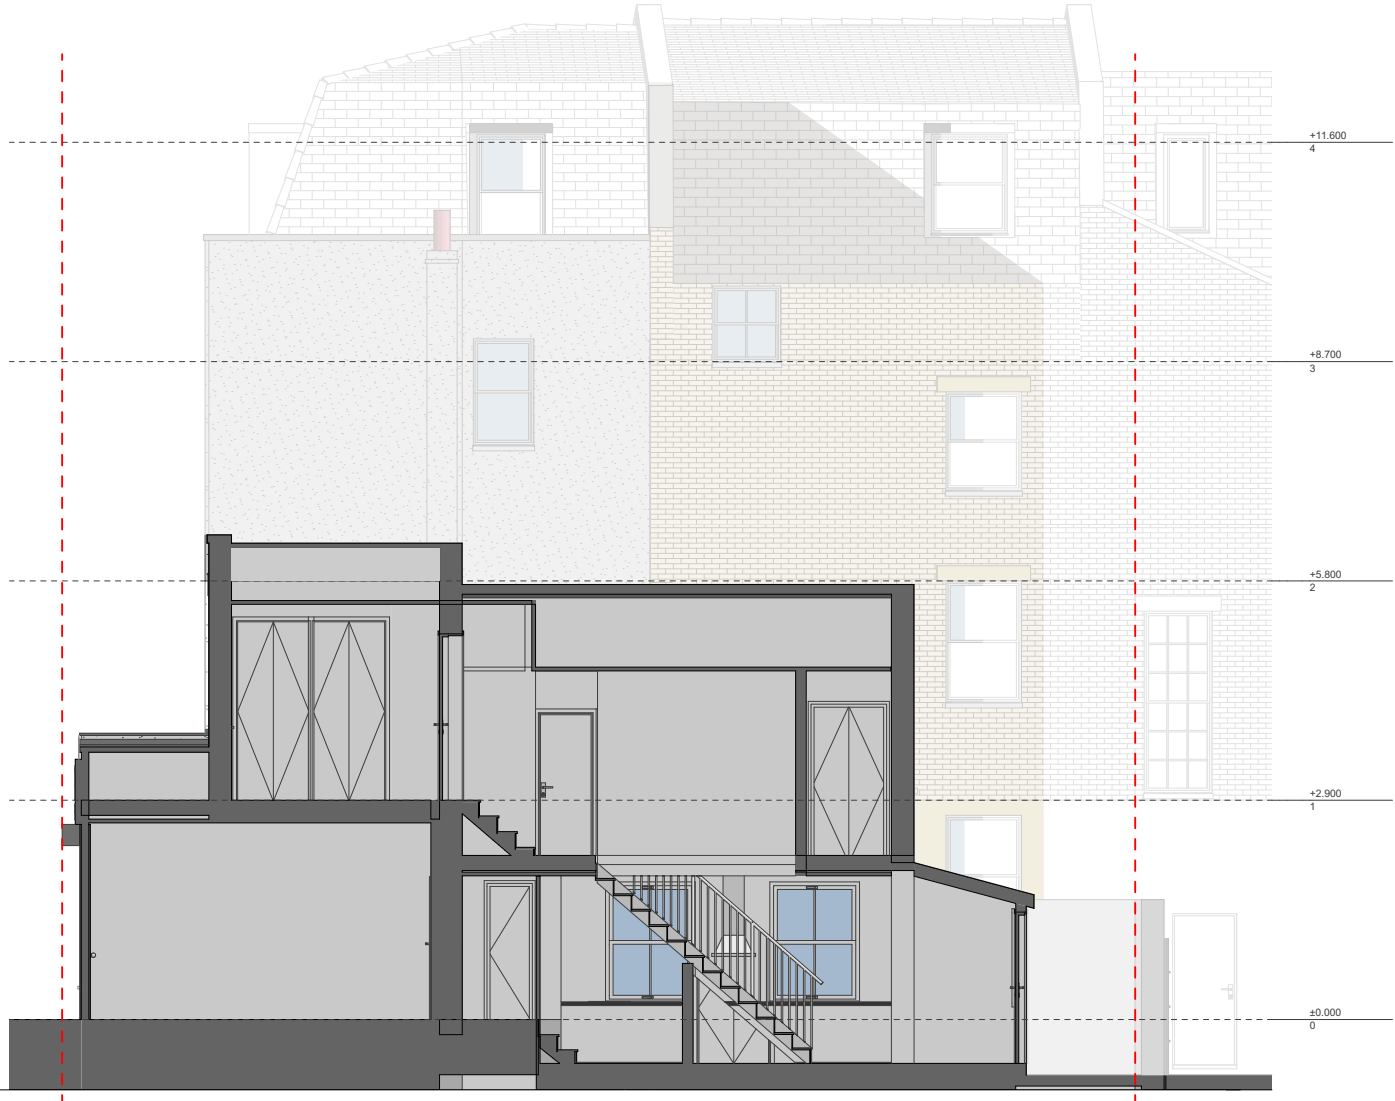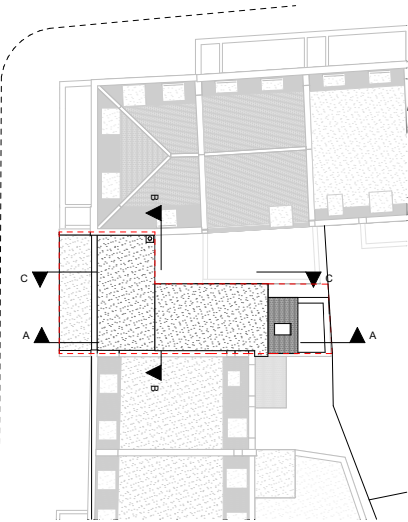

As Built Building Section AA  
Scale: 1:100

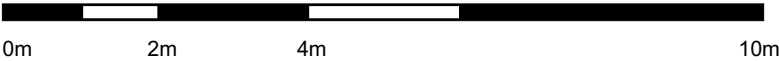

**Urbanist Architecture**  
2 Little Thames Walk London SE8 3FB  
Tel: 0203 793 7878  
info@urbanistarchitecture.co.uk  
www.urbanistarchitecture.co.uk

**Project Description**

**Site Address**  
128 Camden Road London NW1 9EE

**Drawing Name**  
Sections As Built  
As Built Building Section AA


**Drawing Status:** Planning

**Scale:** 1/100 @A3 **Drawn:** SMC  
**Date:** 24/05/2024 **Checked:** BS

Drawing no							
project	originator	zone	level	type	role	no.	rev
215-	-	URB	-	ZZ	-	XX - DR - A	-102301- R1 NW19EE

**Notes**  
Do not scale from this drawing. To be read in conjunction with all relevant Architects', Services and Structural Engineers' information. Architect to be immediately notified of discrepancies. Copyright belongs to Urbanist Architecture Ltd.

- - - - Boundary Line

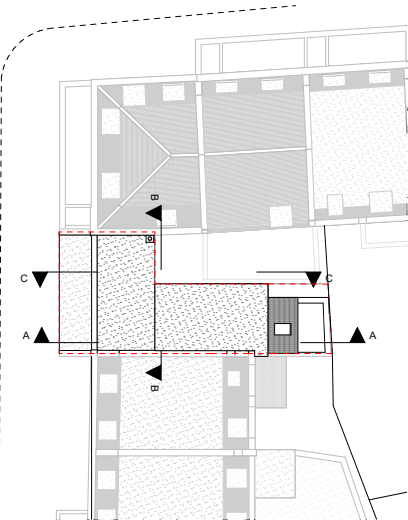

**Urbanist Architecture**  
2 Little Thames Walk London SE8 3FB  
Tel: 0203 793 7878  
info@urbanistarchitecture.co.uk  
www.urbanistarchitecture.co.uk

**Project Description**


**Site Address**  
128 Camden Road London NW1 9EE

**Drawing Name**  
Sections As Built  
As Built Building Section BB, As Built Building Section CC


**Drawing Status:** Planning

**Scale:** 1/100 @A3 **Drawn:** SMC  
**Date:** 24/05/2024 **Checked:** BS

Drawing no							
project	originator	zone	level	type	role	no.	rev
215-	URB	ZZ	XX	DR	A	-102302-	R1 NW19EE

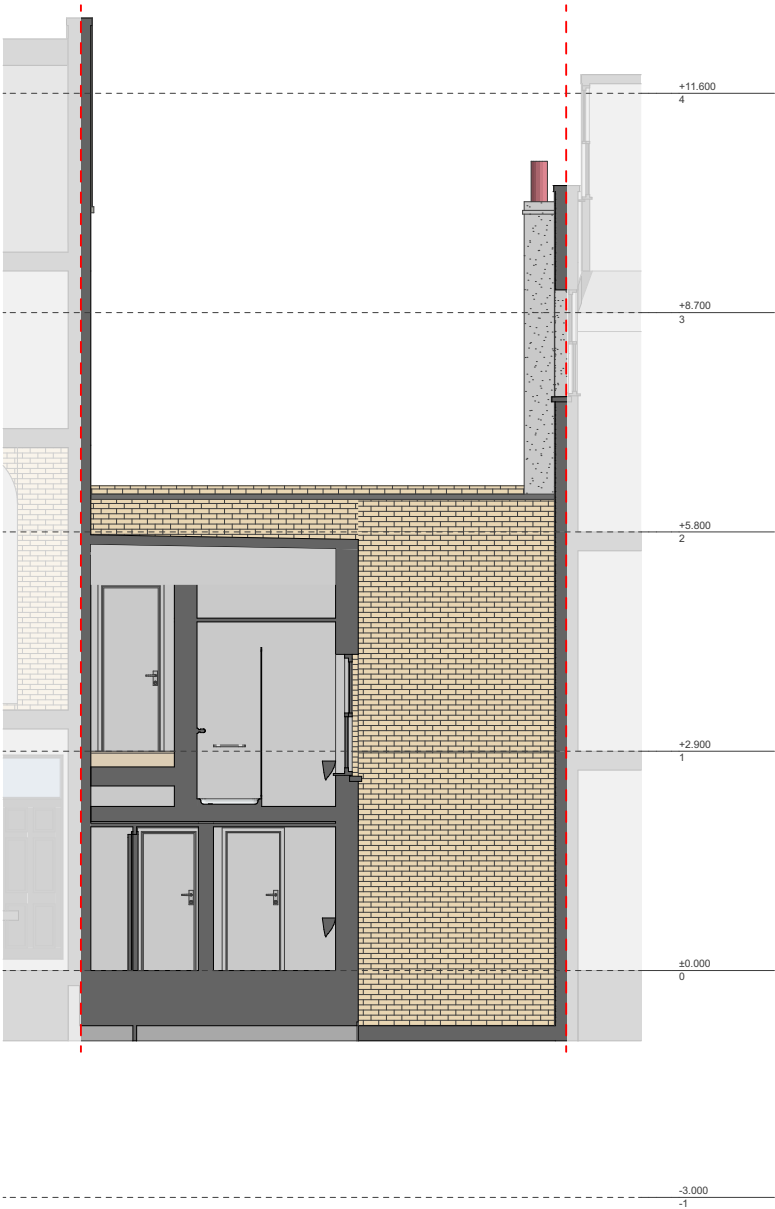

As Built Building Section BB  
Scale: 1:100

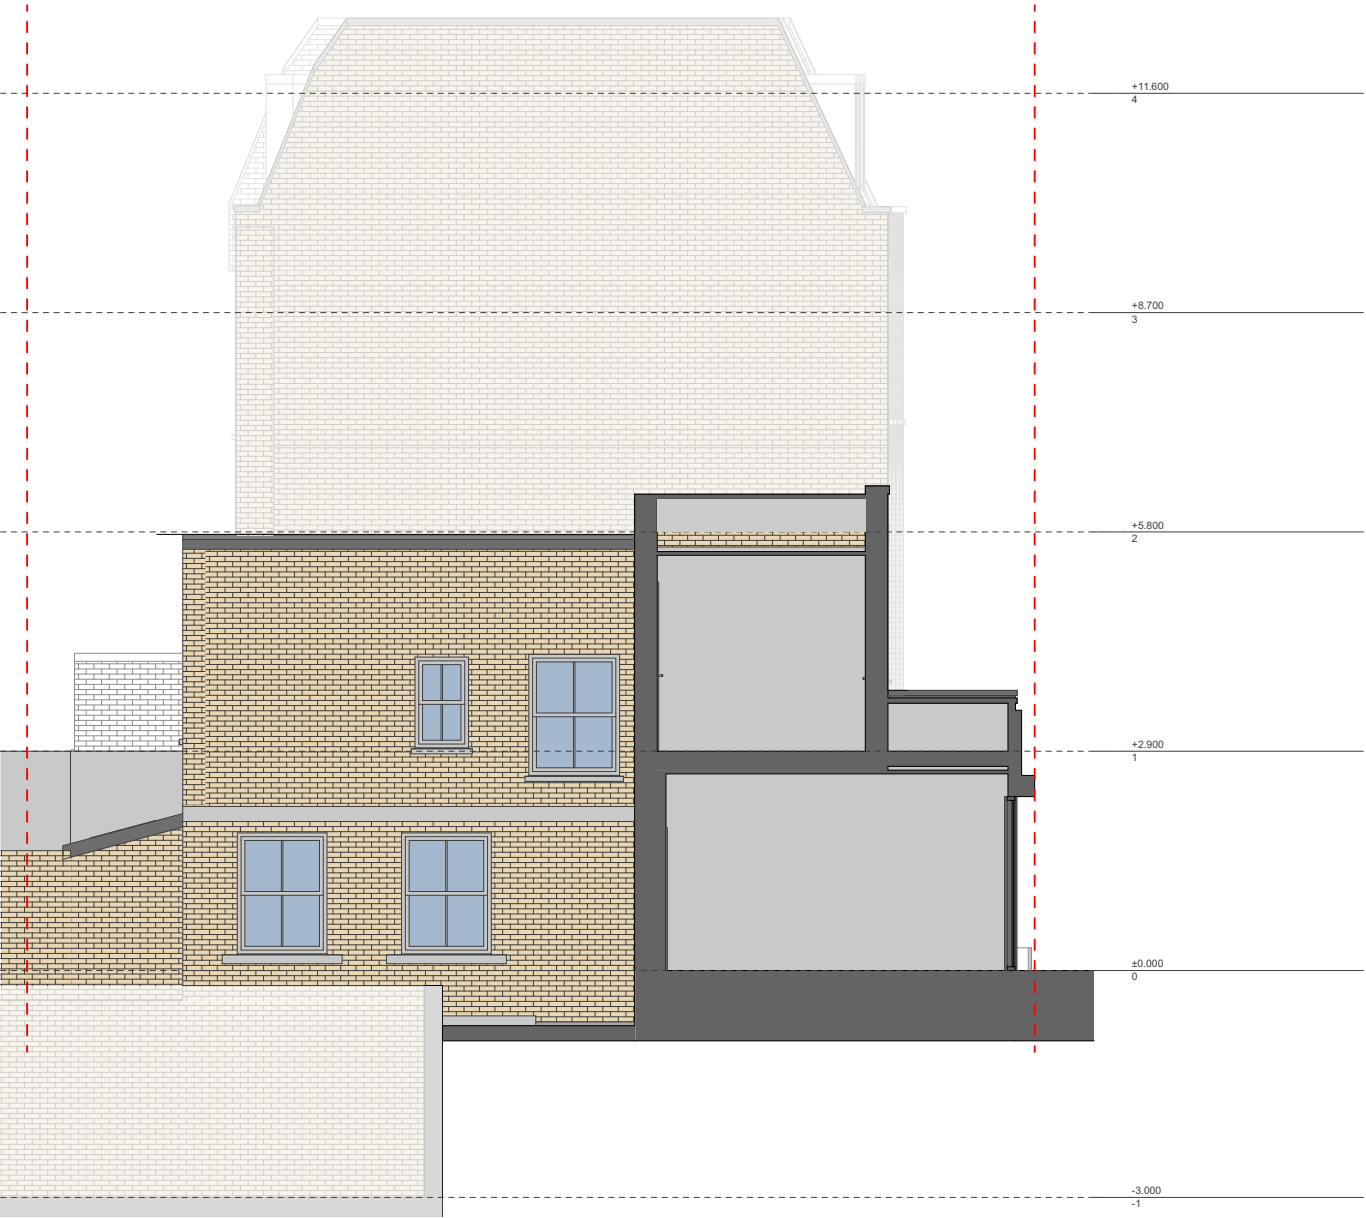

As Built Building Section CC  
Scale: 1:100

