

NOTES

1. Do not scale from this drawing.
2. All dimensions are given in millimetres unless otherwise stated.
3. Report all drawing errors, omissions and discrepancies to the architect/designer.

KASIA WHITFIELD DESIGN

KASIAWHITFIELD@GMAIL.COM
T: 020 77865652
M: 0788503533


JOB#

9A BELSIZE SQUARE
LONDON NW3 4HT

TITLE
SIDE ELEVATIONS (WEST & EAST)
AS CONSTRUCTED

DATE	SCALE	STATUS
2024.06.10	1:100@A3	PLANNING
PROJECT NO.	DRAWING NO.	REVISION

BS9/3 PP03

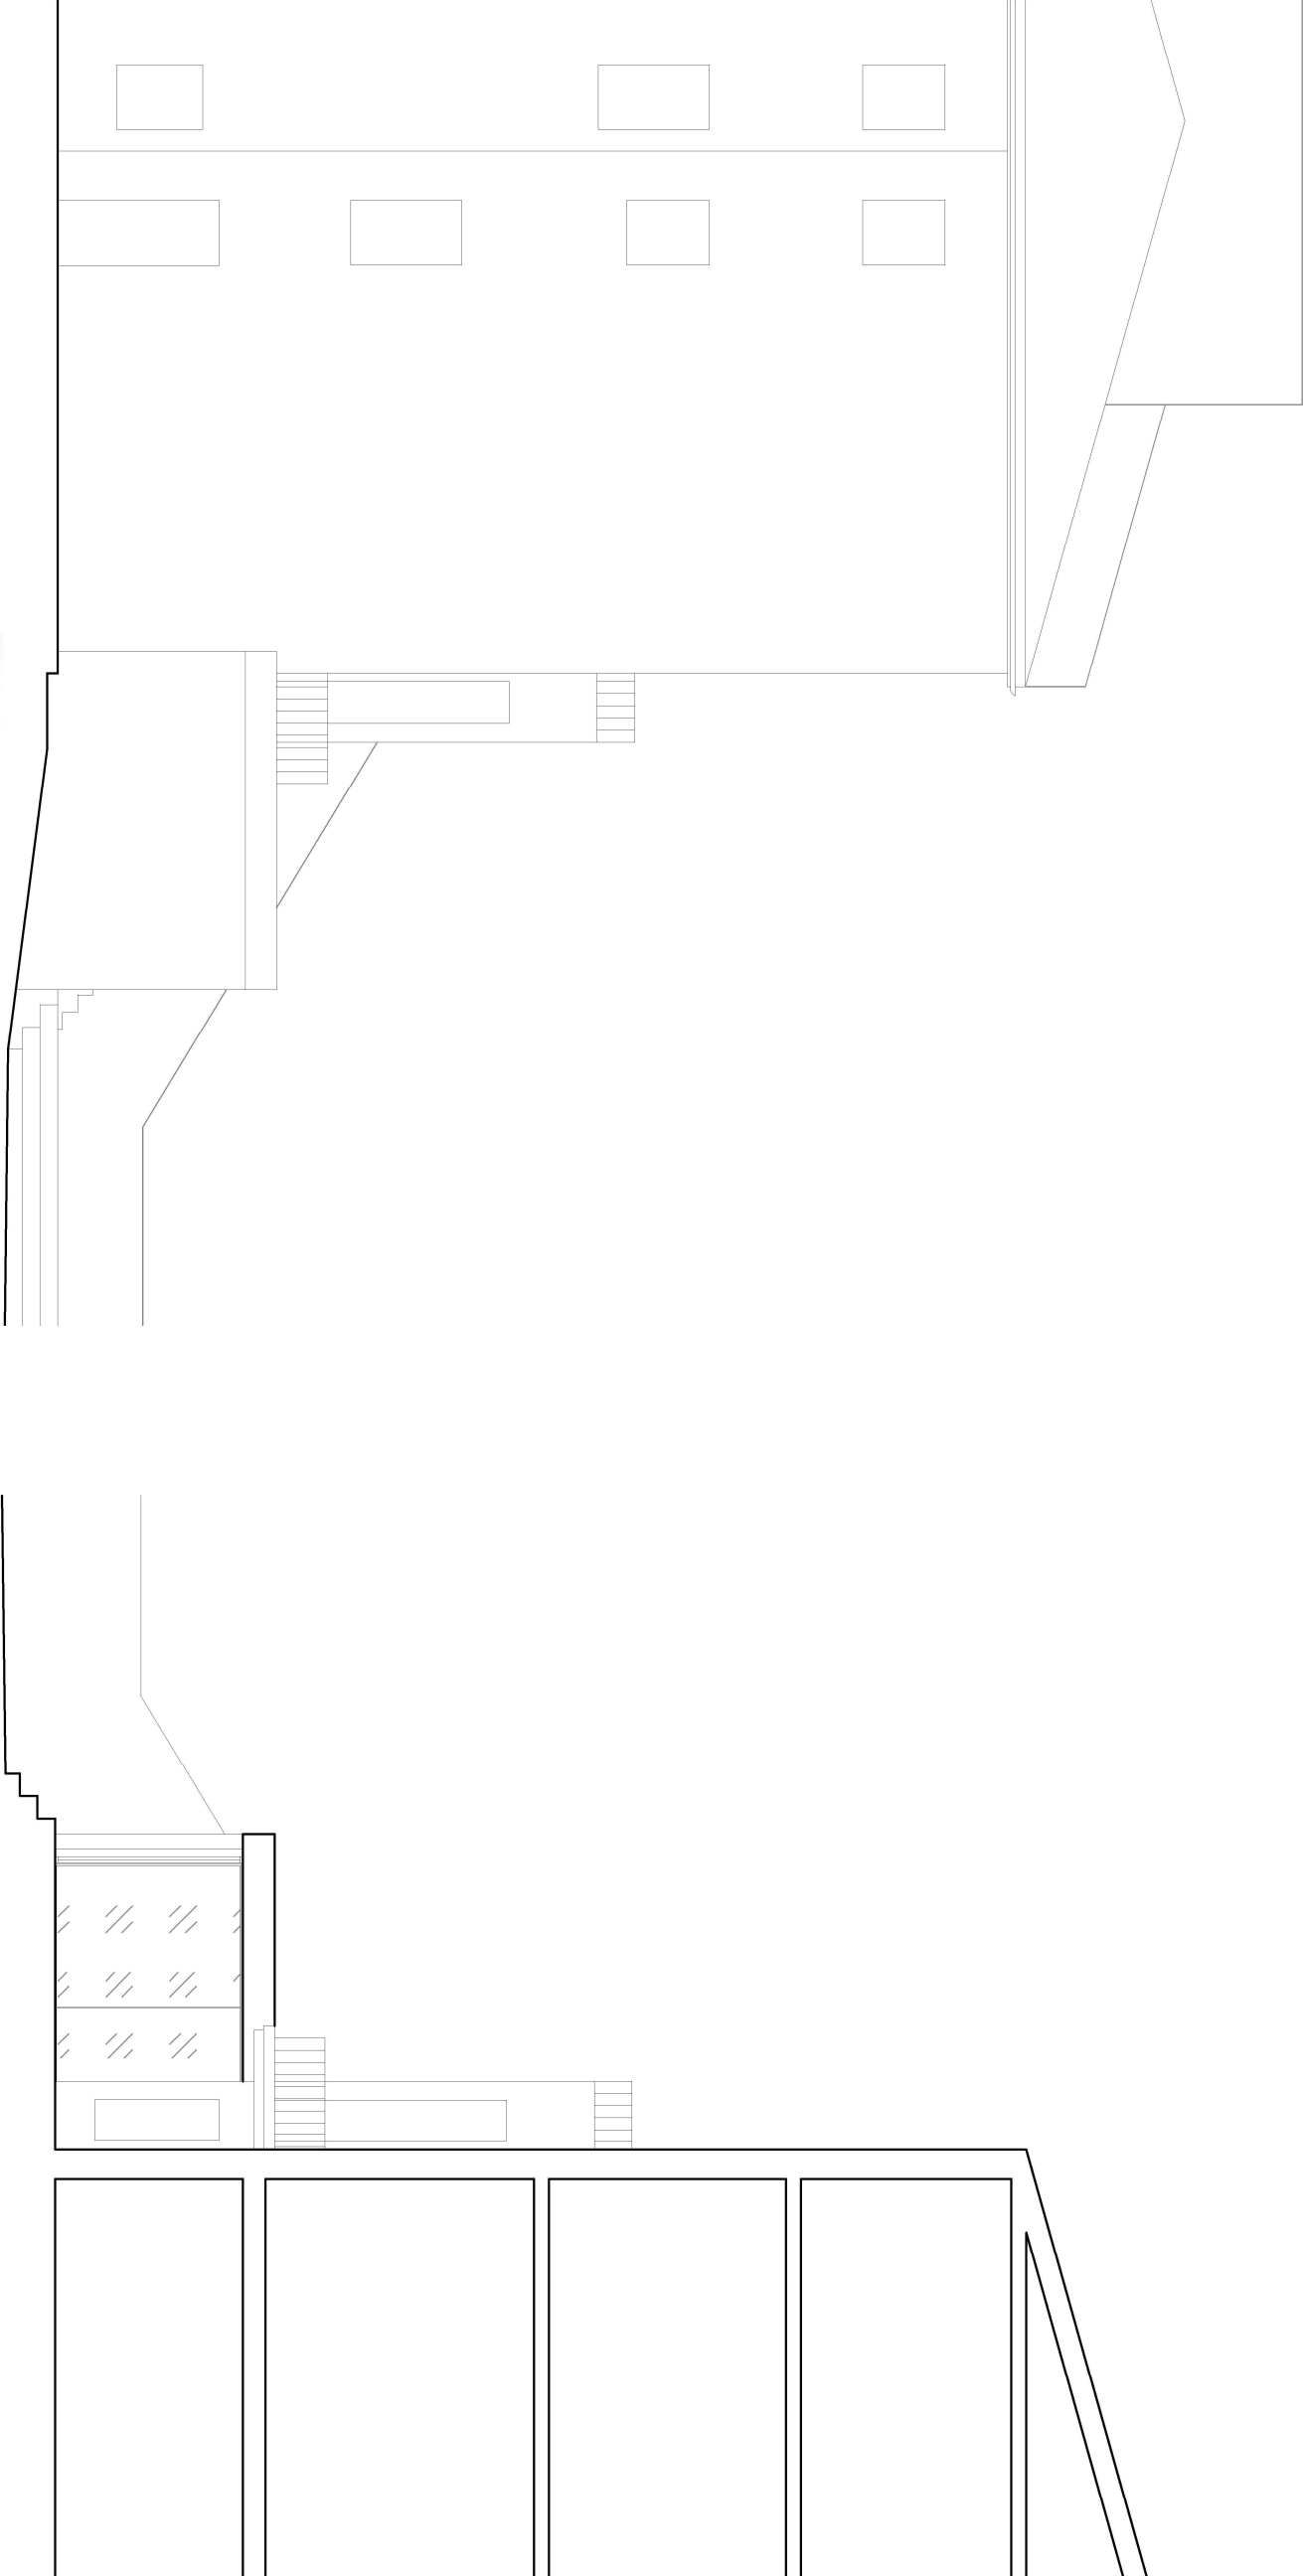

WALLS TO BE RENDERED AND PAINTED
TO RESEMBLE AS CLOSELY AS POSSIBLE, IN COLOUR AND TEXTURE
THE FINISH OF THE MAIN BUILDING