



30 LIVE JOY 250 LIVE JOY

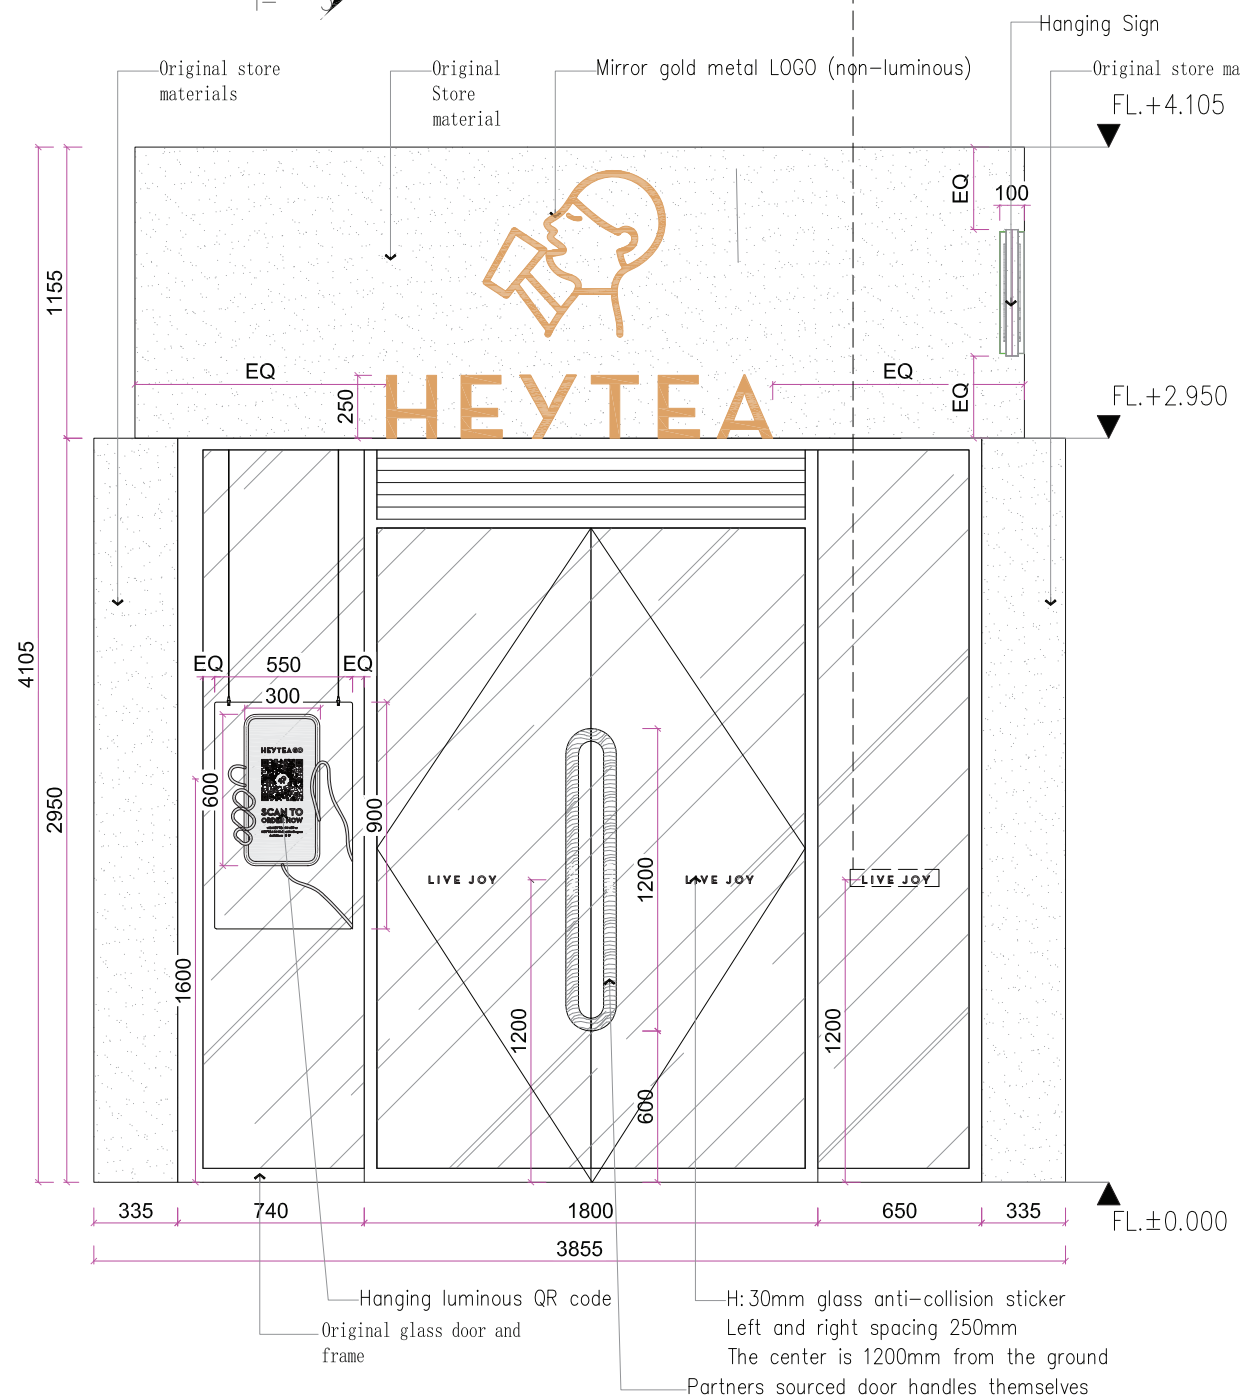

5 EXISTING FRONT ELEVATION - As Built
SCALE 1:50 @ A3

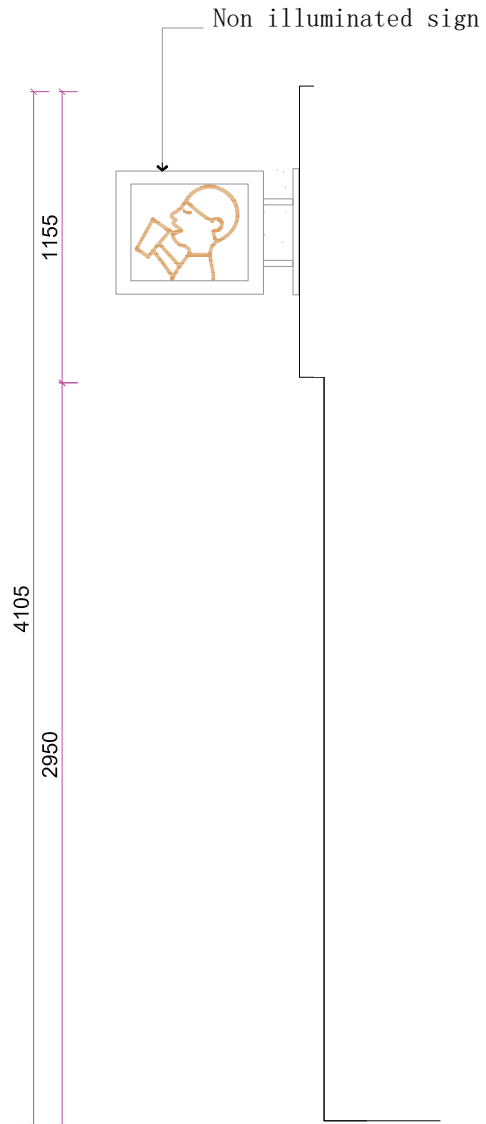

6 SIDE ELEVATION - As Built
SCALE 1:50 @ A3

General Notes:
All dimensions are in millimeters unless noted otherwise.
All dimensions to be verified on site.
For any discrepancies and omissions, it is recipient's responsibility to verify the same specifically with the designer.
The copyright of this drawing is held by Muhu Architecture.
No unauthorized use or copies are permitted without our consent.



MUHU Architecture, London
Email: muhusagal@gmail.com

Client:	HEY TEA HOLBORN
Project Title:	HEY TEA CONVERSION
Project Address:	Unit 3 227 High Holborn
Client ID:	---

Drawing Title	Date: 18.03.2024
PROPOSED ELEVATIONS	
Scale	A3
1:50	
Drawn By: FK	Checked By: SM
Approved By: SM	
Drawing No.	Revisions
MA24/HTH/006	00

