


PROPOSED SIDE ELEVATION

CHANGES TO THE ELEVATION SHOWN IN RED SQUARE PIPE TO BE CONNECTED TO EXISTING refer to BPG73-07 FOR WINDOW REPLACEMENT DETAIL

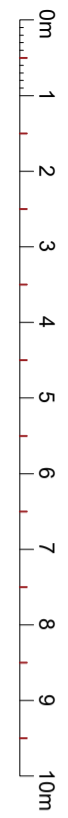

ADDRESS:
73 BELSIZE PARK GARDENS
NW3 4JP

Title:
PROPOSED SIDE ELEVATION

dwg NO:
BPG73 - 05

Scale @ A3
1:100

23/01/2024

Revision	Date	Description
B	24.04.24	WINDOWS AND NOTE AMENDED
A	28.02.24	NOTE ADDED

GR ARCHITECTURE
DESIGN STUDIO

160 Woodlands Avenue
Eastcote, Ruslip
HAA 9QY
Mob: 07768683550
E: fatlum@grarchitecture.com

PLANNING ISSUE