



- For briefing, information, planning, technical design, or tendering purposes ONLY.
 - Use figured dimensions only.
 - Do not scale from this drawing.
 - Issued for purpose indicated only.
 - All dimensions to be checked on site.
 - Architect to be notified of any discrepancies before construction commences.
 - Structural and services information is indicative only - refer to consultants' drawings and specification for details and setting out.
 - All work and materials to be in accordance with current applicable statutory legislation and to comply with all relevant codes of practice and British and European standards.
 - Information contained within this drawing is the sole copyright of Turner Architects Ltd. and not to be reproduced without written permission.

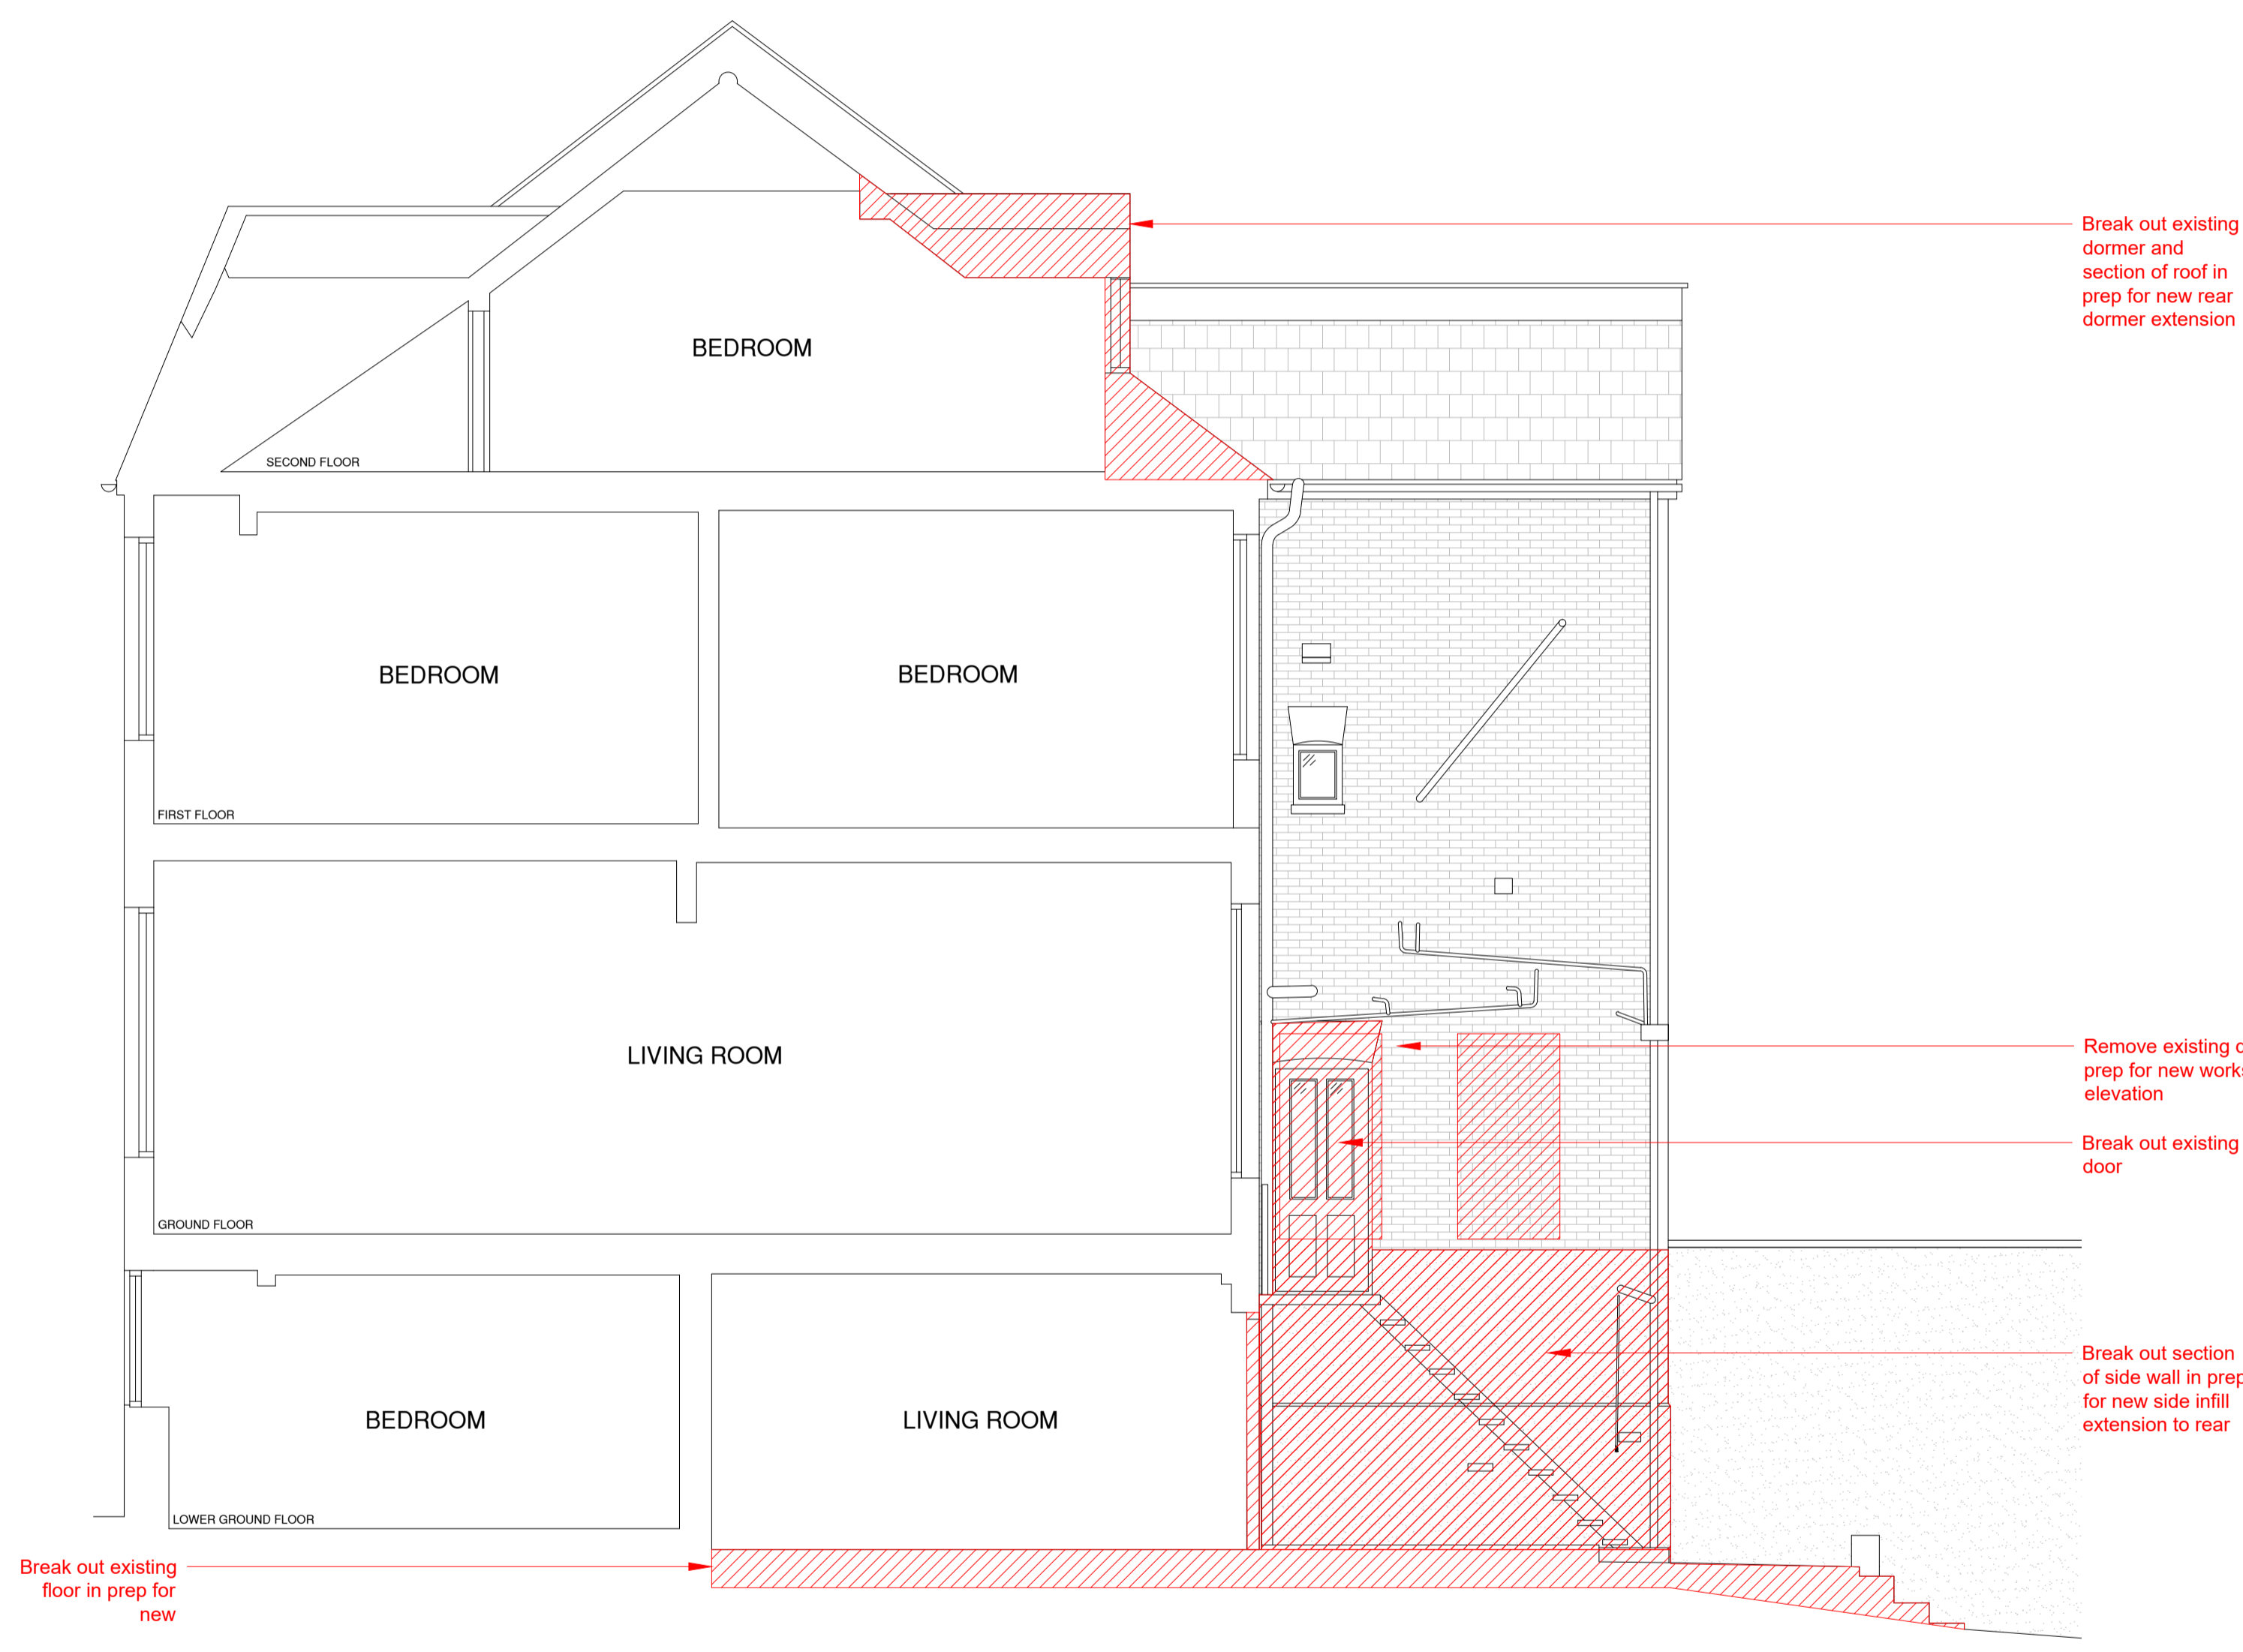


FF EXISTING SECTION FF
 0 0.5 1 2 3 4 5m 1:50

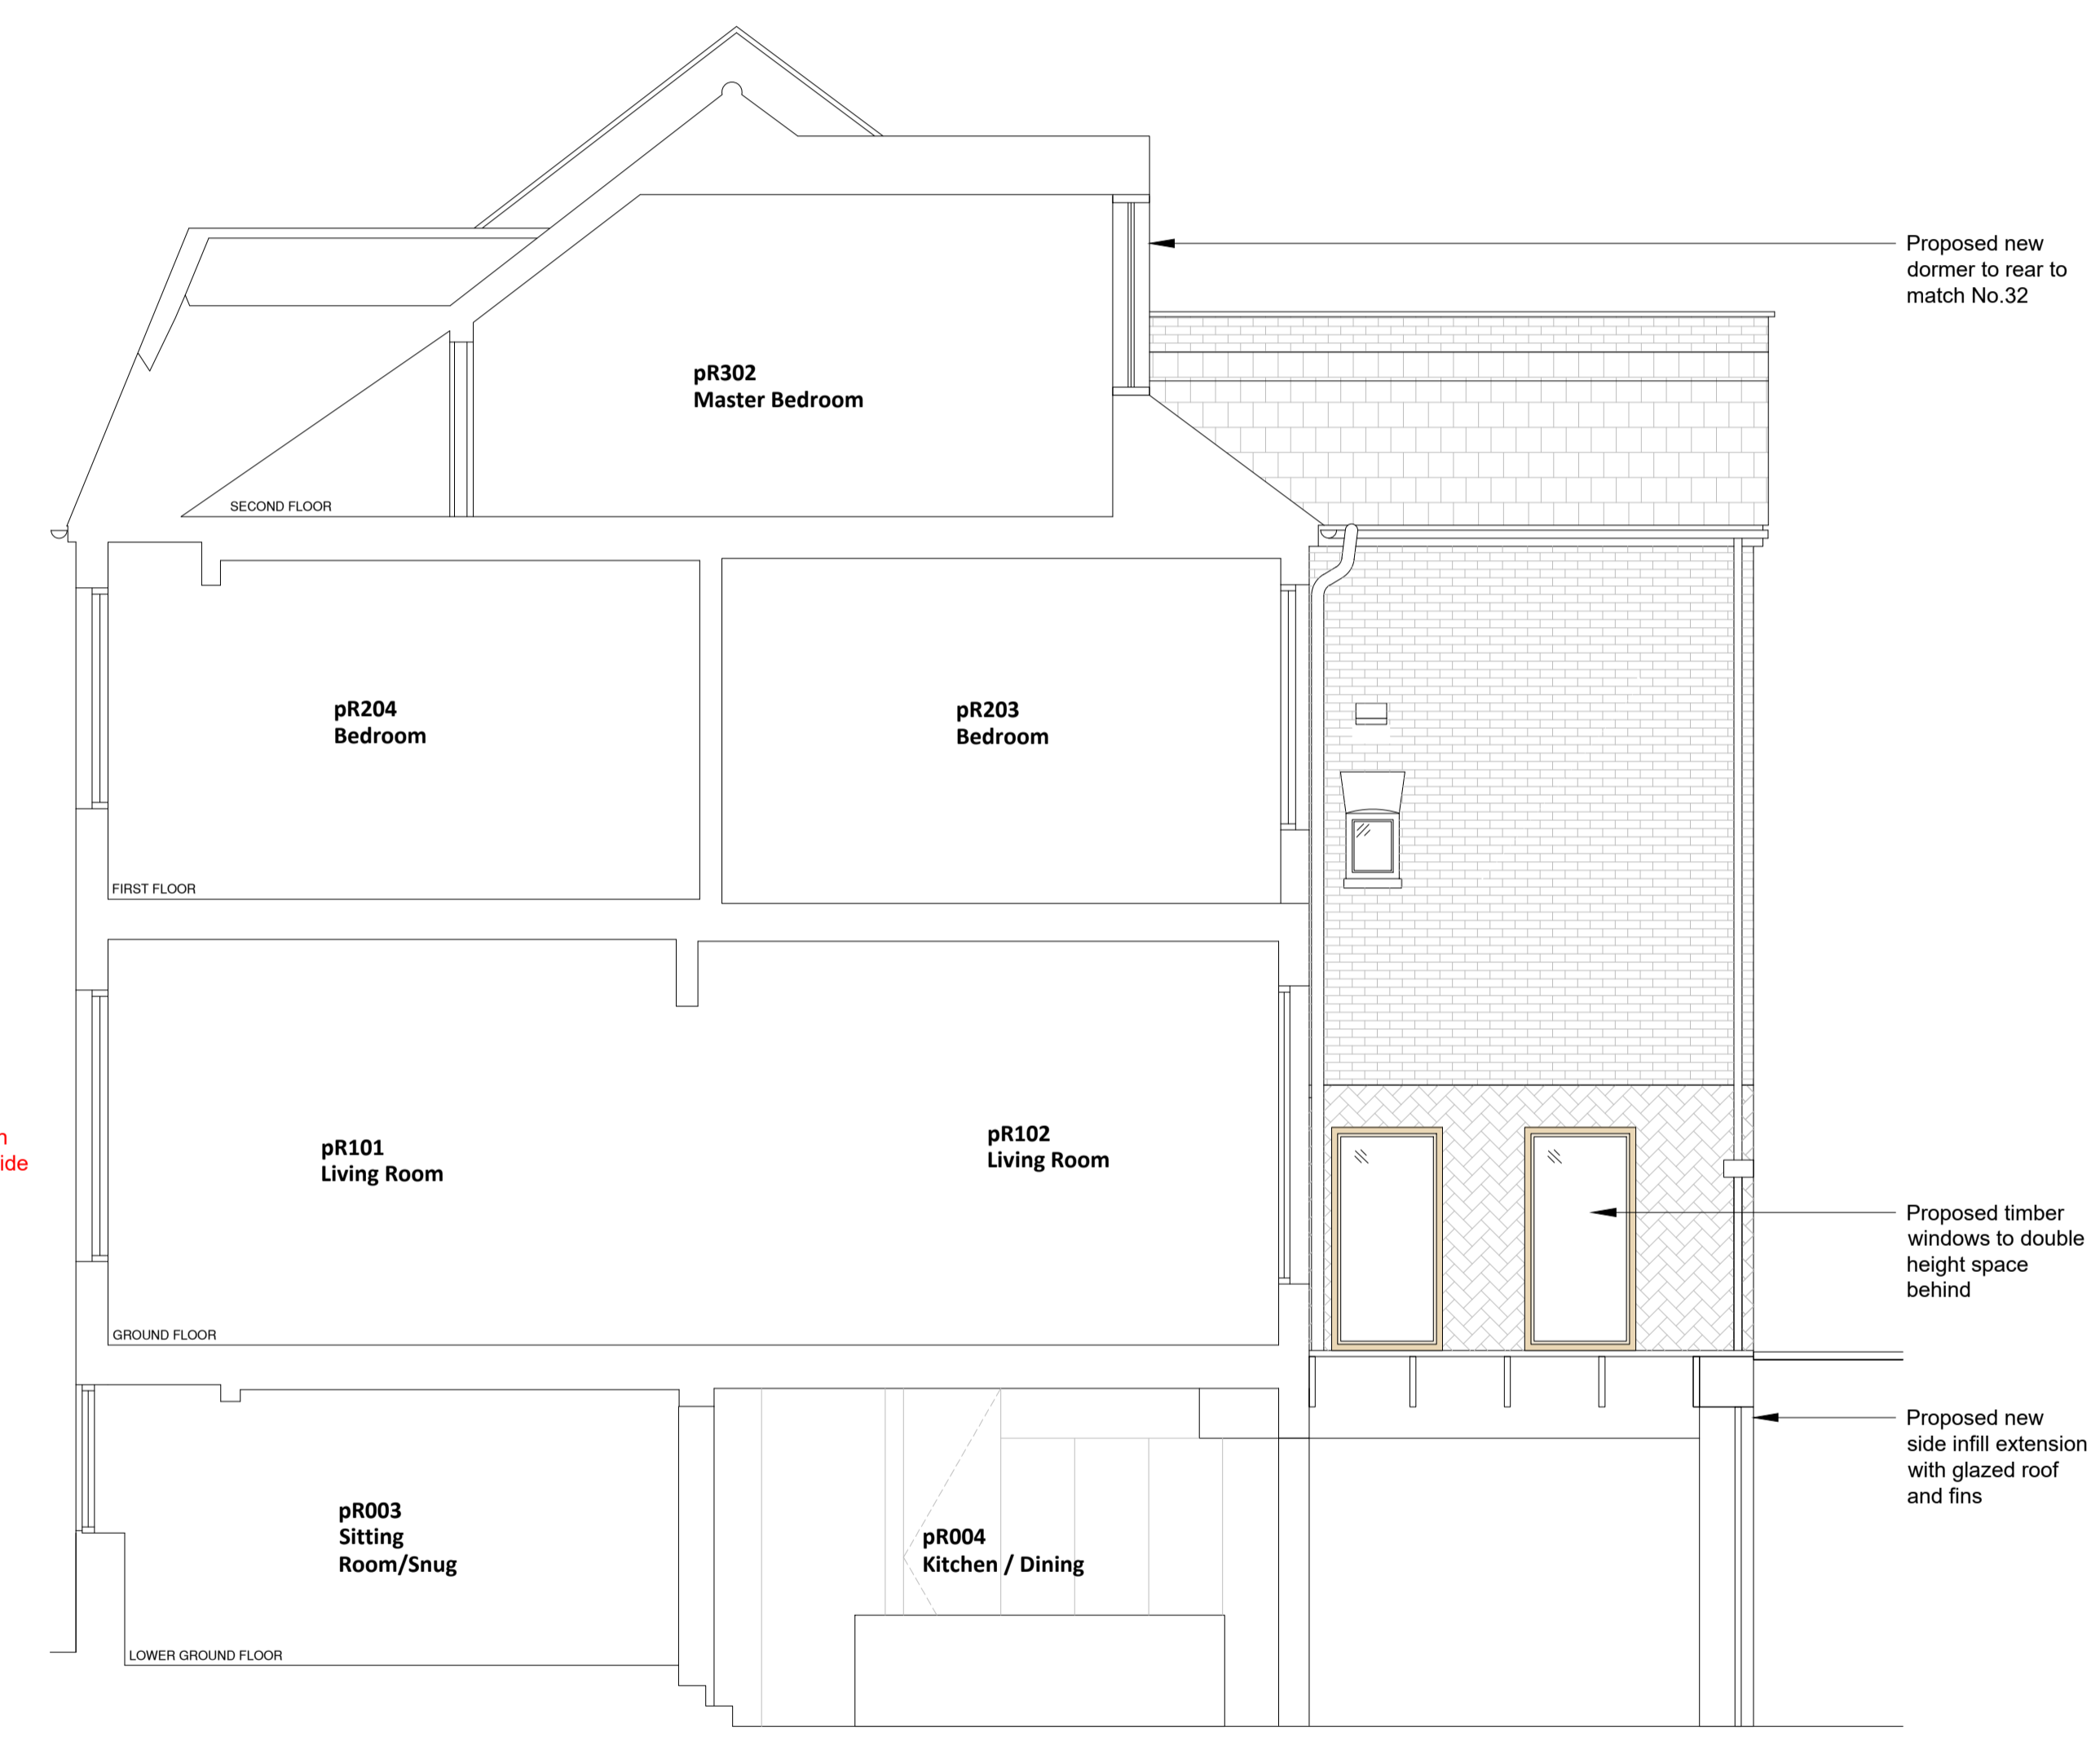

FF PROPOSED SECTION FF
 0 0.5 1 2 3 4 5m 1:50

Rev	Date	Notes
A	13/01/24	Draft for client comment
B	21/02/24	PLANNING ISSUE
C	13/06/24	PLANNING REVISION

 ISSUE
FEASIBILITY STUDY
PRELIMINARY
PLANNING
BUILDING REGULATION
PRODUCTION INFORMATION
AS BUILT



TURNER ARCHITECTS
 t. +44 (0) 7779 726996
 e. info@turnerarchitects.co.uk
 w. www.turnerarchitects.co.uk

34 HILLFIELD ROAD
 LONDON
 NW6 1PZ

Existing and Proposed
 SECTION FF

1:50 @ A1
 JAN 2023
 AP PT 1-3

HI 301 C