



Main House LO1
3660

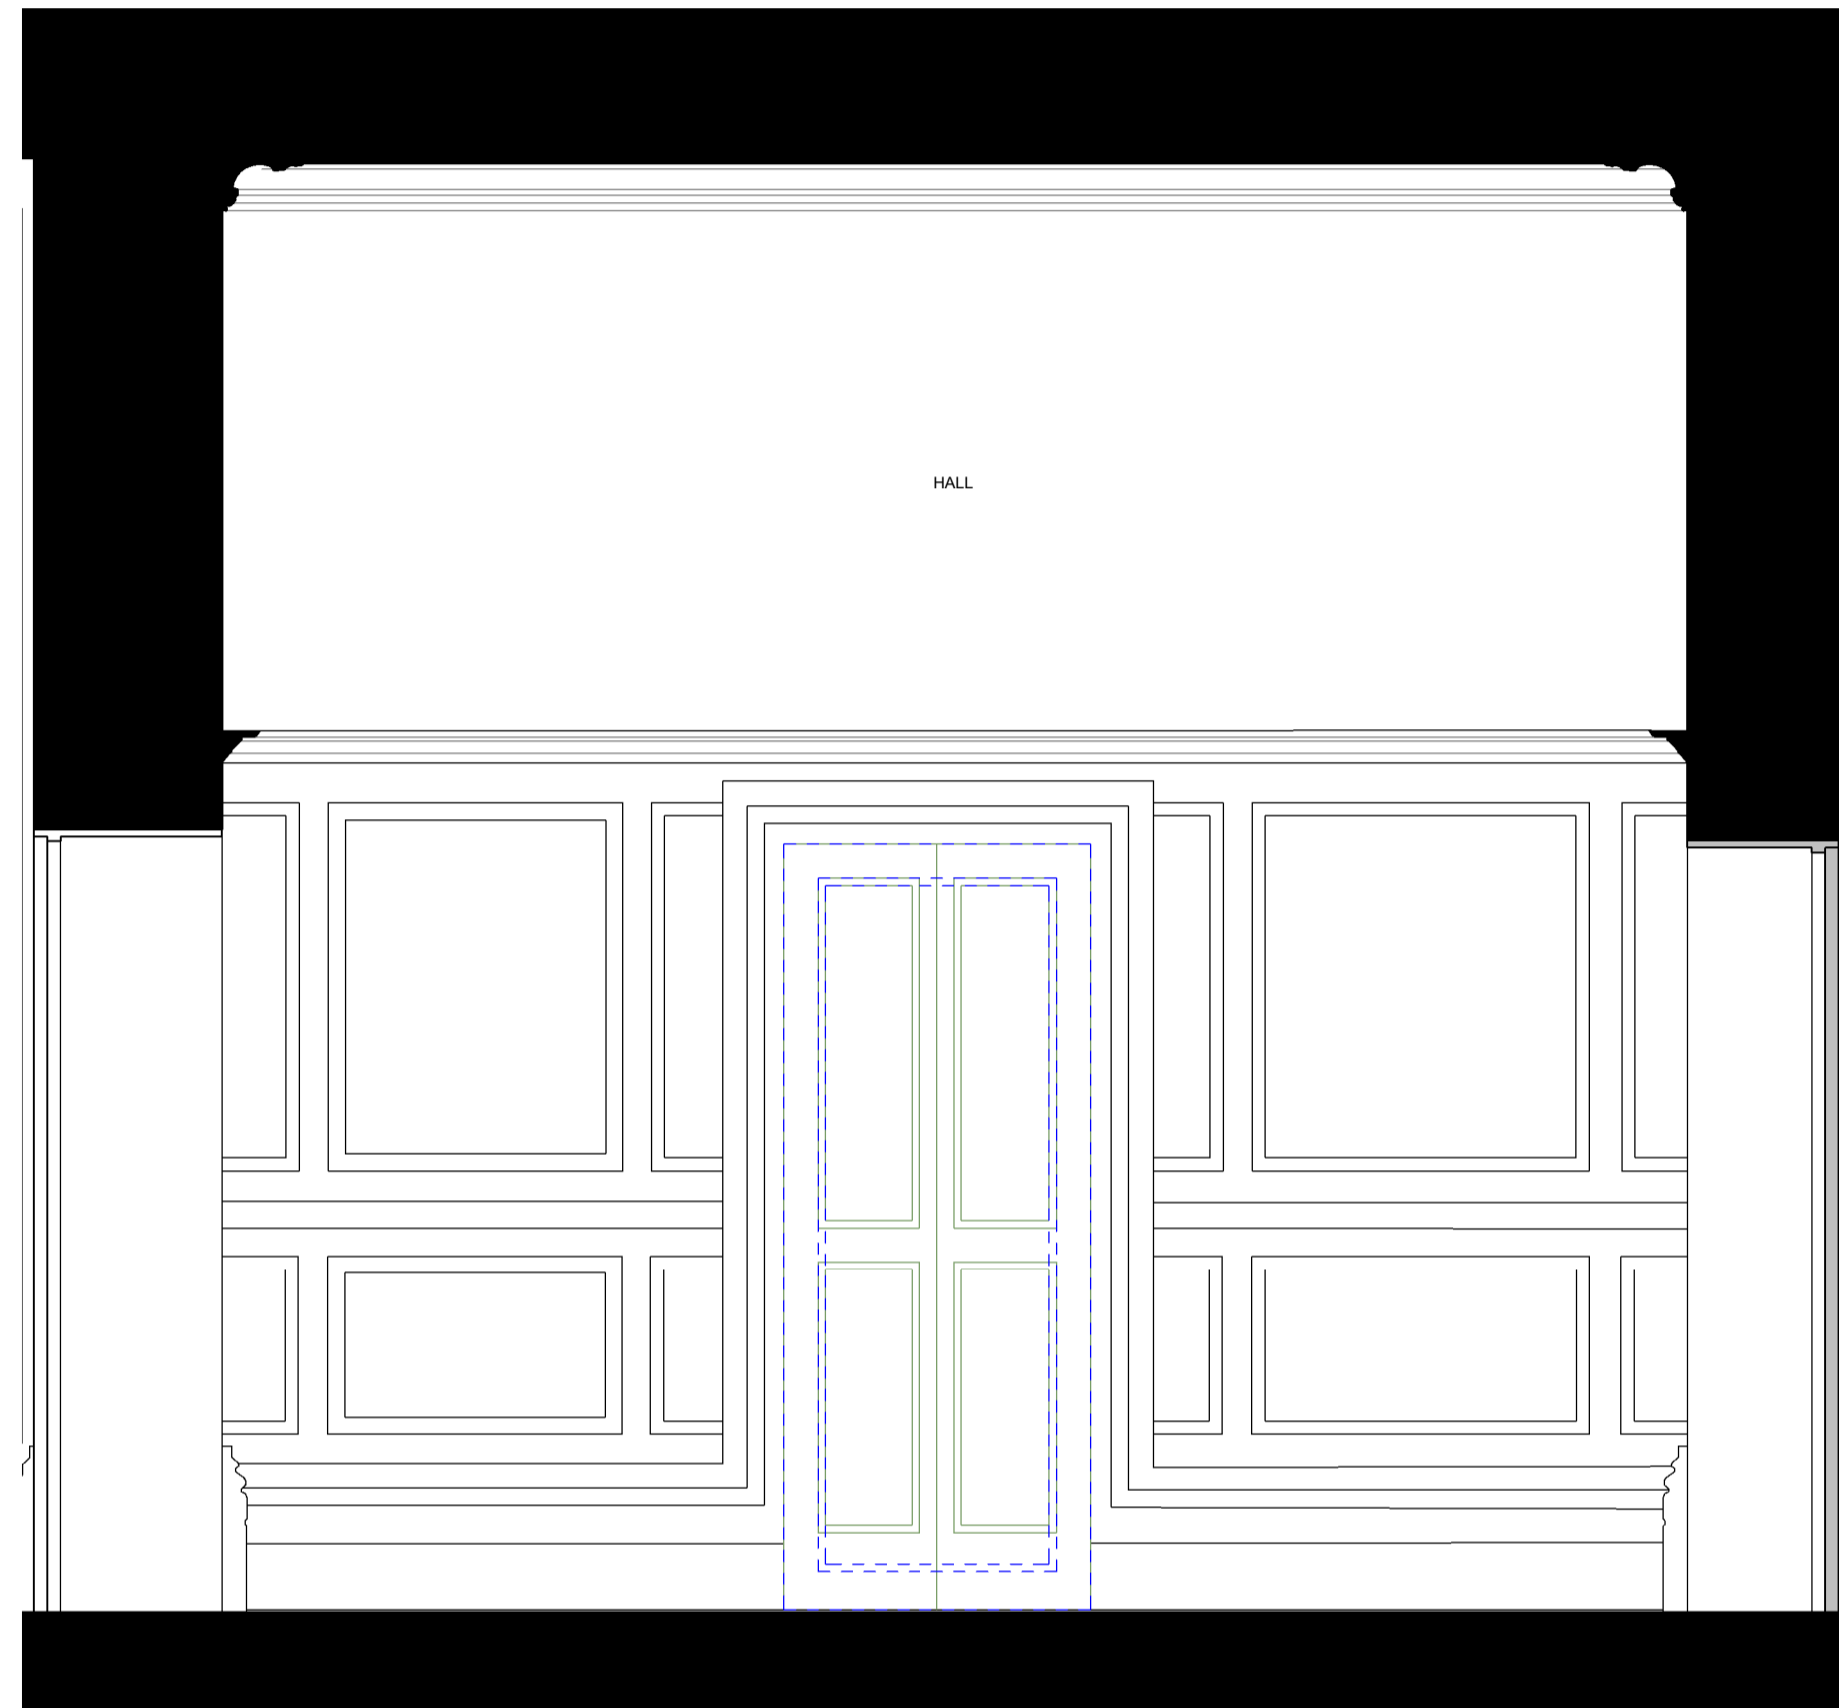


Main House LO0
31370

Mews House LO0
31295

1 Proposed Section AA - Powder Room Doors
1:20

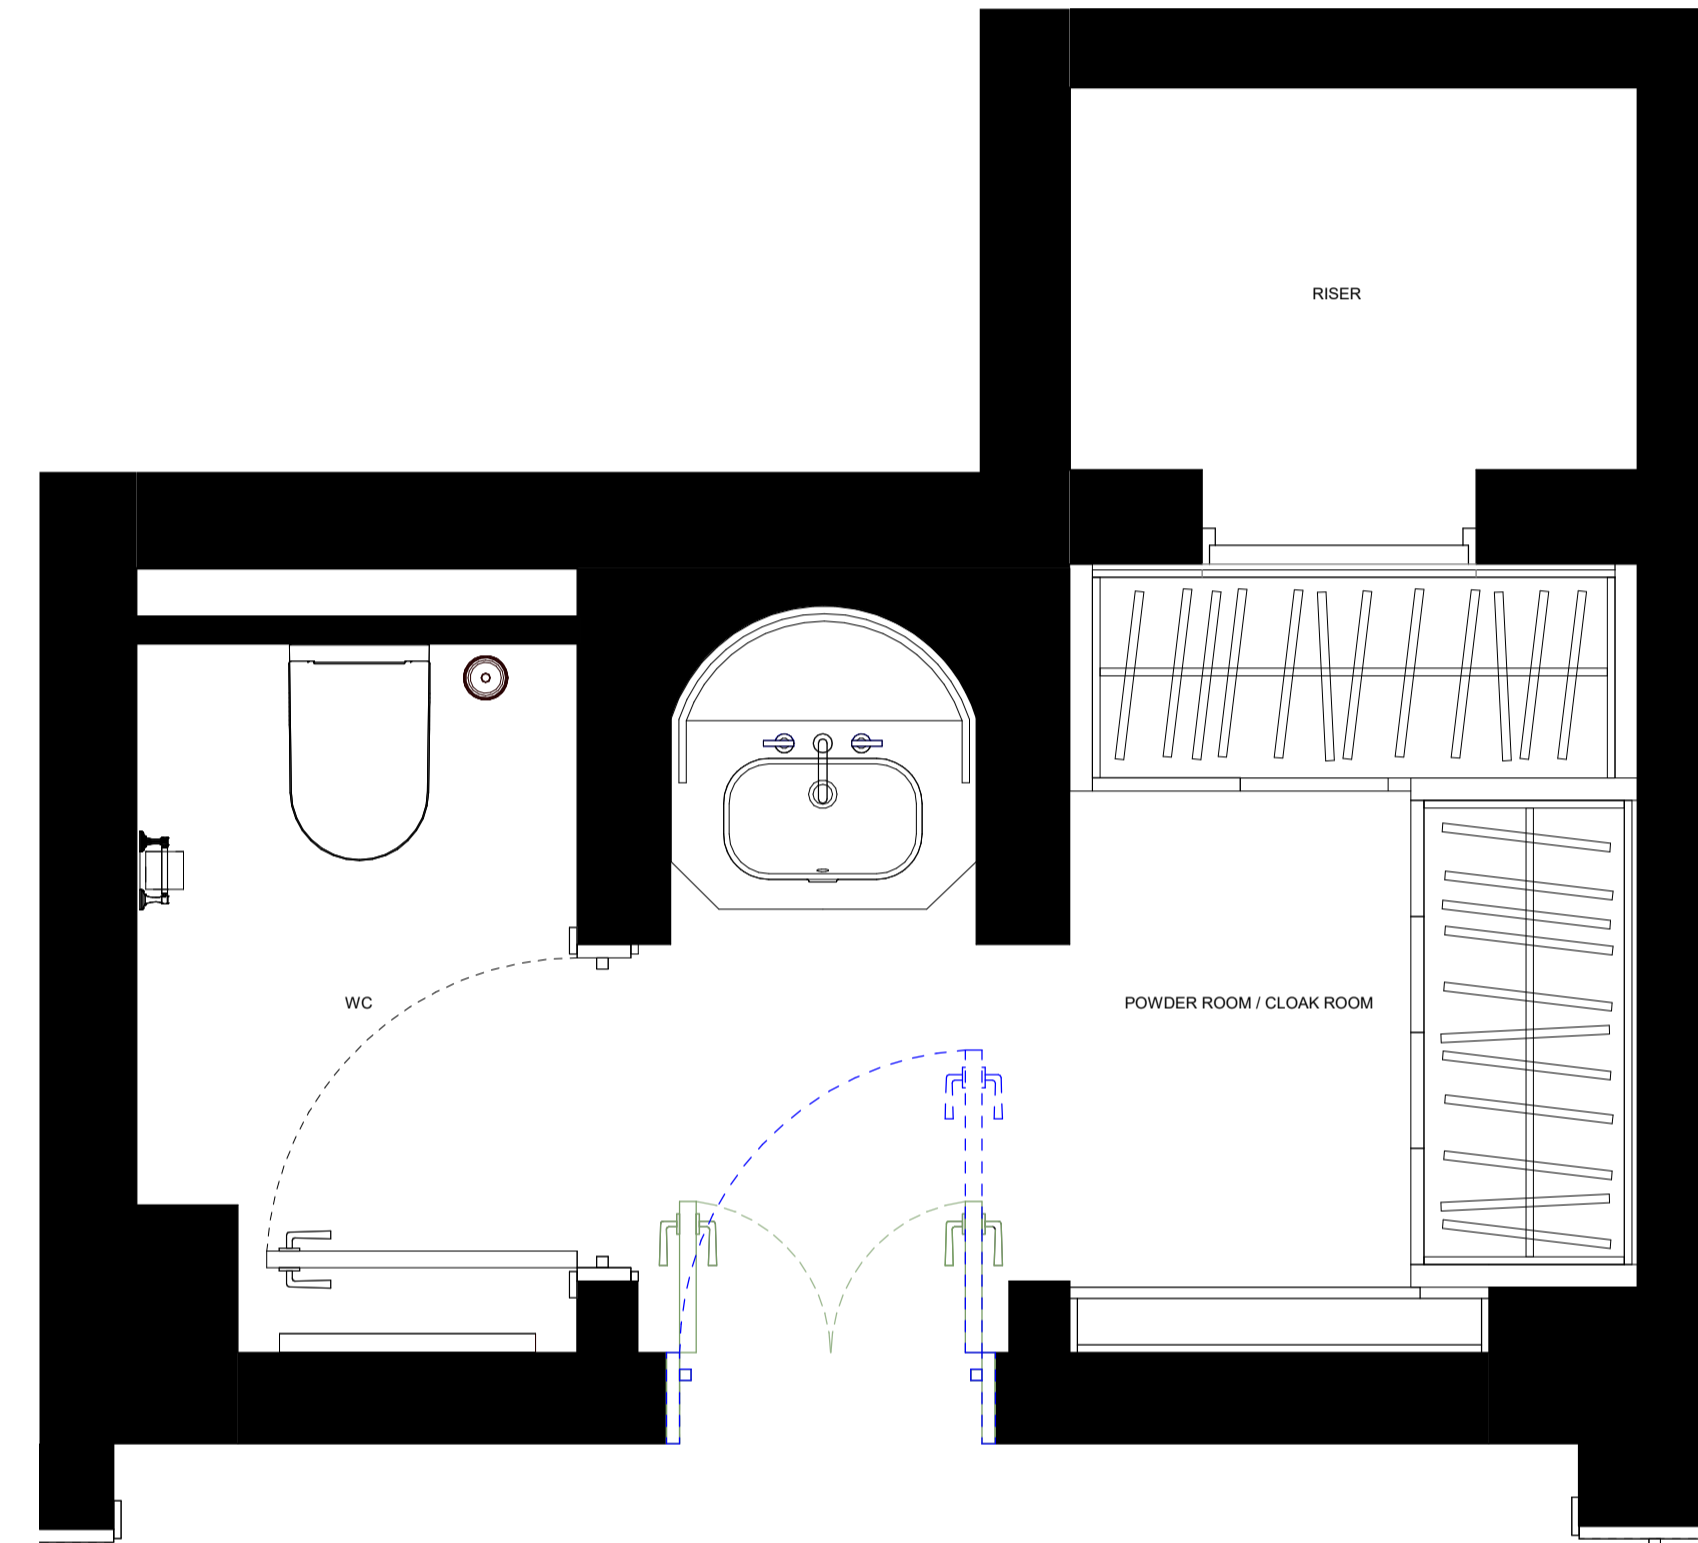

2 Proposed Plan - Powder Room
1:20

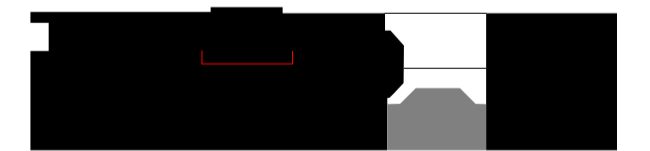

DFA

DOWEN FARMER ARCHITECTS

Unit 601, Level 6,
Peckham Levels,
95A Rye Ln,
London
SE15 4ST

T: 020 8058 7997
W: www.dowenfarmer.com

Project
4 CAMBRIDGE GATE

Project address
4 Cambridge Gate, Regents
Park, NW1 4JX

Client
PRIVATE

Sheet number
1089 -DFA -20_102

Sheet name
Proposed Section AA - Hall

Sheet scale
As indicated
@ A1

Date
09/07/2024 15:20:30

Rev	Description	Date	Issued	Checked
1	Planning Issue	09/07/2024	SN	PB

Key

- Proposed
- Existing Building / Existing Consent
- Existing Consented Item

Scale Bar: 1:50 @ A1 (Metres)



Project status

Planning

GENERAL NOTES:

This drawing is not for construction and is for information purposes only. Contractor to provide detailed design and construction information. This drawing is to be read in conjunction with all relevant architects' and engineers' drawings and specifications. Drawings to be read in line with the approved inspectors plan check and all dimensions to be checked on site with any discrepancies reported to the architect.

OS information not accurate and not to be used for measurements.

Dowen Farmer Architects Ltd is incorporated in England & Wales. Company registration number 10861309.