


SITE PLAN
AS BUILT

Copyright notice:
This and all other documents authored by VMA and all information and concepts both depicted and implied therein are the sole property of VMA. Reproduction or transmission in any form is strictly forbidden unless prior permission is obtained in writing from VMA. Construction based on the depicted information at any time or location not related to this project is strictly forbidden unless prior permission is obtained in writing from VMA.

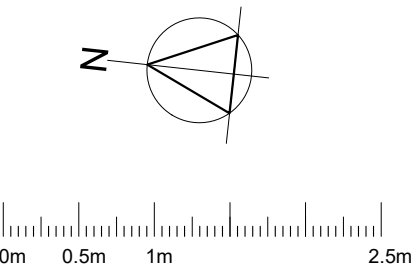


LEGEND:
New structures

00	23.07.21	FOR PLANNING
----	----------	--------------


VMArchitects
21 Sunningfields Road
London NW4 4QR
Job title
11 HEMSTAL ROAD,
LONDON NW6 2AB
Drawing title
SITE PLAN
AS BUILT

Scale	Date	Drawn	Checked
1:100@ A3	July 24	MJ	VM
Drawing No.		Rev. No.	
397A - 201		00	

Copyright notice:
This and all other documents authored by VMA and all information and concepts both depicted and implied therein are the sole property of VMA. Reproduction or transmission in any form is strictly forbidden unless prior permission is obtained in writing from VMA. Construction based on the depicted information at any time or location not related to this project is strictly forbidden unless prior permission is obtained in writing from VMA.

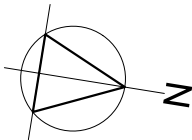

LEGEND:
New structures

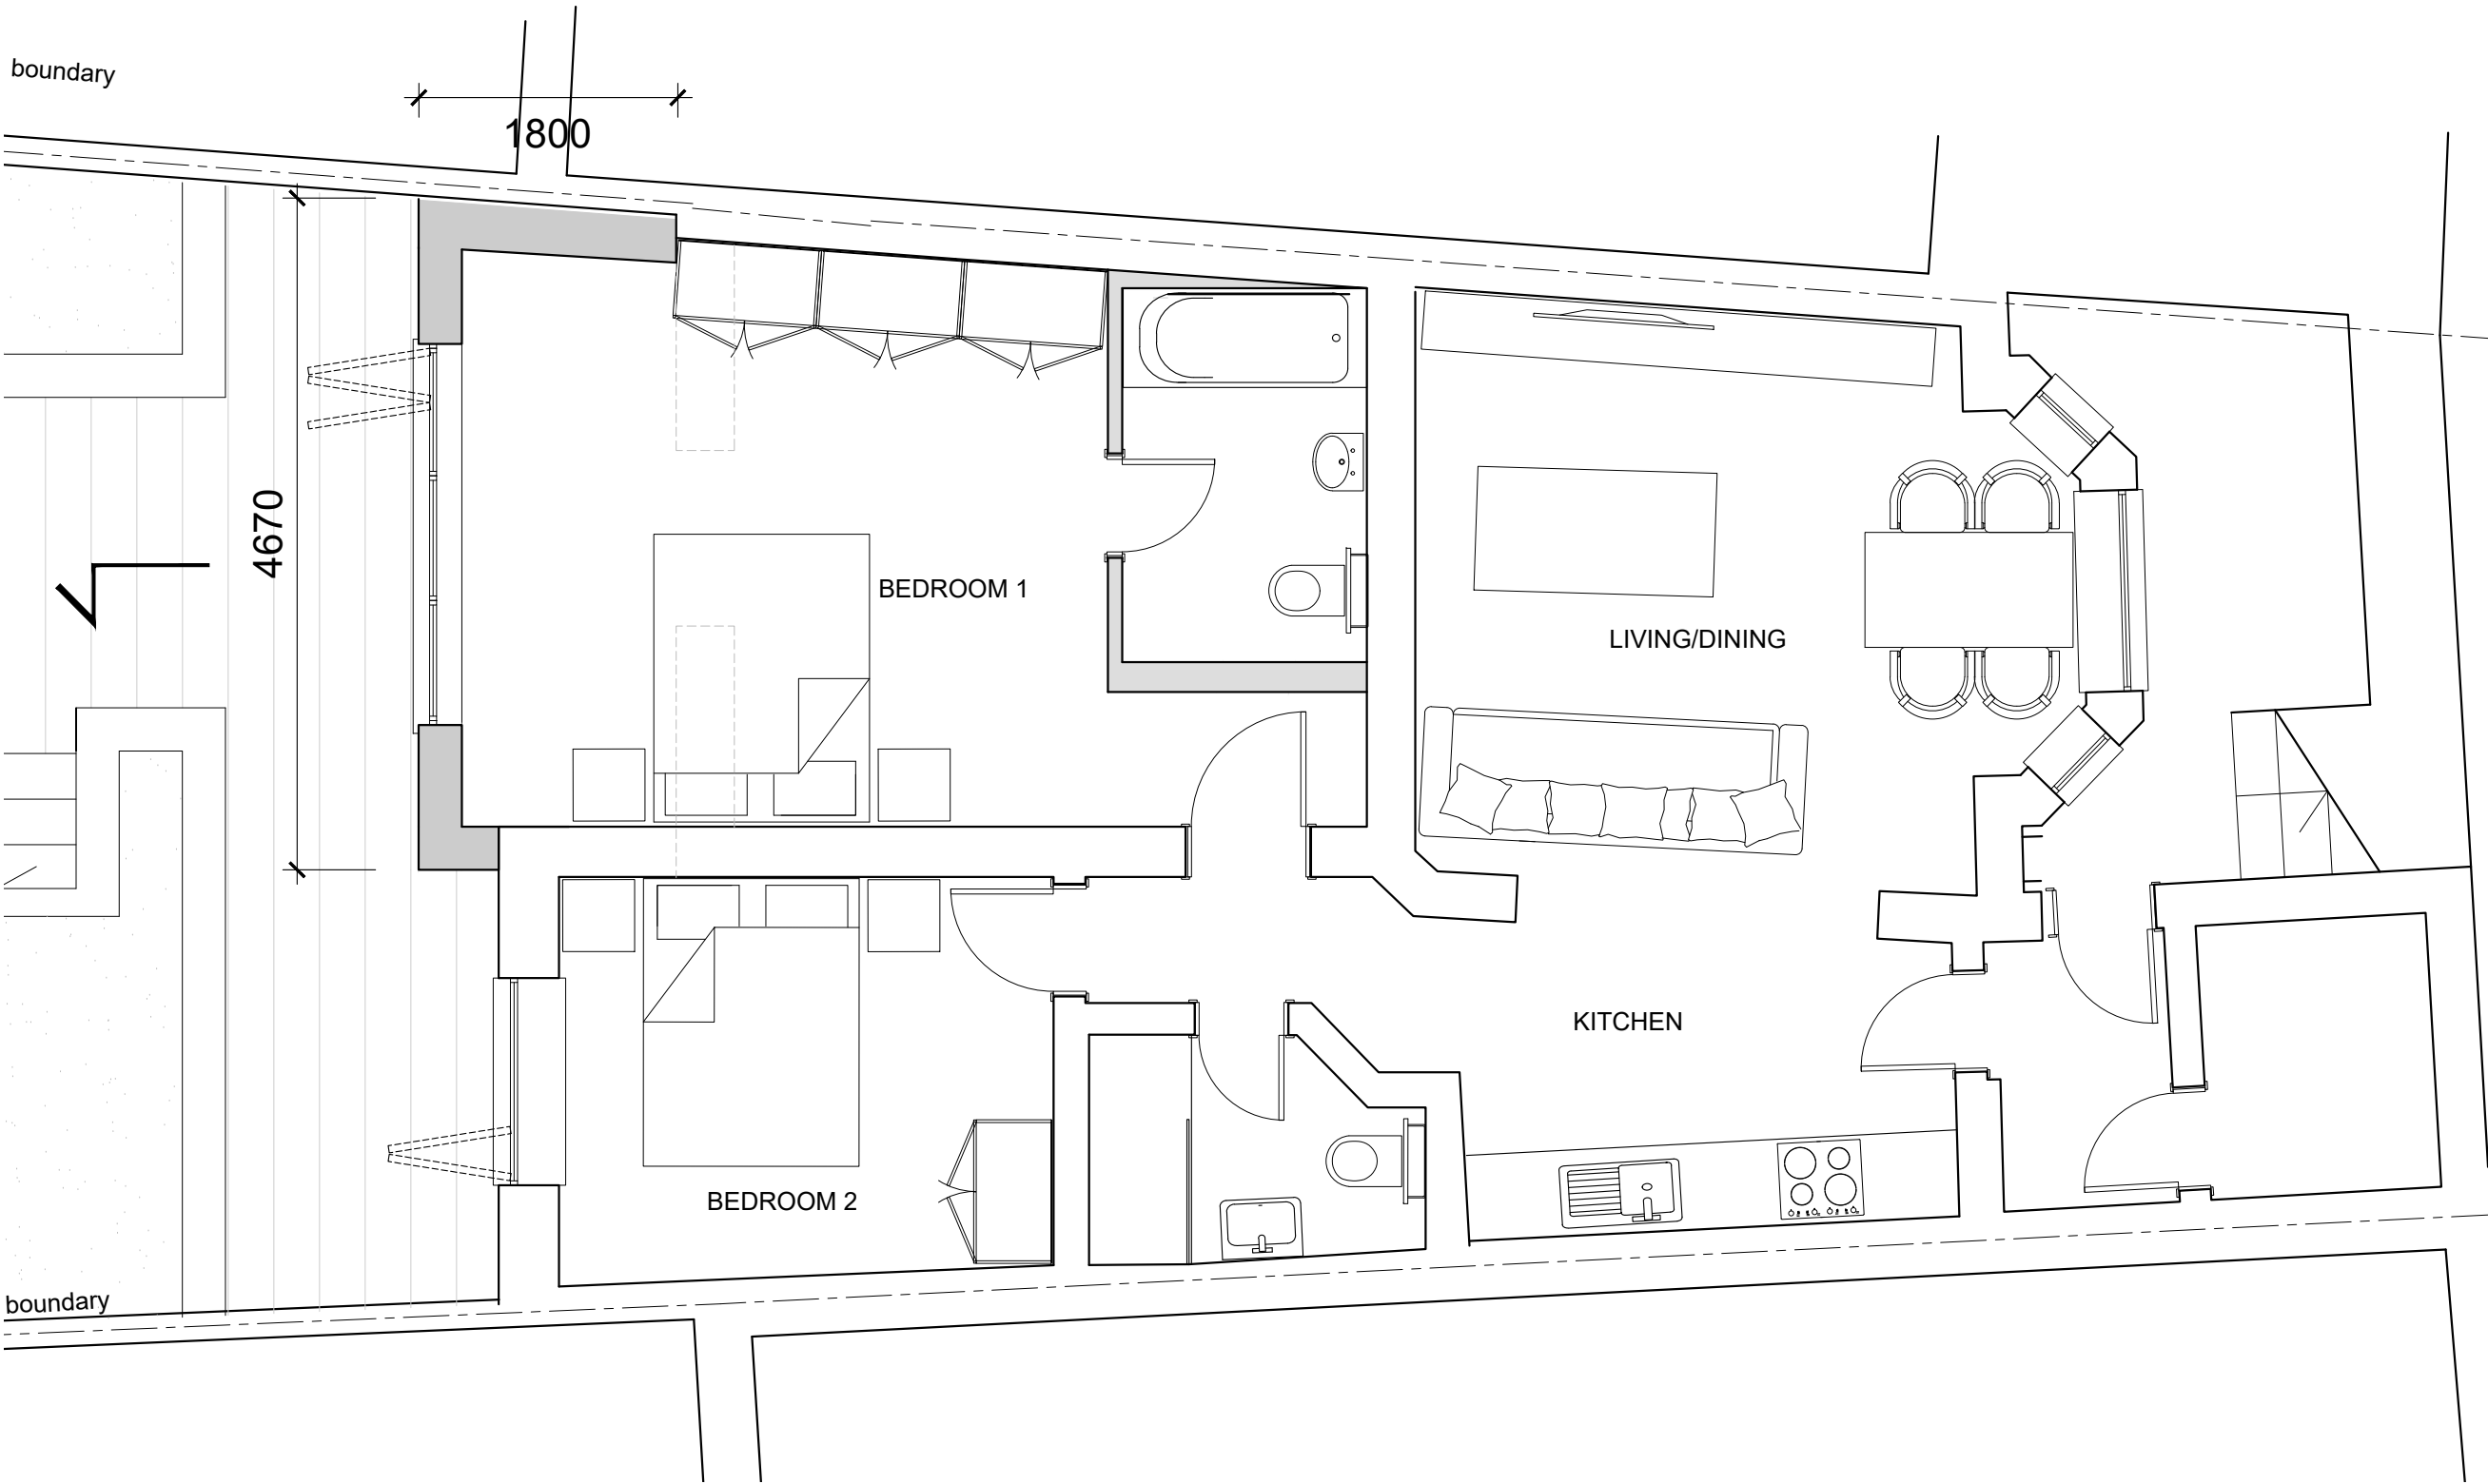


00	23.07.21	FOR PLANNING
----	----------	--------------

VMArchitects
21 Sunningfields Road
London NW4 4QR
DDI: 020 7936 4222
office@vm-arch.com
Job title
11 HEMSTAL ROAD,
LONDON NW6 2AB
Drawing title
GROUND FLOOR PLAN
AS BUILT


Scale	Date	Drawn	Checked
1:50@ A3	July 24	MJ	VM
Drawing No.		Rev. No.	
397A - 210		00	

LOWER GROUND FLOOR PLAN
AS BUILT

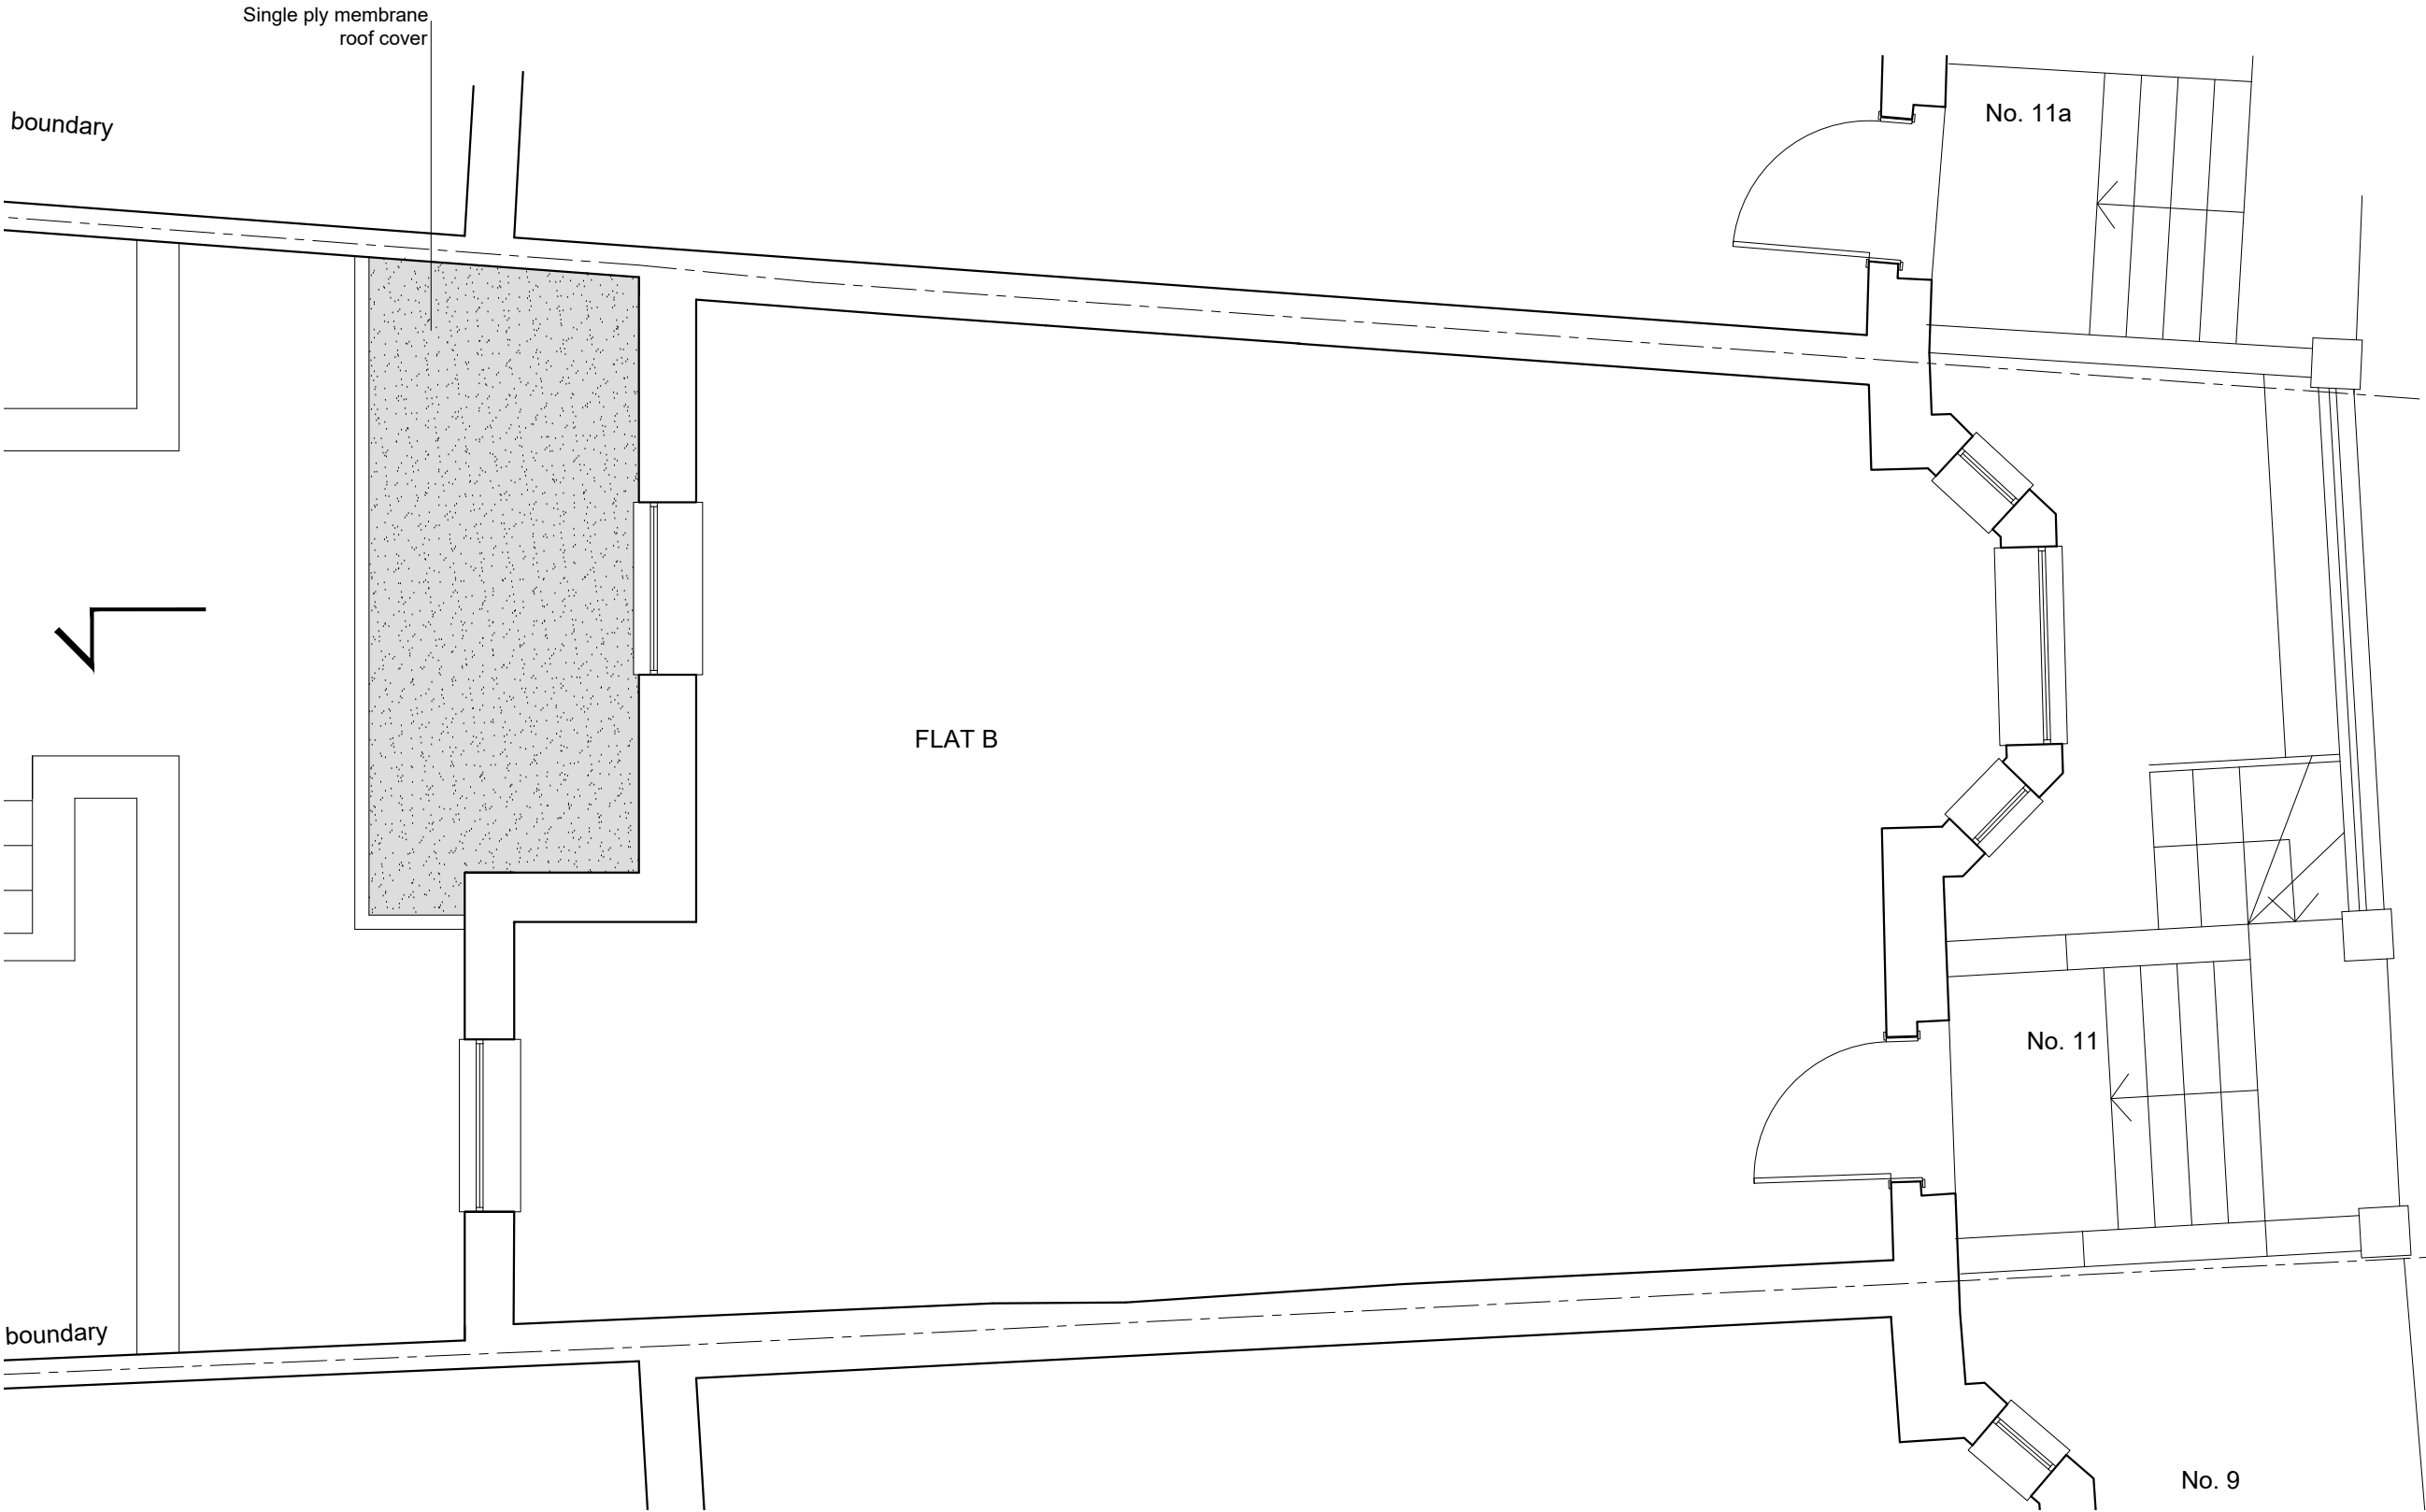


Copyright notice:

This and all other documents authored by VMA and all information and concepts both depicted and implied therein are the sole property of VMA. Reproduction or transmission in any form is strictly forbidden unless prior permission is obtained in writing from VMA. Construction based on the depicted information at any time or location not related to this project is strictly forbidden unless prior permission is obtained in writing from VMA.

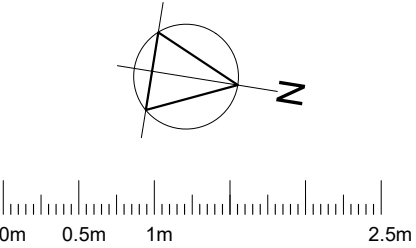

LEGEND:

 New structures

GROUND FLOOR PLAN
AS BUILT

00	23.07.24	FOR PLANNING	
----	----------	--------------	--

VMA rchitects

21 Sunningfields Road
London NW4 4QR

DDI: 020 7936 4222
office@vm-arch.com

Job title
11 HEMSTAL ROAD,
LONDON NW6 2AB

Drawing title
GROUND FLOOR PLAN
AS BUILT

Scale	Date	Drawn	Checked
1:50@ A3	July 24	MJ	VM


Drawing No.	Rev. No.
397A - 211	00



Powder coated aluminium frame double glazed bi-fold door

Fair faced brickwork to match existing London stock

REAR ELEVATION

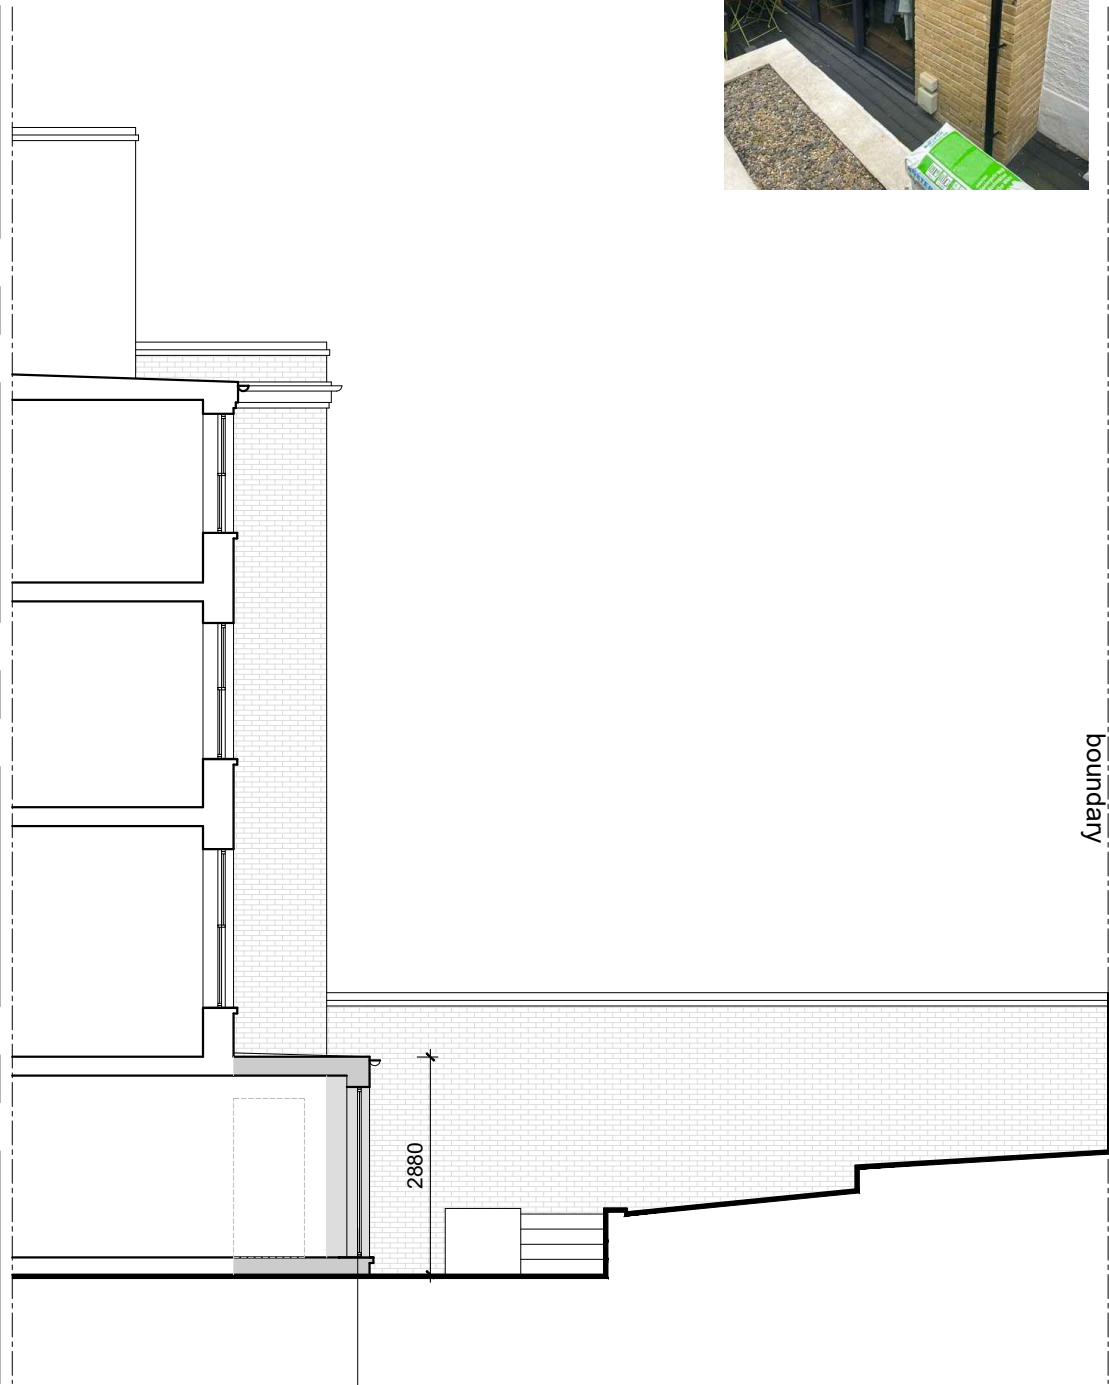

Powder coated aluminium frame double glazed bi-fold door

SECTION




Copyright notice:

This and all other documents authored by VMA and all information and concepts both depicted and implied therein are the sole property of VMA. Reproduction or transmission in any form is strictly forbidden unless prior permission is obtained in writing from VMA. Construction based on the depicted information at any time or location not related to this project is strictly forbidden unless prior permission is obtained in writing from VMA.



LEGEND:

 New structures

00	23.07.24	FOR PLANNING
----	----------	--------------

VMArchitects

21 Sunningfields Road
London NW4 4QR

DDI: 020 7936 4222
office@vm-arch.com

Job title
11 HEMSTAL ROAD,
LONDON NW6 2AB

Drawing title
REAR ELEVATIONS AND SECTION A
AS BUILT

Scale	Date	Drawn	Checked
1:100@ A3	July 24	MJ	VM

Drawing No.	Rev. No.
397A - 220	00

REAR ELEVATIONS AND SECTION AS BUILT