


Pre-existing Second Floor
1:50

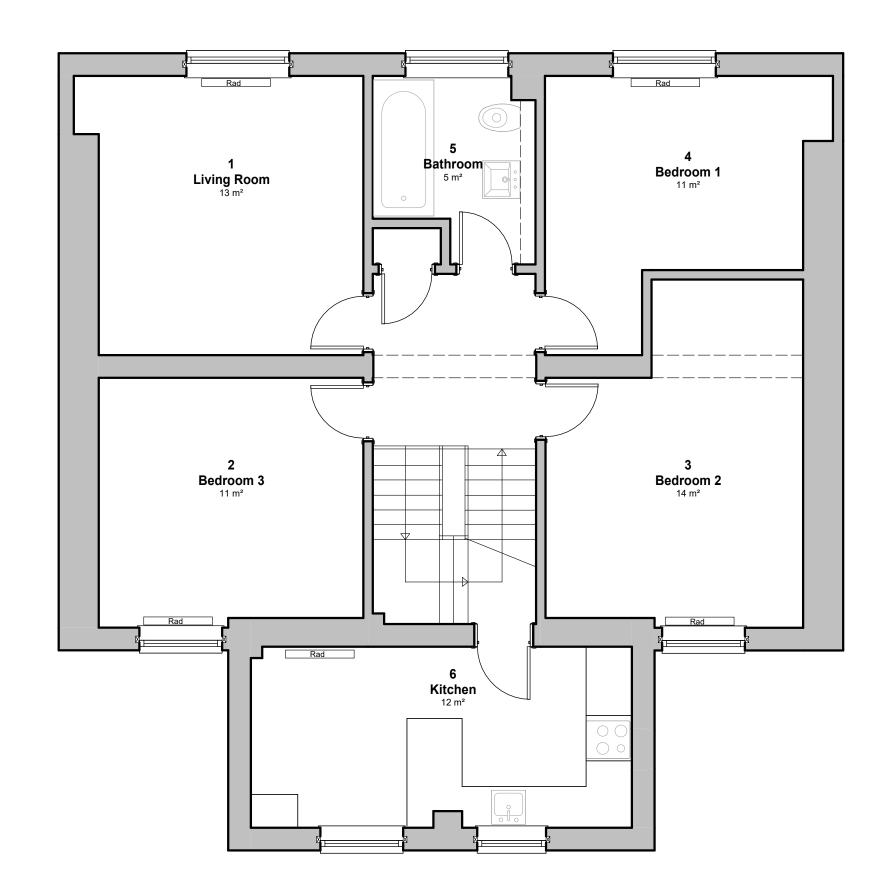

2 As-Built Second Floor
1:50

5E Kingsgate Road
London, NW6 4TD, Unated Kingdom

REVISION

Existing and As-Built Second Floor

Second Issue FH Submission Draft

RIBA W COHANIM

3rd Fl. 207 Regent Street. London, W1B 3HH info@cohanimarchitecture.com

Information contained within this drawing is the sole copyright of Cohanim Limited and is not to be reproduced without express permission. No implied licence exists. This drawing is not to be used for land transfer or valuation purposes.


All dimensions to be checked on site by the Contractor. Issued for purposes indicated only. Drawing errors and omissions to be reported to Project Architect or Architectural Lead


CURRENT PROJECT STATUS

PLANNING APPLICATION

CLIENT:	TRUE NORTH
Ms Kronseder	
DRAWN BY:	
АМ	
CHECKED BY:	DRAWING NUMBER:
JH	389-01-A004-1
DATE:	SCALE:
19/07/2024	1 : 50
	OUEET OIZE.
FILE:	SHEET SIZE:
FILE: 389-CA-05-M3-A000-01.rvt	A1L

0m 1m 2m 3m 4m 5m 1:50

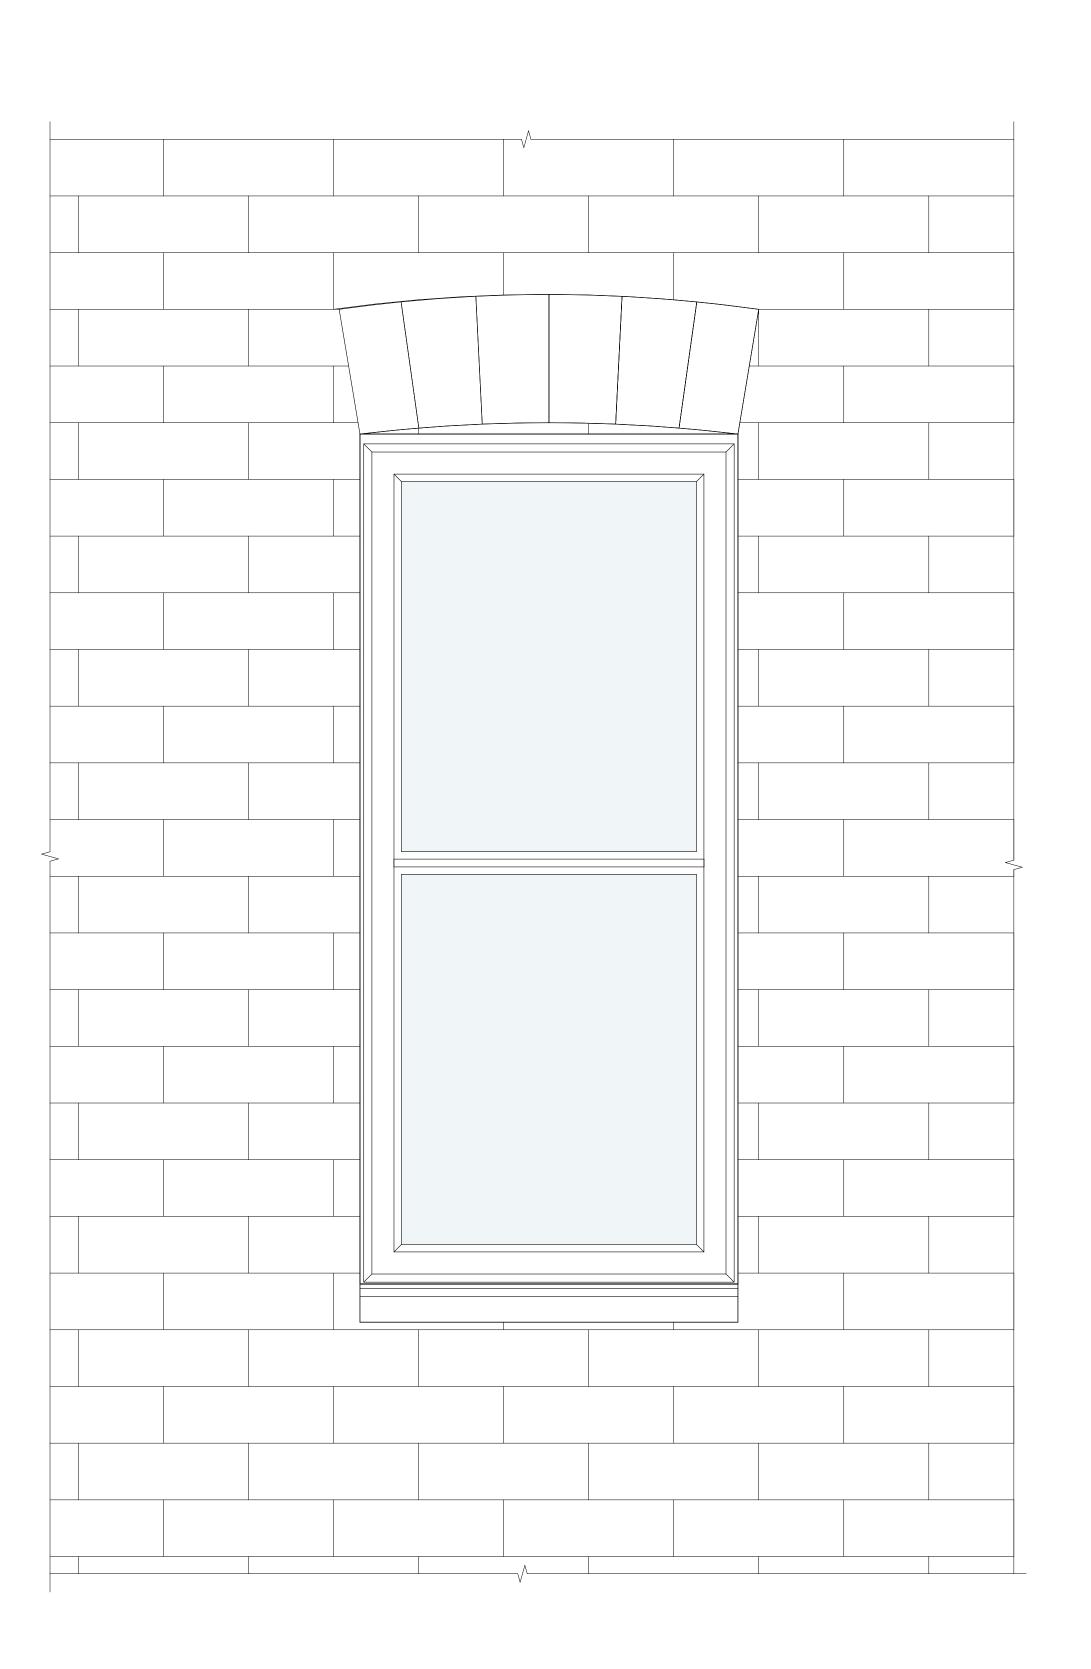

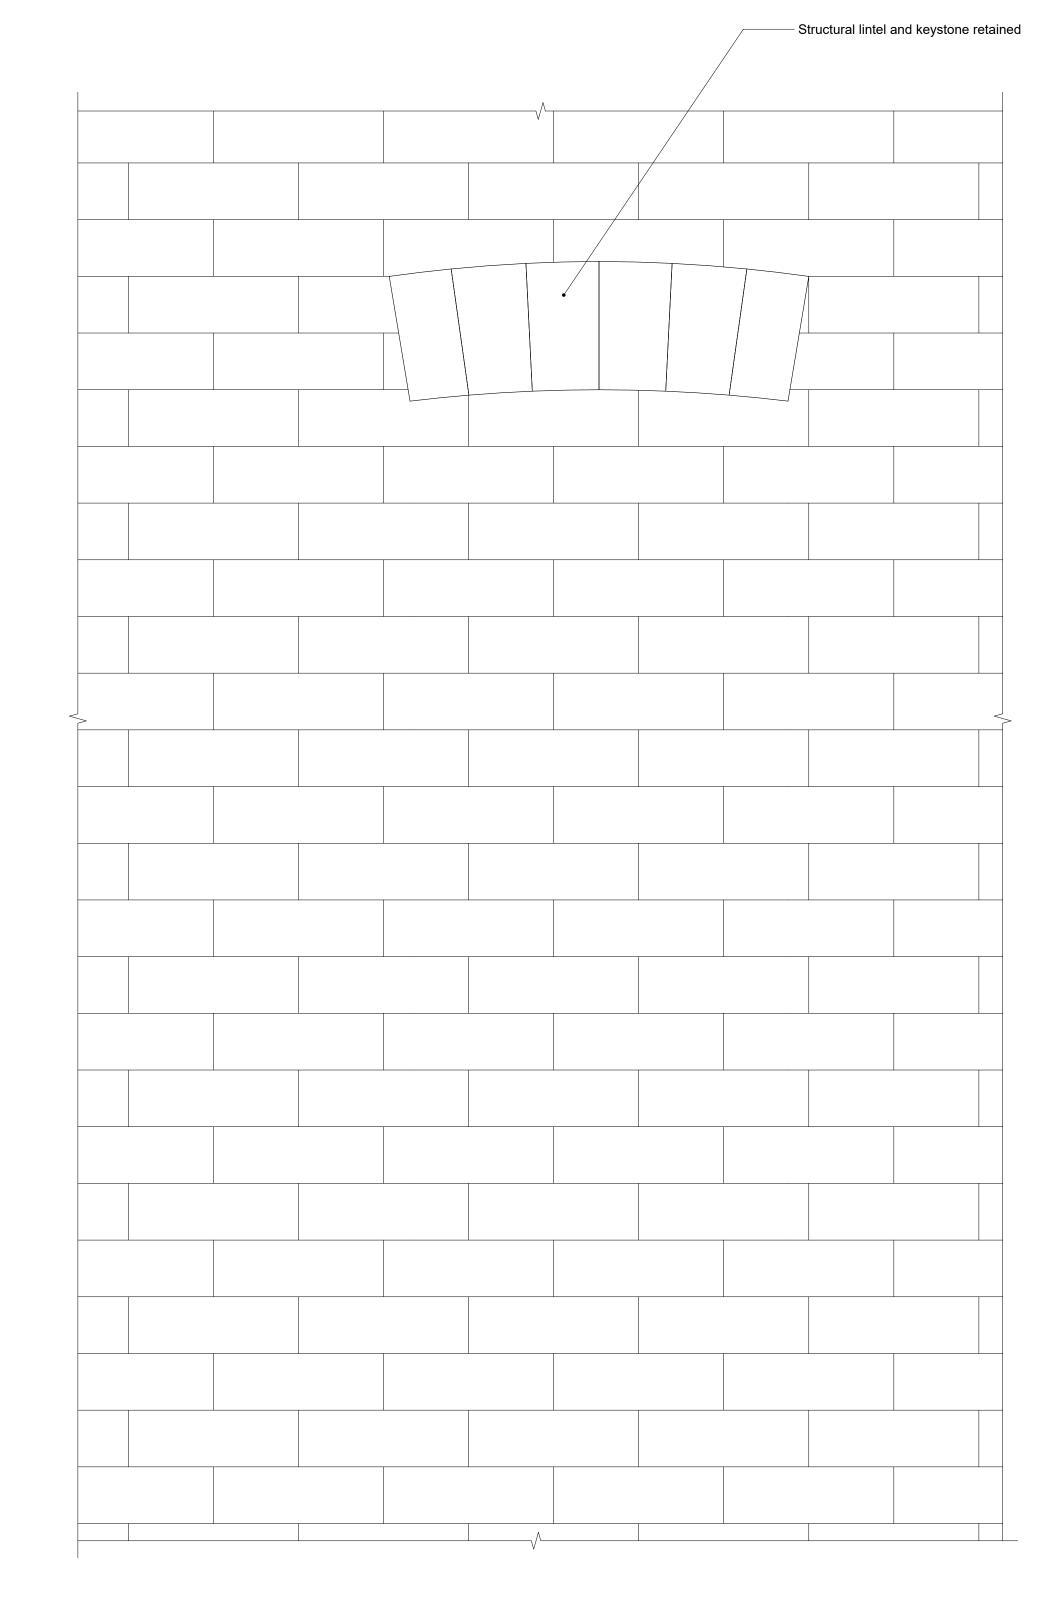

Pre-existing Window
1:5

2 As-Built Window

0m 0.1m 0.2m 0.3m 0.4m 0.5m 1:5 5E Kingsgate Road
London, NW6 4TD, Unated Kingdom

REV# DATE

REVISION

Existing and As-Built Windows

19/07/2024 Second Issue FH Submission Draft

RIBA COHANIM

3rd Fl. 207 Regent Street. London, W1B 3HH info@cohanimarchitecture.com

Information contained within this drawing is the sole copyright of Cohanim Limited and is not to be reproduced without express permission. No implied licence exists. This drawing is not to be used for land transfer or valuation purposes. All dimensions to be checked on site by the Contractor. Issued for purposes indicated only. Drawing errors and omissions to be reported to Project Architect or Architectural Lead

CURRENT PROJECT STATUS

PLANNING APPLICATION

CLIENT:	TRUE NORTH
Ms Kronseder	
DRAWN BY:	
AM	
CHECKED BY:	DRAWING NUMBER:
JH	389-01-A005-1
DATE:	SCALE:
19/07/2024	1:5
FILE:	SHEET SIZE:
389-CA-05-M3-A000-01.rvt	A1L