


FLOORING LEGEND

- FLOOR TYPE A - raised floor with bonded timber.
- FLOOR TYPE E - Vinyl on existing prepared concrete and stairs.
- FLOOR TYPE F - Joinery timber steps.
- FLOOR TYPE G - Porcelain tiles Terazzo effect on prepared concrete floor.
- Walk on glass
- FLOOR TYPE G - SDS Primary matting
- FLOOR TYPE H - Interface barrier mat.
- FLOOR TYPE J - Altro vinyl



New Office

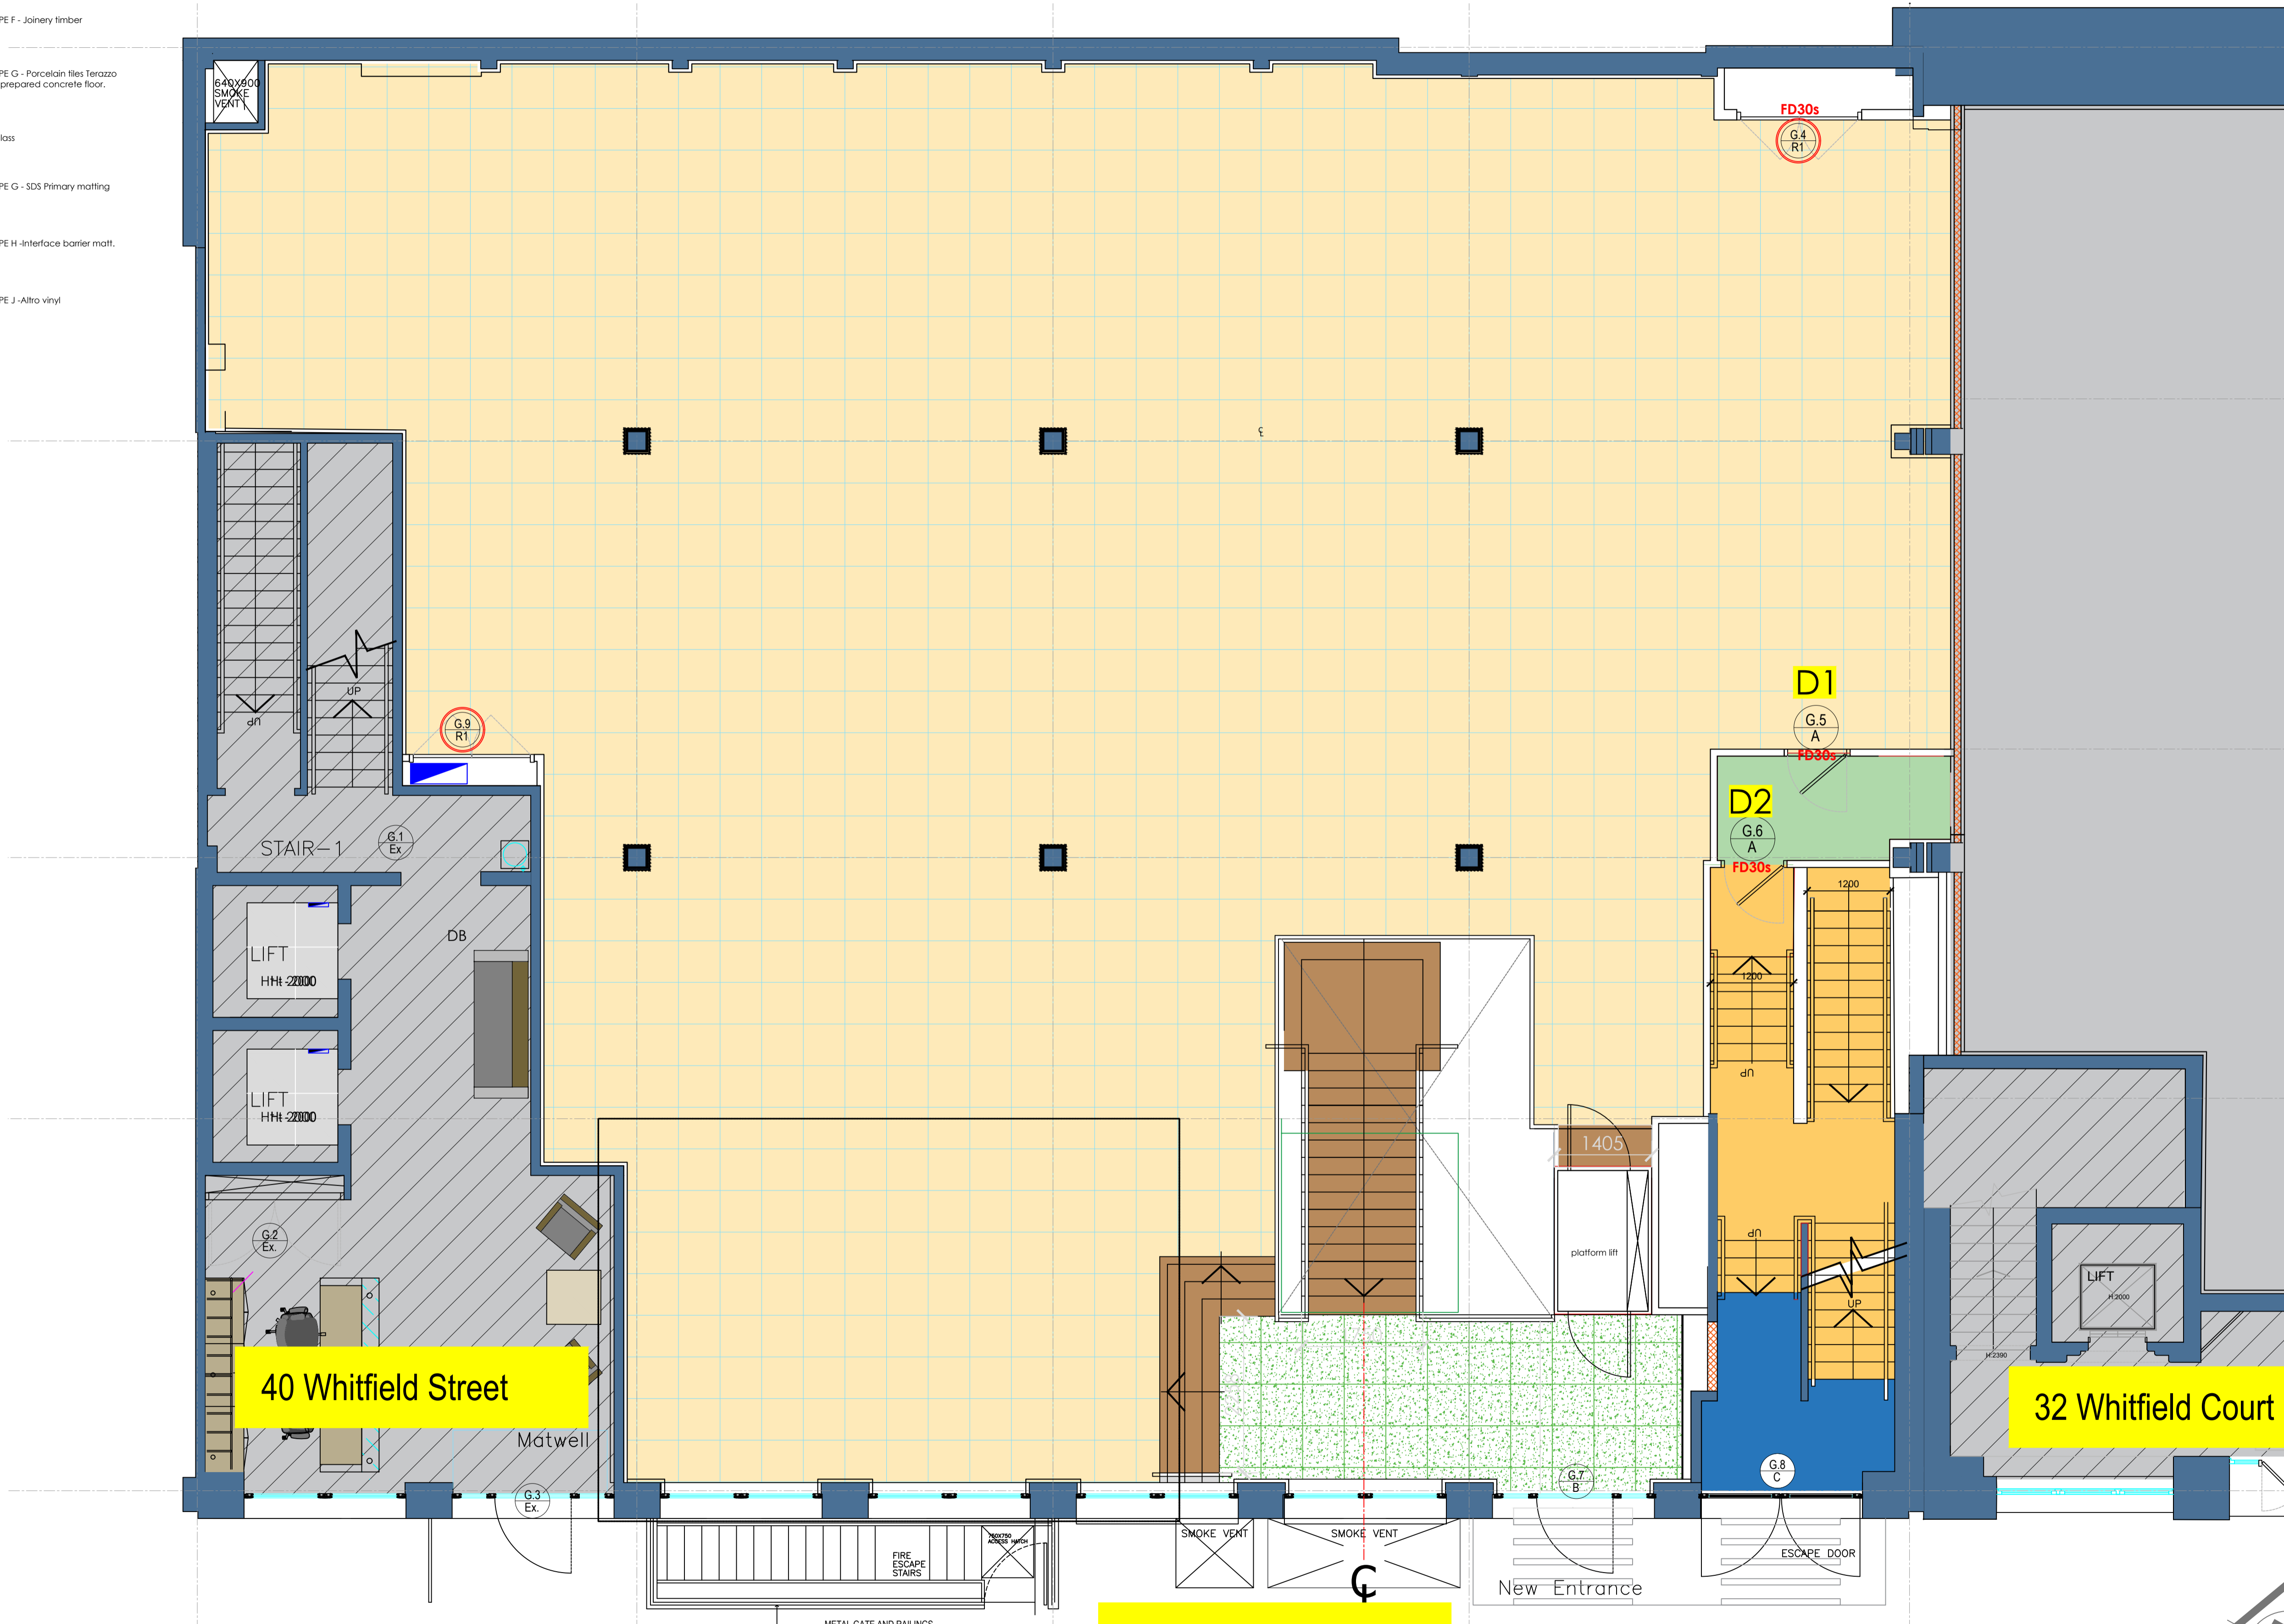

GROUND FLOOR AS BUILT FLOORING LAYOUT

THIS DRAWING REMAINS THE PROPERTY OF BASE INTERIORS LTD. IT MAY NOT BE COPIED OR REPRODUCED WITHOUT EXPRESS WRITTEN CONSENT. FIGURED DIMENSIONS SHOULD BE USED WHERE GIVEN.

REV	DESCRIPTION	DATE
Estates & Agency		
CLIENT		
38 Whitfield Street London W1T 2RH		
SITE ADDRESS		
AS BUILT		
GROUND FLOOR		
DRAWING TITLE		
EAA 516	G 005	
PROJECT NO.	DRAWING NO.	
1:50 on A1	Floor finishes	
SCALE	DESCRIPTION	
AV	16.01.2020	
DRAWN	DATE	

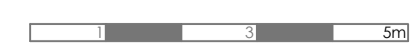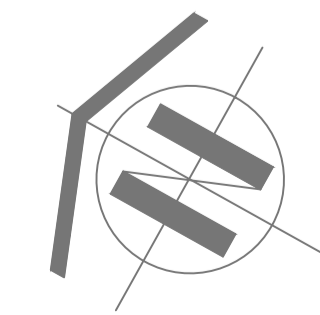

T. 020 7487 3222
F. 020 7487 3555
BASEINTERIORS

BASE

15 BERKELEY MEWS LONDON W1H 7AX