

Project

8 Gloucester Gate

Project address

8 Gloucester Gate
London
NW1 4HG

Client

Dory Gabbay and Tamara Gabbay

Sheet number

1146-DFA-030016

Sheet name

Proposed - Cross Section Through Closet Wing

Sheet scale

As indicated
@ A1

Date/time

08/08/2024 18:09:47

Rev	Description	Date	Issued	Checked
1	Planning Issue	08.08.24	ZI	PB

NOTE
Interior configuration and details to be further reviewed by interior designer

Project status





Planning

GENERAL NOTES:

This drawing is not for construction and is for information purposes only. Contractor to provide detailed design and construction information. This drawing is to be read in conjunction with all relevant architects' and engineers' drawings and specifications. Drawings to be read in line with the approved inspectors plan check and all dimensions to be checked on site with any discrepancies reported to the architect.

OS information no accurate and not to be used for measurements.

Downen Farmer Architects Ltd is incorporated in England & Wales. Company registration number 10861309.

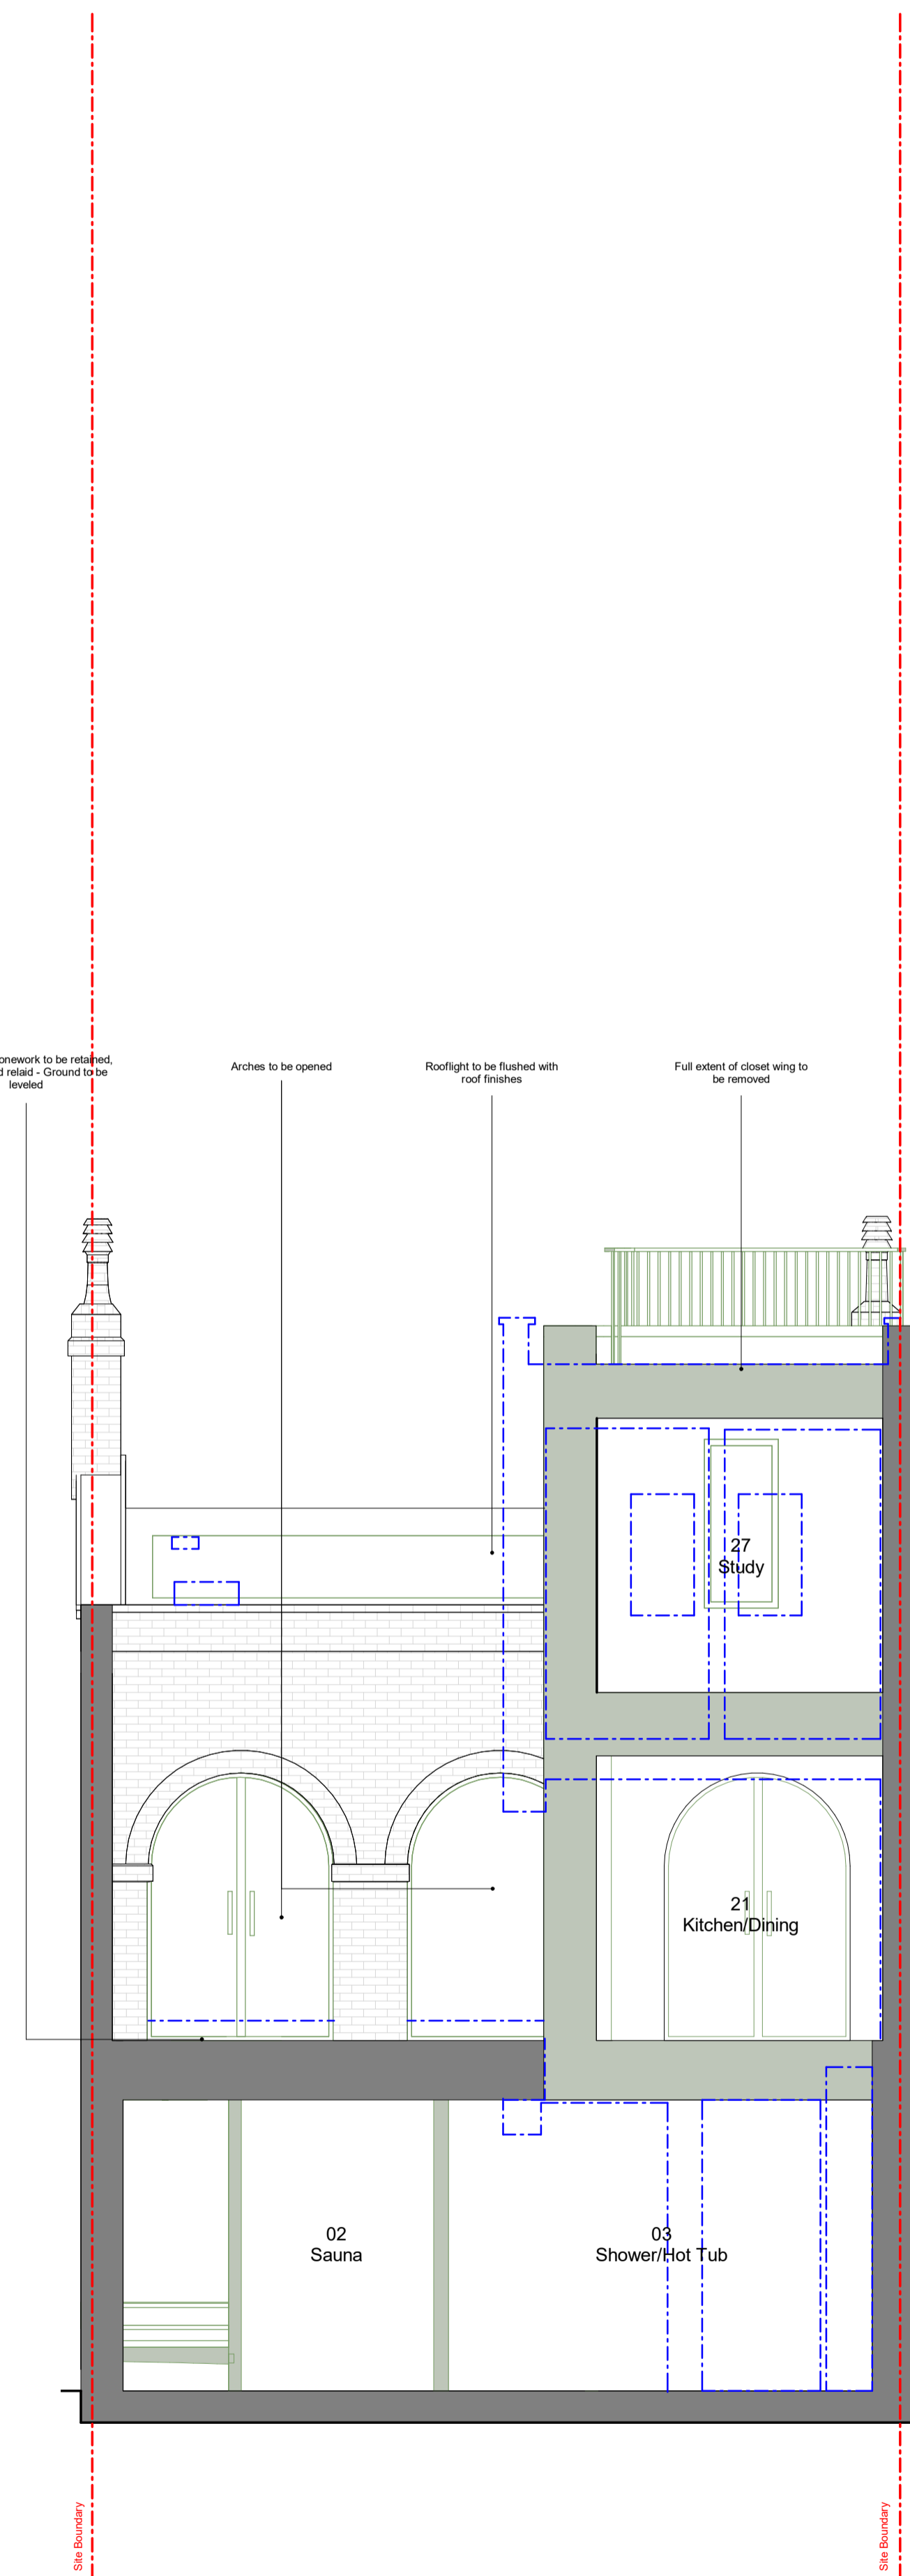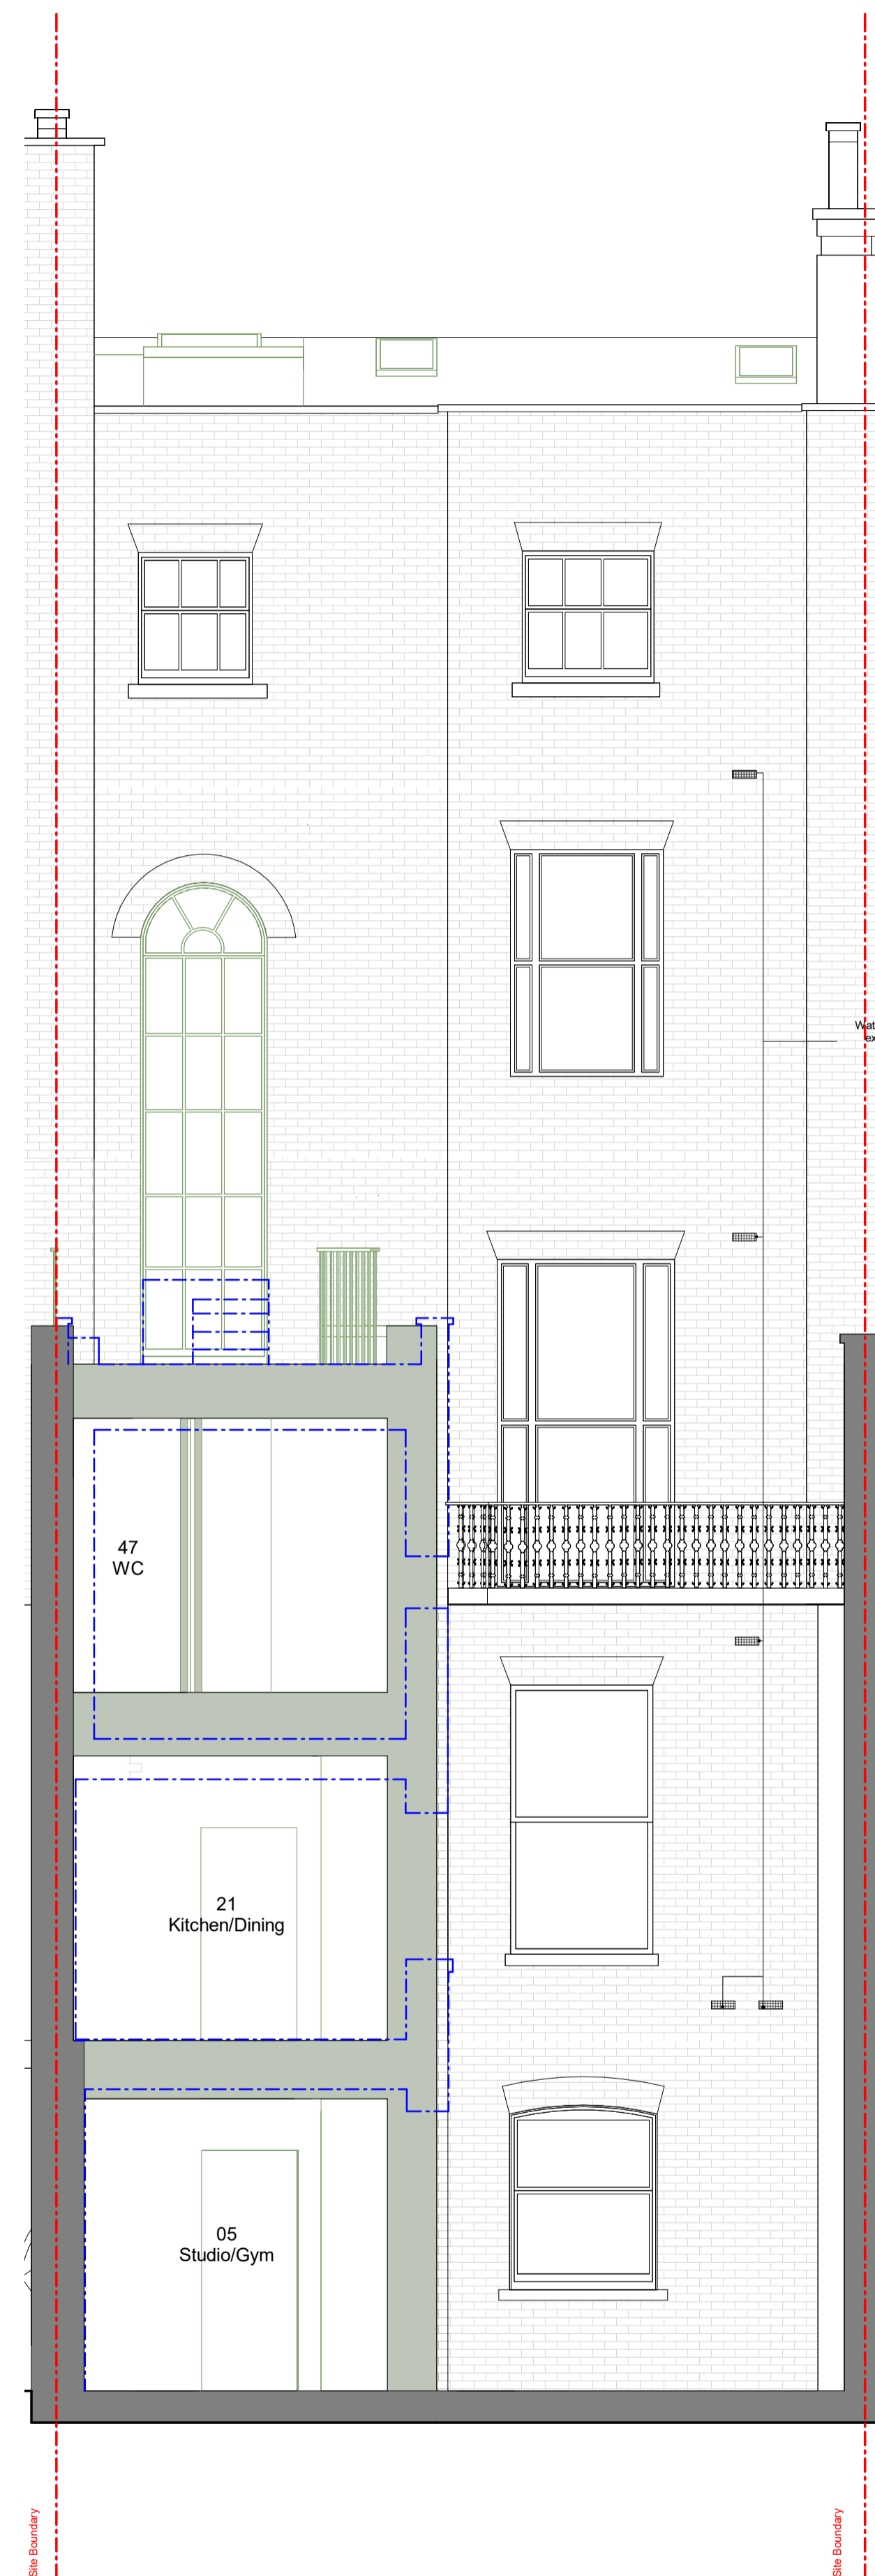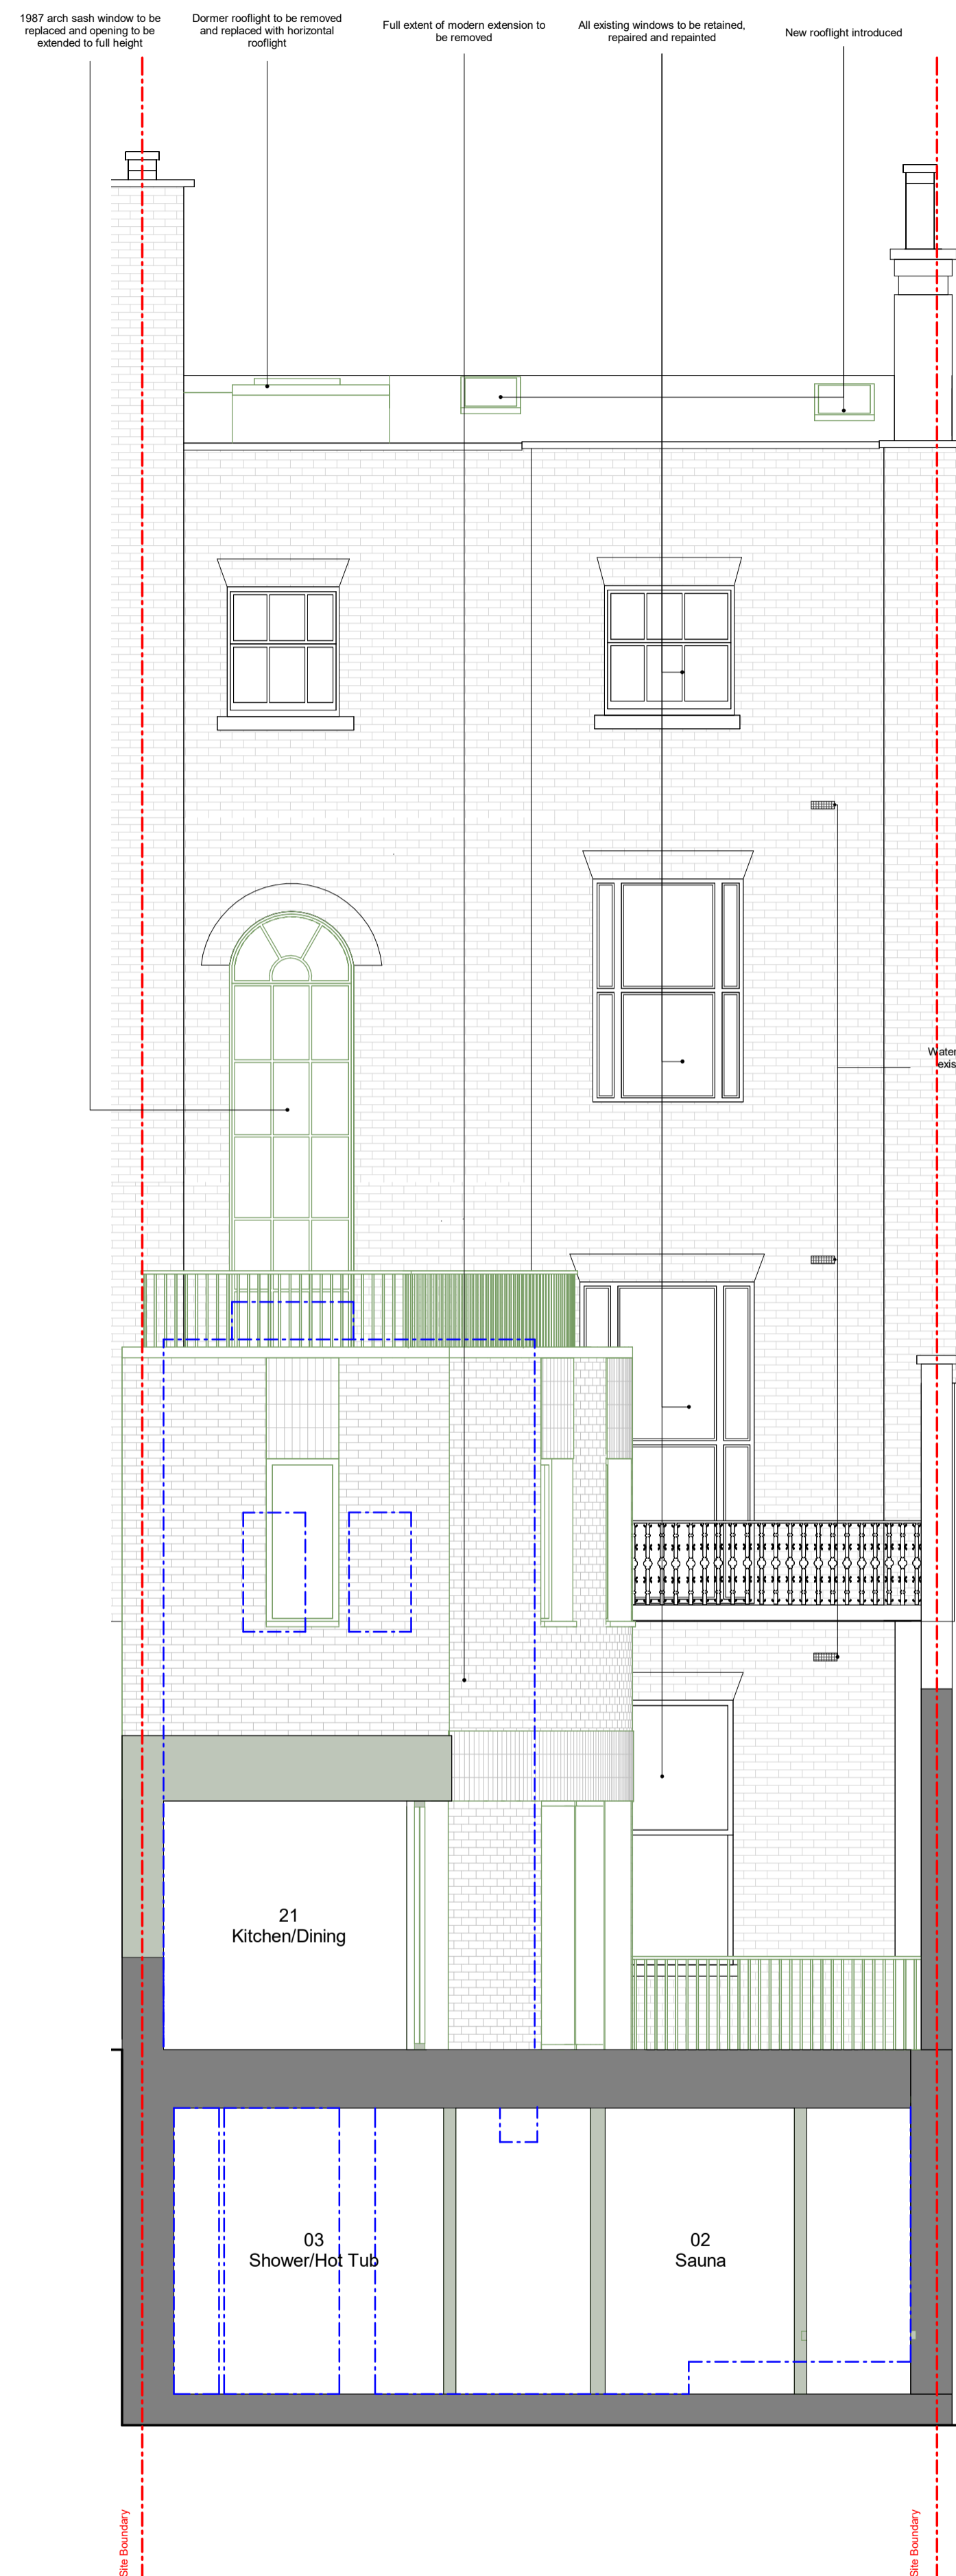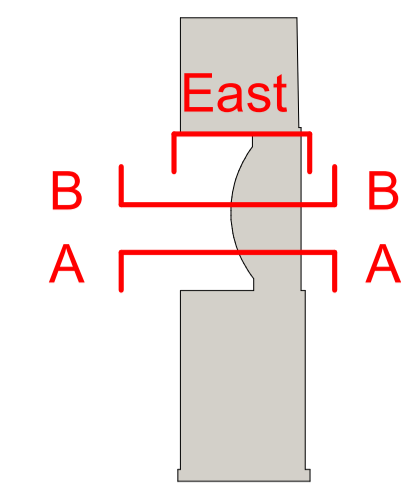

1 Proposed East Closet Wing Elevation
1 : 50

2 Cross Section Through Closet Wing A-A
1 : 50

3 Cross Section Through Closet Wing B-B
1 : 50

Scale Bar: 1:50 @ A1 (Metres)

