



1 Pre-2023 Basement Plan (02)20 Scale: 1:50



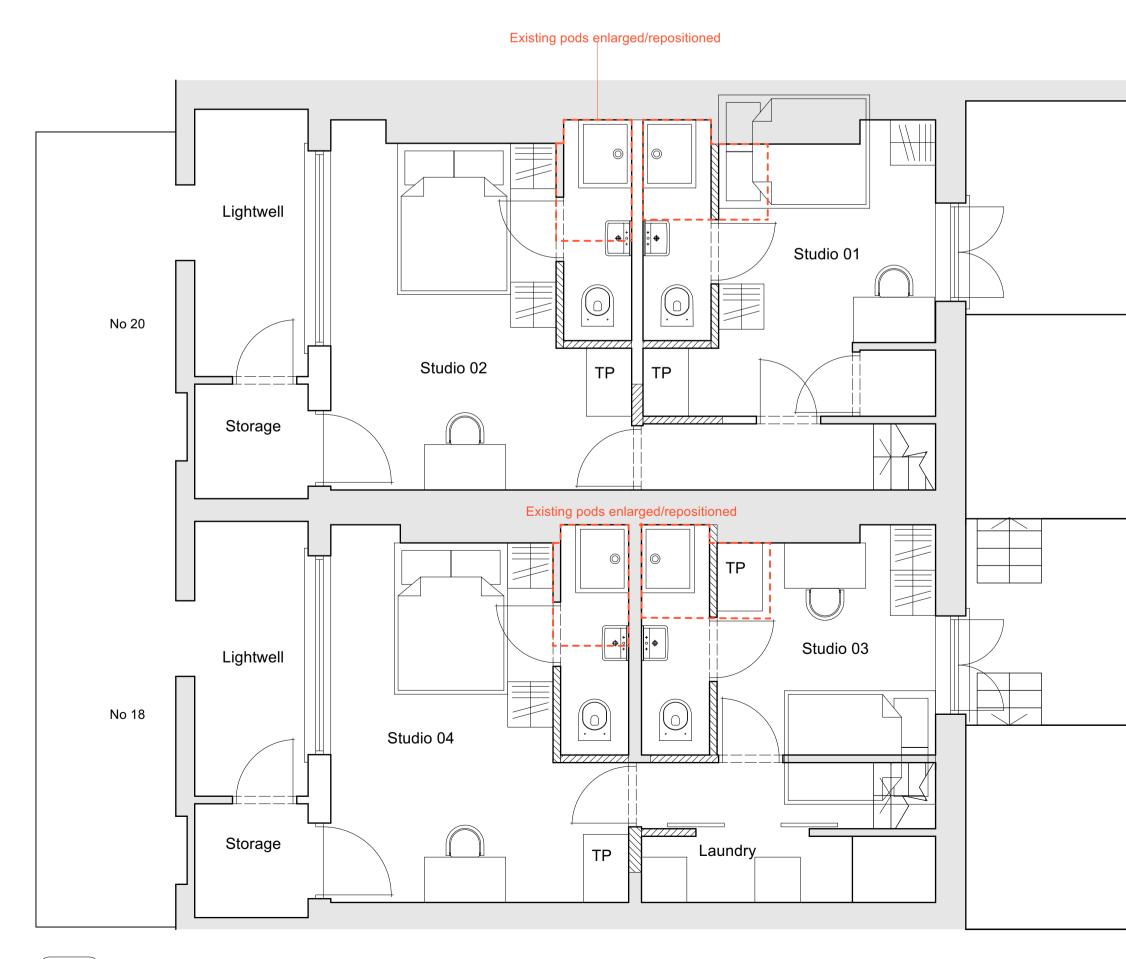

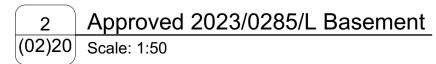

EXISTING

NEW

---- DEMOLITIONS

3 As-Built Basement Plan - Tea Points (02)20 Scale: 1:50



4 As-Built Basement Plan - En-suite (02)20 Scale: 1:50

