



1 Pre-2023 Second Floor Plan
(02)23 Scale: 1:50



2 Approved 2023/0285/L Second Floor Plan
(02)23 Scale: 1:50

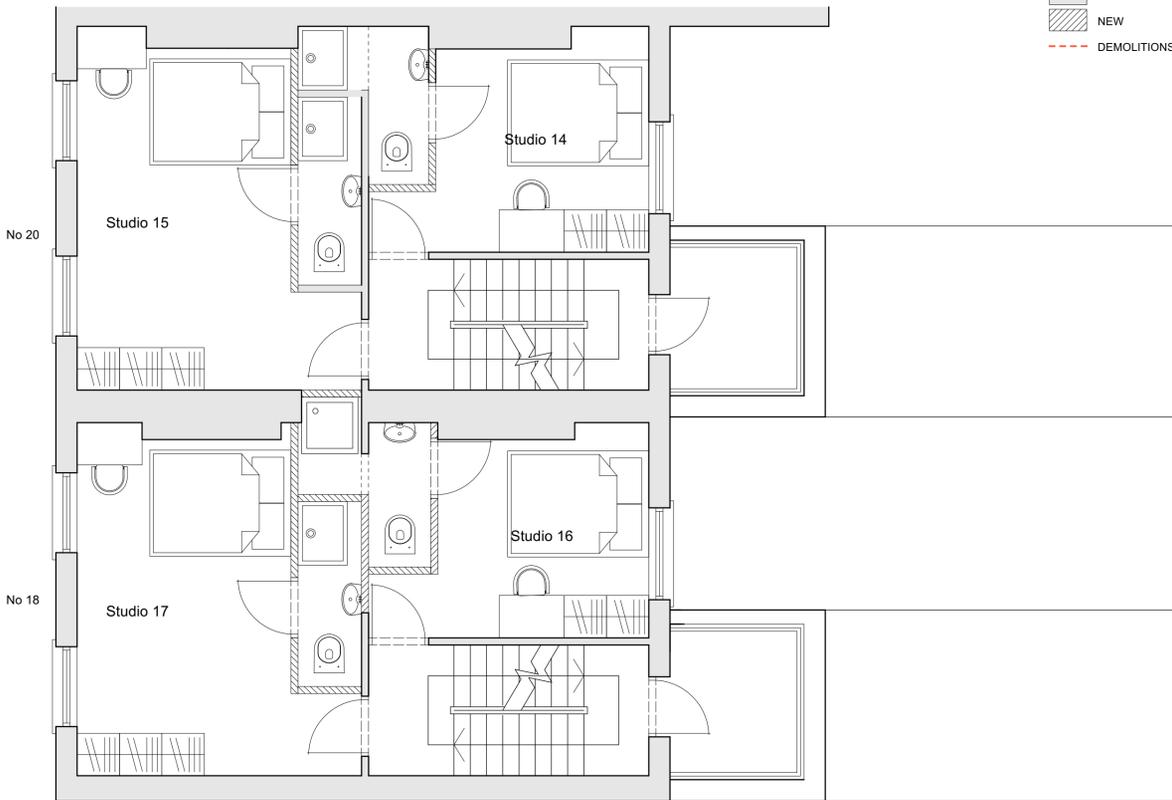

3 As-Built Second Floor Plan - Tea Points
(02)23 Scale: 1:50

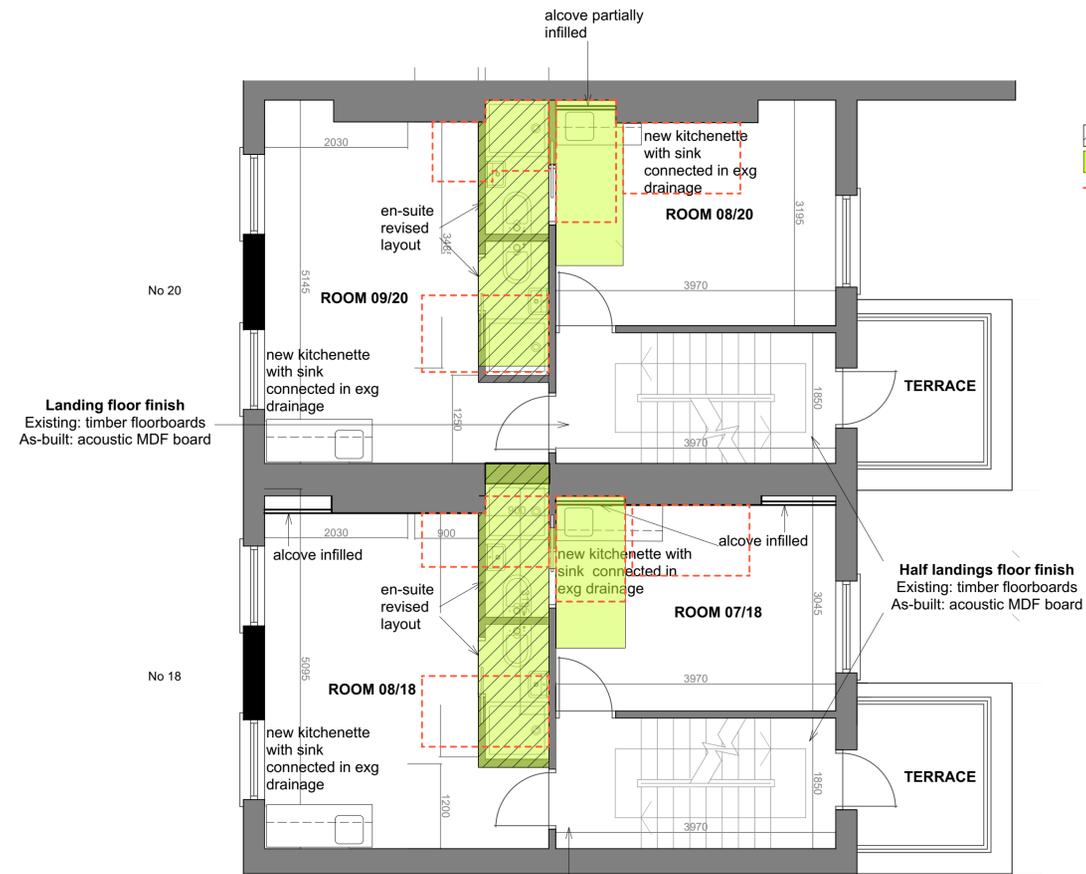

4 As-Built Second Floor Plan - En-suite
(02)23 Scale: 1:50

AS BUILT
CONSENTED
PRE-EXISTING

AS BUILT
CONSENTED
PRE-EXISTING

Notes		
B	Annotations updated	08/05/2024
A	Annotations updated	03/05/2024
Revisions		
Kelley House 18-20 Royal College Street NW1 Comparative plans - Second Floor		
ROGER MEARS ARCHITECTS LLP <small>Union Chapel, Compton Avenue London N1 2XD</small>		
<small>mra@mears.co.uk Tel 020 7350 8222 www.mears.co.uk © Roger Mears Architects LLP</small>		
Date	Scale	
Sep 2024	1:50@A1	
Job No.	Dwg No.	Rev
2245	(02)23	B

