


Pre-2023 Third Floor Plan (02)24 Scale: 1:50

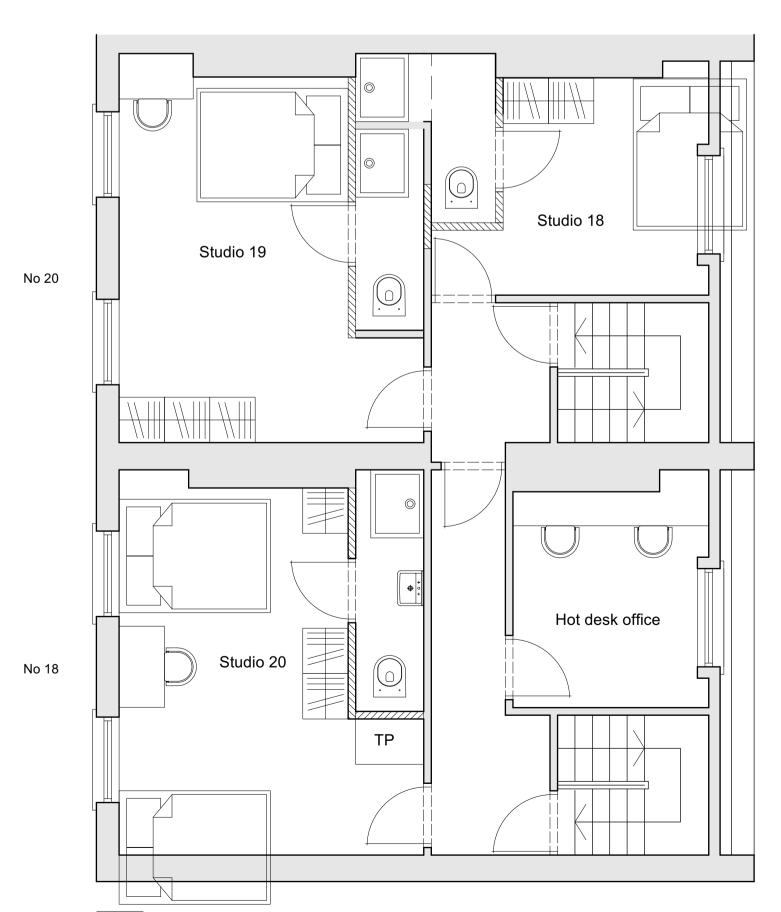

EXISTING

NEW

---- DEMOLITIONS

2 Approved 2023/0285/L Third Floor Plan (02)24 Scale: 1:50







As-built: acoustic MDF board

(02)24 Scale: 1:50

(02)24 Scale: 1:50



Notes