




EXISTING SECOND FLOOR PLAN
NO CHANGES

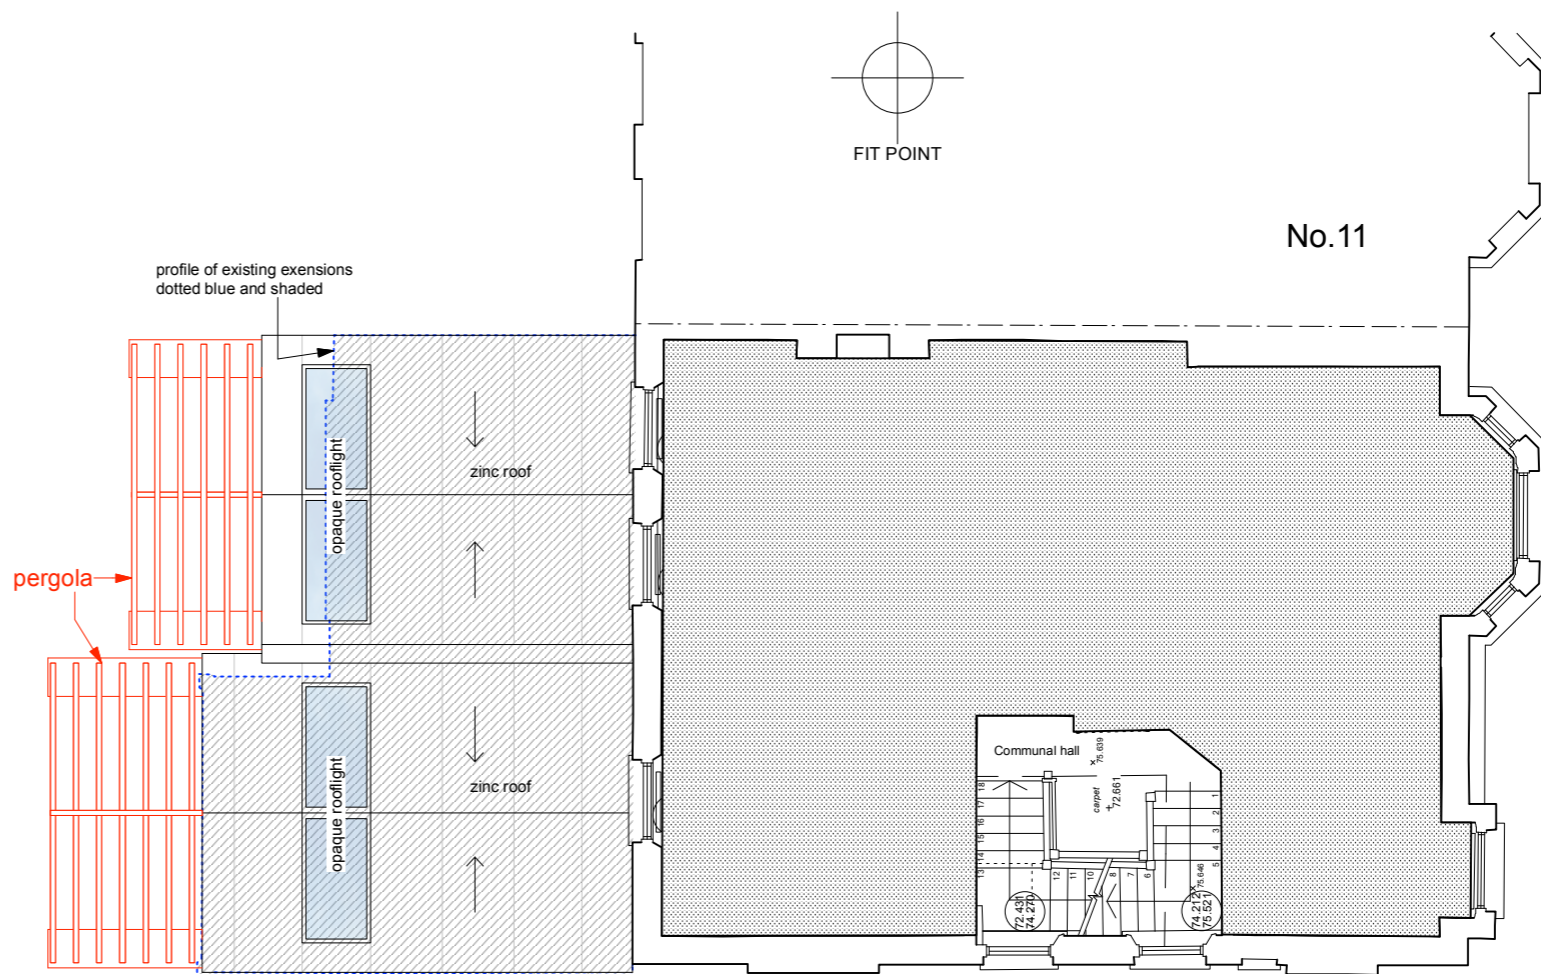



all rooflights to be obscured glazed and non-openable

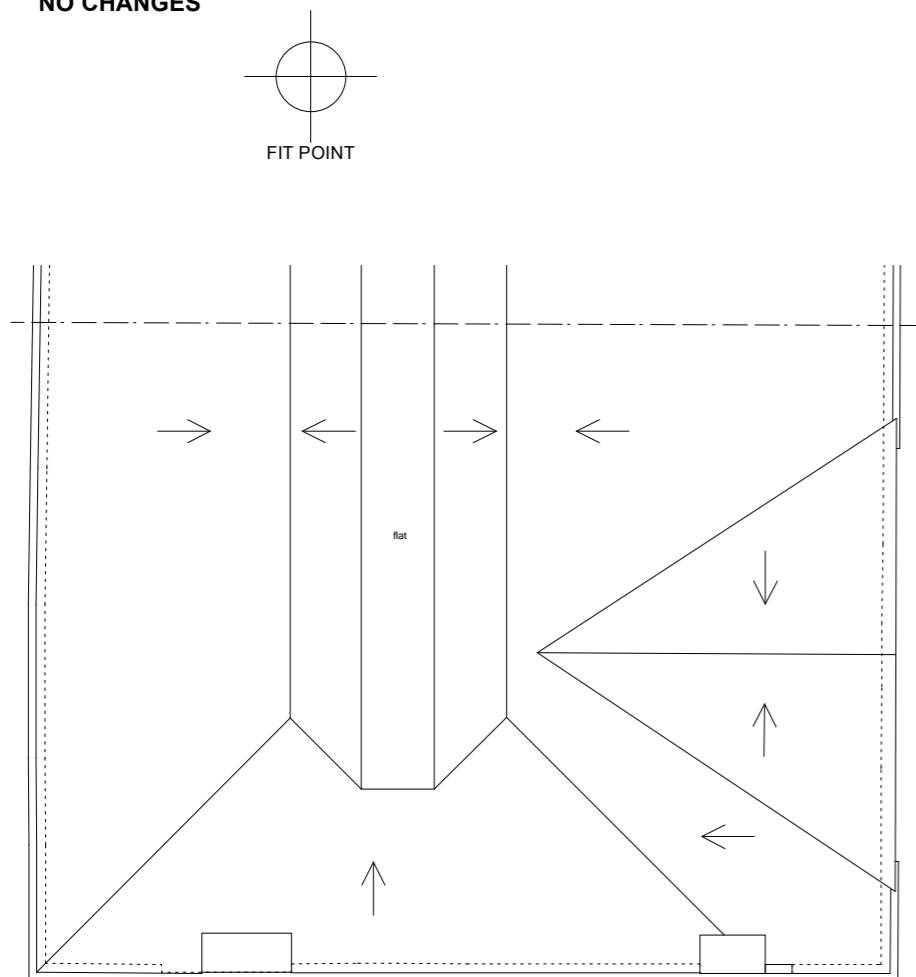


EXISTING ROOF PLAN
NO CHANGES

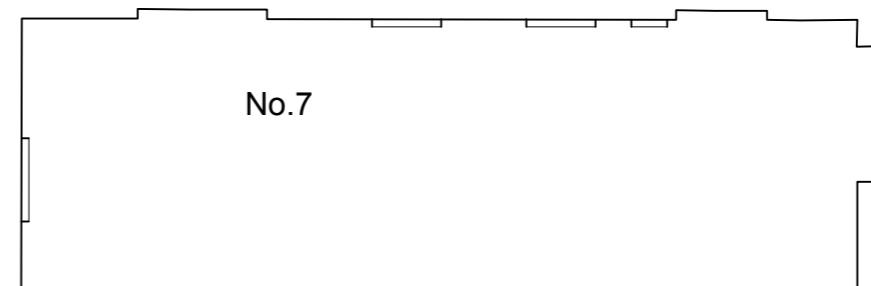

EXISTING FIRST FLOOR PLAN

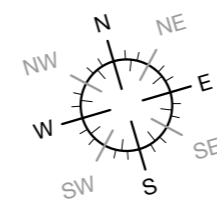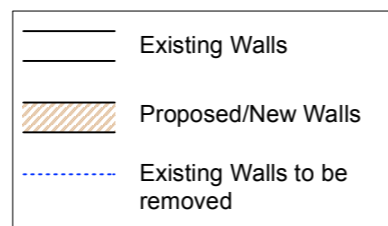

scale bar - metric

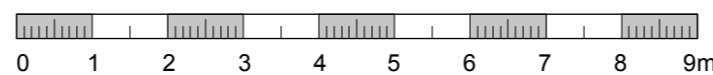

scale bar - imperial



Differences from Permitted Application 2022/0314/P shown in red

BROD WIGHT
Architects

8a Baynes Mews --- London --- NW3 5BH

Project Address:
Ground Floor/Garden Flat, 9
Downside Crescent NW3 2AN

www.brodwight.co.uk office@brodwight.co.uk
Tel 020 7722 0810 This drawing is copyright

Drawing Title:
Proposed 1st and 2nd Floors
Planning Issue

Drawing Ref:
1122-AP05-02

Date: January 2022 Scale: 1:100@A3/1:50@A1

Rev