



PROPOSED FRONT ELEVATION (street view)

Differences from Permitted Application 2022/0314/P shown in red
(NO CHANGES)

BROD WIGHT
Architects

8a Baynes Mews --- London --- NW3 5BH

Project Address:

**Ground Floor/Garden Flat, 9
Downside Crescent NW3 2AN**

www.brodwight.co.uk office@brodwight.co.uk
Tel 020 7722 0810 This drawing is copyright

Drawing Title:

Proposed Front Elevation

Planning Issue

Drawing Ref:


1122-AP05-03

Date


January 2022

Scale

1:100@A3/1:50@A1

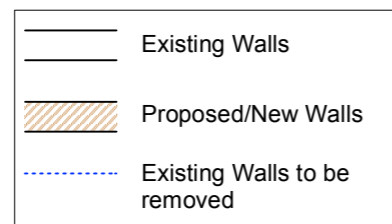

scale bar - metric

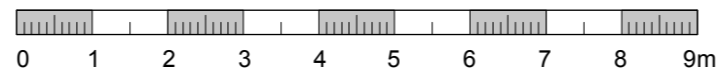

scale bar - imperial

