



PROPOSED SIDE ELEVATION

Differences from Permitted Application 2022/0314/P shown in red

Rev  
obs

**BROD WIGHT**  
**Architects**

8a Baynes Mews --- London --- NW3 5BH

Project Address:  
**Ground Floor/Garden Flat, 9**  
**Downside Crescent NW3 2AN**

www.brodwight.co.uk office@brodwight.co.uk  
Tel 020 7722 0810 This drawing is copyright


Drawing Title:  
**Proposed Side Elevation**

**Planning Issue**


Drawing Ref:  
**1122-AP05-05**

Date  
January 2022

Scale  
1:100@A3/1:50@A1

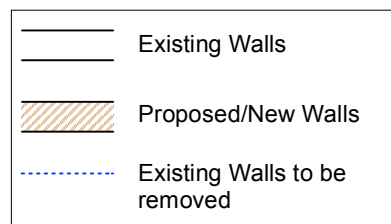

scale bar - metric

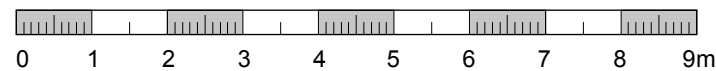

scale bar - imperial

