




ELEVATION - EXISTING

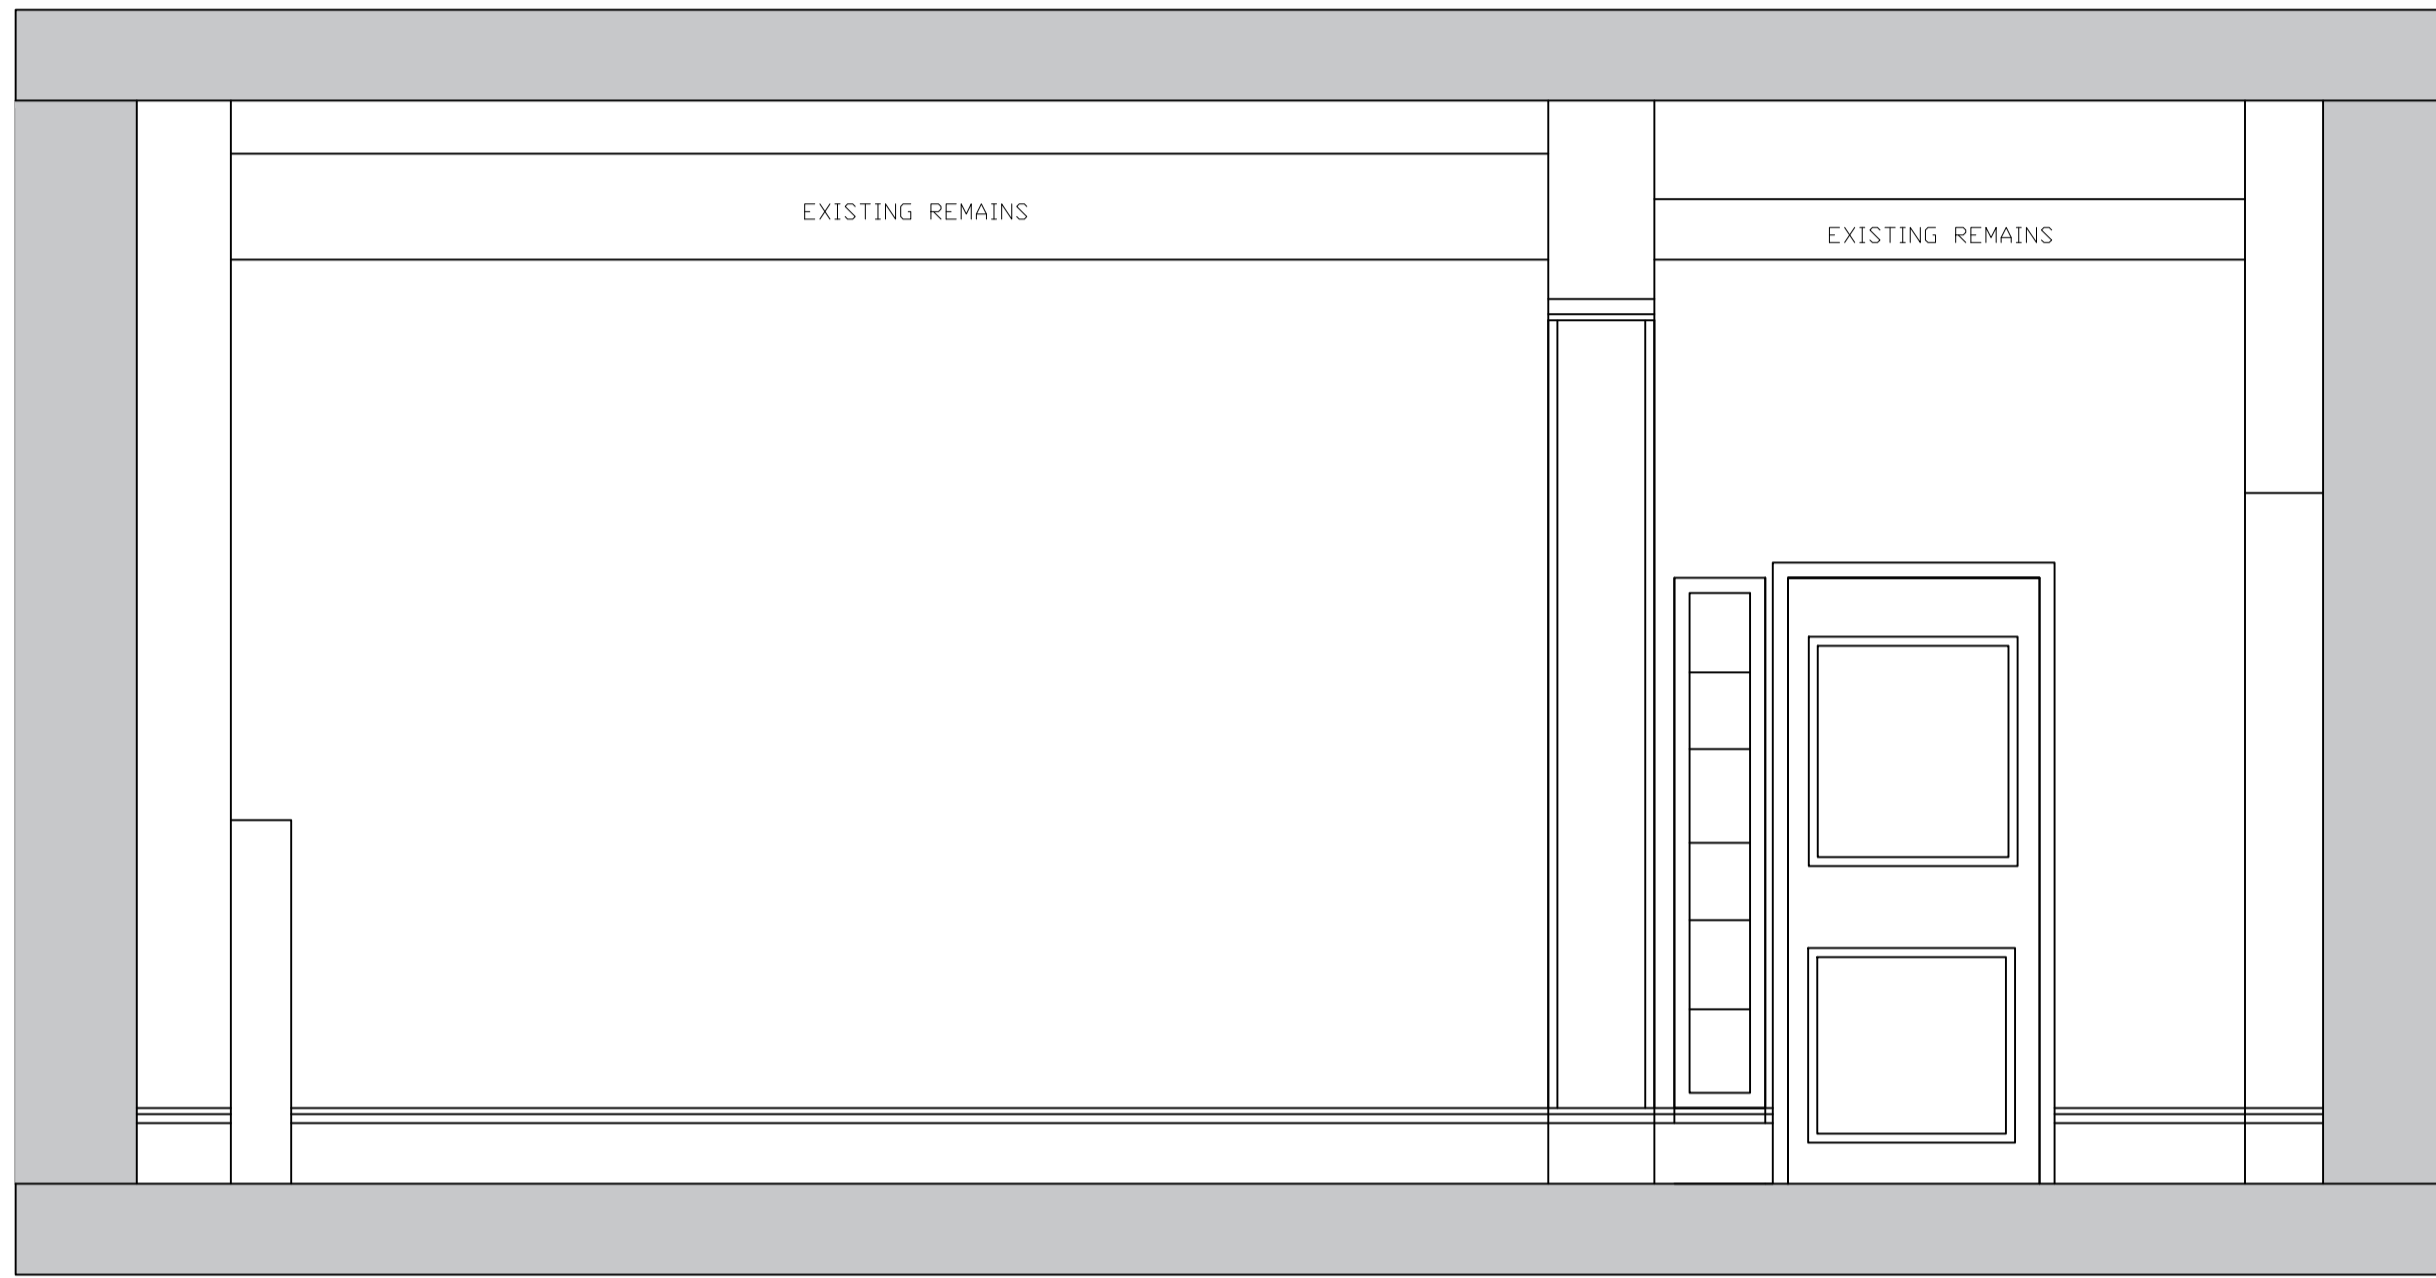


ELEVATION - STRIP OUT

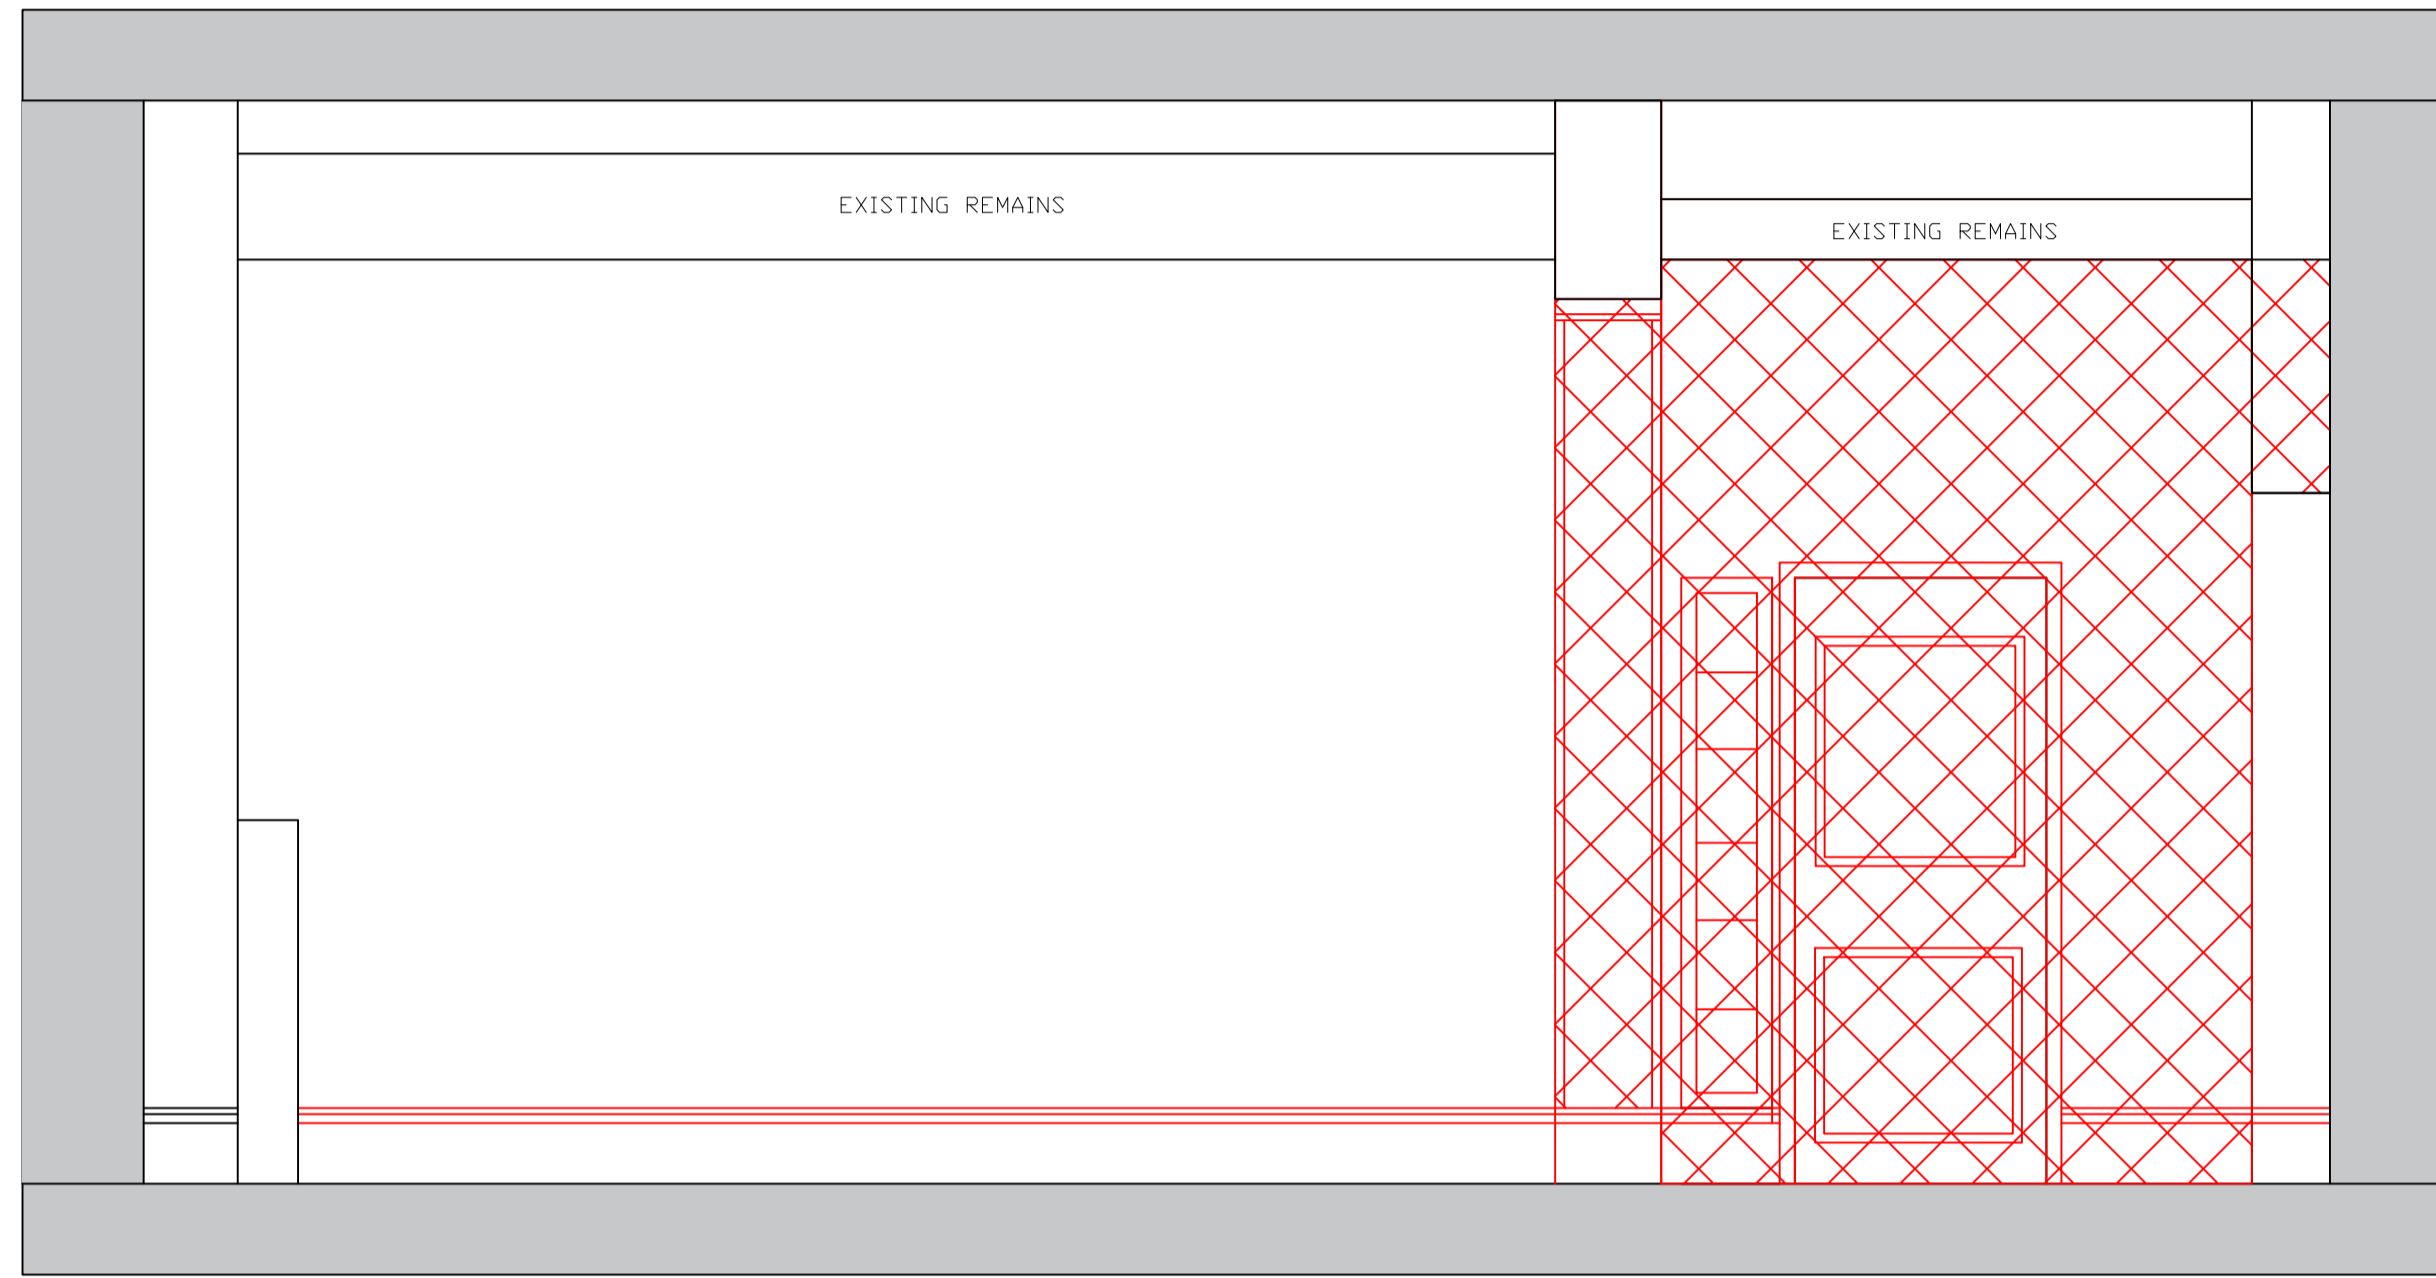

ELEVATION - PROPOSED UNFURNISHED

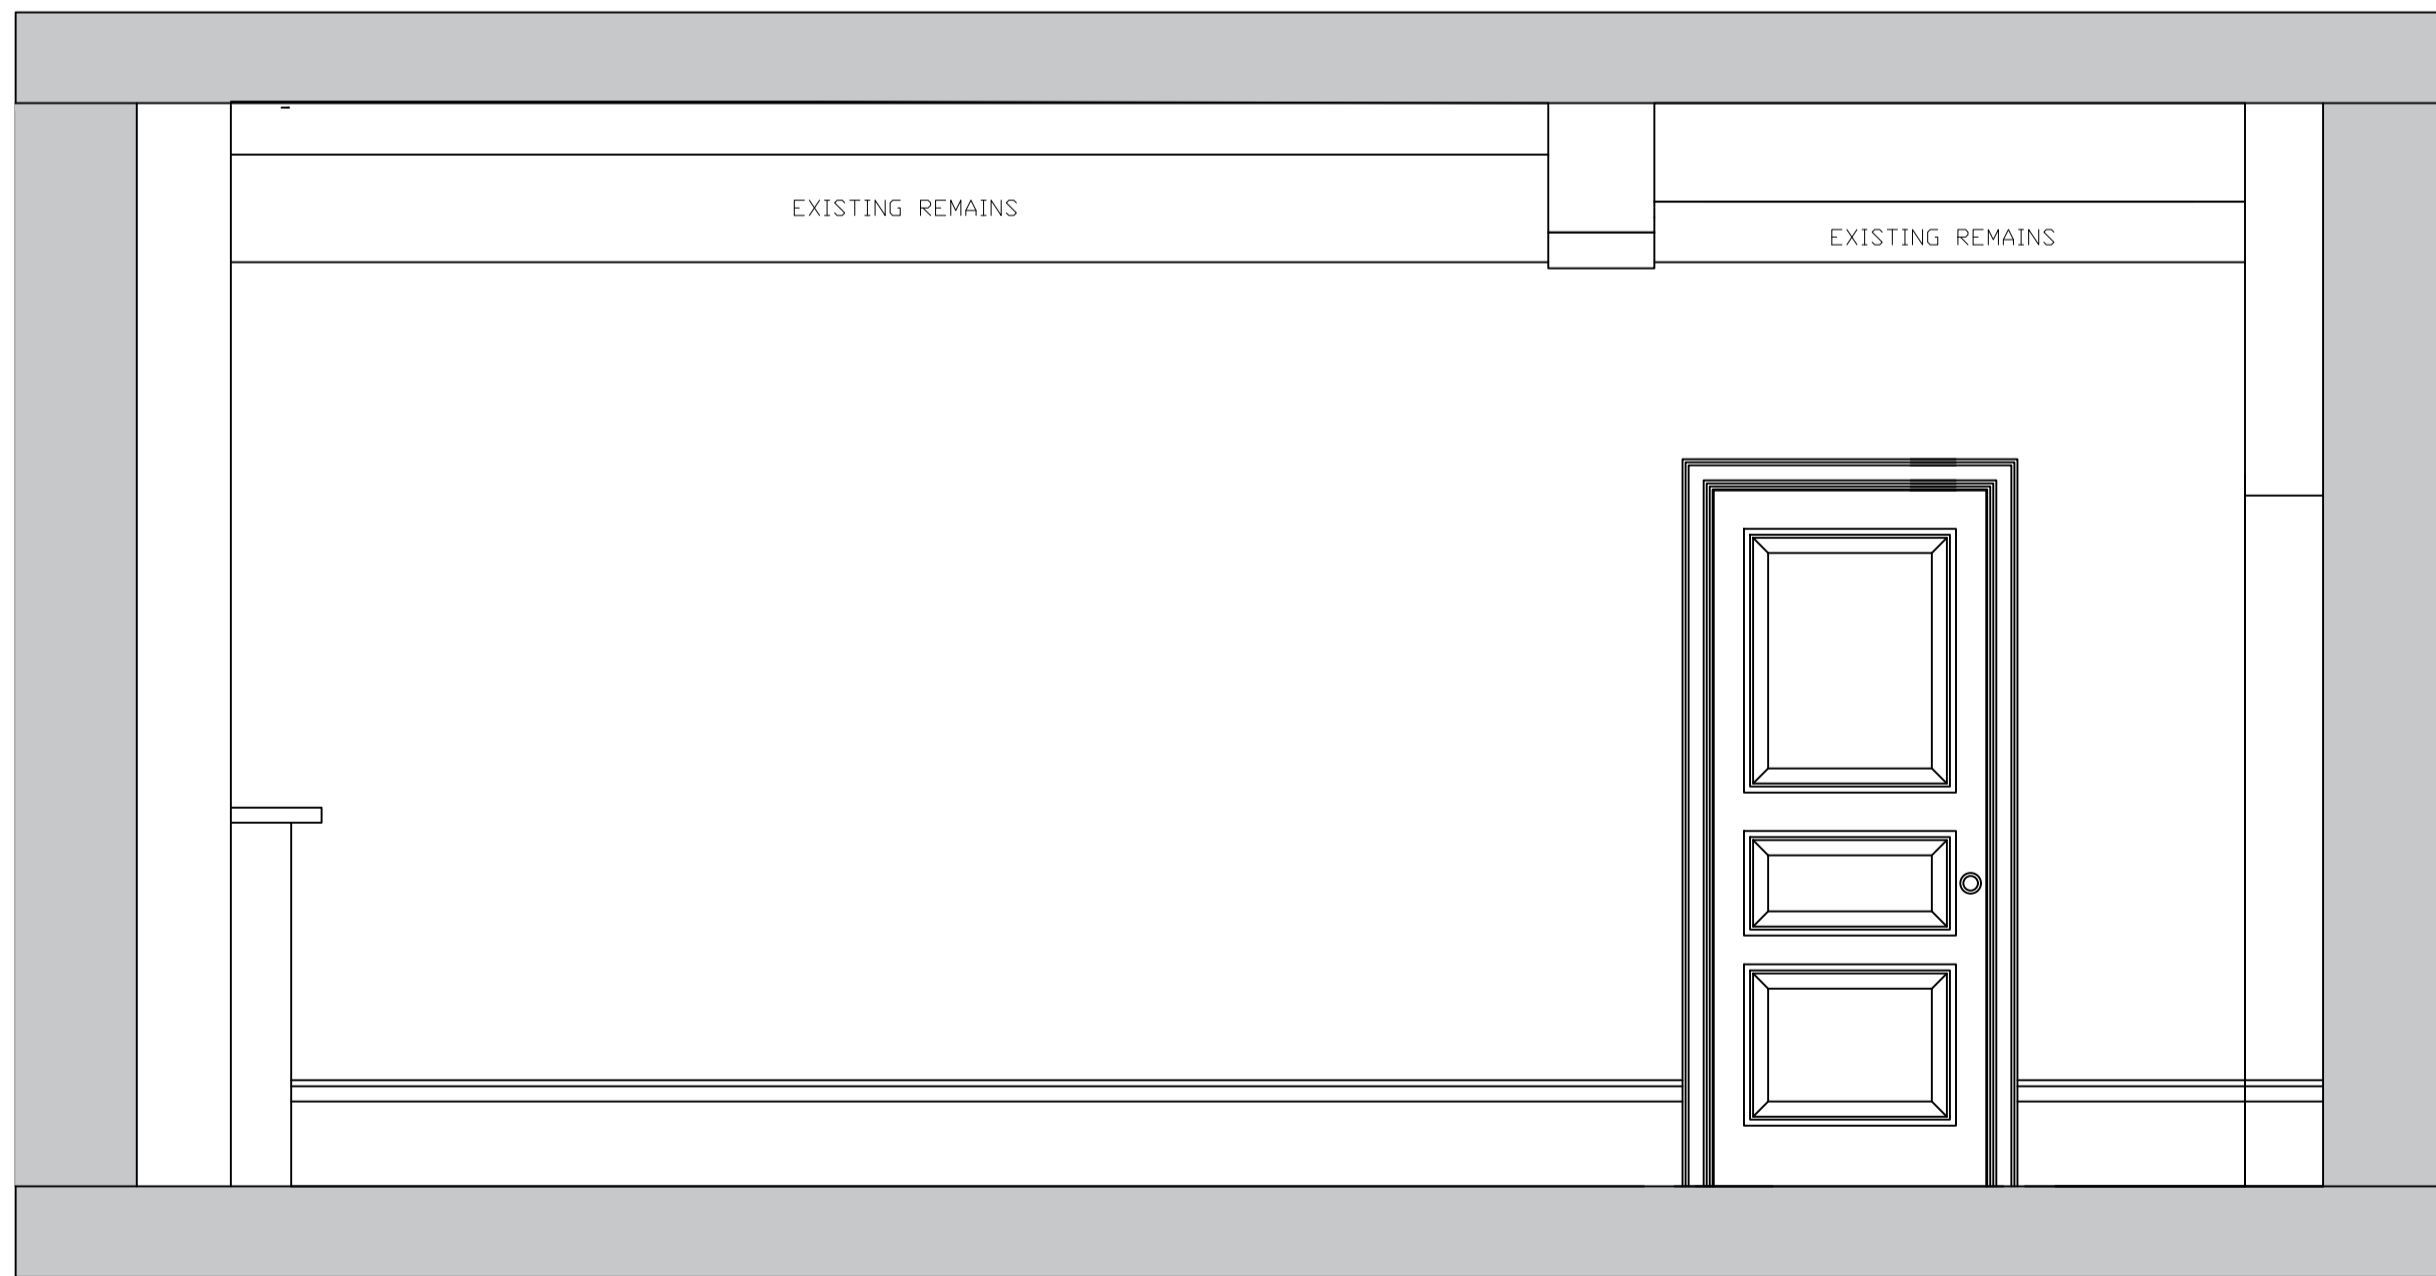

ELEVATION - EXISTING PICTURE

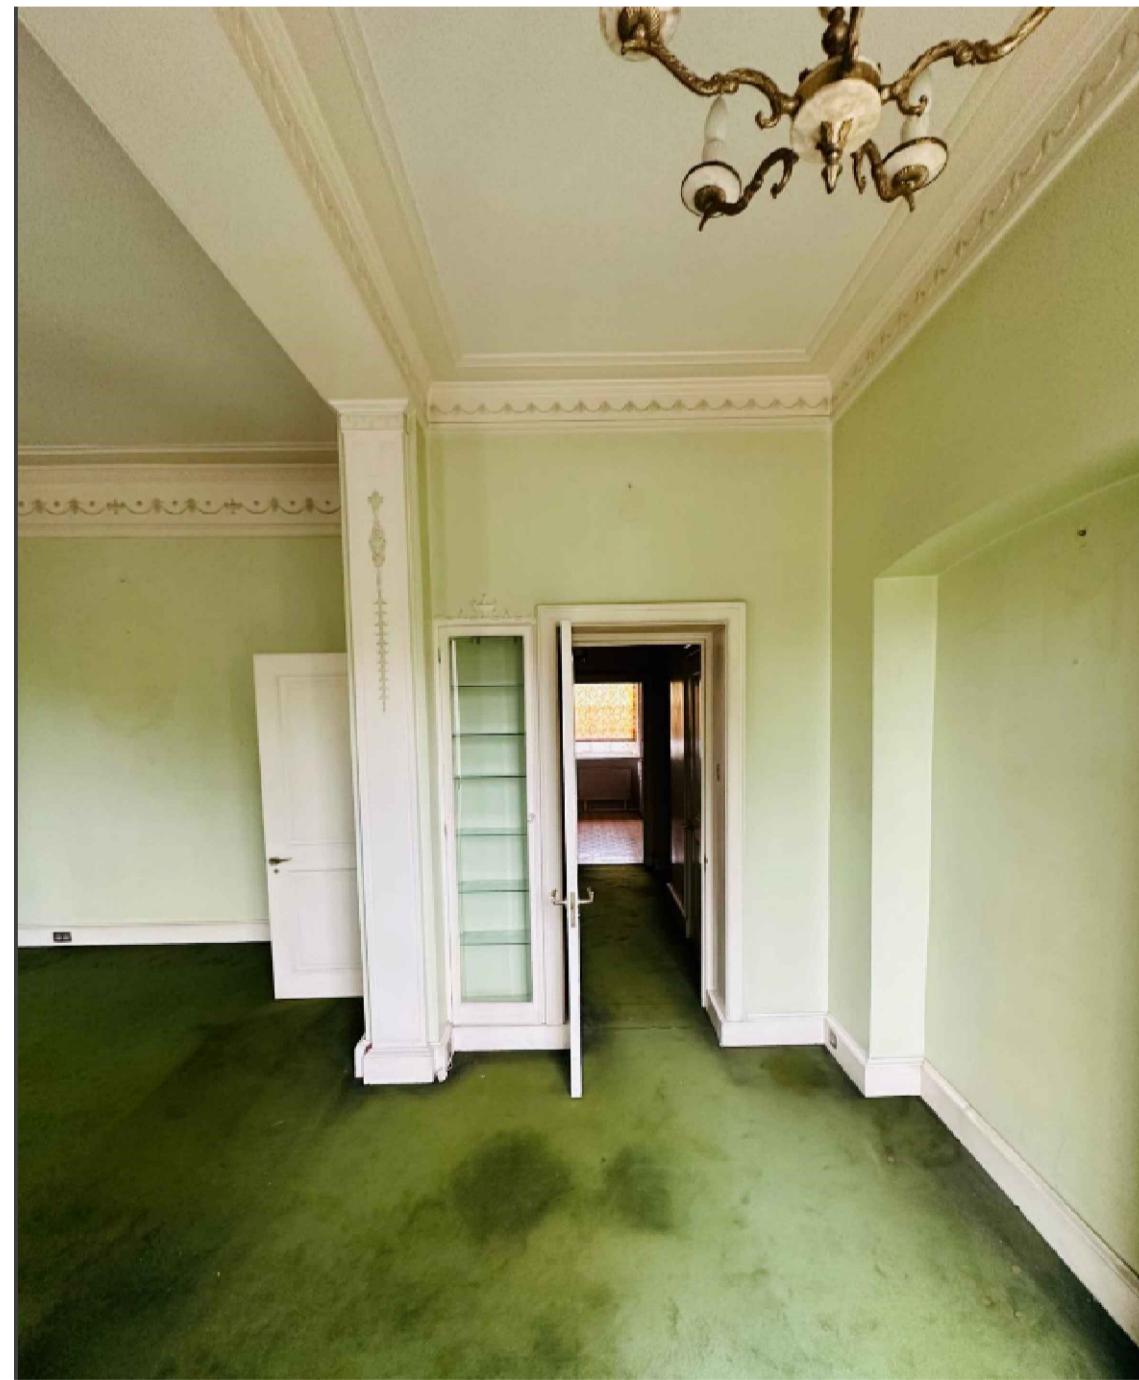

General Notes

NOTES:
RED LINES INDICATES
STRIP OUT ELEMENT

R1	RECEPTION CORNICE REMAINS	09/10
No.	Revision/Issue	Date

Firm Name and Address
SPEC GROUP
SOLAR HOUSE
915 HIGH ROAD
N12 8QJ
LONDON

Project Name and Address
5 CUMBERLAND TERRACE

Title ELEVATION B	Drawing # 252
Date 18/06/2024	
Scale 1:20 @ A1	