



NOTES
1) THE AS BUILT LAYOUT IS BASED ON A DIGITAL SURVEY.
AT THE TIME OF THE ORIGINAL PLANNING DRAWINGS THE SITE WAS DERELICT AND THE SITE WAS NOT SURVEYED DIGITALLY
2) DRAWINGS TO BE READ IN CONJUNCTION WITH DRAWING NUMBERS 21064/A01 TO A04 AND NUMBERS 21064/B01 TO B05

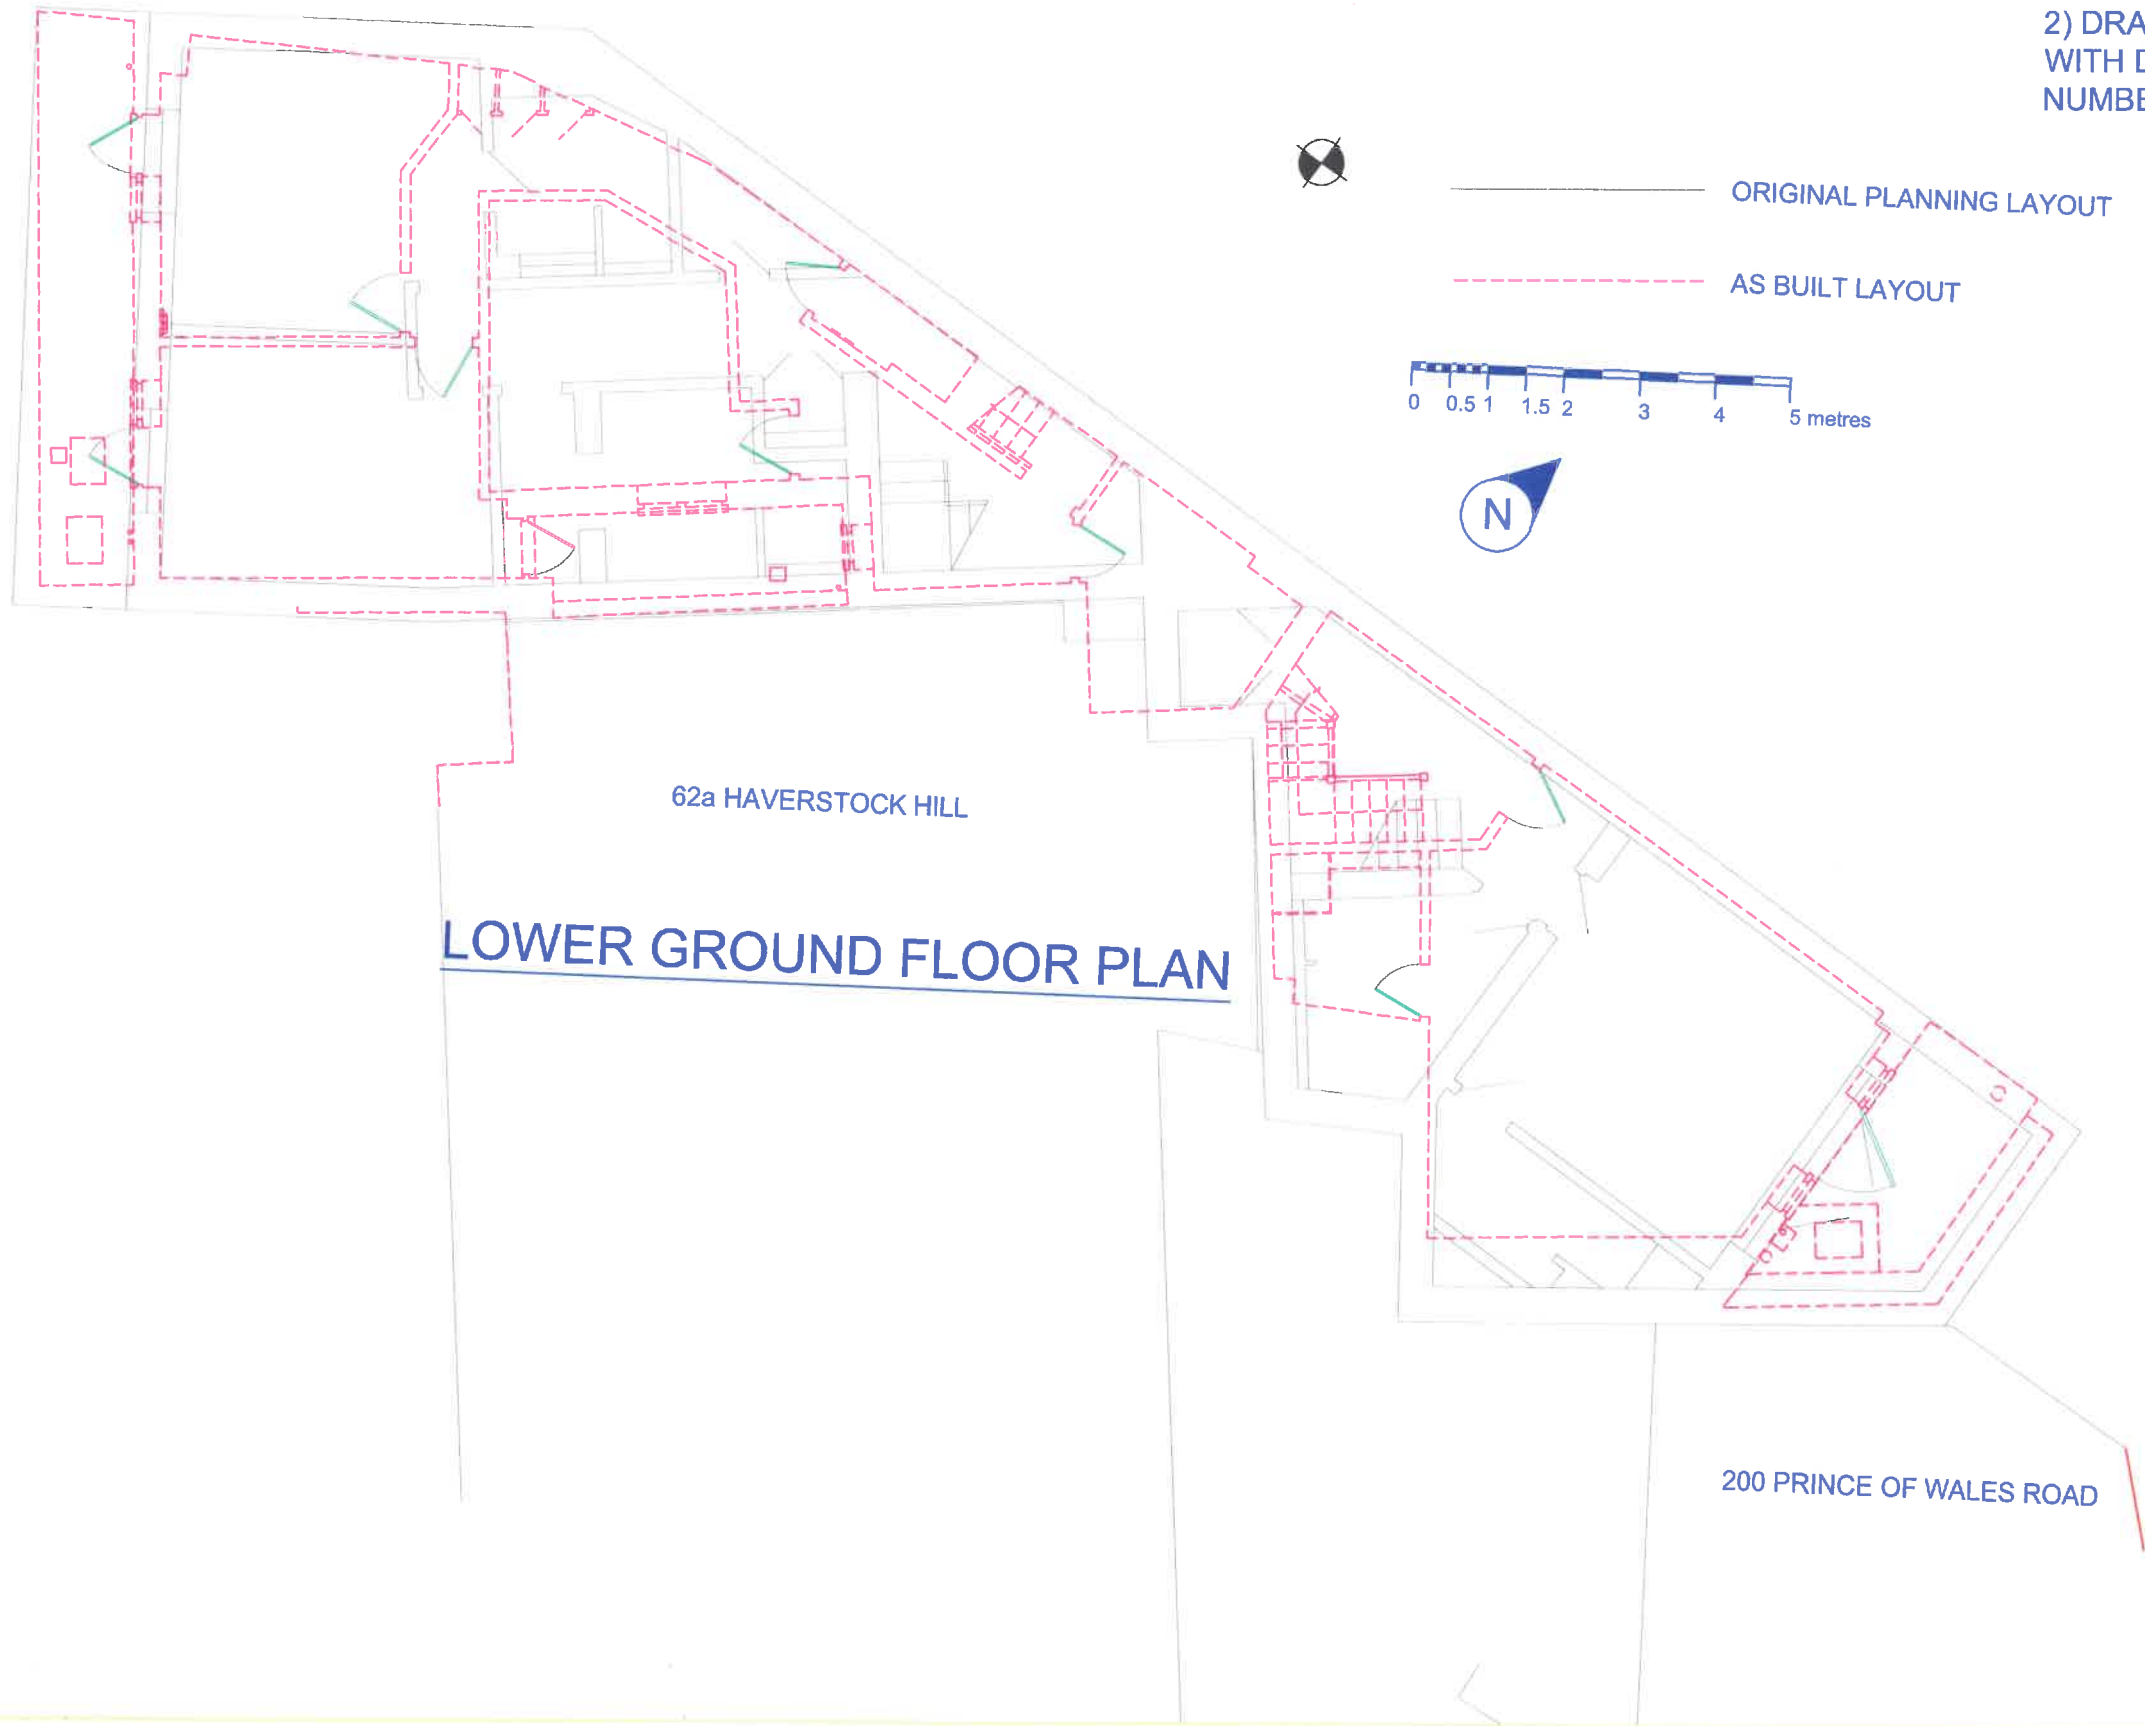


Suffix	Revision	Date
KLF STRUCTURAL DESIGN LIMITED Consulting Engineers SBC House Wallington SM6 7AH 020 8619 0359 KLF_Structural_Design@yahoo.com		
Job 62A HAVERSTOCK HILL LONDON NW3		
Title ORIGINAL PLANNING/AS BUILT OVERLAY LOWER GROUND FLOOR PLAN		
Drawn TM	Date OCT 24	Checked Date Scale 1:100 @ A3
Sheet Size A3		Sheet No. 21064/C01
Revision		

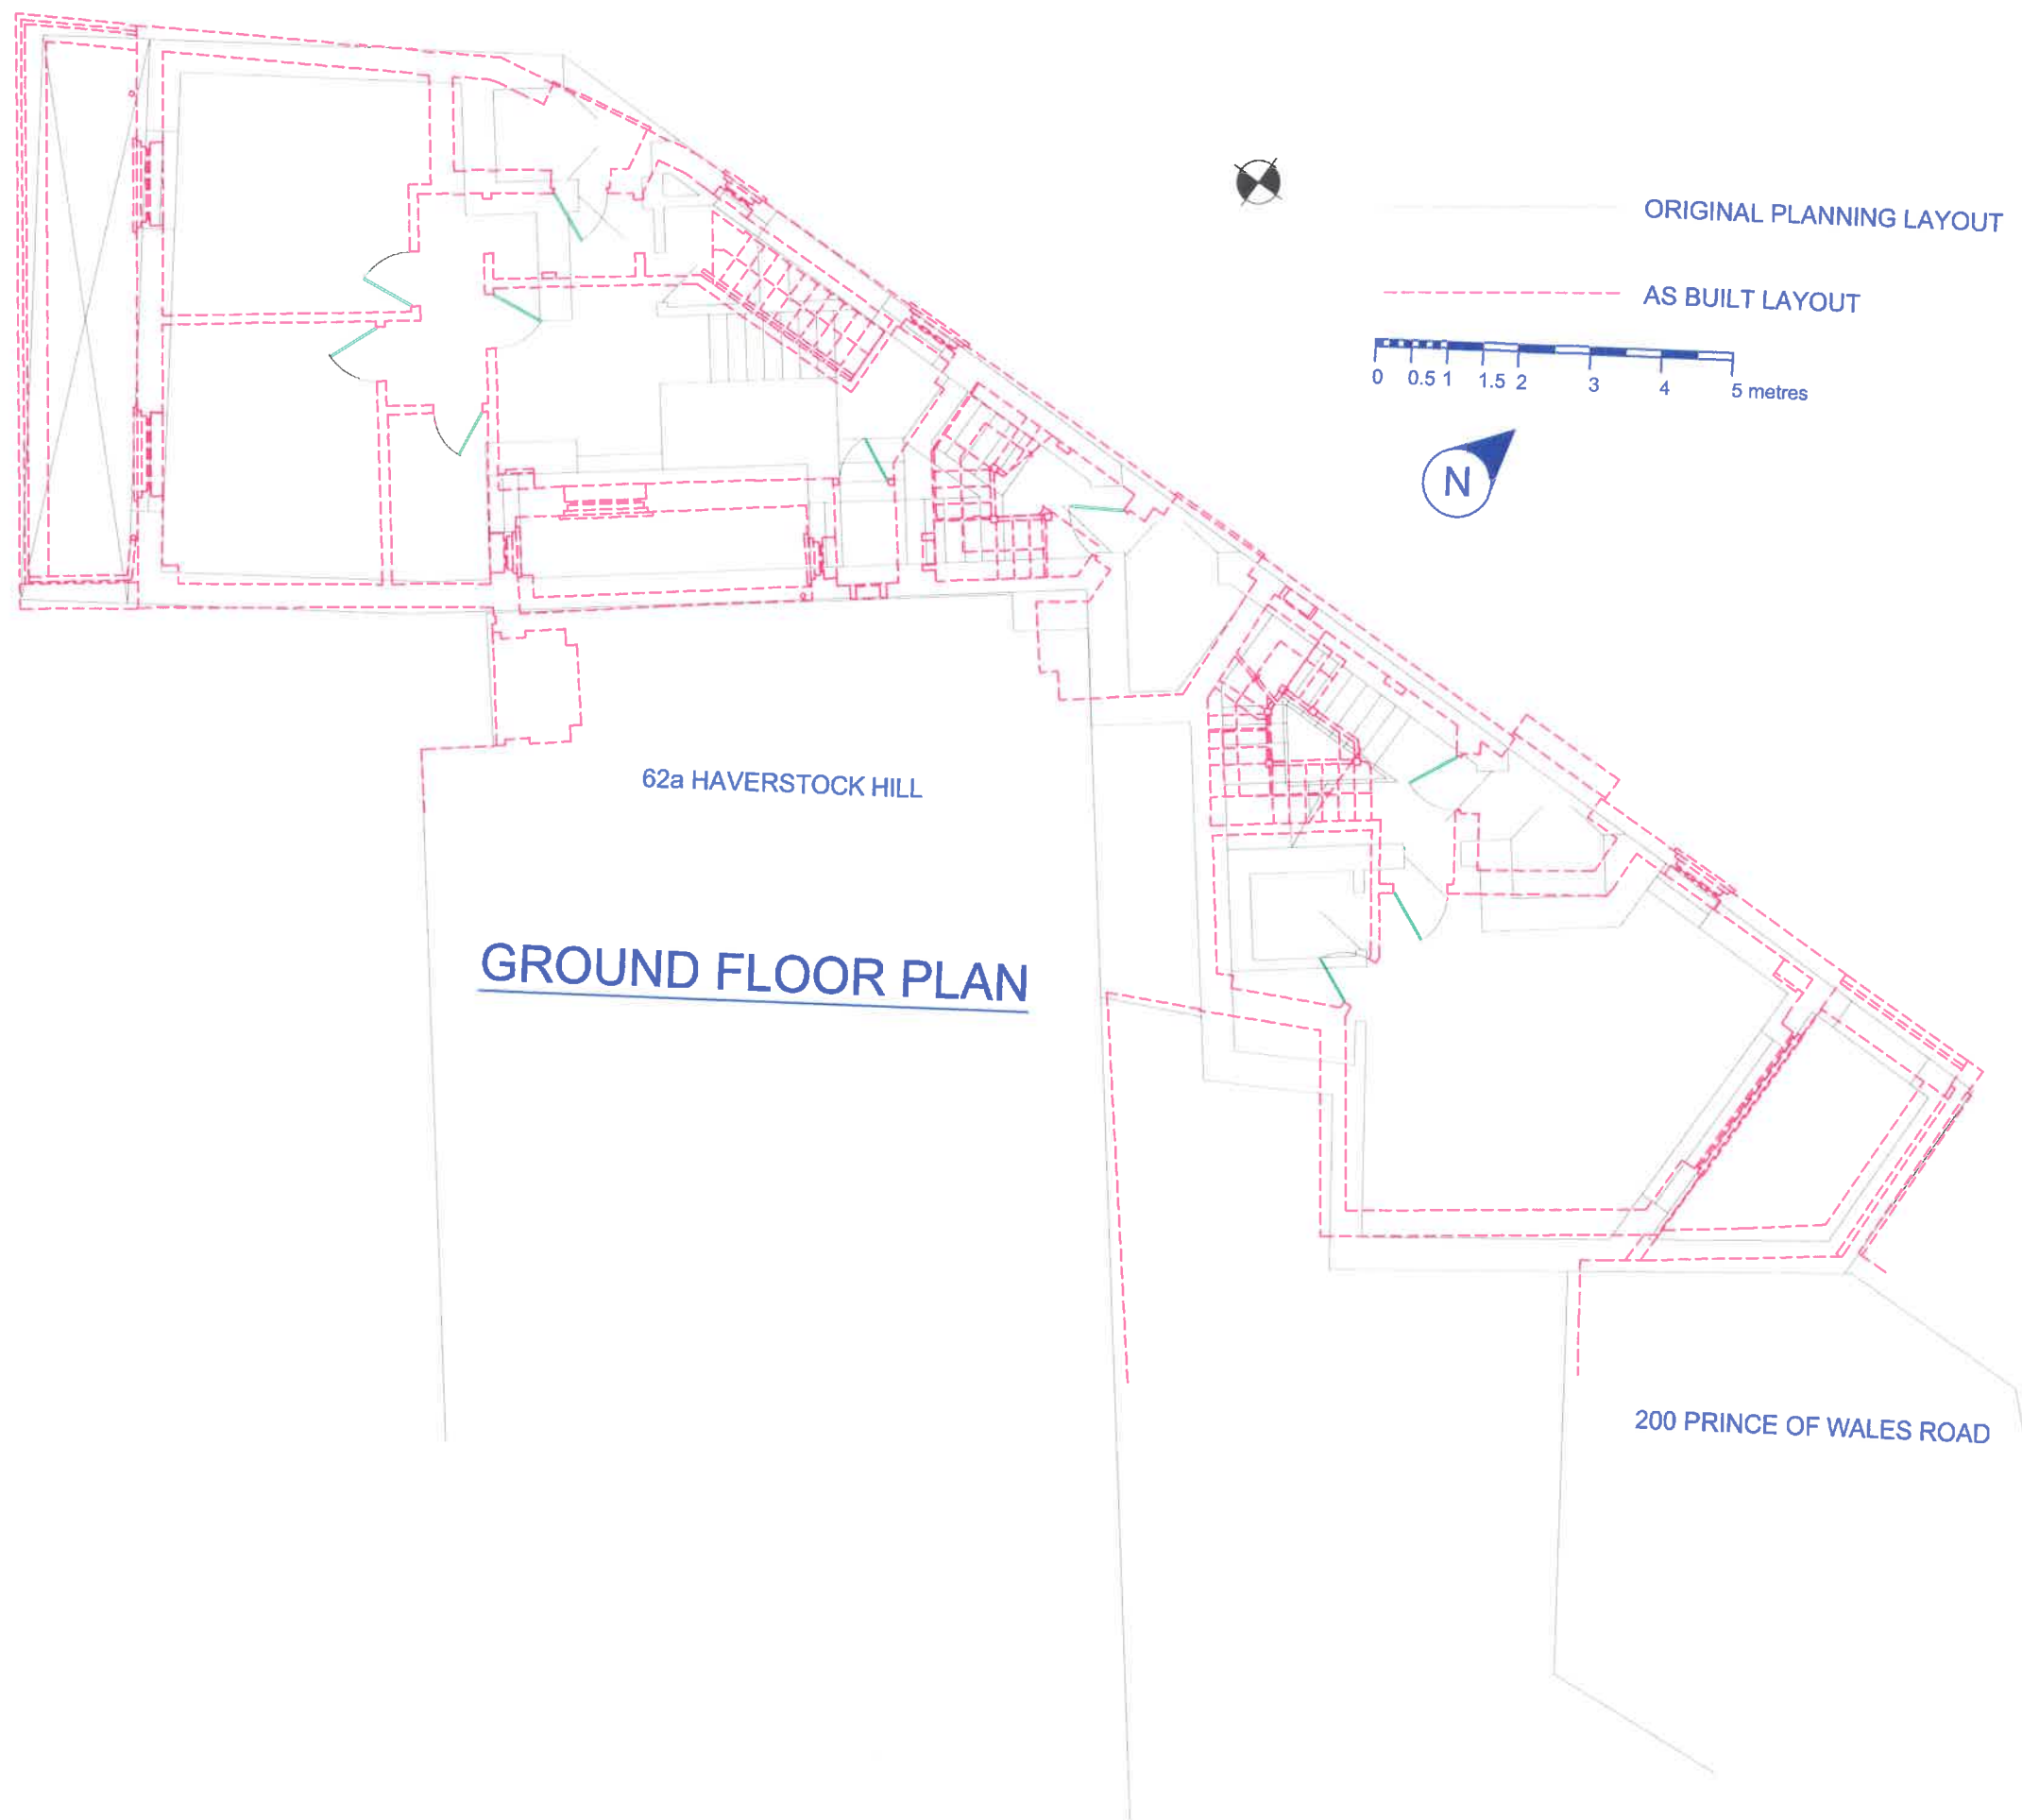


- NOTES
- 1) THE AS BUILT LAYOUT IS BASED ON A DIGITAL SURVEY.
AT THE TIME OF THE ORIGINAL PLANNING DRAWINGS THE SITE WAS DERELICT AND THE SITE WAS NOT SURVEYED DIGITALLY
 - 2) DRAWINGS TO BE READ IN CONJUNCTION WITH DRAWING NUMBERS 21064/A01 TO A04 AND NUMBERS 21064/B01 TO B05

Suffix	Revision	Date
KLF STRUCTURAL DESIGN LIMITED Consulting Engineers SBC House Wallington SM6 7AH 020 8619 0359 KLF_Structural_Design@yahoo.com		
Job 62A HAVERSTOCK HILL LONDON NW3		
Title ORIGINAL PLANNING/AS BUILT OVERLAY GROUND FLOOR PLAN		
Drawn TM	Date OCT 24	Checked Date Scale 1:100 @ A3
Sheet Size A3		Sheet No. 21064/C02
Revision		

NOTES
1) THE AS BUILT LAYOUT IS BASED ON A DIGITAL SURVEY.
AT THE TIME OF THE ORIGINAL PLANNING DRAWINGS THE SITE WAS DERELICT AND THE SITE WAS NOT SURVEYED DIGITALLY
2) DRAWINGS TO BE READ IN CONJUNCTION WITH DRAWING NUMBERS 21064/A01 TO A04 AND NUMBERS 21064/B01 TO B05

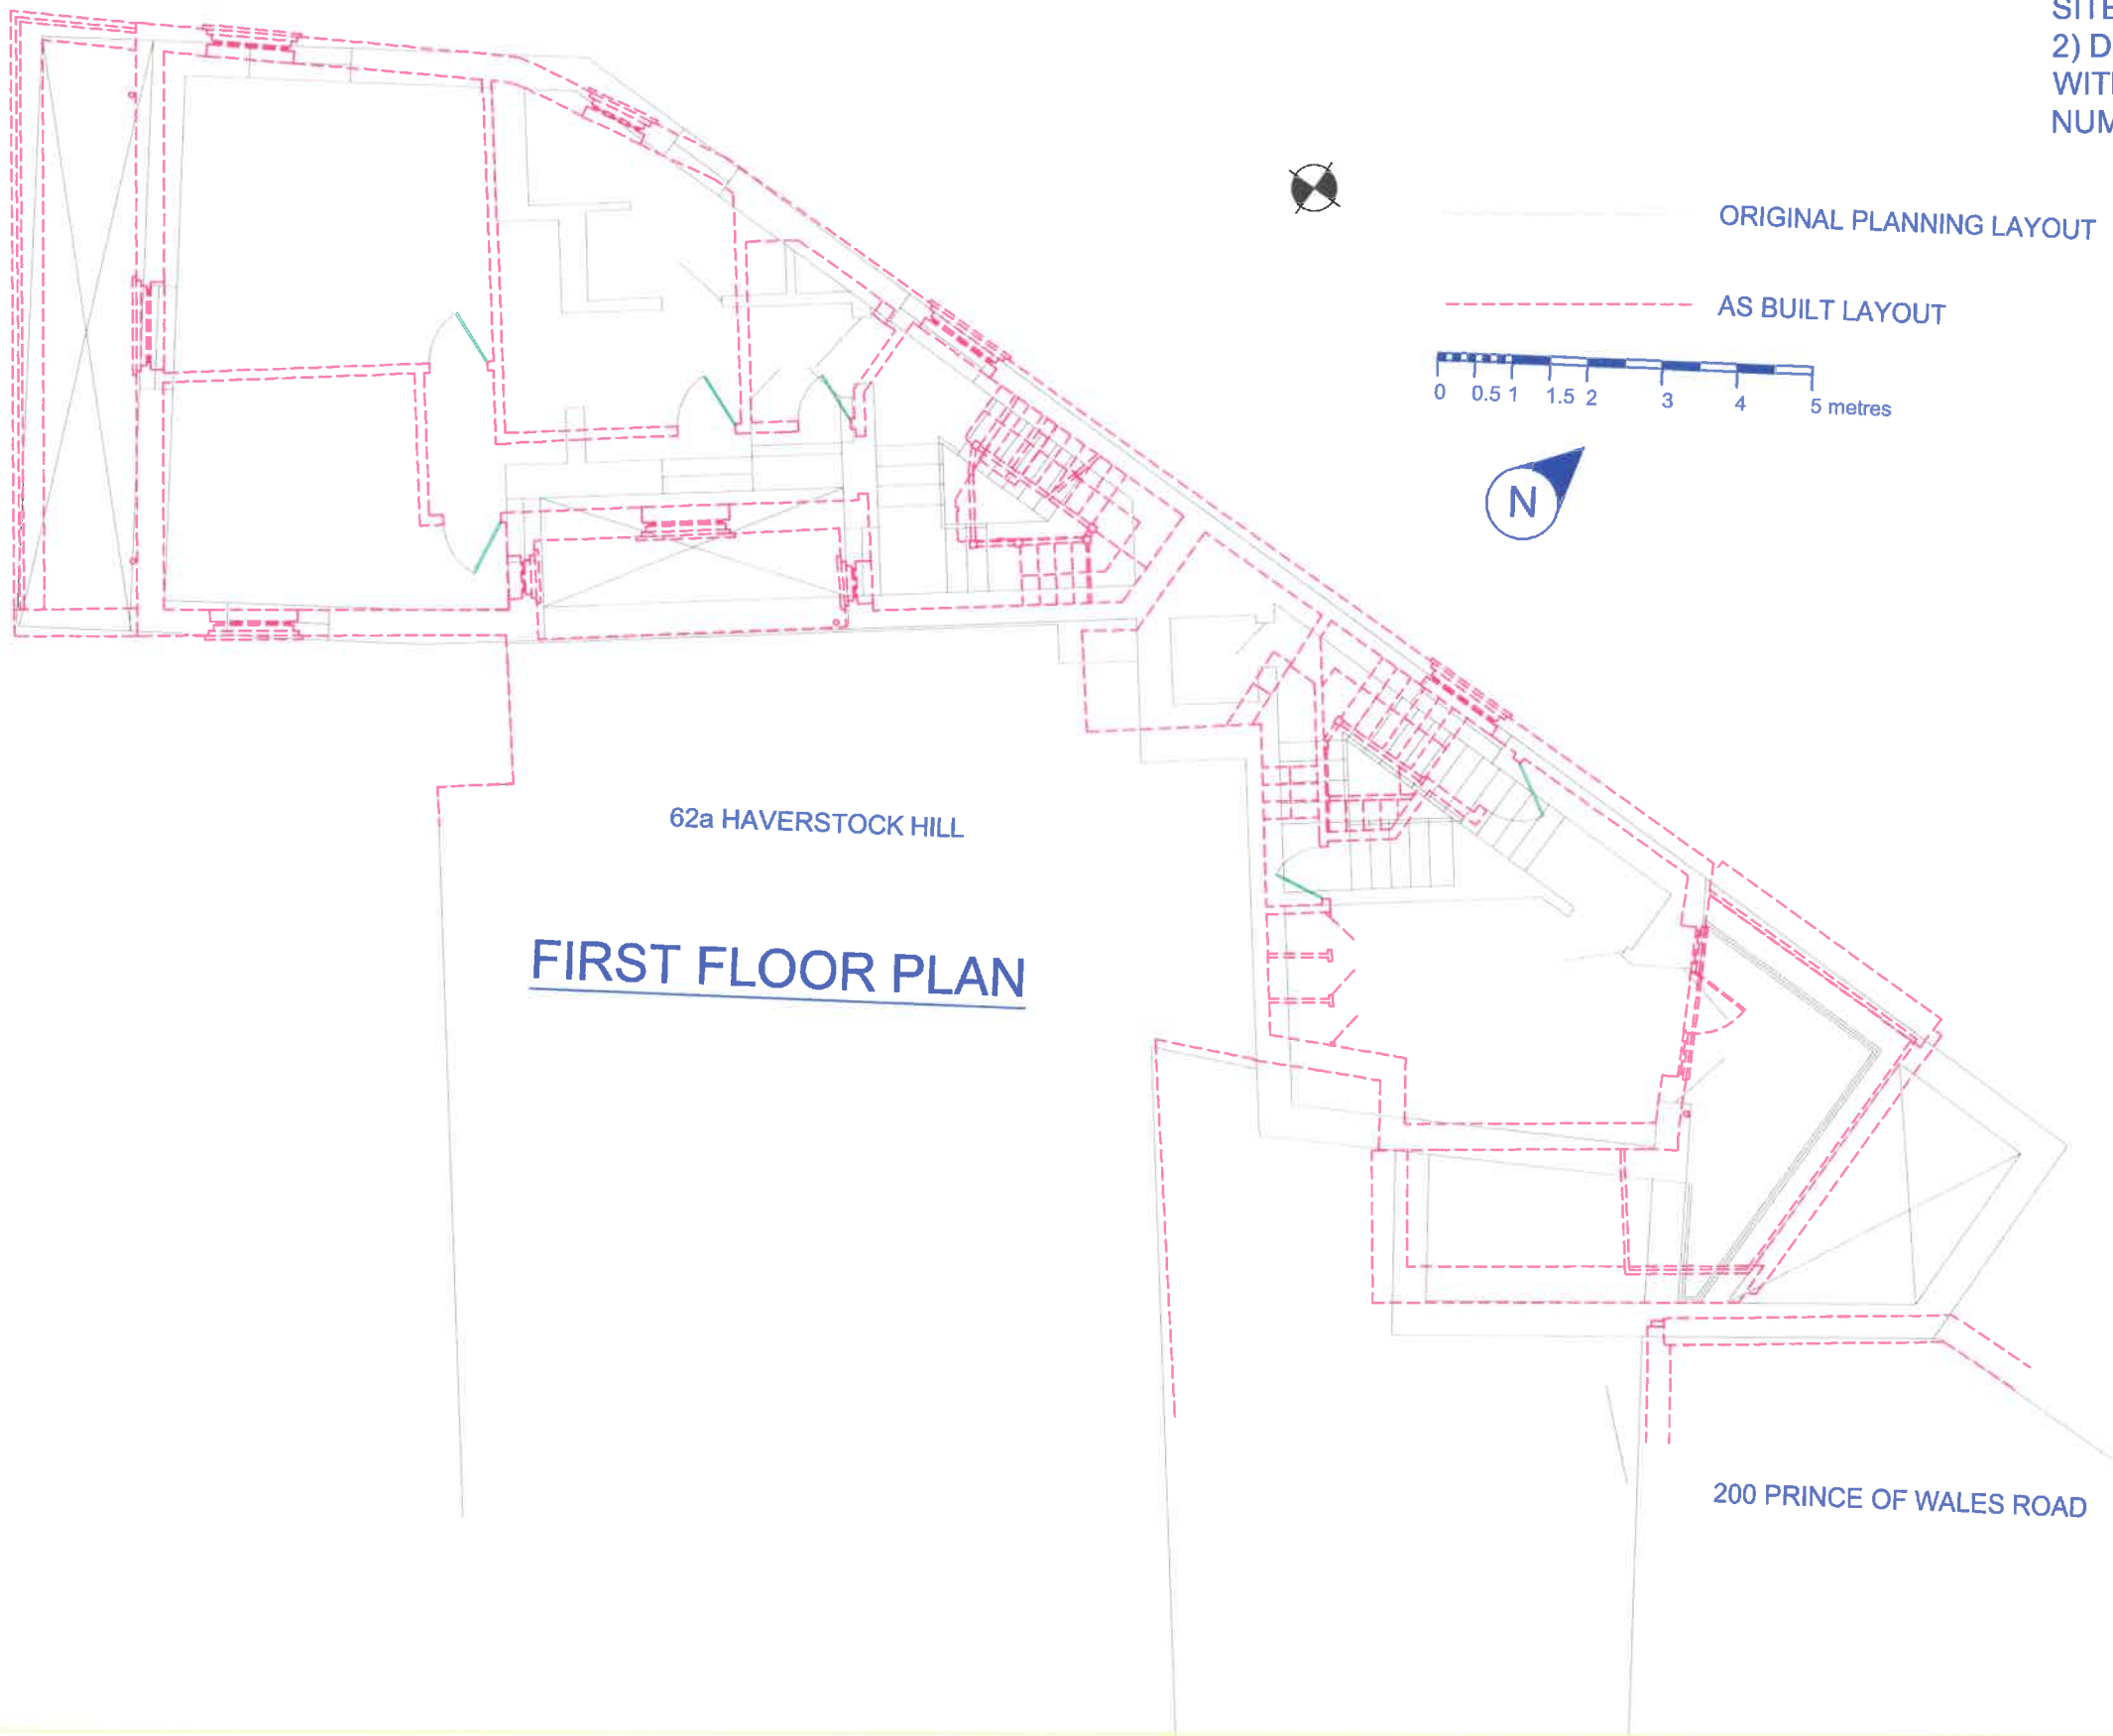

Suffix		Revision		Date				
KLF STRUCTURAL DESIGN LIMITED Consulting Engineers SBC House Wallington SM6 7AH 020 8819 0359 KLF_Structural_Design@yahoo.com						©		
Job 62A HAVERSTOCK HILL LONDON NW3								
Title ORIGINAL PLANNING/AS BUILT OVERLAY FIRST FLOOR PLAN								
Drawn TM		Date OCT 24		Checked		Date	Scale 1:100 @ A3	
Sheet Size A3				Sheet No. 21064/C03				
Revision								

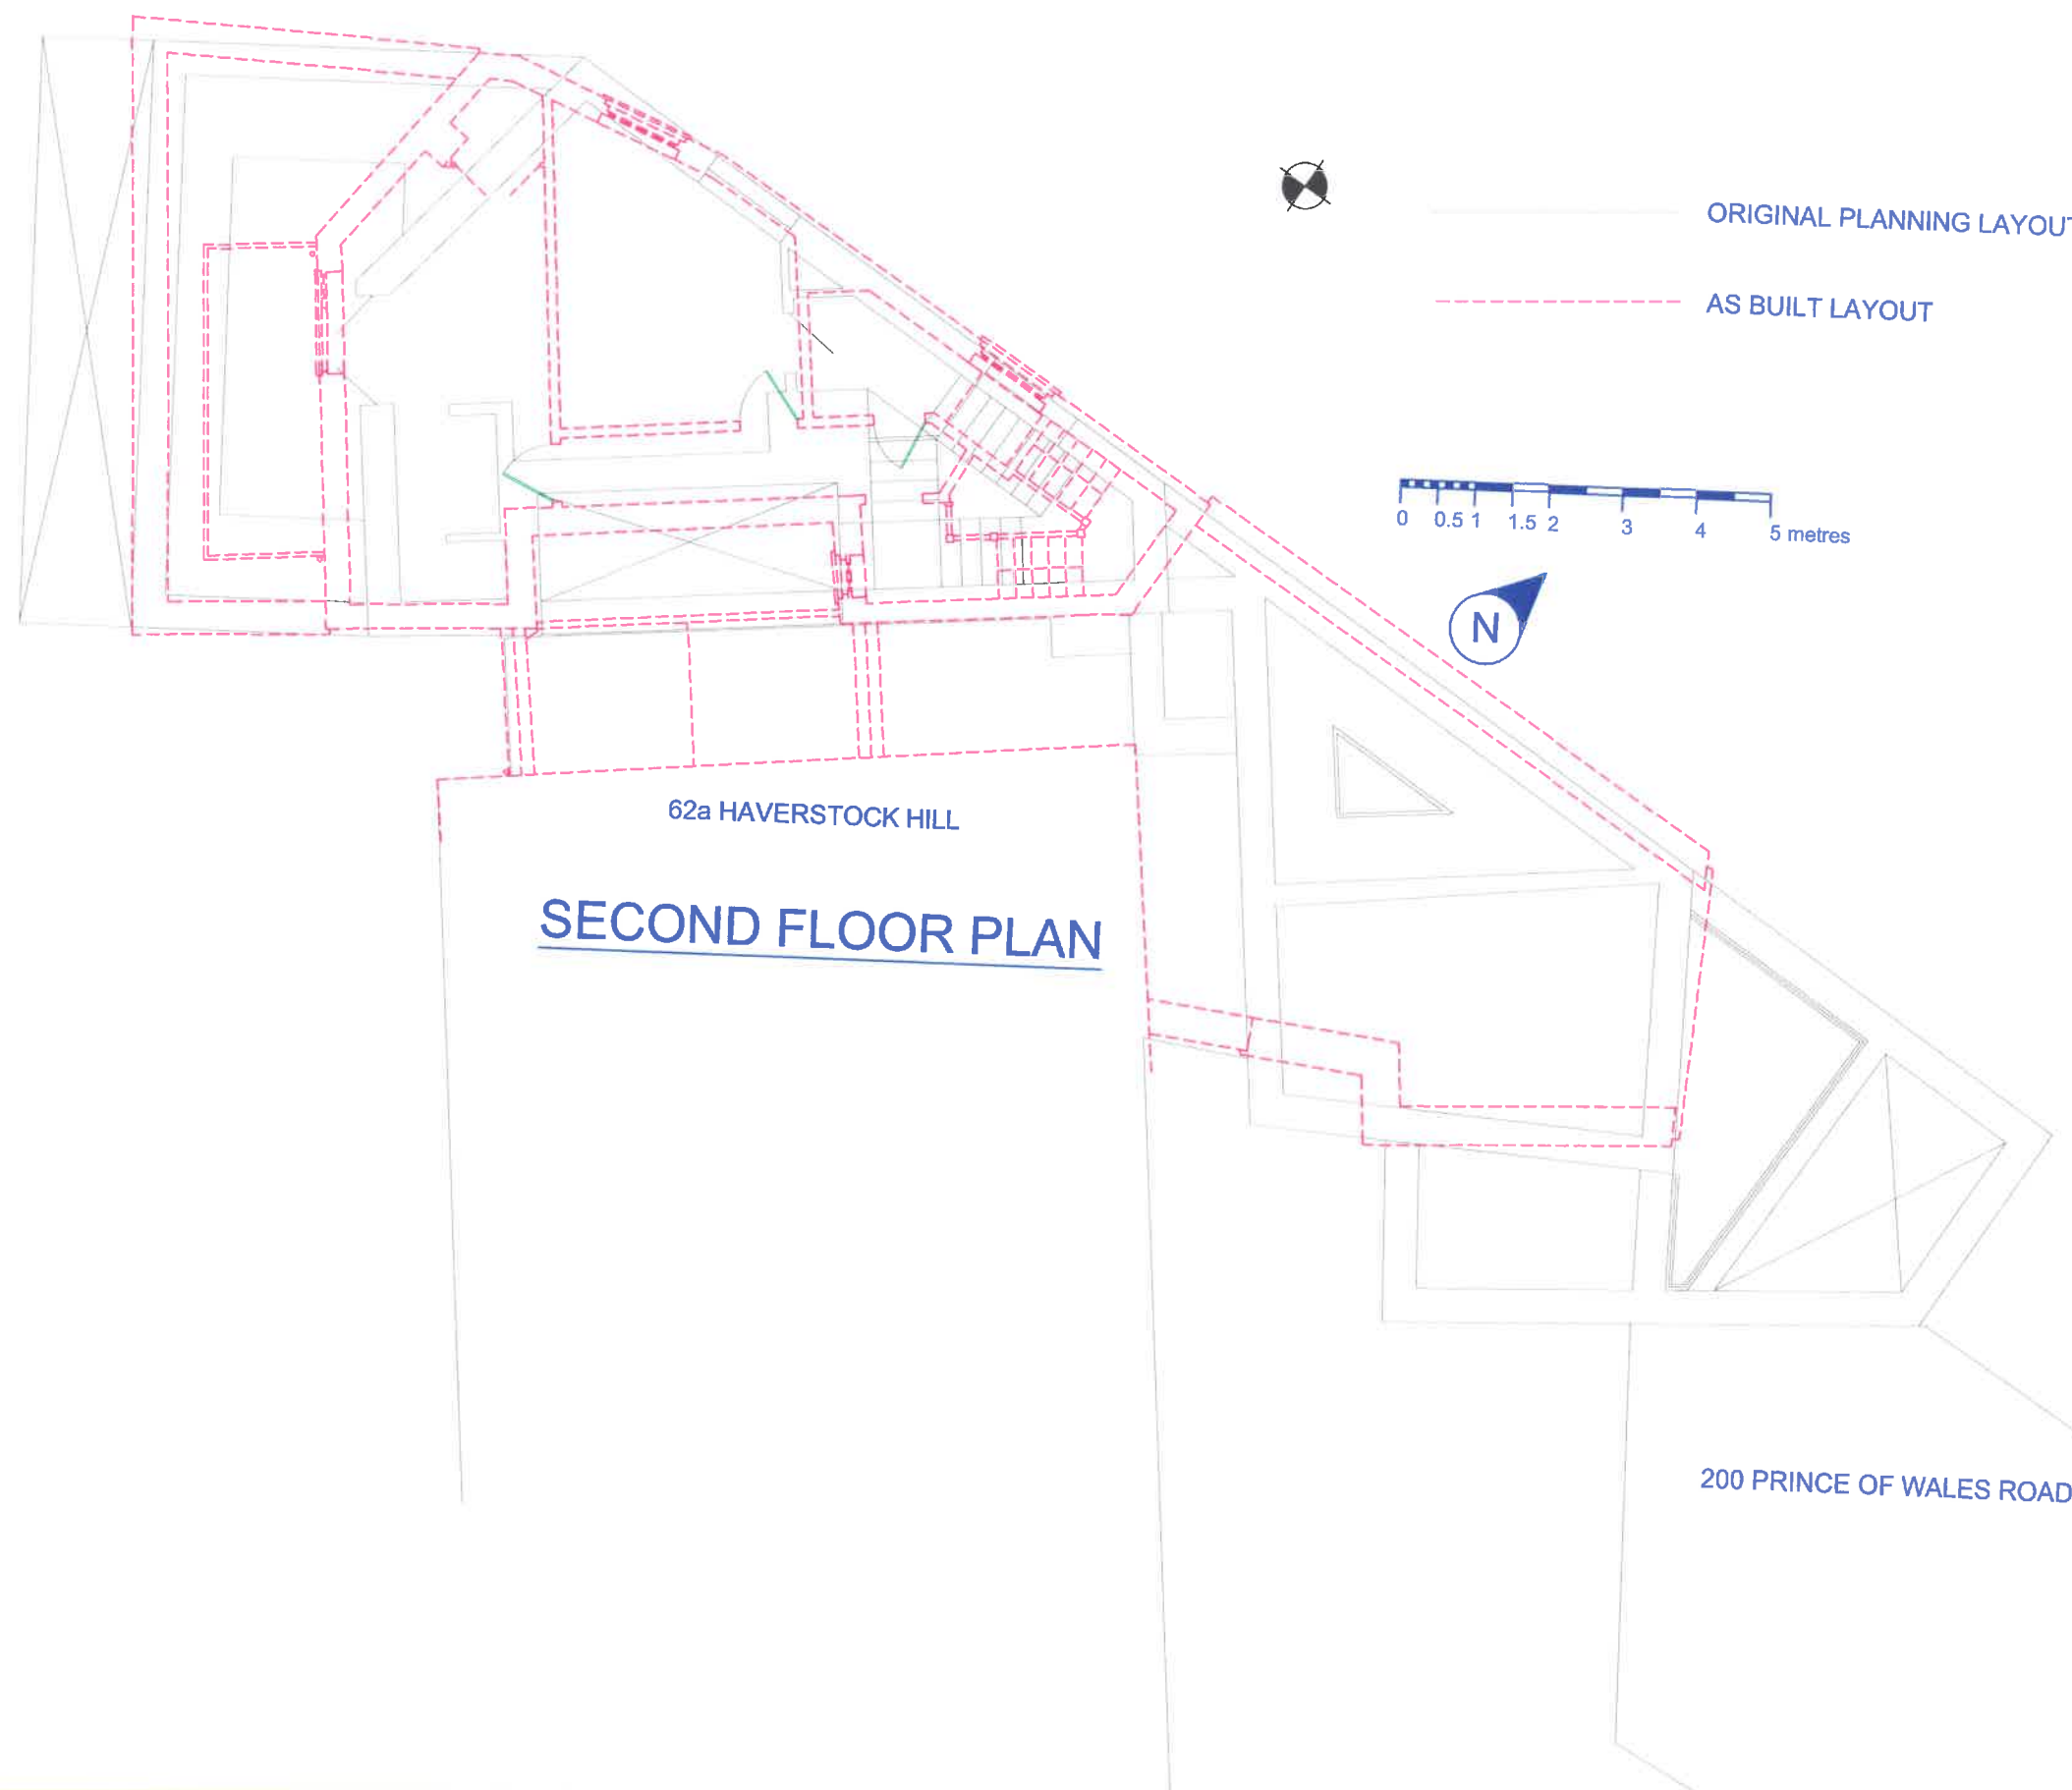

- NOTES
- 1) THE AS BUILT LAYOUT IS BASED ON A DIGITAL SURVEY.
AT THE TIME OF THE ORIGINAL PLANNING DRAWINGS THE SITE WAS DERELICT AND THE SITE WAS NOT SURVEYED DIGITALLY
 - 2) DRAWINGS TO BE READ IN CONJUNCTION WITH DRAWING NUMBERS 21064/A01 TO A04 AND NUMBERS 21064/B01 TO B05

Suffix	Revision	Date										
KLF STRUCTURAL DESIGN LIMITED Consulting Engineers SBC House Wallington SM6 7AH 020 8619 0359 KLF_Structural_Design@yahoo.com												©
Job 62A HAVERSTOCK HILL LONDON NW3												
Title ORIGINAL PLANNING/AS BUILT OVERLAY SECOND FLOOR PLAN												
Drawn TM		Date OCT 24		Checked		Date		Scale 1:100 @ A3				
Sheet Size A3					Sheet No. 21064/C04							
Revision												