

1.5mm ALUMINIUM LETTER 'a' RETURNS & LETTER FACES FINISHED:
 MATT BLACK - RAL 9005 (EXTERNALLY)
 MATT WHITE - RAL 9010 (INTERNALLY)

LETTER FACE TO BE SEAMLESS WHERE THE FACE MEETS THE RETURNS & THE RETURN TO THE CENTRE OF THE "a o" TO BE SEAMLESS WHERE IT'S JOINED ✓

5mm ALUMINIUM FIXING LUGS POSITIONED AS SHOWN
 TO BE FINISHED MATT WHITE - RAL 9010
 LUGS TAPPED TO TAKE M3 SCREWS


10mm OPAL 030 ACRYLIC BACKTRAYS FIXED TO THE BACKTRAY VIA M3 PAN HEAD FIXINGS WITH NUTS TO THE REAR
 NO FIXINGS TO THE RETURNS

TEXT FITTED WITH WHITE 4000k LED'S TO INSIDE FACE TO PROVIDE HALO ILLUMINATION ✓

21.5ømm PLASTIC POLYPIPE CUT TO LENGTHS TO RUN ELECTRICAL CABLE THROUGH PLASTIC POLYPIPE TUBE BONDED TO LETTER BACKS
 BACKING PANEL TO HAVE A ø12mm CABLE HOLE

LETTERS STOOD OFF THE BACKGROUND BY 38mm OPAL TUBE SPACERS
 BOND THESE TO THE REAR OF THE LETTERS.

20MM

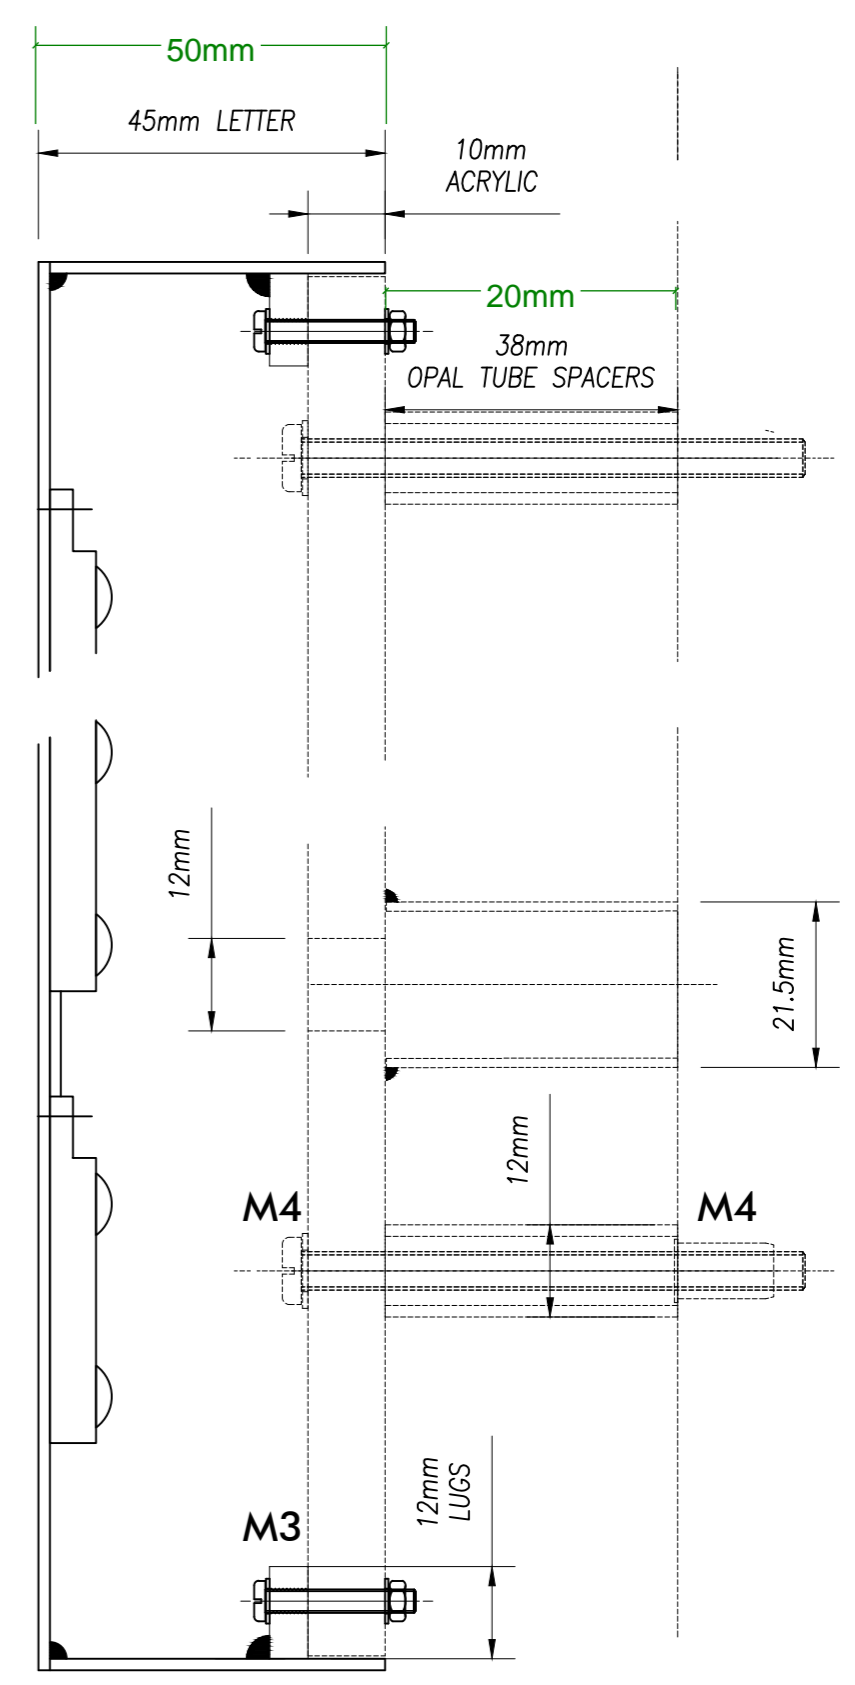

METALSHOP NOTE
 PLEASE ENSURE THE QUALITY OF THESE LETTERS ARE AS THE SAMPLE LETTER WE PRODUCED PRIOR TO THIS JOB.
 ESPECIALLY NO SEAMS AND SOFTEN EDGES. ✓

<input type="checkbox"/> APPROVED	<input type="checkbox"/> REJECTED
<input checked="" type="checkbox"/> APPROVED AS NOTED	<input type="checkbox"/> FOR INFORMATION ONLY
<input type="checkbox"/> REVISE AND RESUBMIT	
JK	10/23/2024
Reviewed by:	date:
<small>SUBMITTALS ARE REVIEWED FOR CONFORMANCE WITH THE DESIGN INTENT AND GENERAL COMPLIANCE WITH THE CONTRACT DOCUMENTS. THE CONTRACTOR IS RESPONSIBLE FOR CONFIRMING AND CORRECTING ALL QUANTITIES, DIMENSIONS, TOLERANCES, CLEARANCES, FABRICATION PROCESSES, TECHNIQUES AND SEQUENCES OF CONSTRUCTION, COMPATIBILITY OF MATERIALS AND METHODS, COORDINATION OF THEIR WORK WITH OTHER TRADES AND SUBCONTRACTORS, PERFORMANCE OF WORK IN A SAFE AND SATISFACTORY MANNER AND FOR FULL COMPLIANCE WITH THE CONTRACT DOCUMENTS.</small>	

- M1
- M2
- LASER
- STEEL
- VINYL
- DIGI
- DIGI SETUP
- PX
- ROUTER
- PAINT
- FIX
- ASSY

<p>5 Patricia Way, Pysons Road, Broadstairs, Kent. CT10 2XZ +44 (0) 1843 601075 +44 (0) 1843 867924 info@blazesigns.co.uk www.blazesigns.co.uk</p>	Job Title ALO YOGA 25 NEAL ROAD COVENT GARDEN	Drawing No. 149777	Scale 1:5	Date 15:OCT:2024	Drawn By P.MAYER
	Revisions THREE SETS OF REQUIRED				

THE COPYRIGHT OF THIS DRAWING IS OWNED BY BLAZE SIGNS LIMITED AND IS NOT TO BE DISCLOSED TO OTHER PERSONS OR TO BE USED FOR MANUFACTURING PURPOSES WITHOUT PERMISSION.