

ALL TREES IDENTIFIED WHERE POSSIBLE. ADVICE FROM AN ARBORICULTURIST SHOULD BE SOUGHT TO CONFIRM ANY SPECIES OR SIZE SHOWN.


DETAIL, DRAINAGE AND UTILITIES MAY NOT BE SHOWN IF CONCEALED FROM VIEW AT THE TIME OF THE SURVEY.

ANY ERRORS OR DISCREPANCIES FOUND ON THIS DRAWING SHOULD BE REPORTED TO SCOPE SURVEYS LTD IMMEDIATELY.

© SCOPE SURVEYS LTD HOLD THE COPYRIGHT TO ALL INFORMATION PROVIDED IN THIS DRAWING. WRITTEN CONSENT MUST BE OBTAINED PRIOR TO COPYING OR USING THE DATA FOR ANY PURPOSE OTHER THAN ORIGINALLY INTENDED.

DO NOT SCALE FROM THIS DRAWING.

ACU	AIR BRICK	MAH	MANHOLE COVER
ACU	AIR CONDITIONING UNIT	NA	NO ACCESS
B	BOLTER	RAD	RADIATOR
CA	CENTRE OF ARCH	RE	RODGING EYE
CD	CEILING HEIGHT	RL	ROOF LIGHT
CD	COVER LEVEL	RTW	RETAINING WALL
CSU	CRACKS, ROSES UP	SA	RAIN WATER PALL
CUPD	CUPBOARD	SA	SIDE OF ARCH
DA	DOOR HEIGHT	SH	SUSPENDED CEILING
DP	DOWN PIPE	SH	SILE TO HEAD
ECP	ELECTRIC CONTROL PANEL	SB	SPRING POINT
ELEC	ELECTRIC METER	SVP	SOIL VENT PIPE
FL	FLOOR LEVEL	TOP	TOP OF FENCE
FR	FLOOR	TOP	TOP OF WALL
G	GULLY	US	UNDERSIDE
GAS	GAS	USE	UNDERSIDE OF BEAM
HHT	HOT WATER TANK	UN	UNABLE TO SURVEY
IC	INSPECTION COVER	V	VENT
IL	INVERT LEVEL	VP	VENT PIPE

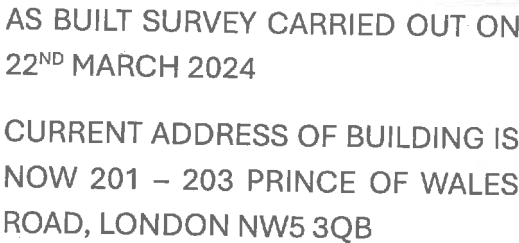

REVISION:			
PROJECT			
62A HAVERSTOCK HILL			
LONDON NW3 2BH			
CLIENT			
KLF STRUCTURAL DESIGN LTD			
DRAWING TITLE			
LOWER GROUND FLOOR			
SCALE		DATE	
1:50		MARCH 2024	
DRAWING NUMBER		REVISION	PAPER SIZE
2960_01		-	A1
LEVELS RELATED TO:			
ARBITRARY			
GRID RELATED TO:			
ARBITRARY			



**SCOPE**  
**SURVEYS**

**LAND & MEASURED BUILDING SURVEYORS**

T: 0206 771 8477  
E: [info@scope-surveys.co.uk](mailto:info@scope-surveys.co.uk)  
W: [www.scope-surveys.co.uk](http://www.scope-surveys.co.uk)

OFFICE 2  
20 BEARDILL STREET  
LONDON SE10 1TP



**THE SURVEY  
ASSOCIATION**



**worksafe  
contractor**



**SSIP**



**ISO 9001  
CERTIFIED**

GENERAL NOTES

ALL TREES IDENTIFIED WHERE POSSIBLE. ADVICE FROM AN ARBOROLOGIST SHOULD BE SOUGHT TO CONFIRM ANY SPECIES OR SIZE SHOWN.

DETAIL, DRAINAGE AND UTILITIES MAY NOT BE SHOWN IF CONCEALED FROM VIEW AT THE TIME OF THE SURVEY.


ANY ERRORS OR DISCREPANCIES FOUND ON THIS DRAWING SHOULD BE REPORTED TO SCOPE SURVEYS LTD IMMEDIATELY.

© SCOPE SURVEYS LTD HOLD THE COPYRIGHT TO ALL INFORMATION PROVIDED IN THIS DRAWING. WRITTEN CONSENT MUST BE OBTAINED PRIOR TO COPYING OR USING THE DATA FOR ANY PURPOSE OTHER THAN ORIGINALLY INTENDED.

DO NOT SCALE FROM THIS DRAWING.

BUILDING ABBREVIATIONS

AB	AIR BRICK	MH	MANHOLE COVER
ACU	AIR CONDITIONING UNIT	NA	NO ACCESS
B	BOILER	RAD	RADIATOR
CA	CENTRE OF ARCH	RE	RODDING EYE
CH	CEILING HEIGHT	RL	ROOF LIGHT
CL	COVER LEVEL	RTW	RETAINING WALL
CSU	CEILING SLOPES UP	RWP	RAIN WATER PIPE
CUPD	CUPBOARD	SA	SIDE OF ARCH
DH	DOOR HEIGHT	SGH	SUSPENDED CEILING
DP	DRAINAGE PIPE	SH	BILL TO HEAD
ECP	ELECTRIC CONTROL PANEL	SP	SPRING POINT
ELEC	ELECTRIC METER	SVP	SOIL VENT PIPE
FL	FLOOR LEVEL	TOF	TOP OF FENCE
FS	FLOOR TO BILL	TOW	TOP OF WALL
G	GULLY	U/S	UNDERSIDE
GAS	GAS METER	USB	UNDERSIDE OF BEAM
HWT	HOT WATER TANK	UTS	UNABLE TO SURVEY
IC	INSPECTION COVER	V	VENT
IL	INVERT LEVEL	VP	VENT PIPE

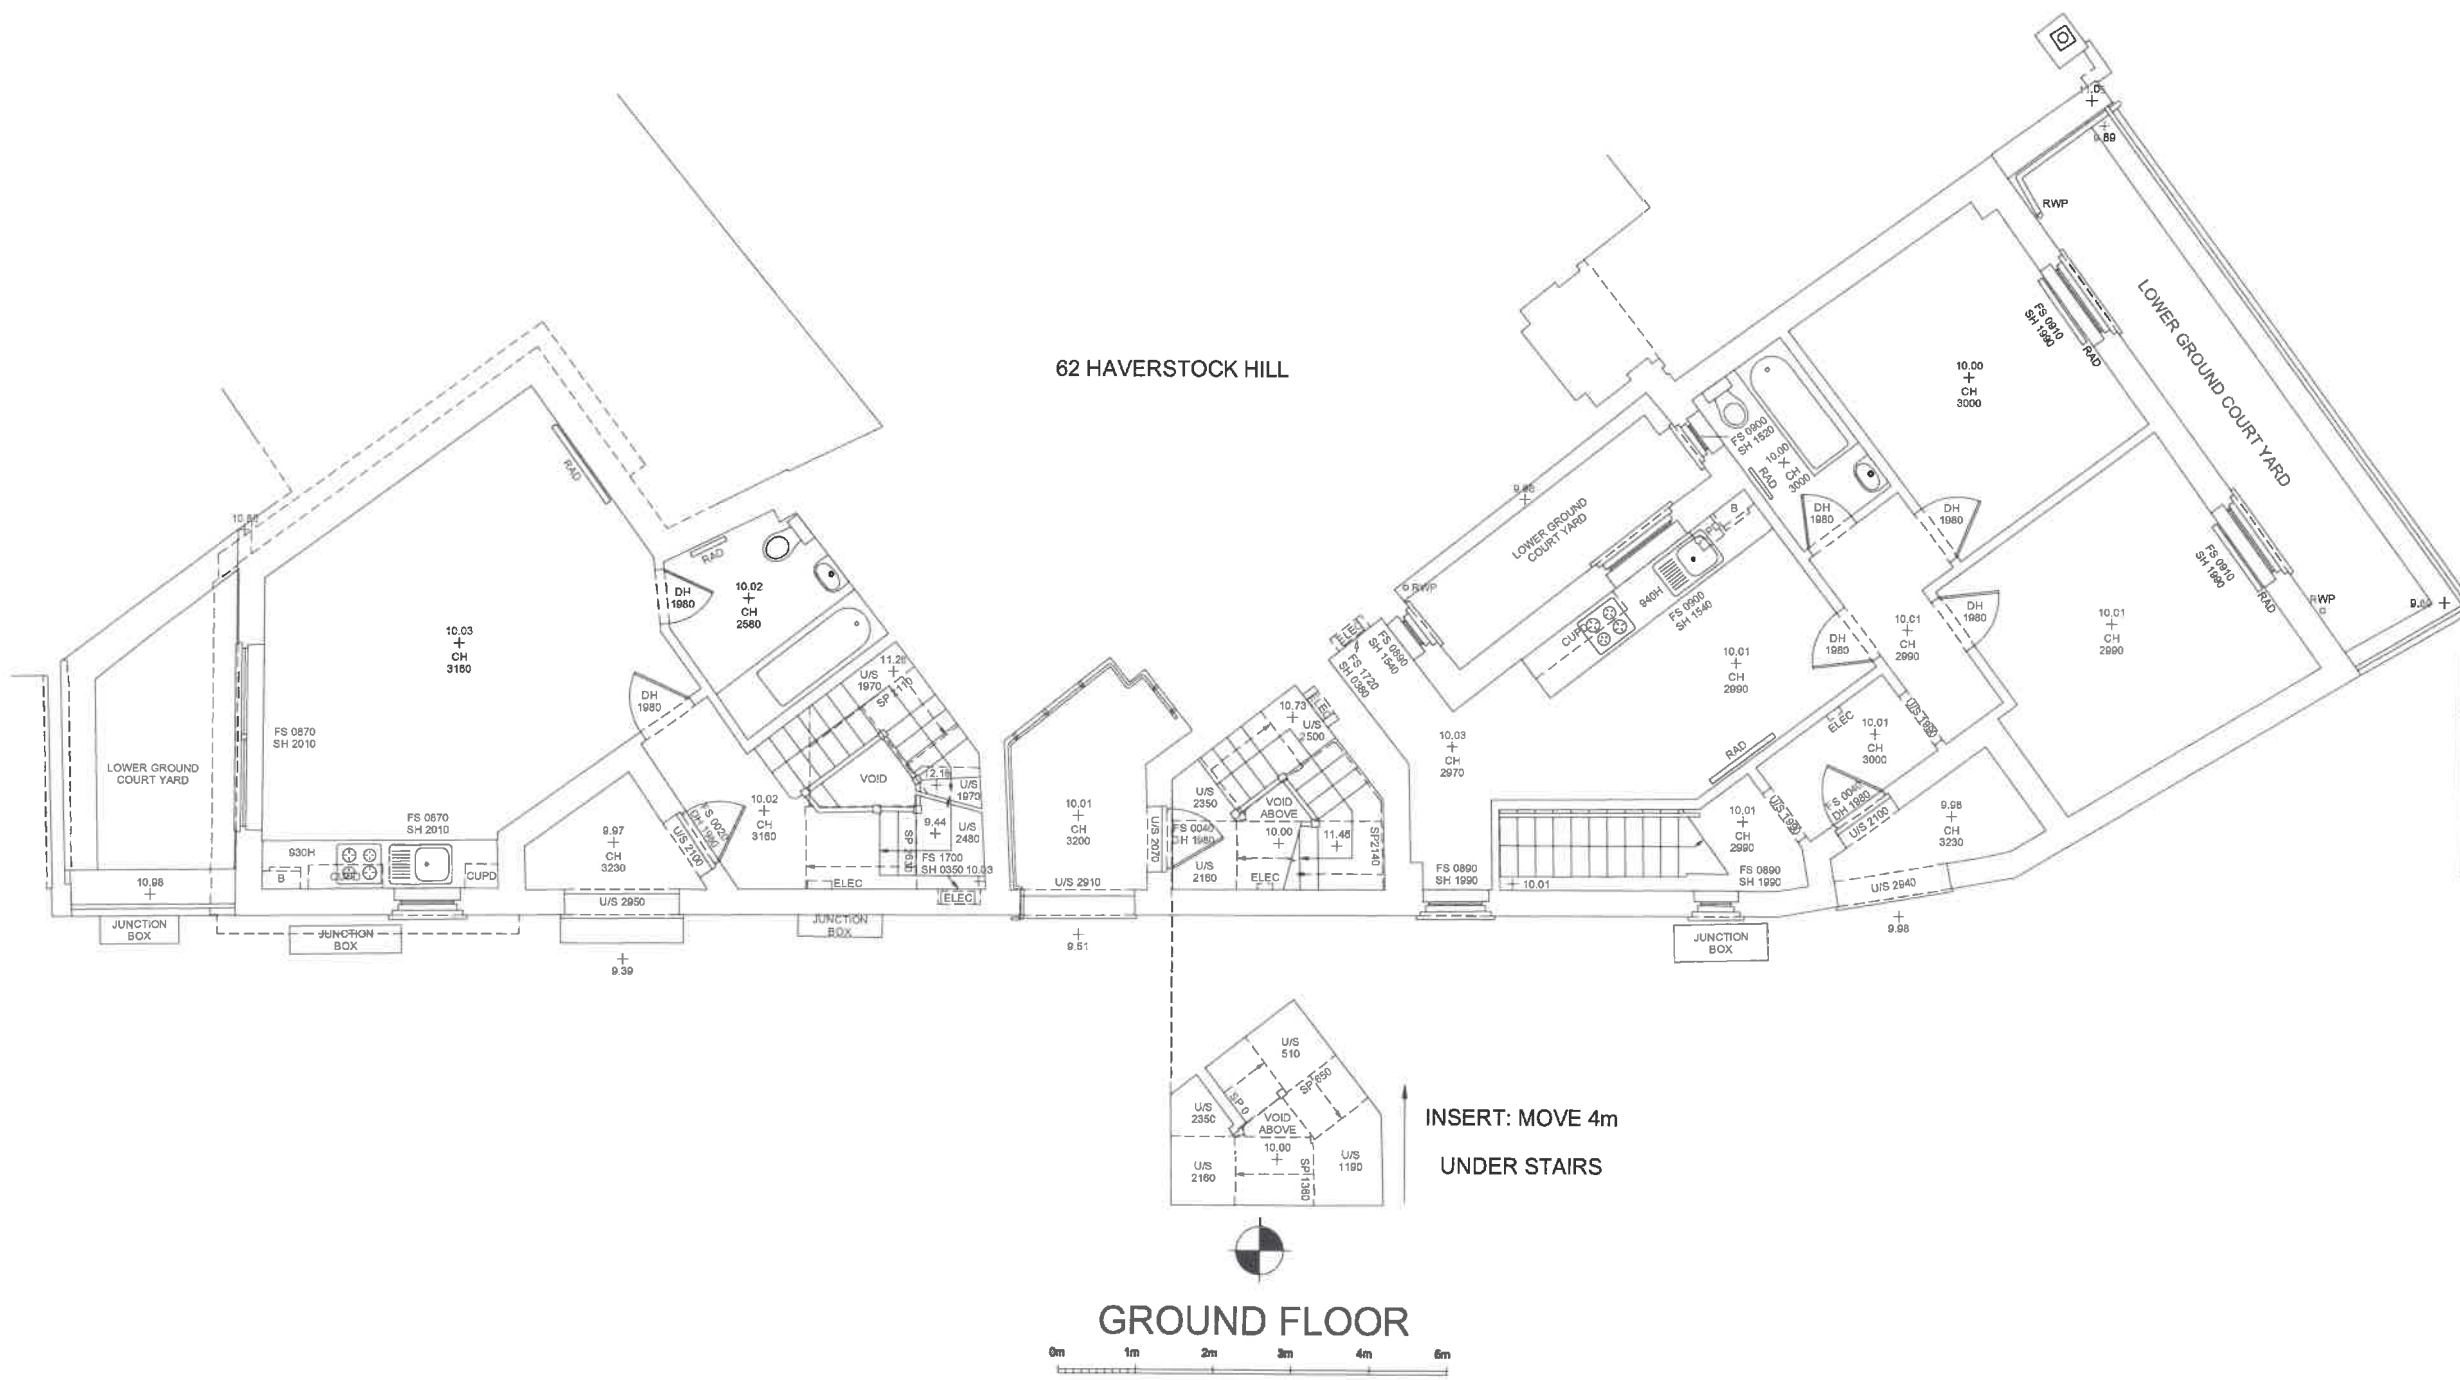


AS BUILT SURVEY CARRIED OUT ON  
22<sup>ND</sup> MARCH 2024

CURRENT ADDRESS OF BUILDING IS  
NOW 201 – 203 PRINCE OF WALES  
ROAD, LONDON NW5 3QB

REVISION:		
PROJECT 62A HAVERSTOCK HILL LONDON NW3 2BH		
CLIENT KLF STRUCTURAL DESIGN LTD		
DRAWING TITLE GROUND FLOOR		
SCALE 1:50	DATE MARCH 2024	
DRAWING NUMBER 2960_02	REVISION -	PAPER SIZE A1
LEVELS RELATED TO: ARBITRARY		
GRID RELATED TO: ARBITRARY		

**SCOPE**  
SURVEYS  
LAND & MEASURED BUILDING SURVEYORS  
T: 0208 771 3477  
E: INFO@SCOPEURVEYS.CO.UK  
W: WWW.SCOPEURVEYS.CO.UK

OFFICE 2  
20 BEARDELL STREET  
LONDON SE16 1TP

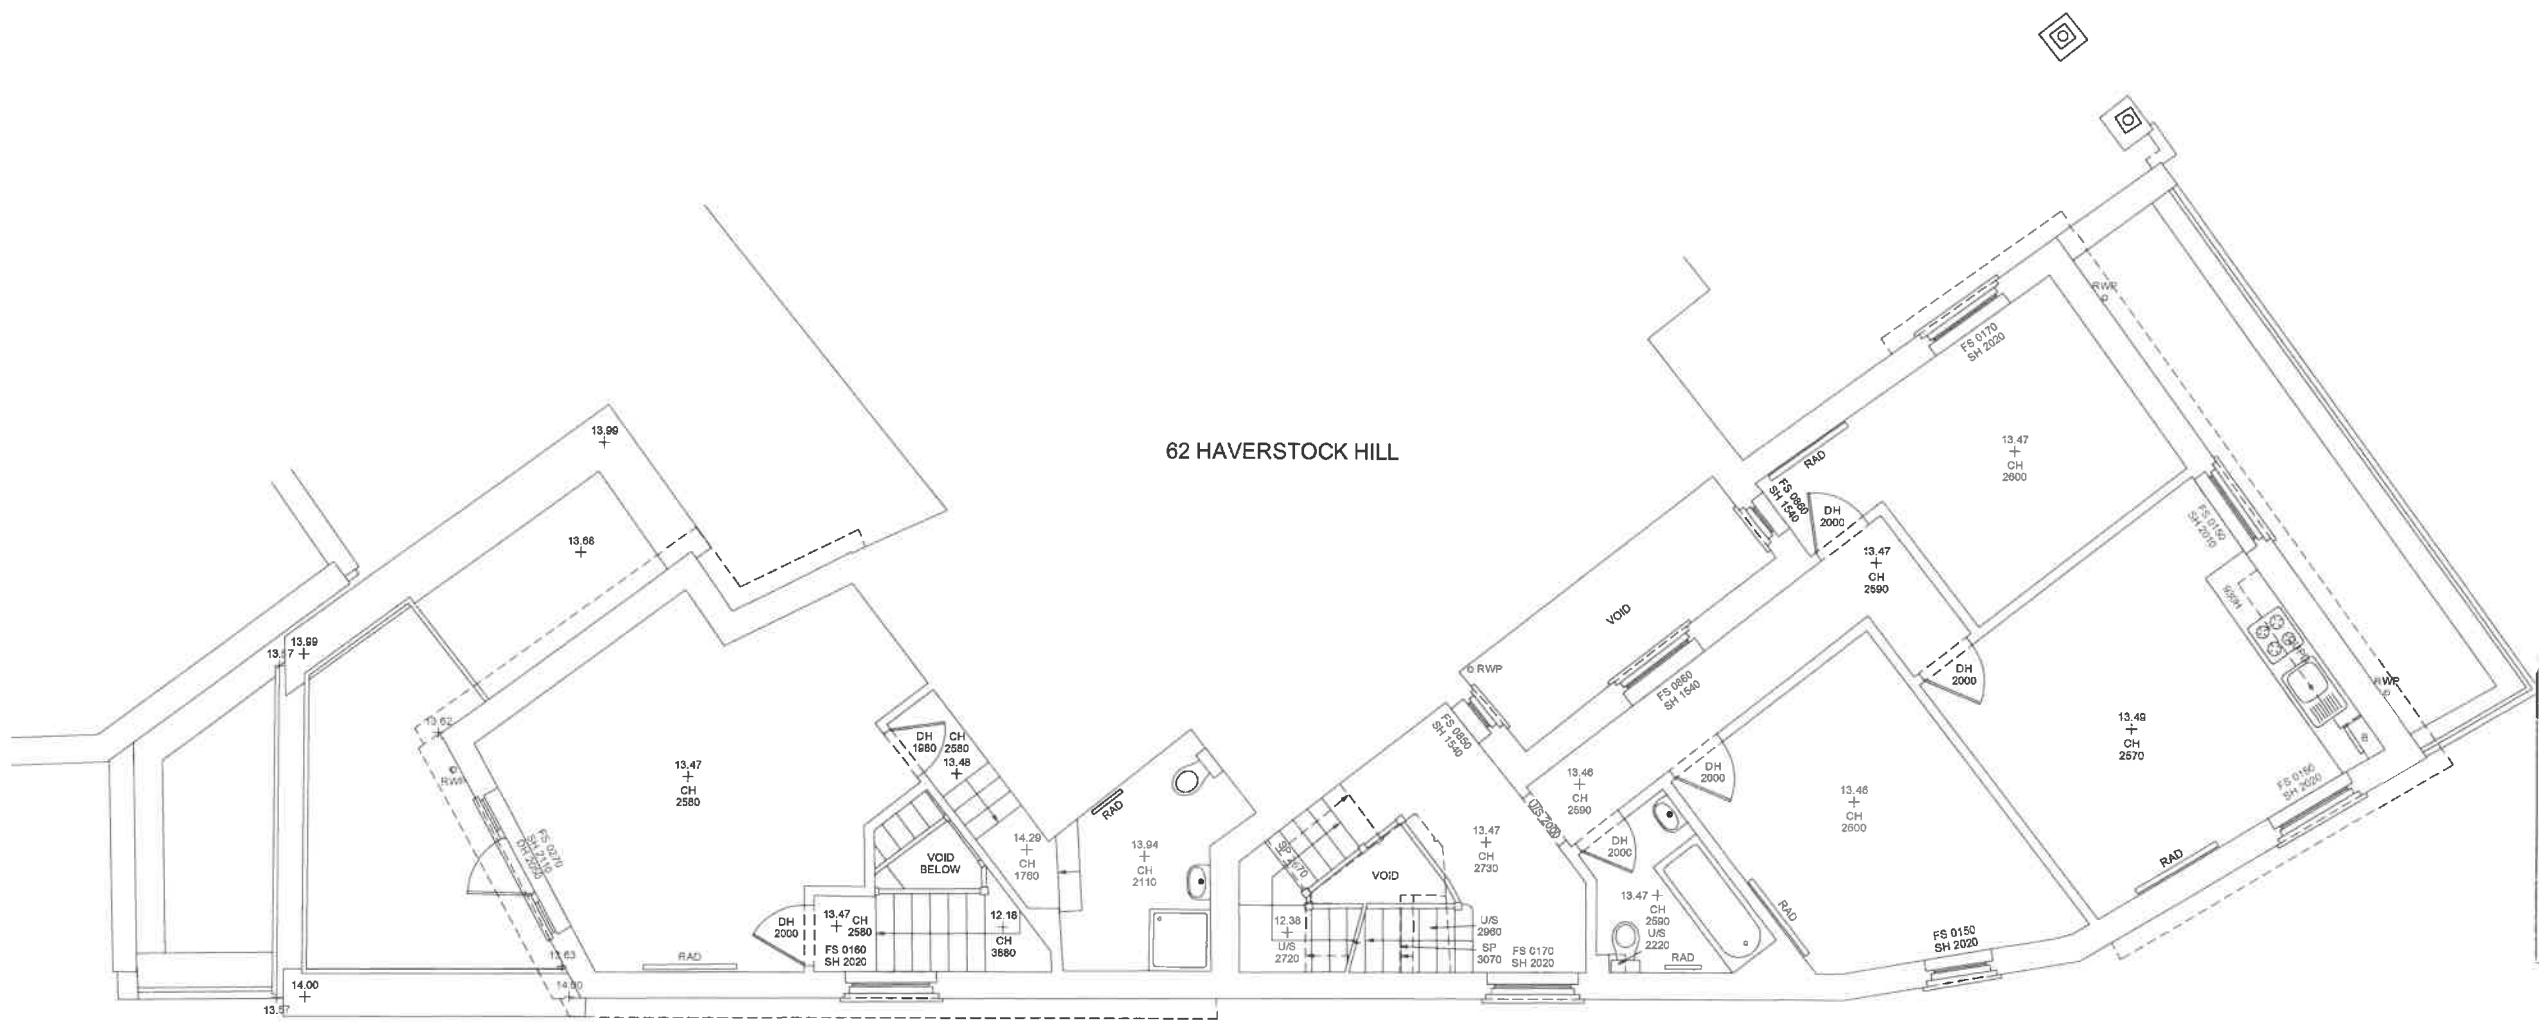

62 HAVERSTOCK HILL



FIRST FLOOR

#### GENERAL NOTES

ALL TREES IDENTIFIED WHERE POSSIBLE, ADVICE FROM AN ARBOROLOGIST SHOULD BE SOUGHT TO CONFIRM ANY SPECIES OR SIZE SHOWN.

DETAIL, DRAINAGE AND UTILITIES MAY NOT BE SHOWN IF CONCEALED FROM VIEW AT THE TIME OF THE SURVEY.

ANY ERRORS OR DISCREPANCIES FOUND ON THIS DRAWING SHOULD BE REPORTED TO SCOPE SURVEYS LTD IMMEDIATELY.

© SCOPE SURVEYS LTD HOLD THE COPYRIGHT TO ALL INFORMATION PROVIDED IN THIS DRAWING. WRITTEN CONSENT MUST BE OBTAINED PRIOR TO COPYING OR USING THE DATA FOR ANY PURPOSE OTHER THAN ORIGINALLY INTENDED.

DO NOT SCALE FROM THIS DRAWING.

#### BUILDING ABBREVIATIONS

AB	AIR BRICK	MH	MANHOLE COVER
ACU	AIR CONDITIONING UNIT	NA	NO ACCESS
B	BOILER	RAD	RADIATOR
CA	CENTRE OF ARCH	RE	ROOMING EYE
CH	CEILING HEIGHT	RL	ROOF LIGHT
CL	COVER LEVEL	RTW	RETAINING WALL
CSU	CEILING SLOPES UP	RWP	RAIN WATER PIPE
CUPD	CUPBOARD	SA	SIDE OF ARCH
DH	DOOR HEIGHT	SCH	SUSPENDED CEILING
DP	DRAINAGE PIPE	SH	SILL TO HEAD
ECP	ELECTRIC CONTROL PANEL	SP	SPRING POINT
ELEC	ELECTRIC METER	SWP	SOIL VENT PIPE
FL	FLOOR LEVEL	TGF	TOP OF FENCE
FS	FLOOR TO SILL	TOW	TOP OF WALL
G	GULLY	US	UNDERSIDE
GAS	GAS METER	USB	UNDERSIDE OF BEAM
HWT	HOT WATER TANK	UTS	UNABLE TO SURVEY
IC	INSPECTION COVER	V	VENT
IL	INVERT LEVEL	VP	VENT PIPE

AS BUILT SURVEY CARRIED OUT ON  
22<sup>ND</sup> MARCH 2024

CURRENT ADDRESS OF BUILDING IS  
NOW 201 – 203 PRINCE OF WALES  
ROAD, LONDON NW5 3QB

REVISION:		
PROJECT 62A HAVERSTOCK HILL LONDON NW3 2BH		
CLIENT: KLF STRUCTURAL DESIGN LTD		
DRAWING TITLE FIRST FLOOR		
SCALE 1:50	DATE MARCH 2024	
DRAWING NUMBER 2960_03	REVISION -	PAPER SIZE A1
LEVELS RELATED TO: ARBITRARY		
GRID RELATED TO: ARBITRARY		

**SCOPE**  
SURVEYS

LAND & MEASURED BUILDING SURVEYORS

T: 0208 771 3477  
E: INFO@SCOPEURVEYS.CO.UK  
W: WWW.SCOPEURVEYS.CO.UK

OFFICE 2  
20 BEARDELL STREET  
LONDON SE16 1TP





ALL TREES IDENTIFIED WHERE POSSIBLE, ADVICE FROM AN ARBOROLOGIST SHOULD BE SOUGHT TO CONFIRM ANY SPECIES OR SIZE SHOWN.

DETAIL, DRAINAGE AND UTILITIES MAY NOT BE SHOWN IF CONCEALED FROM VIEW AT THE TIME OF THE SURVEY.

ANY ERRORS OR DISCREPANCIES FOUND ON THIS DRAWING SHOULD BE REPORTED TO SCOPE SURVEYS LTD IMMEDIATELY.

© SCOPE SURVEYS LTD HOLD THE COPYRIGHT TO ALL INFORMATION PROVIDED IN THIS DRAWING. WRITTEN CONSENT MUST BE OBTAINED PRIOR TO COPYING OR USING THE DATA FOR ANY PURPOSE OTHER THAN ORIGINALLY INTENDED.

DO NOT SCALE FROM THIS DRAWING.

ACU	AIR BRICK	MH	MANHOLE COVER
ACU	AIR CONDITIONING UNIT	NA	NO ACCESS
BO	BOILER	RA	RADIATOR
CA	CENTRE OF ARCH	RE	RE-RODING EYE
CH	CEILING HEIGHT	RL	ROOF LIGHT
CH	COVER LEVEL	RET	RETAINING WALL
CHU	CHIMNEY SLOPES	RW	RAIN WATER PIPE
CUPD	CUPBOARD	SA	SIDE OF ARCH
DC	DOOR HEIGHT	SP	SPRINGING CEILING
DP	DOWN PIPE	SH	SILL TO HEAD
DP	ELECTRIC CONTROL PANEL	SH	SH UP
ELEC	ELECTRIC MOTOR	SVP	SOIL VENT PIPE
FL	FLOOR LEVEL	TOP	TOP OF FENCE
FL	FLOOR FSL	TOP	TOP OF WALL
FL	GAS FSL	US	UNDERSIDE
G	GULLY	USB	UNDERSIDE OF BEAM
GAS	GAS TO BELL	UTS	UNABLE TO SURVEY
HW	HOT WATER TANK	V	VENT
IC	INSPECTION COVER	VP	VENT PIPE
IN	INLET LEVEL		

62 | HAVERSTOCK HILL

CURRENT ADDRESS OF BUILDING IS  
NOW 201 – 203 PRINCE OF WALES  
ROAD, LONDON NW5 3QB

REVISION:

PROJECT  
62A HAVERSTOCK HILL  
LONDON NW3 2BH

CLIENT  
KLF STRUCTURAL DESIGN LTD

DRAWING TITLE

**SECOND FLOOR & ROOF PLAN**

SCALE 1:50 DATE MARCH 2024

DRAWING NUMBER	REVISION	PAPER SIZE
2960_04	-	A1

LEVELS RELATED TO:  
ARBITRARY

GRID RELATED TO:  
ARBITRARY



**LAND & MEASURED BUILDING SURVEYORS**

T: 0208 771 3477  
E: [INFO@SCOPESURVEYS.CO.UK](mailto:INFO@SCOPESURVEYS.CO.UK)  
W: [WWW.SCOPESURVEYS.CO.UK](http://WWW.SCOPESURVEYS.CO.UK)

OFFICE 2  
20 BEARDELL STREET  
LONDON SE18 1TP



## SECOND FLOOR & ROOF PLAN





ELEVATION 1

ELEVATION 2

**GENERAL NOTES**

ALL TREES IDENTIFIED WHERE POSSIBLE, ADVICE FROM AN ARBOROLOGIST SHOULD BE SOUGHT TO CONFIRM ANY SPECIES OR SIZE SHOWN.

DETAIL, DRAINAGE AND UTILITIES MAY NOT BE SHOWN IF CONCEALED FROM VIEW AT THE TIME OF THE SURVEY.

ANY ERRORS OR DISCREPANCIES FOUND ON THIS DRAWING SHOULD BE REPORTED TO SCOPE SURVEYS LTD IMMEDIATELY.

© SCOPE SURVEYS LTD HOLD THE COPYRIGHT TO ALL INFORMATION PROVIDED IN THIS DRAWING. WRITTEN CONSENT MUST BE OBTAINED PRIOR TO COPYING OR USING THE DATA FOR ANY PURPOSE OTHER THAN ORIGINALLY INTENDED.

DO NOT SCALE FROM THIS DRAWING.

**BUILDING ABBREVIATIONS**

AB	AIR BRICK	MH	MANHOLE COVER
AGU	AIR CONDITIONING UNIT	NA	NO ACCESS
B	BOILER	RAD	RADIATOR
CA	CENTRE OF ARCH	RE	ROOFING EYE
CH	CEILING HEIGHT	RL	ROOF LIGHT
CL	COVER LEVEL	RTW	RETAINING WALL
CSU	CEILING SLOPES UP	RWP	RAIN WATER PIPE
CUPD	CUPBOARD	SA	SIDE OF ARCH
DH	DOOR HEIGHT	SCH	SUSPENDED CEILING
DP	DRAINAGE PIPE	SH	SILL TO HEAD
ECP	ELECTRIC CONTROL PANEL	SP	SPRING POINT
ELEC	ELECTRIC METER	SVP	SOIL VENT PIPE
FL	FLOOR LEVEL	TOP	TOP OF FENCE
FS	FLOOR TO SILL	TOW	TOP OF WALL
G	GULLY	US	UNDERSIDE
GAS	GAS METER	USB	UNDERSIDE OF BEAM
HWT	HOT WATER TANK	UTS	UNABLE TO SURVEY
IC	INSPECTION COVER	V	VENT
IL	INVERT LEVEL	VP	VENT PIPE

**ELEVATIONS KEY PLAN**

AS BUILT SURVEY CARRIED OUT ON  
22<sup>ND</sup> MARCH 2024

CURRENT ADDRESS OF BUILDING IS  
NOW 201 – 203 PRINCE OF WALES  
ROAD, LONDON NW5 3QB


REVISION:

PROJECT	62A HAVERSTOCK HILL LONDON NW3 2BH	
CLIENT	KLF STRUCTURAL DESIGN LTD	
DRAWING TITLE	ELEVATION 1 & 2	
SCALE	DATE	
1:50	MARCH 2024	
DRAWING NUMBER	REVISION	PAPER SIZE
2960_05	-	A1
LEVELS RELATED TO: ARBITRARY		
GRID RELATED TO: ARBITRARY		

**SCOPE SURVEYS**  
LAND & MEASURED BUILDING SURVEYORS

T: 0208 771 3477  
E: INFO@SCOPEURVEYS.CO.UK  
W: WWW.SCOPEURVEYS.CO.UK

OFFICE 2  
20 BEARDELL STREET  
LONDON SE10 1TP

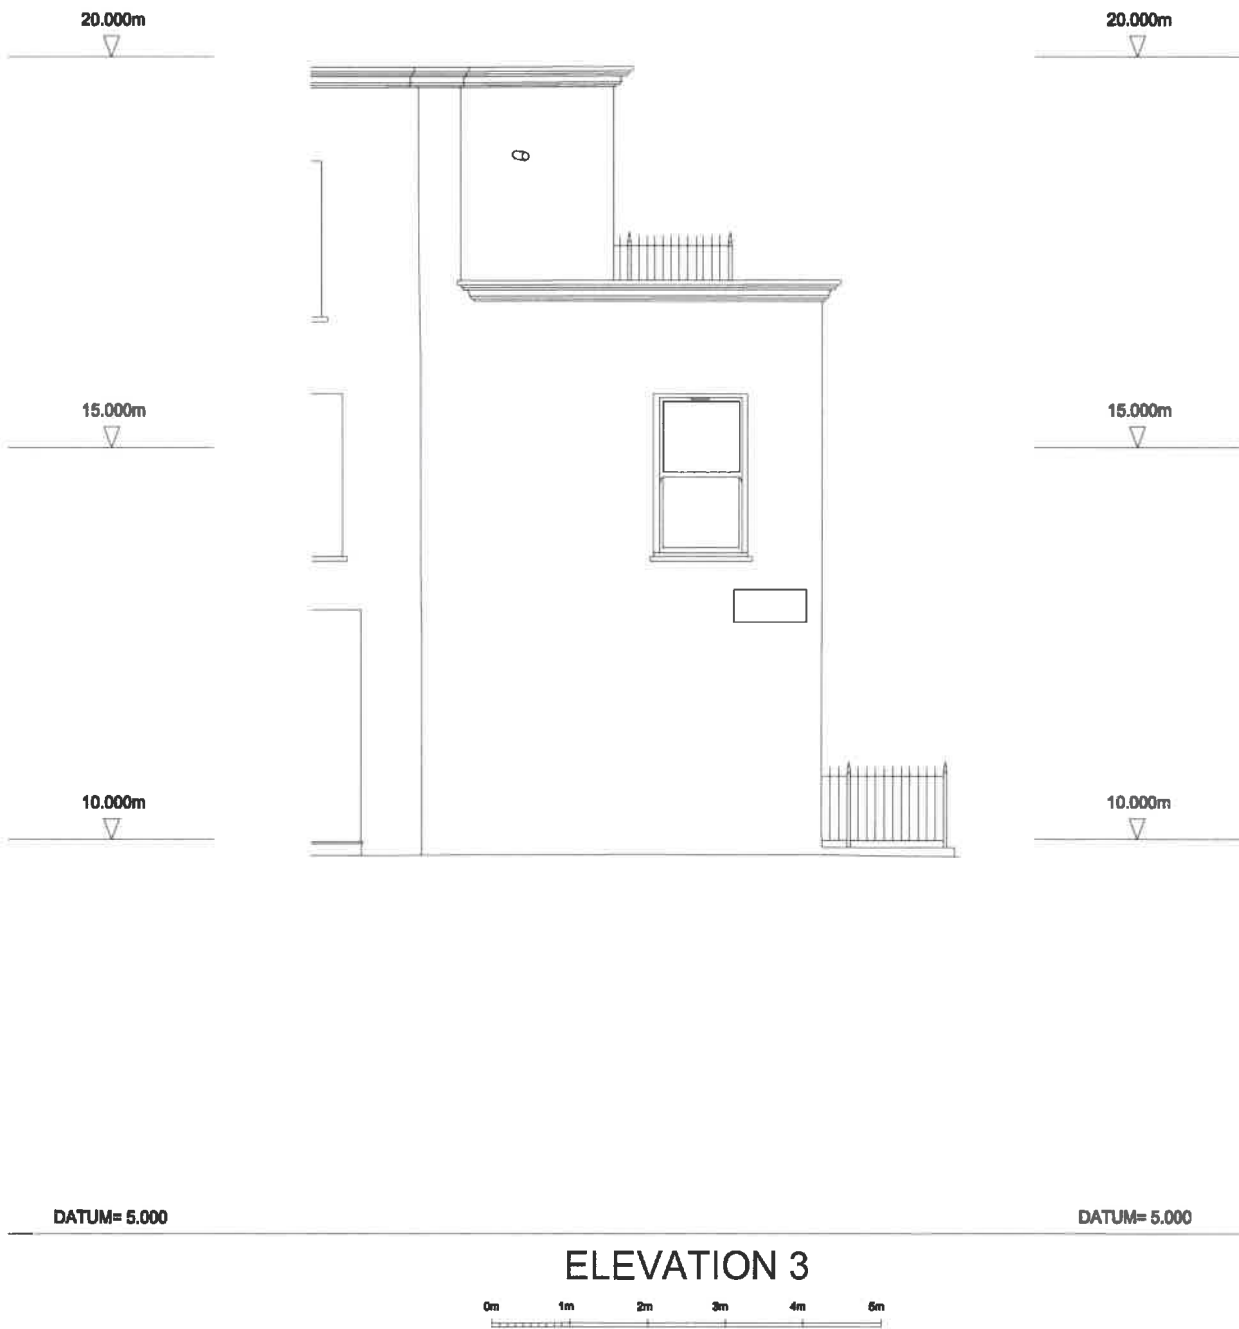

GENERAL NOTES

ALL TREES IDENTIFIED WHERE POSSIBLE, ADVICE FROM AN ARBOROLOGIST SHOULD BE SOUGHT TO CONFIRM ANY SPECIES OR SIZE SHOWN.

DETAIL, DRAINAGE AND UTILITIES MAY NOT BE SHOWN IF CONCEALED FROM VIEW AT THE TIME OF THE SURVEY.

ANY ERRORS OR DISCREPANCIES FOUND ON THIS DRAWING SHOULD BE REPORTED TO SCOPE SURVEYS LTD IMMEDIATELY.

© SCOPE SURVEYS LTD HOLD THE COPYRIGHT TO ALL INFORMATION PROVIDED IN THIS DRAWING. WRITTEN CONSENT MUST BE OBTAINED PRIOR TO COPYING OR USING THE DATA FOR ANY PURPOSE OTHER THAN ORIGINALLY INTENDED.

DO NOT SCALE FROM THIS DRAWING.

BUILDING ABBREVIATIONS

AB	AIR BRICK	MH	MAN-HOLE COVER
ACU	AIR CONDITIONING UNIT	NA	NO ACCESS
B	BOILER	RAO	RADIATOR
CA	CENTRE OF ARCH	RE	ROOFING EYE
CH	CEILING HEIGHT	RL	ROOF LIGHT
CL	COVER LEVEL	RTW	RETAINING WALL
CSU	CEILING SLOPES UP	RWP	RAIN WATER PIPE
CUPD	CUPBOARD	SA	SIDE OF ARCH
DH	DOOR HEIGHT	SCH	SUSPENDED CEILING
DP	DRAINAGE PIPE	SH	SILL TO HEAD
EDC	ELECTRIC CONTROL PANEL	SP	SPRING POINT
ELEC	ELECTRIC METER	SVP	SOIL VENT PIPE
FL	FLOOR LEVEL	TOP	TOP OF FENCE
FS	FLOOR TO SILL	TOW	TOP OF WALL
G	GULLY	U/S	UNDERSIDE
GAS	GAS METER	USB	UNDERSIDE OF BEAM
HWT	HOT WATER TANK	UTS	UNABLE TO SURVEY
IC	INSPECTION COVER	V	VENT
IL	INVERT LEVEL	VP	VENT PIPE

ELEVATIONS KEY PLAN



AS BUILT SURVEY CARRIED OUT ON  
22<sup>ND</sup> MARCH 2024

CURRENT ADDRESS OF BUILDING IS  
NOW 201 – 203 PRINCE OF WALES  
ROAD, LONDON NW5 3QB

REVISION:		
PROJECT 62A HAVERSTOCK HILL LONDON NW3 2BH		
CLIENT KLF STRUCTURAL DESIGN LTD		
DRAWING TITLE ELEVATION 3		
SCALE 1:50	DATE MARCH 2024	
DRAWING NUMBER 2960_06	REVISION -	PAPER SIZE A1
LEVELS RELATED TO: ARBITRARY		
GRID RELATED TO: ARBITRARY		

**SCOPE**  
SURVEYS

LAND & MEASURED BUILDING SURVEYORS

T: 0208 771 3477  
E: INFO@SCOPE SURVEYS.CO.UK  
W: WWW.SCOPE SURVEYS.CO.UK

OFFICE 2  
20 BEARDELL STREET  
LONDON SE16 1TP



ELEVATION 4



GENERAL NOTES

ALL TREES IDENTIFIED WHERE POSSIBLE, ADVICE FROM AN ARBOROLOGIST SHOULD BE SOUGHT TO CONFIRM ANY SPECIES OR SIZE SHOWN.

DETAIL, DRAINAGE AND UTILITIES MAY NOT BE SHOWN IF CONCEALED FROM VIEW AT THE TIME OF THE SURVEY.

ANY ERRORS OR DISCREPANCIES FOUND ON THIS DRAWING SHOULD BE REPORTED TO SCOPE SURVEYS LTD IMMEDIATELY.


© SCOPE SURVEYS LTD HOLD THE COPYRIGHT TO ALL INFORMATION PROVIDED IN THIS DRAWING. WRITTEN CONSENT MUST BE OBTAINED PRIOR TO COPYING OR USING THE DATA FOR ANY PURPOSE OTHER THAN ORIGINALLY INTENDED.

DO NOT SCALE FROM THIS DRAWING.

BUILDING ABBREVIATIONS

AB	AIR BRICK	MH	MANHOLE COVER
ACU	AIR CONDITIONING UNIT	NA	NO ACCESS
B	BOILER	RAD	RADIATOR
CA	CENTRE OF ARCH	RE	ROOFING EYE
CH	CEILING HEIGHT	RL	ROOF LIGHT
CL	COVER LEVEL	RTW	RETAINING WALL
CSU	CEILING SLOPES UP	RWP	RAIN WATER PIPE
CUPD	CUPBOARD	SA	SIDE OF ARCH
DH	DOOR HEIGHT	SCH	SUSPENDED CEILING
DP	DRAINAGE PIPE	SH	SILL TO HEAD
ECP	ELECTRIC CONTROL PANEL	SP	SPRING POINT
ELEC	ELECTRIC METER	SVP	SOIL VENT PIPE
FL	FLOOR LEVEL	TGF	TOP OF FENCE
FS	FLOOR TO SILL	TOW	TOP OF WALL
G	GULLY	UIS	UNDERSIDE
GAS	GAS METER	USB	UNDERSIDE OF BEAM
HWT	HOT WATER TANK	UTS	UNABLE TO SURVEY
IC	INSPECTION COVER	V	VENT
IL	INVERT LEVEL	VP	VENT PIPE

ELEVATIONS KEY PLAN

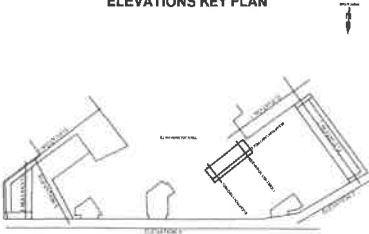

AS BUILT SURVEY CARRIED OUT ON  
22<sup>ND</sup> MARCH 2024

CURRENT ADDRESS OF BUILDING IS  
NOW 201 – 203 PRINCE OF WALES  
ROAD, LONDON NW5 3QB

REVISION:

PROJECT  
62A HAVERSTOCK HILL  
LONDON NW3 2BH

CLIENT  
KLF STRUCTURAL DESIGN LTD

DRAWING TITLE  
ELEVATION 4

SCALE  
1:50

DATE  
MARCH 2024

DRAWING NUMBER  
2960\_07

REVISION  
-

PAPER SIZE  
A1

LEVELS RELATED TO:  
ARBITRARY

GRID RELATED TO:  
ARBITRARY


**SCOPE**  
**SURVEYS**

LAND & MEASURED BUILDING SURVEYORS

T: 0208 771 3477  
E: INFO@SCOPESURVEYS.CO.UK  
W: WWW.SCOPESURVEYS.CO.UK

OFFICE 2  
20 BEARDELL STREET  
LONDON SE18 1TP



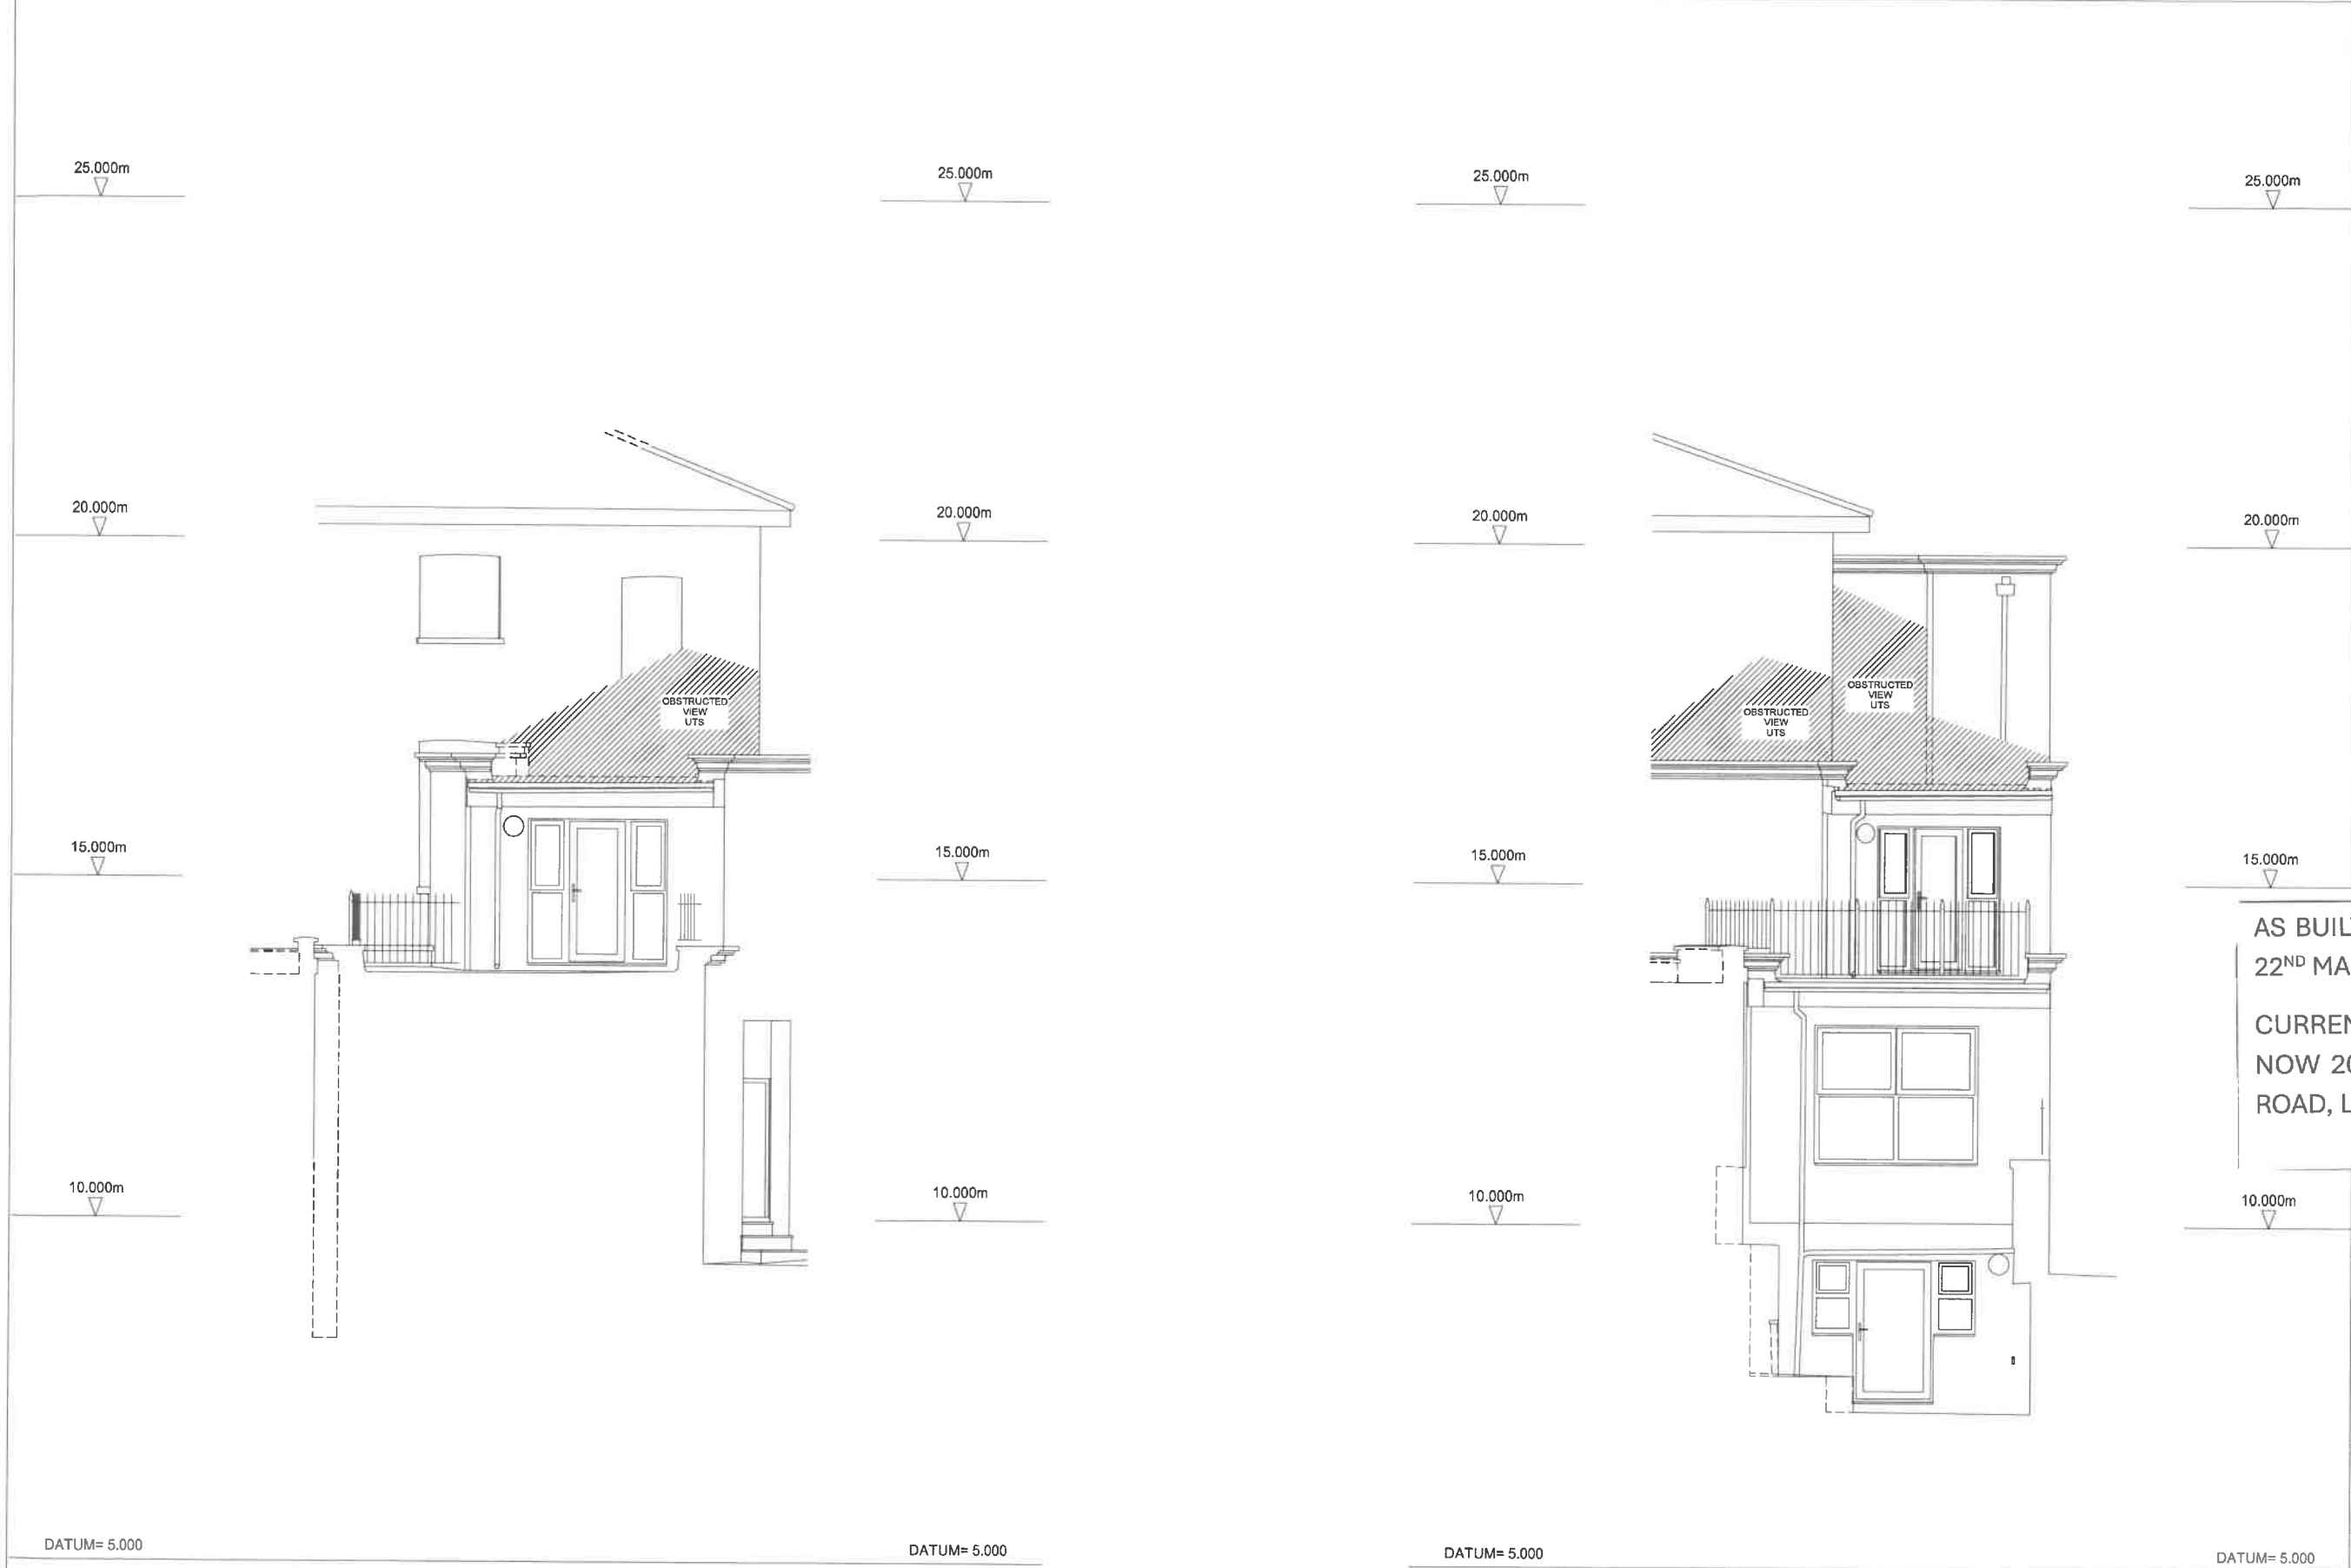

**GENERAL NOTES**

ALL TREES IDENTIFIED WHERE POSSIBLE, ADVICE FROM AN ARBOROLOGIST SHOULD BE SOUGHT TO CONFIRM ANY SPECIES OR SIZE SHOWN.

DETAIL, DRAINAGE AND UTILITIES MAY NOT BE SHOWN IF CONCEALED FROM VIEW AT THE TIME OF THE SURVEY.

ANY ERRORS OR DISCREPANCIES FOUND ON THIS DRAWING SHOULD BE REPORTED TO SCOPE SURVEYS LTD IMMEDIATELY.

© SCOPE SURVEYS LTD HOLD THE COPYRIGHT TO ALL INFORMATION PROVIDED IN THIS DRAWING. WRITTEN CONSENT MUST BE OBTAINED PRIOR TO COPYING OR USING THE DATA FOR ANY PURPOSE OTHER THAN ORIGINALLY INTENDED.

DO NOT SCALE FROM THIS DRAWING.

**BUILDING ABBREVIATIONS**

AB	AIR BRICK	MH	MANHOLE COVER
ACU	AIR CONDITIONING UNIT	NA	NO ACCESS
B	BOILER	RAO	RADIATOR
CA	CENTRE OF ARCH	RE	RODDING EYE
CH	CEILING HEIGHT	RL	ROOF LIGHT
CL	COVER LEVEL	RTW	RETAINING WALL
CSU	CEILING SLOPES UP	RWP	RAIN WATER PIPE
CUPD	CUPBOARD	SA	SIDE OF ARCH
DH	DOOR HEIGHT	SCH	SUSPENDED CEILING
DP	DRAINAGE PIPE	SH	BILL TO HEAD
ECP	ELECTRIC CONTROL PANEL	SP	SPRING POINT
ELEC	ELECTRIC METER	SVF	SOIL VENT PIPE
FL	FLOOR LEVEL	TCF	TOP OF FENCE
FS	FLOOR TO SILL	TCW	TOP OF WALL
G	GULLY	US	UNDERSIDE
GAS	GAS METER	USB	UNDERSIDE OF BEAM
HWT	HOT WATER TANK	UTS	UNABLE TO SURVEY
I	INSPECTION COVER	V	VENT
IL	INVERT LEVEL	VP	VENT PIPE

**ELEVATIONS KEY PLAN**

AS BUILT SURVEY CARRIED OUT ON  
22<sup>ND</sup> MARCH 2024

CURRENT ADDRESS OF BUILDING IS  
NOW 201 – 203 PRINCE OF WALES  
ROAD, LONDON NW5 3QB

REVISION:

PROJECT	62A HAVERSTOCK HILL LONDON NW3 2BH	
CLIENT	KLF STRUCTURAL DESIGN LTD	
DRAWING TITLE	ELEVATION 5 & 6	
SCALE	DATE	
1:50	MARCH 2024	
DRAWING NUMBER	REVISION	PAPER SIZE
2960_08	-	A1
LEVELS RELATED TO: ARBITRARY		
GRID RELATED TO: ARBITRARY		

**SCOPE SURVEYS**


LAND & MEASURED BUILDING SURVEYORS

T: 0208 771 3477  
E: INFO@SCOPEURVEYS.CO.UK  
W: WWW.SCOPEURVEYS.CO.UK


OFFICE 2  
20 BEARDELL STREET  
LONDON SE19 1TP

THE SURVEY ASSOCIATION  
worksafe contractor  
SSIP  
ISO 9001 CERTIFIED



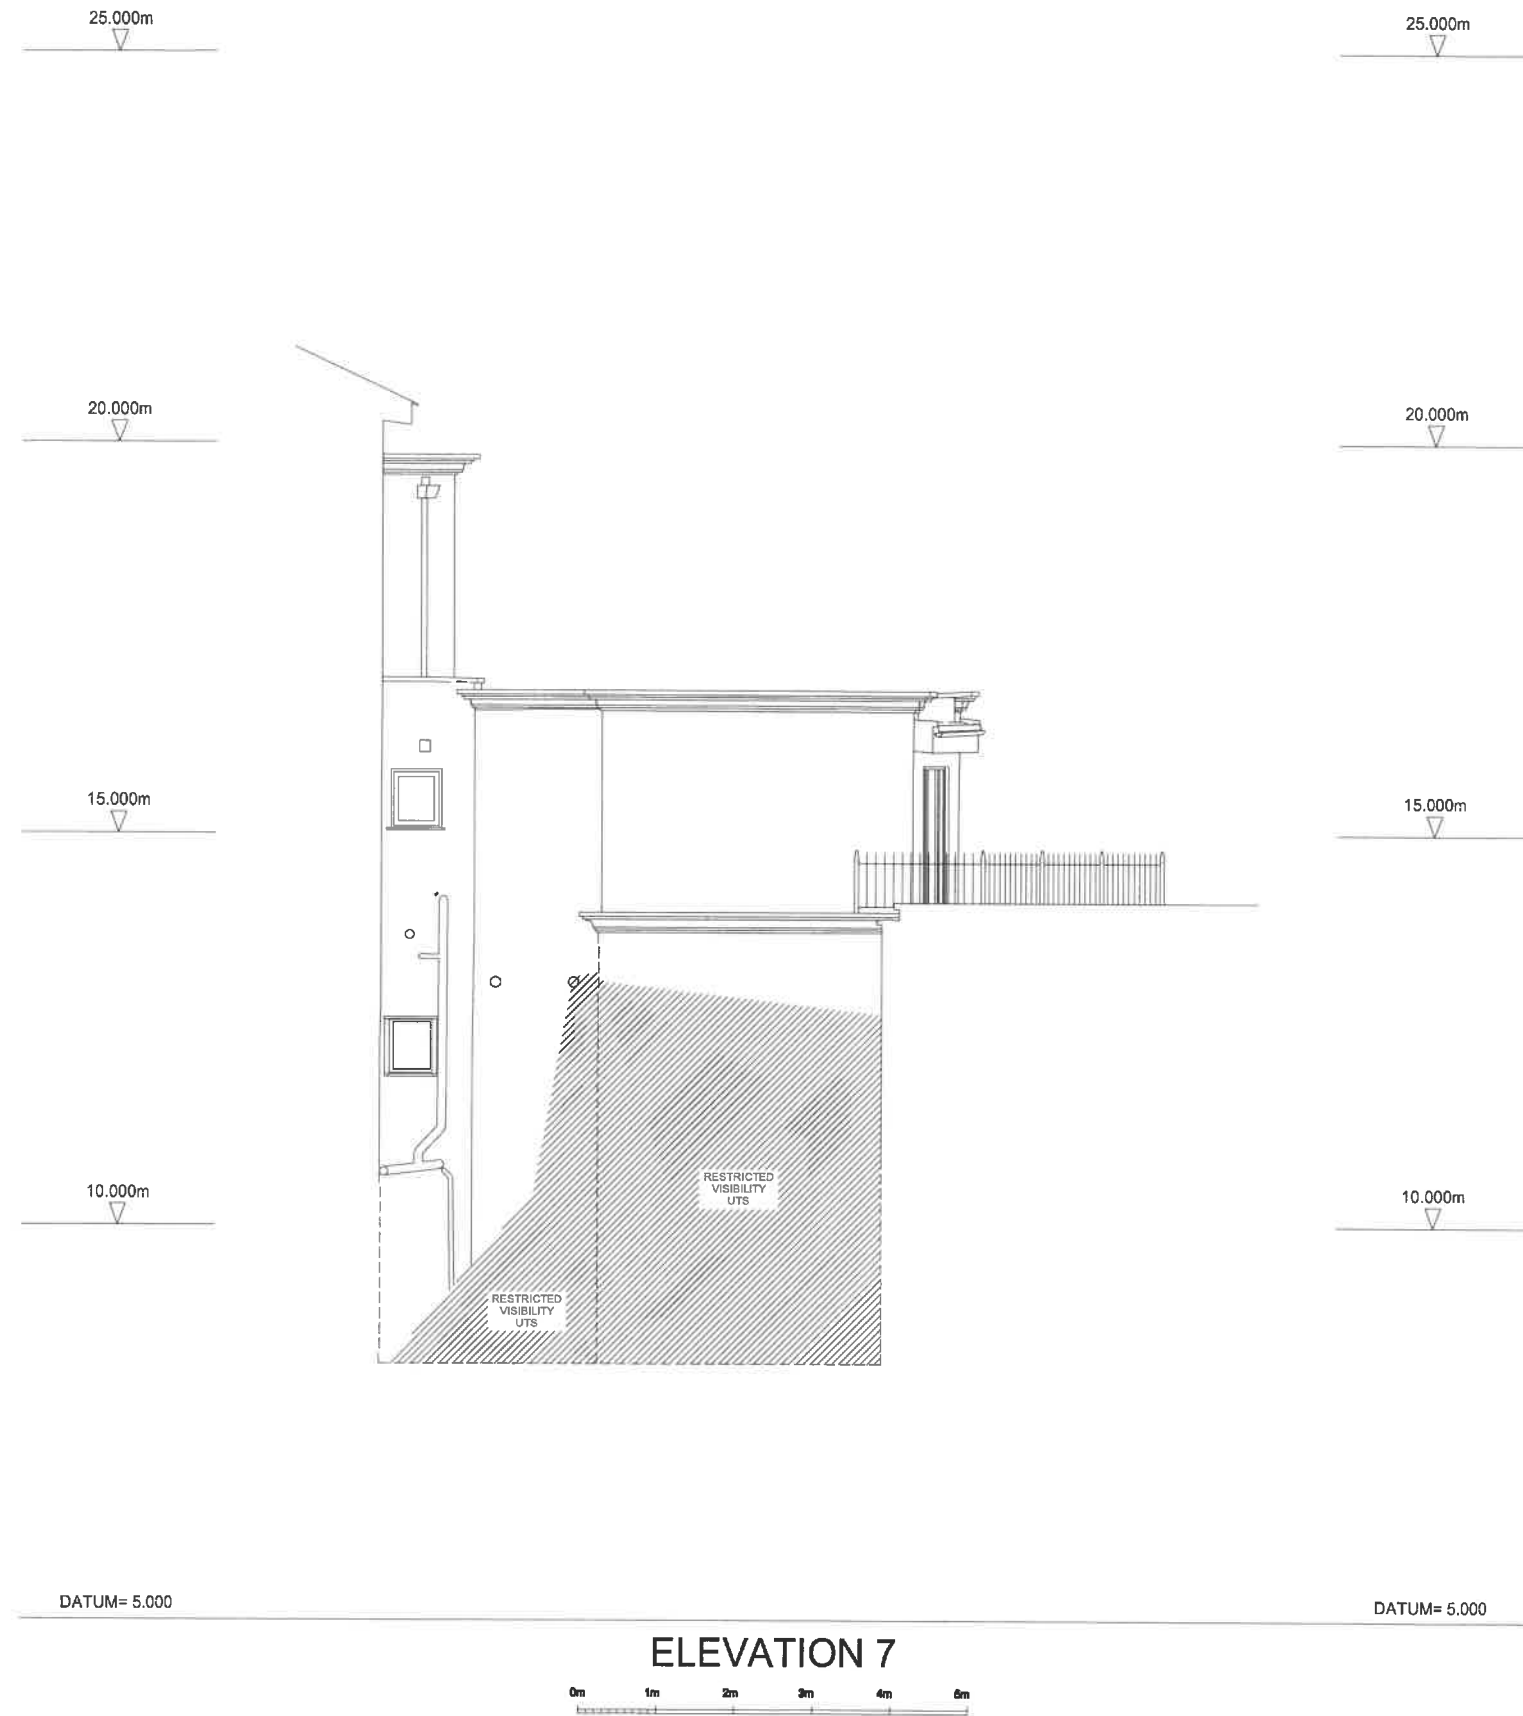

GENERAL NOTES			
ALL TREES IDENTIFIED WHERE POSSIBLE. ADVICE FROM AN ARBOROLOGIST SHOULD BE SOUGHT TO CONFIRM ANY SPECIES OR SIZE SHOWN.			
DETAIL, DRAINAGE AND UTILITIES MAY NOT BE SHOWN IF CONCEALED FROM VIEW AT THE TIME OF THE SURVEY.			
ANY ERRORS OR DISCREPANCIES FOUND ON THIS DRAWING SHOULD BE REPORTED TO SCOPE SURVEYS LTD IMMEDIATELY.			
© SCOPE SURVEYS LTD HOLD THE COPYRIGHT TO ALL INFORMATION PROVIDED IN THIS DRAWING. WRITTEN CONSENT MUST BE OBTAINED PRIOR TO COPYING OR USING THE DATA FOR ANY PURPOSE OTHER THAN ORIGINALLY INTENDED.			
DO NOT SCALE FROM THIS DRAWING.			
BUILDING ABBREVIATIONS			
AB	AIR BRICK	KH	MANHOLE COVER
ACU	AIR CONDITIONING UNIT	NA	NO ACCESS
B	BOILER	RAD	RADIATOR
CA	CENTRE OF ARCH	RE	RODDING EYE
CH	CEILING HEIGHT	RL	ROOF LIGHT
CL	COVER LEVEL	RW	RETAINING WALL
CSU	CEILING SLOPES UP	RWP	RAIN WATER PIPE
CUPD	CUPBOARD	SA	SIDE OF ARCH
DH	DOOR HEIGHT	SCH	SUSPENDED CEILING
DP	DRAINAGE PIPE	SH	SILL TO HEAD
ECP	ELECTRIC CONTROL PANEL	SP	SPRING POINT
ELEC	ELECTRIC METER	SVP	SOIL VENT PIPE
FL	FLOOR LEVEL	TOP	TOP OF FENCE
FS	FLOOR TO SILL	TOW	TOP OF WALL
G	GULLY	US	UNDERSIDE
GAS	GAS METER	USB	UNDERSIDE OF BEAM
HWT	HOT WATER TANK	UTS	UNABLE TO SURVEY
IC	INSPECTION COVER	V	VENT
IL	INVERT LEVEL	VP	VENT PIPE

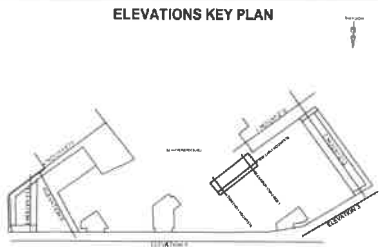

AS BUILT SURVEY CARRIED OUT ON  
22<sup>ND</sup> MARCH 2024

CURRENT ADDRESS OF BUILDING IS  
NOW 201 – 203 PRINCE OF WALES  
ROAD, LONDON NW5 3QB

REVISION:		
PROJECT 62A HAVERSTOCK HILL LONDON NW3 2BH		
CLIENT KLF STRUCTURAL DESIGN LTD		
DRAWING TITLE ELEVATION 7		
SCALE 1:50	DATE MARCH 2024	
DRAWING NUMBER 2960_09	REVISION -	PAPER SIZE A1
LEVELS RELATED TO: ARBITRARY		
GRID RELATED TO: ARBITRARY		

**SCOPE**  
SURVEYS

LAND & MEASURED BUILDING SURVEYORS

T: 0208 771 3477  
E: INFO@SCOPESURVEYS.CO.UK  
W: WWW.SCOPESURVEYS.CO.UK

OFFICE 2  
20 SEARDELL STREET  
LONDON SE16 1TP



**GENERAL NOTES**

ALL TREES IDENTIFIED WHERE POSSIBLE. ADVICE FROM AN ARBOROLOGIST SHOULD BE SOUGHT TO CONFIRM ANY SPECIES OR SIZE SHOWN.


DETAIL DRAINAGE AND UTILITIES MAY NOT BE SHOWN IF CONCEALED FROM VIEW AT THE TIME OF THE SURVEY.

ANY ERRORS OR DISCREPANCIES FOUND ON THIS DRAWING SHOULD BE REPORTED TO SCOPE SURVEYS LTD IMMEDIATELY.

© SCOPE SURVEYS LTD HOLD THE COPYRIGHT TO ALL INFORMATION PROVIDED IN THIS DRAWING. WRITTEN CONSENT MUST BE OBTAINED PRIOR TO COPYING OR USING THE DATA FOR ANY PURPOSE OTHER THAN ORIGINALLY INTENDED.

DO NOT SCALE FROM THIS DRAWING.

BUILDING ABBREVIATIONS			
AB	AIR BRICK	MH	MANHOLE COVER
ACU	AIR CONDITIONING UNIT	NA	NO ACCESS
B	BOILER	RAD	RADIATOR
CA	CENTRE OF ARCH	RE	RODDING EYE
CH	CEILING HEIGHT	RL	ROOF LIGHT
CL	COVER LEVEL	RTW	RETAINING WALL
CSU	CEILING SLOPES UP	RWP	RAIN WATER PIPE
CUPD	CUPBOARD	SA	SIDE OF ARCH
DH	DOOR HEIGHT	SCH	SUSPENDED CEILING
DP	DRAINAGE PIPE	SH	SILL TO HEAD
ECP	ELECTRIC CONTROL PANEL	SP	SPRING POINT
ELEC	ELECTRIC METER	SVP	SOIL VENT PIPE
FL	FLOOR LEVEL	TOF	TOP OF FENCE
FS	FLOOR TO SILL	TOW	TOP OF WALL
G	GULLY	US	UNDERSIDE
GAS	GAS METER	USB	UNDERSIDE OF BEAM
HWT	HOT WATER TANK	UTS	UNABLE TO SURVEY
IC	INSPECTION COVER	V	VENT
IL	INVERT LEVEL	VP	VENT PIPE

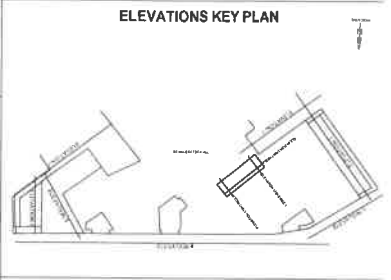

AS BUILT SURVEY CARRIED OUT ON  
22<sup>ND</sup> MARCH 2024

CURRENT ADDRESS OF BUILDING IS  
NOW 201 – 203 PRINCE OF WALES  
ROAD, LONDON NW5 3QB

REVISION:		
PROJECT 62A HAVERSTOCK HILL LONDON NW3 2BH		
CLIENT KLF STRUCTURAL DESIGN LTD		
DRAWING TITLE ELEVATIONS LIGHTWELL		
SCALE 1:50	DATE MARCH 2024	
DRAWING NUMBER 2960_10	REVISION -	PAPER SIZE A1
LEVELS RELATED TO: ARBITRARY		
GRID RELATED TO: ARBITRARY		

SCOPE SURVEYS

LAND & MEASURED BUILDING SURVEYORS

T: 0208 771 3477  
E: INFO@SCOPEURVEYS.CO.UK  
W: WWW.SCOPEURVEYS.CO.UK

OFFICE 2  
20 BEARDELL STREET  
LONDON SE16 1TP