


CONCRETE ARCH OPTIONS

EAST SIDE MOUND BUILDING:

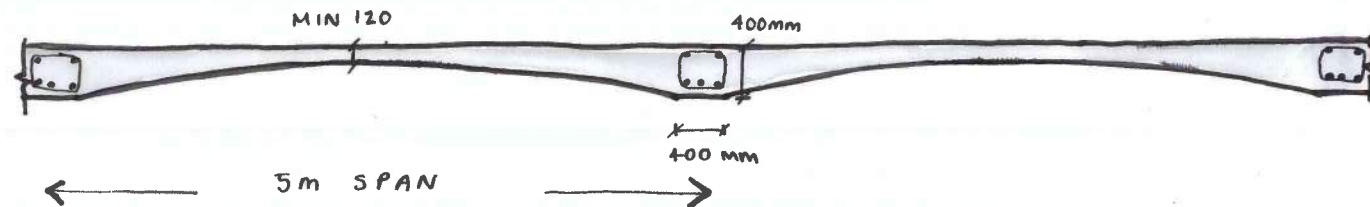


- SHALLOW BEAMS REQUIRED DUE TO HEIGHT RESTRICTIONS


PRECAST VS IN-SITU CONSTRUCTION:

• PRECAST:

• PRECAST PANEL SPLIT LOCATION OPTIONS:

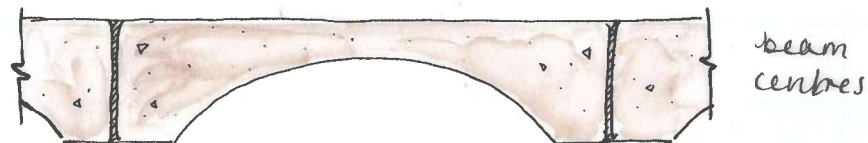

OR

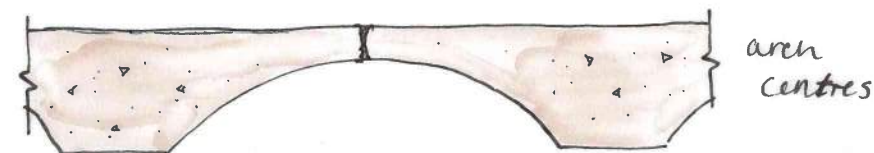


→ LONGER CURING → CAN USE LATER AGE STRENGTH GAIN (56-day vs 28-day)

→ LESS TIME ON SITE, ELEMENTS CRANED IN.


• IN-SITU:

• CUSTOM FORMWORK REQUIRED TO FORM ARCH ON SITE.
• LONGER CONSTRUCTION TIMES DUE TO CURING TIME & TEMPORARY PROPS.

WEST CAFE & OPERATIONS BUILDING:

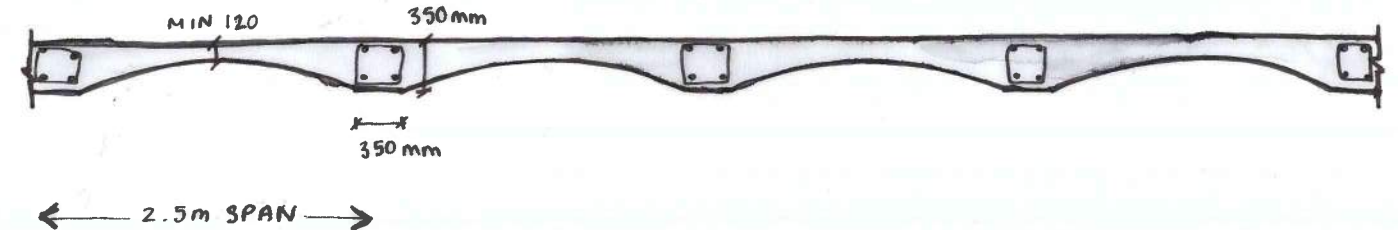

- OPTION TO HAVE SHALLOWER OR DEEPER BEAMS AND ARCHES (e.g. IN DOUBLE HEIGHT ZONES)

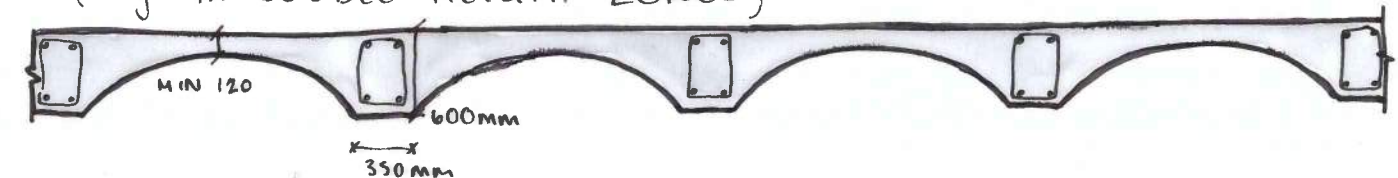

350 deep vs 600 deep:

- **350 DEEP** → LOWER CONCRETE VOLUME
→ MORE REINFORCEMENT REQUIRED.

~ 83 kg CO₂e/m² *

- **600 DEEP** → REDUCES HORIZONTAL FORCES ON EDGE BEAMS.
→ ARCH SHAPE EXPRESSED WITH STRONGER CURVE?

~ 114 kg CO₂e/m² *

CONCRETE:

- CONCRETE MIX TO ACHIEVE A MINIMUM STRENGTH EQUIVALENT TO RC 28/35,
- CONCRETE TO BE SUITABLE FOR EXPOSURE CLASSES XC3, AND XF1 WHERE VEHICLES ARE PRESENT (ATTACK FROM DE-ICING SALTS)
- CONCRETE SUPPLIER EARLY INVOLVEMENT RECOMMENDED TO GUIDE FINISH, EMBODIED CARBON, AND ADDITIONAL CHOICES.

* VALUES SHOWN IN kg CO₂e/m² (FLOOR AREA), CONSIDERING CONCRETE WITH 75% CEMENT REPLACEMENT FOR THE STRUCTURAL SLAB.

WEBB YATES ENGINEERS

020 3696 1550 london@webbyates.com
www.webbyates.com

Drawing No

34565-S-SK-0021

Project

HIGHGATE CEMETERY

Status

S9

Drawing Title

CONCRETE ARCH OPTIONS

Date

4/6/24

Drawn by

AA

Scale

NTS

Revision

0


APPENDIX C. STAGE 3 CIVIL SKETCHES

Option to connect surface water to the combined Thames Water sewer on Swain's Lane was considered, however it is not a sustainable option. Nevertheless, if necessary could be done. This will require pre-planning application to Thames Water to determine whether it is feasible.

Current design routes rainwater drainage around the building. This is designed on the assumption there is space around the building for the proposed manholes.

Due to limited space, this external RWP is proposed to connect to existing manhole. To connect to the proposed RWP drainage system will require additional manhole.


Existing gravity connection to combined Thames Water public sewer underneath Swain's Lane. Thames Water and Local Authority's approval required.

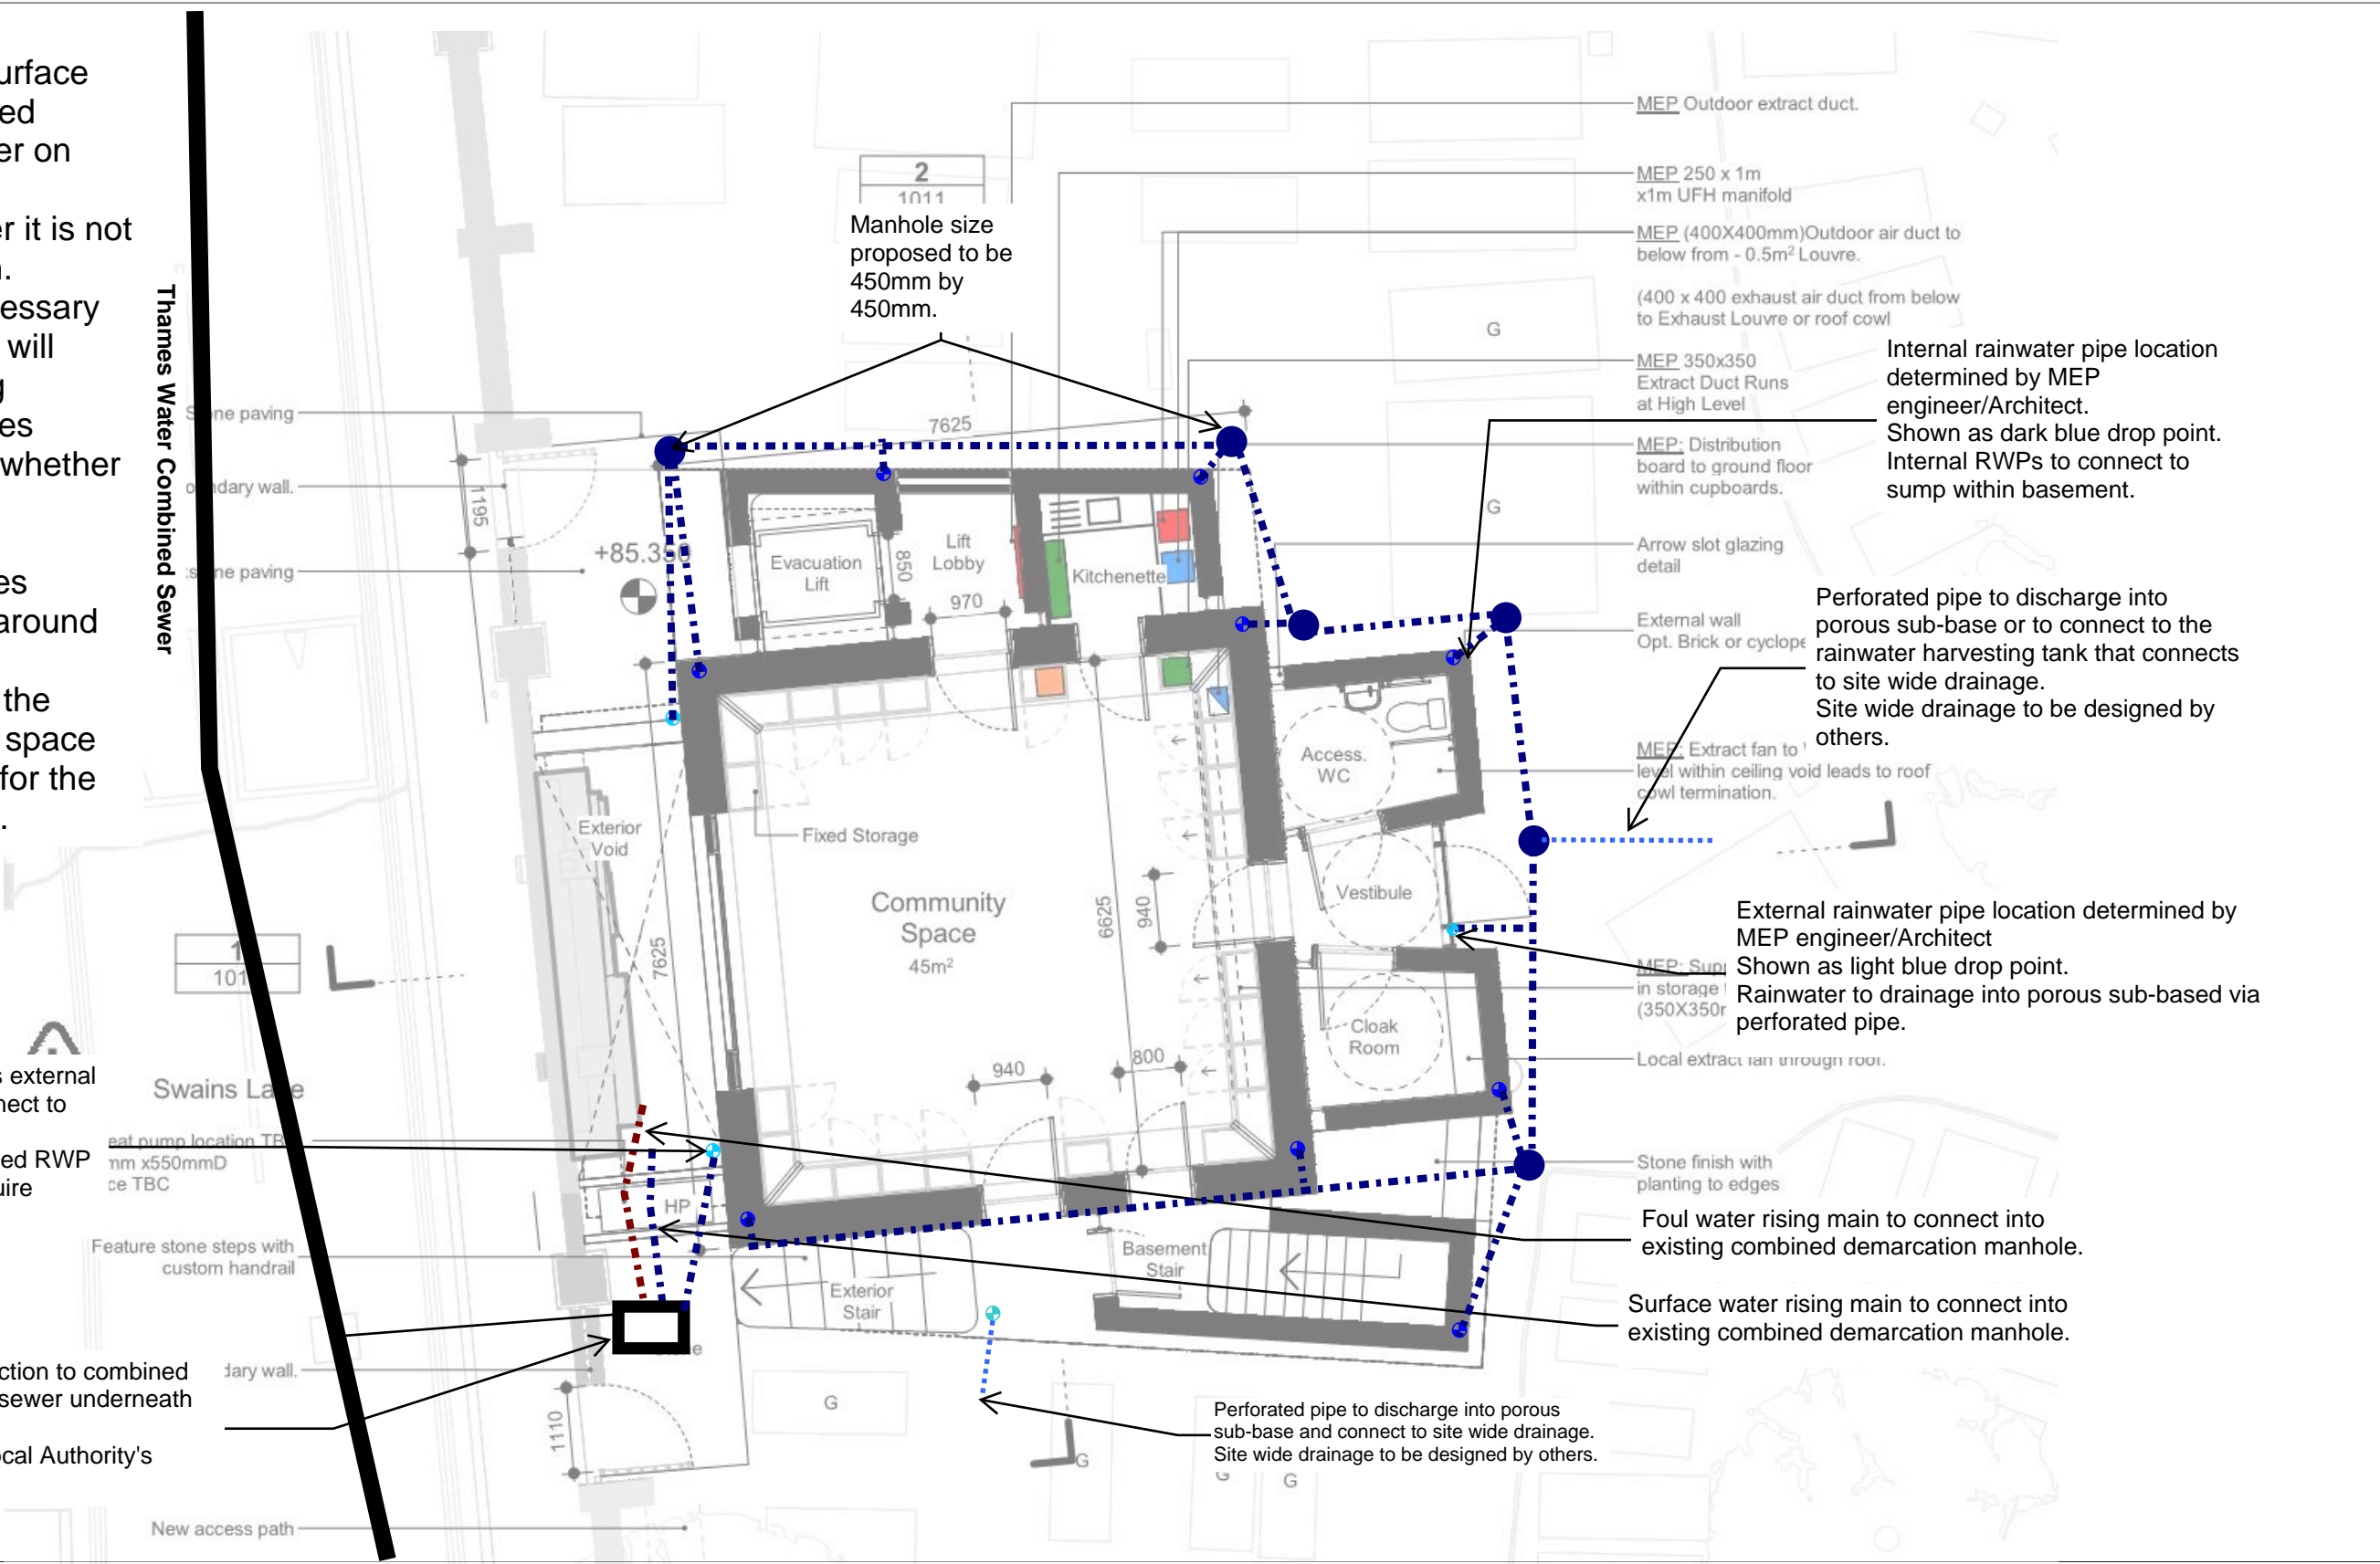

WEBB
YATES ENGINEERS

020 3696 1550
london@webbyates.com
www.webbyates.com


Drawing No. J4565-C-SK-0001			
Project Highgate Cemetery			Status S3
Drawing Title P1 - Ground Floor - East Side Education and Community Building			
Date 03.07.24	Drawn by ZA	Scale NTS	Revision DRAFT

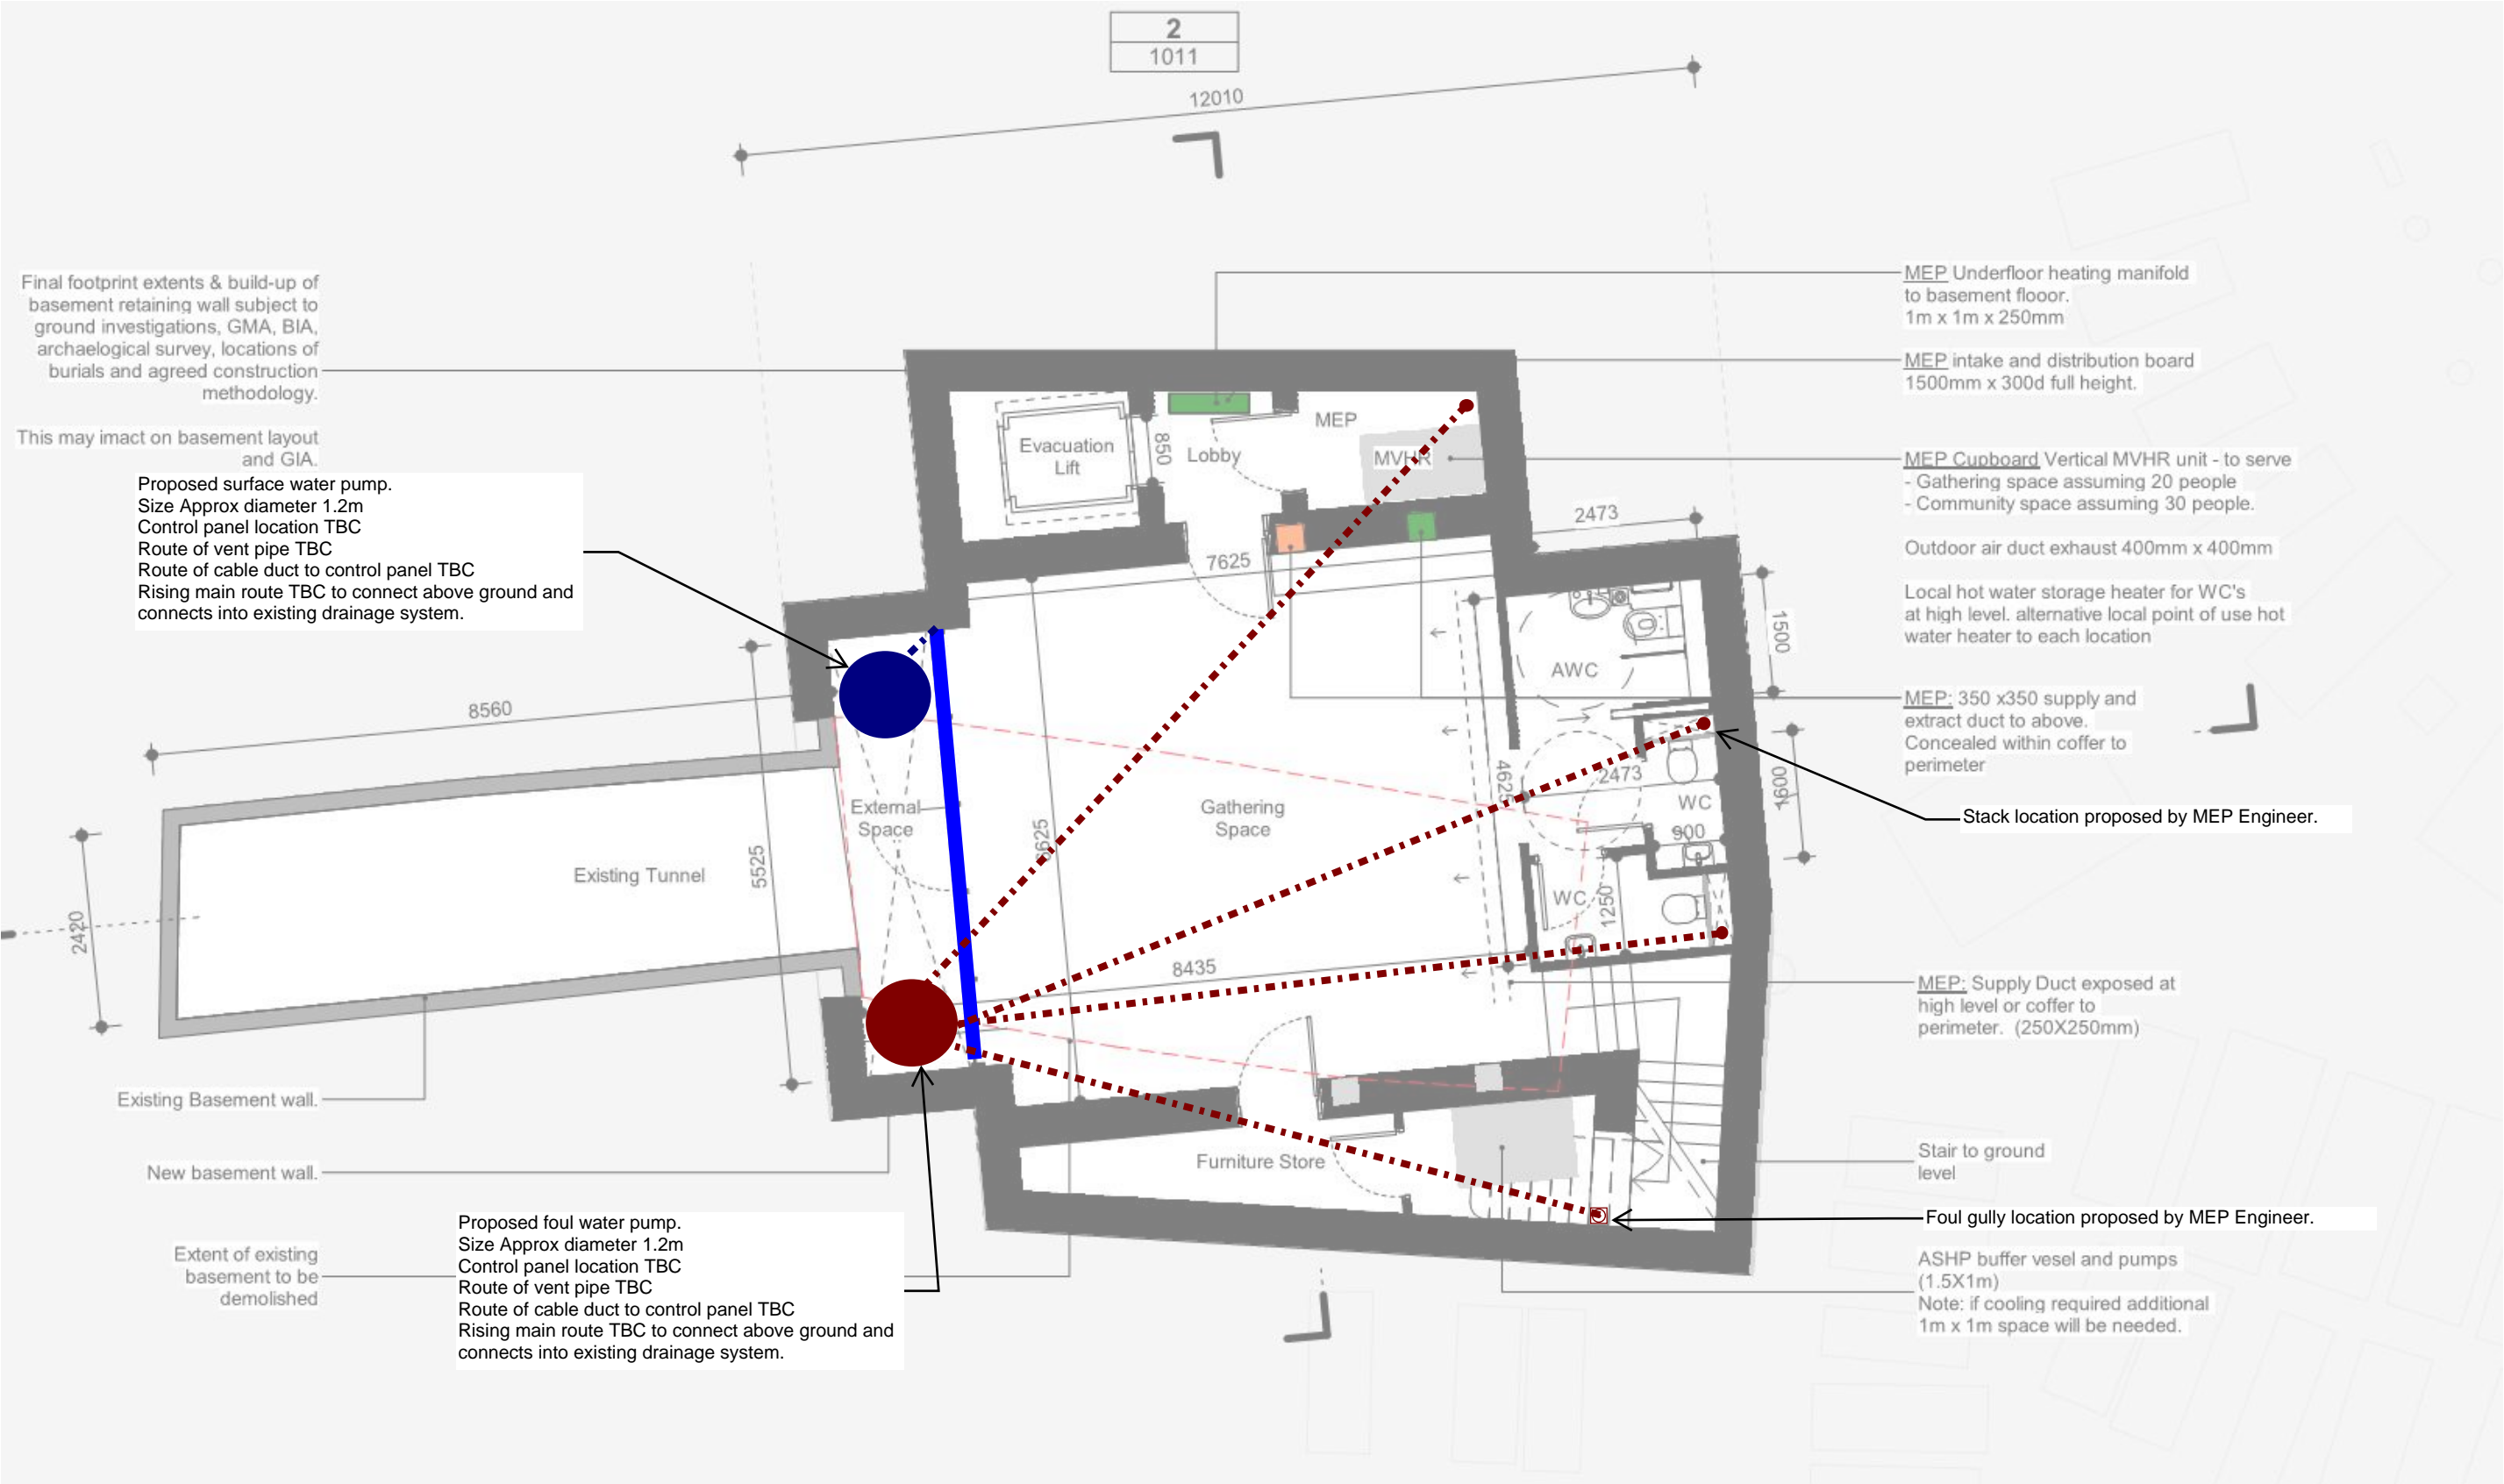

**WEBB
YATES** ENGINEERS

020 3696 1550
london@webbyates.com
www.webbyates.com


Drawing No. J4565-C-SK-0002	Status S3
Project Highgate Cemetery	
Drawing Title P1 - Basement - East Side Education and Community Building	
Date 03.07.24	Revision DRAFT
Drawn by ZA	Scale NTS

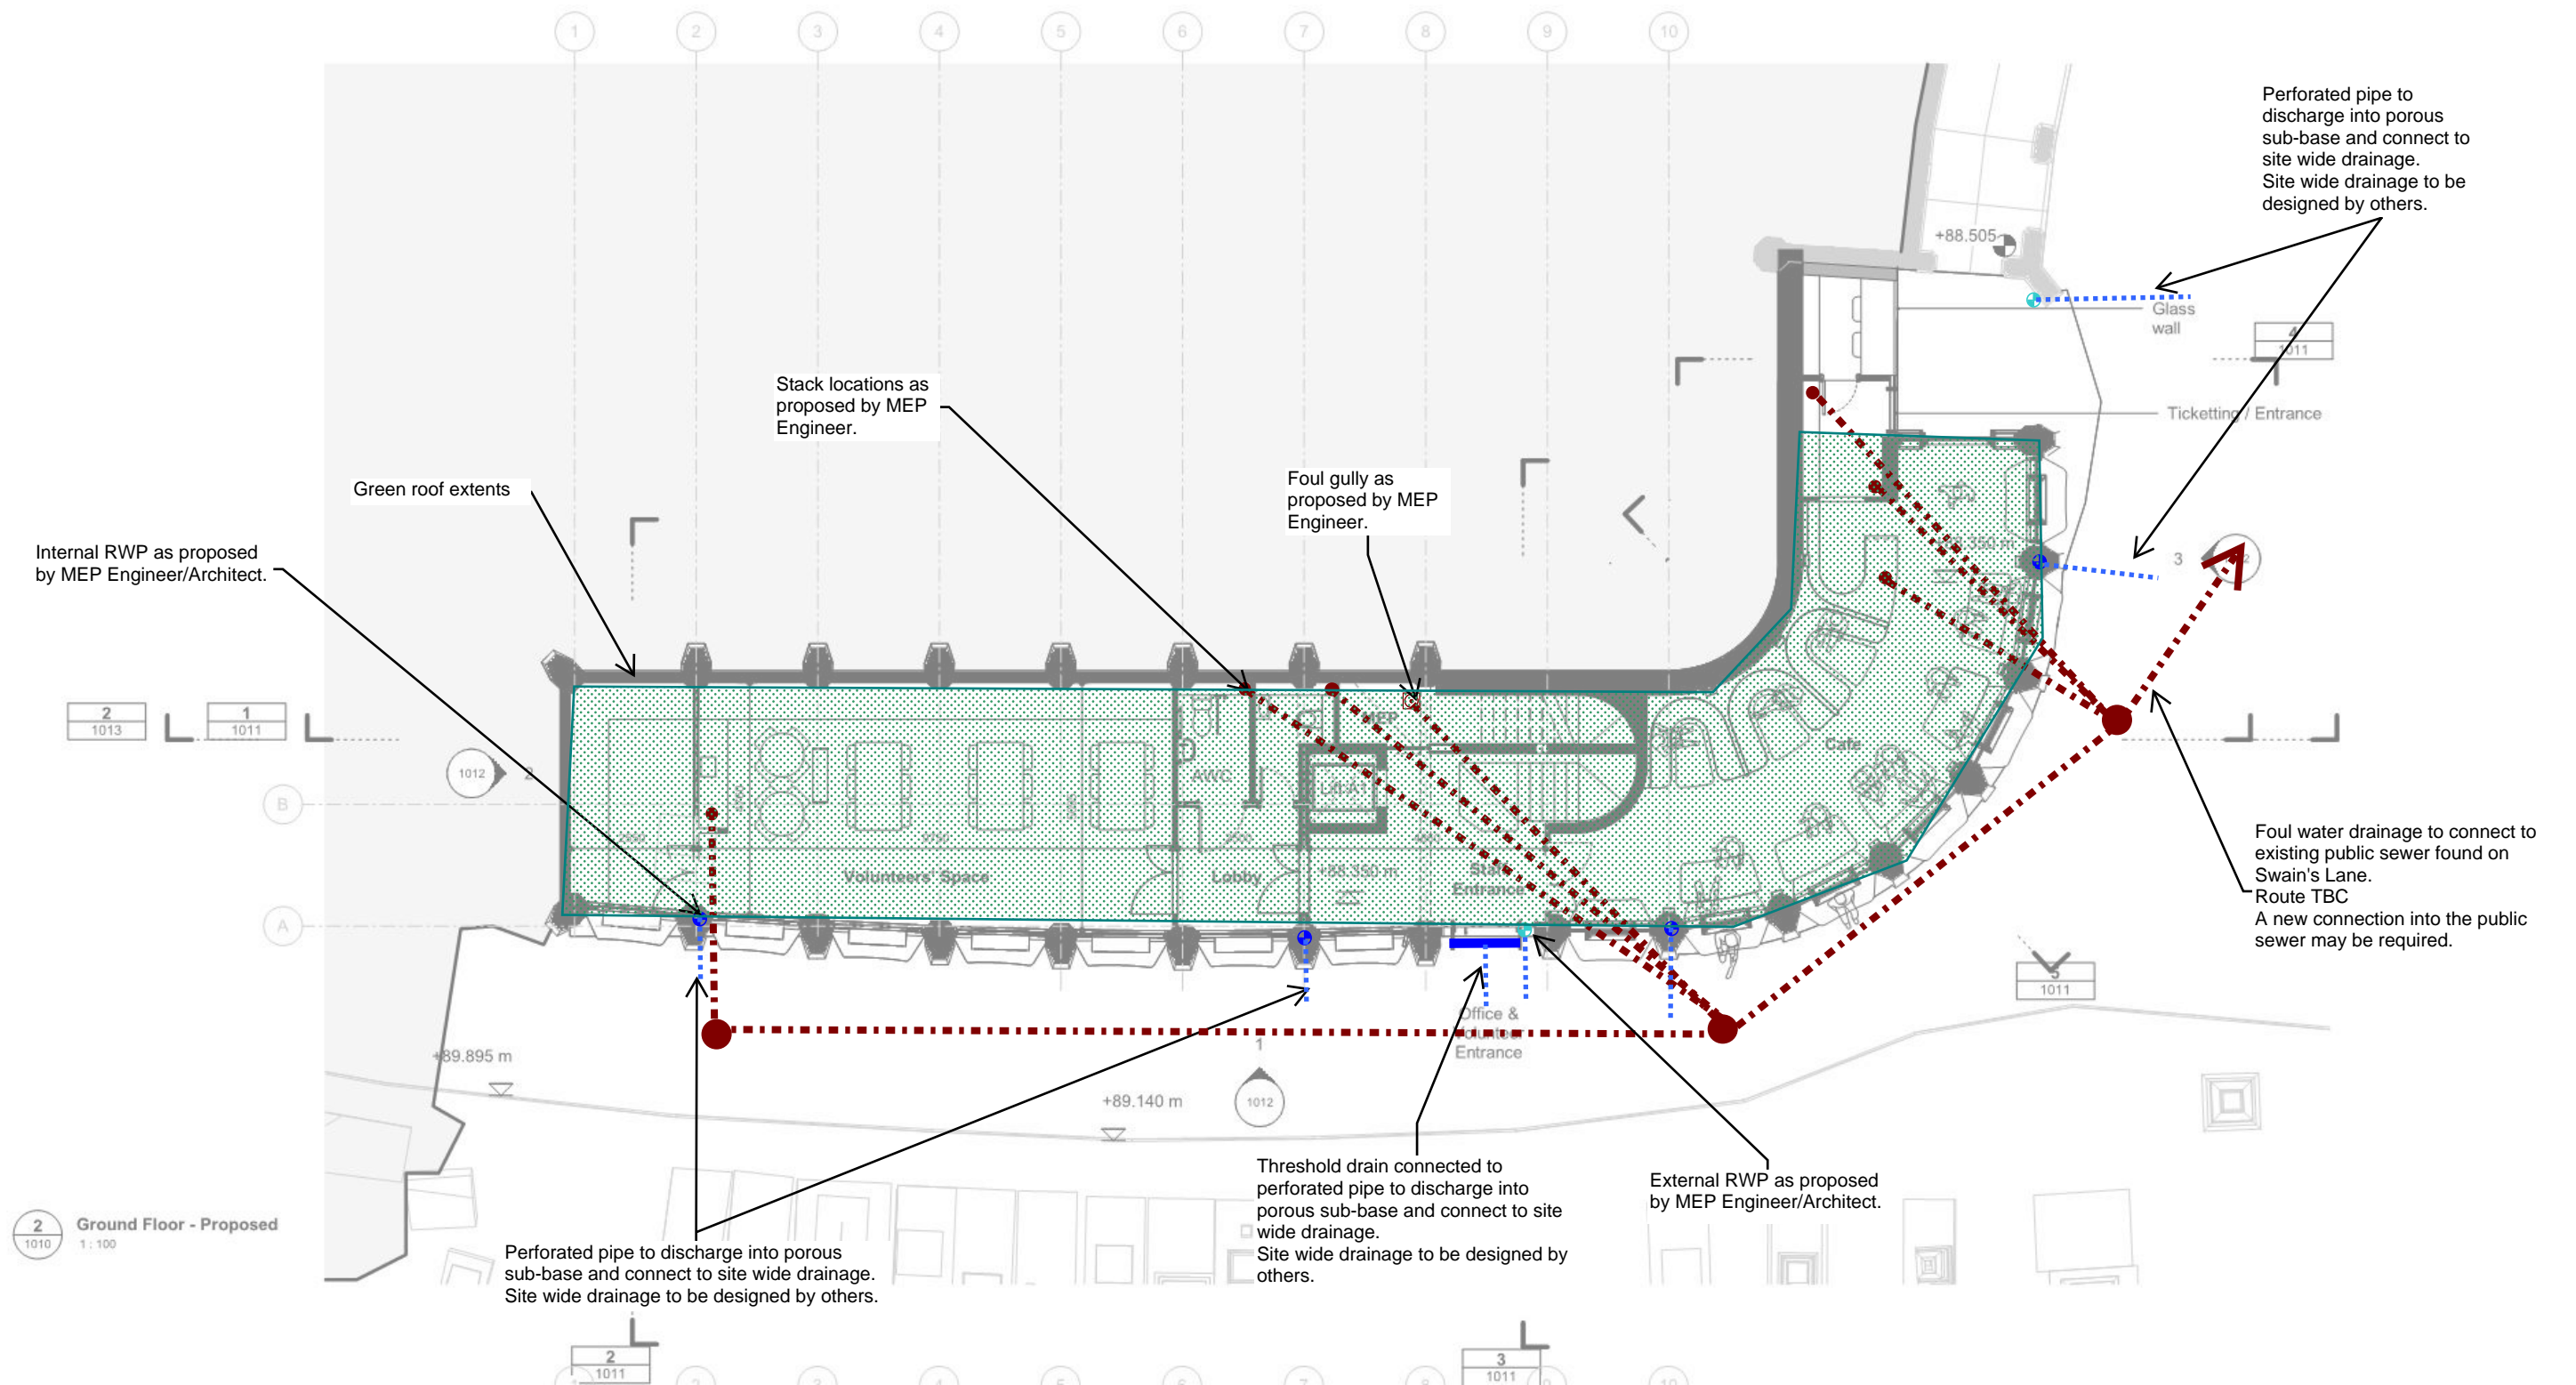

**WEBB
YATES** ENGINEERS

020 3696 1550
london@webbyates.com
www.webbyates.com

Drawing No. J4565-C-SK-0003			
Project Highgate Cemetery			Status S3
Drawing Title P2 - Ground Floor - Operations and visitor building			
Date 03.07.24	Drawn by ZA	Scale NTS	Revision DRAFT

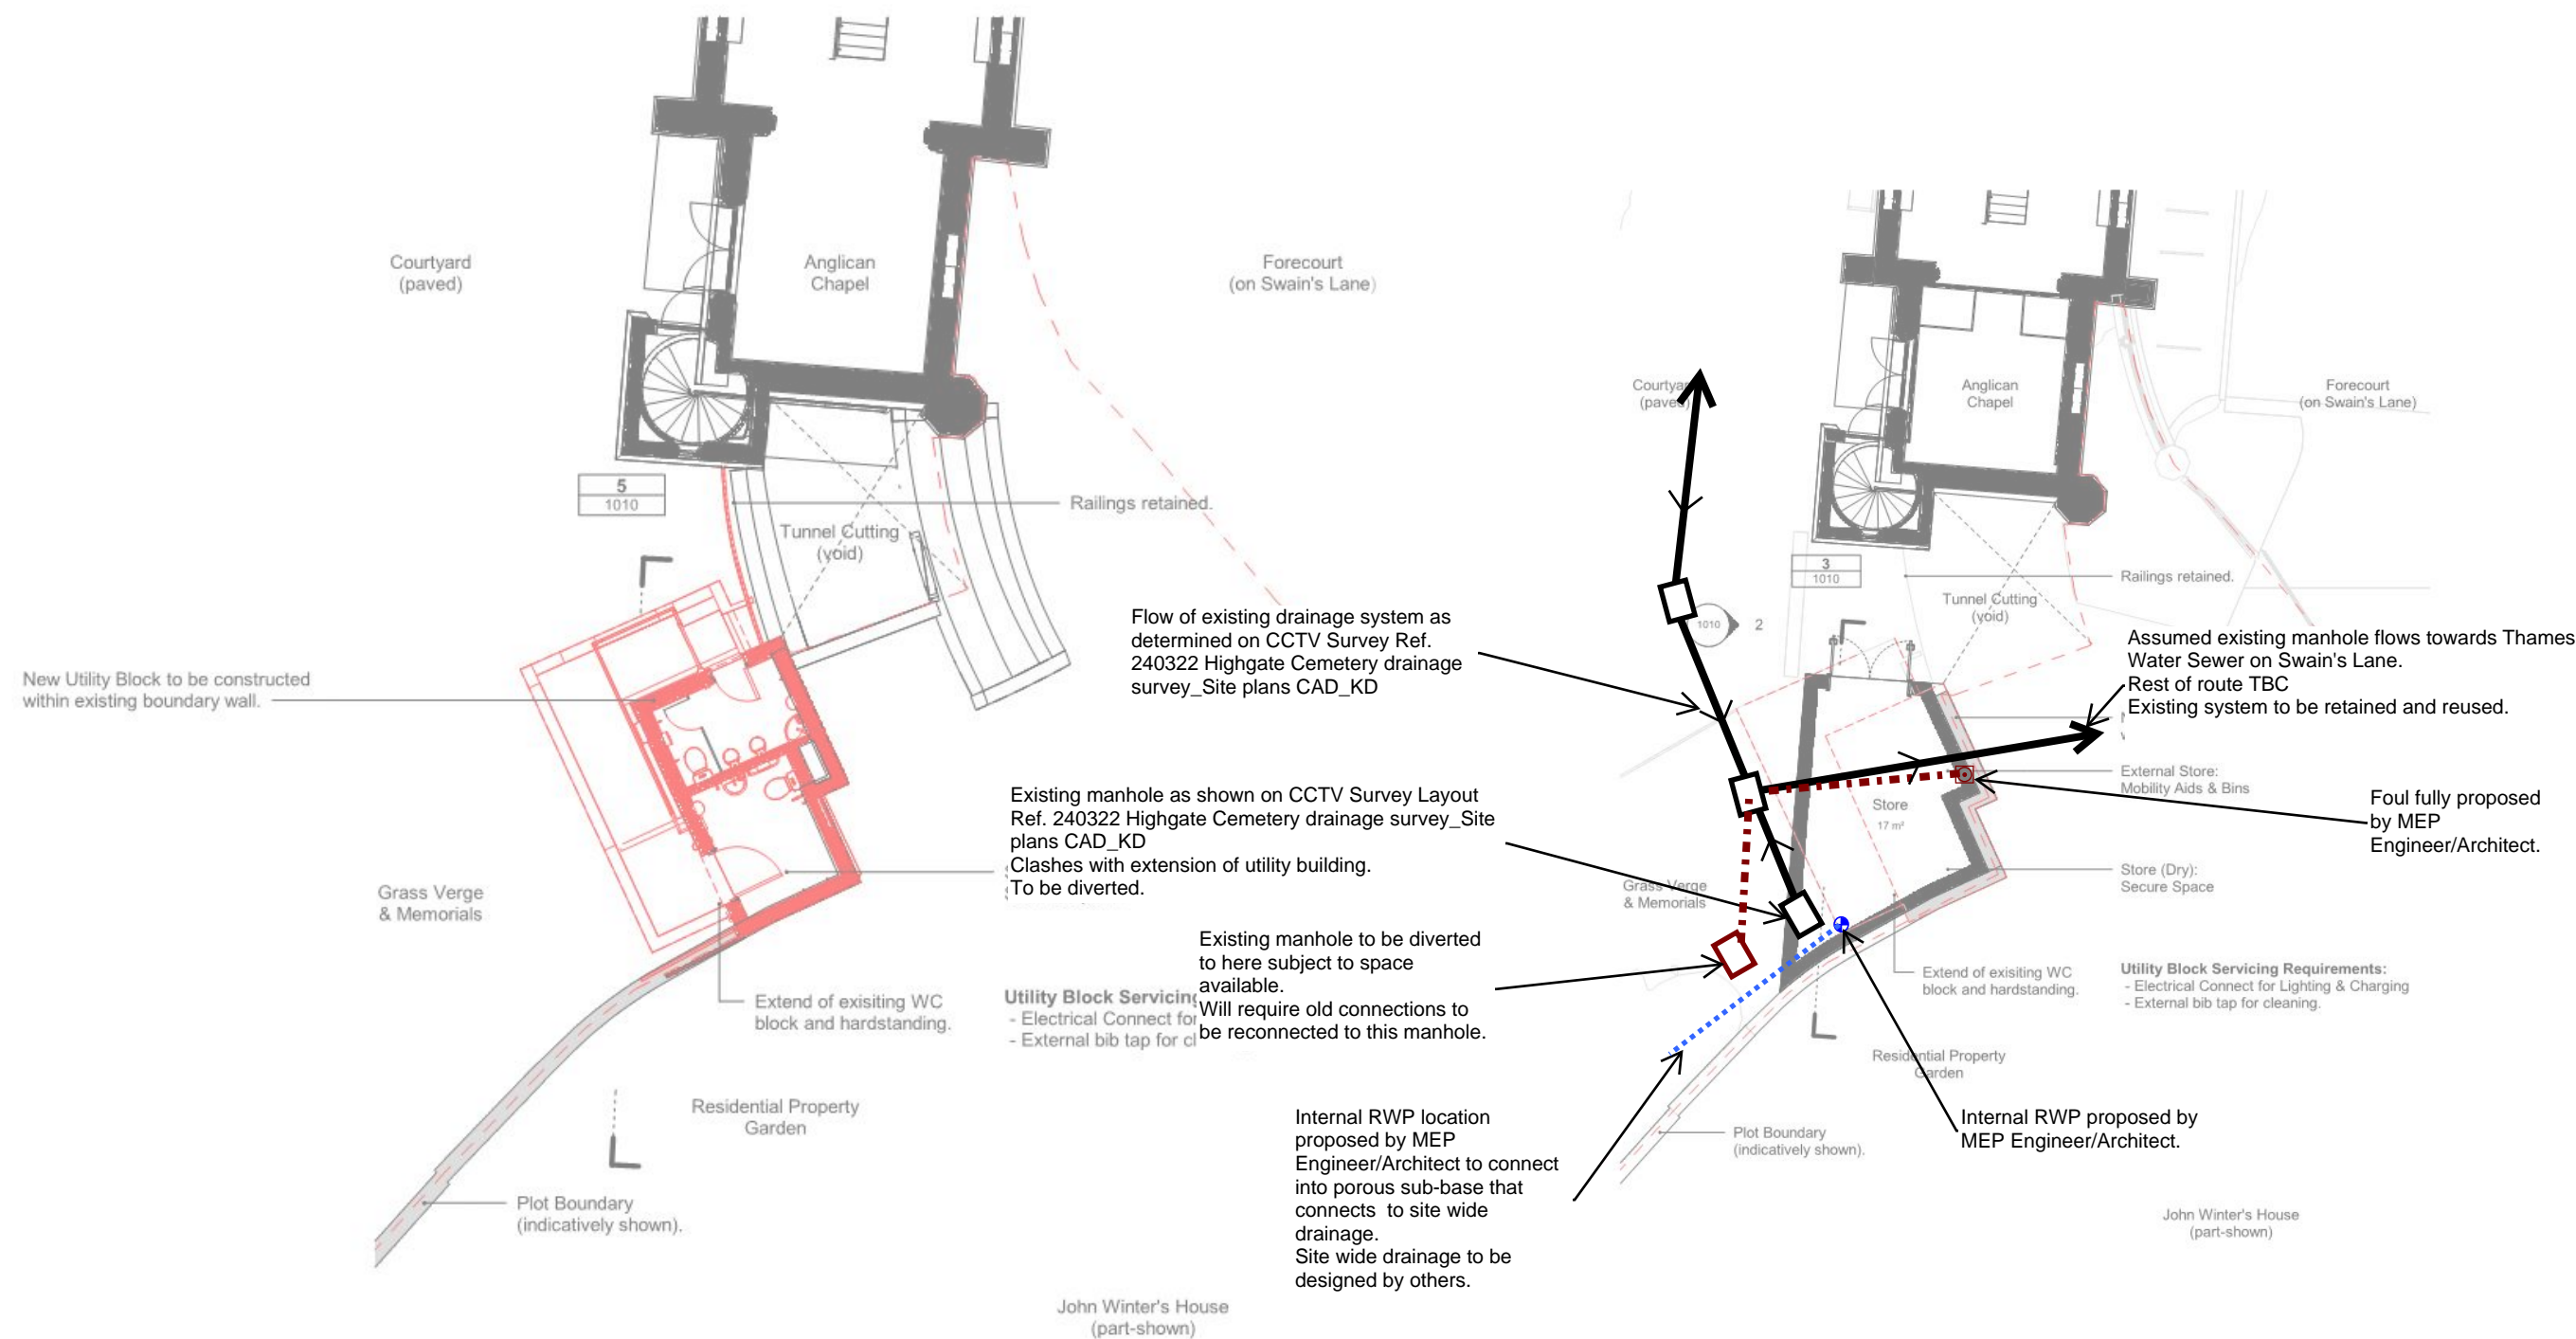

**WEBB
YATES** ENGINEERS

020 3696 1550
london@webbyates.com
www.webbyates.com

Drawing No.
J4565-C-SK-0004

Project
Highgate Cemetery

Drawing Title
P4 - Utility Block


Date
03.07.24

Drawn by
ZA

Scale
NTS

Revision
DRAFT

Status
S3

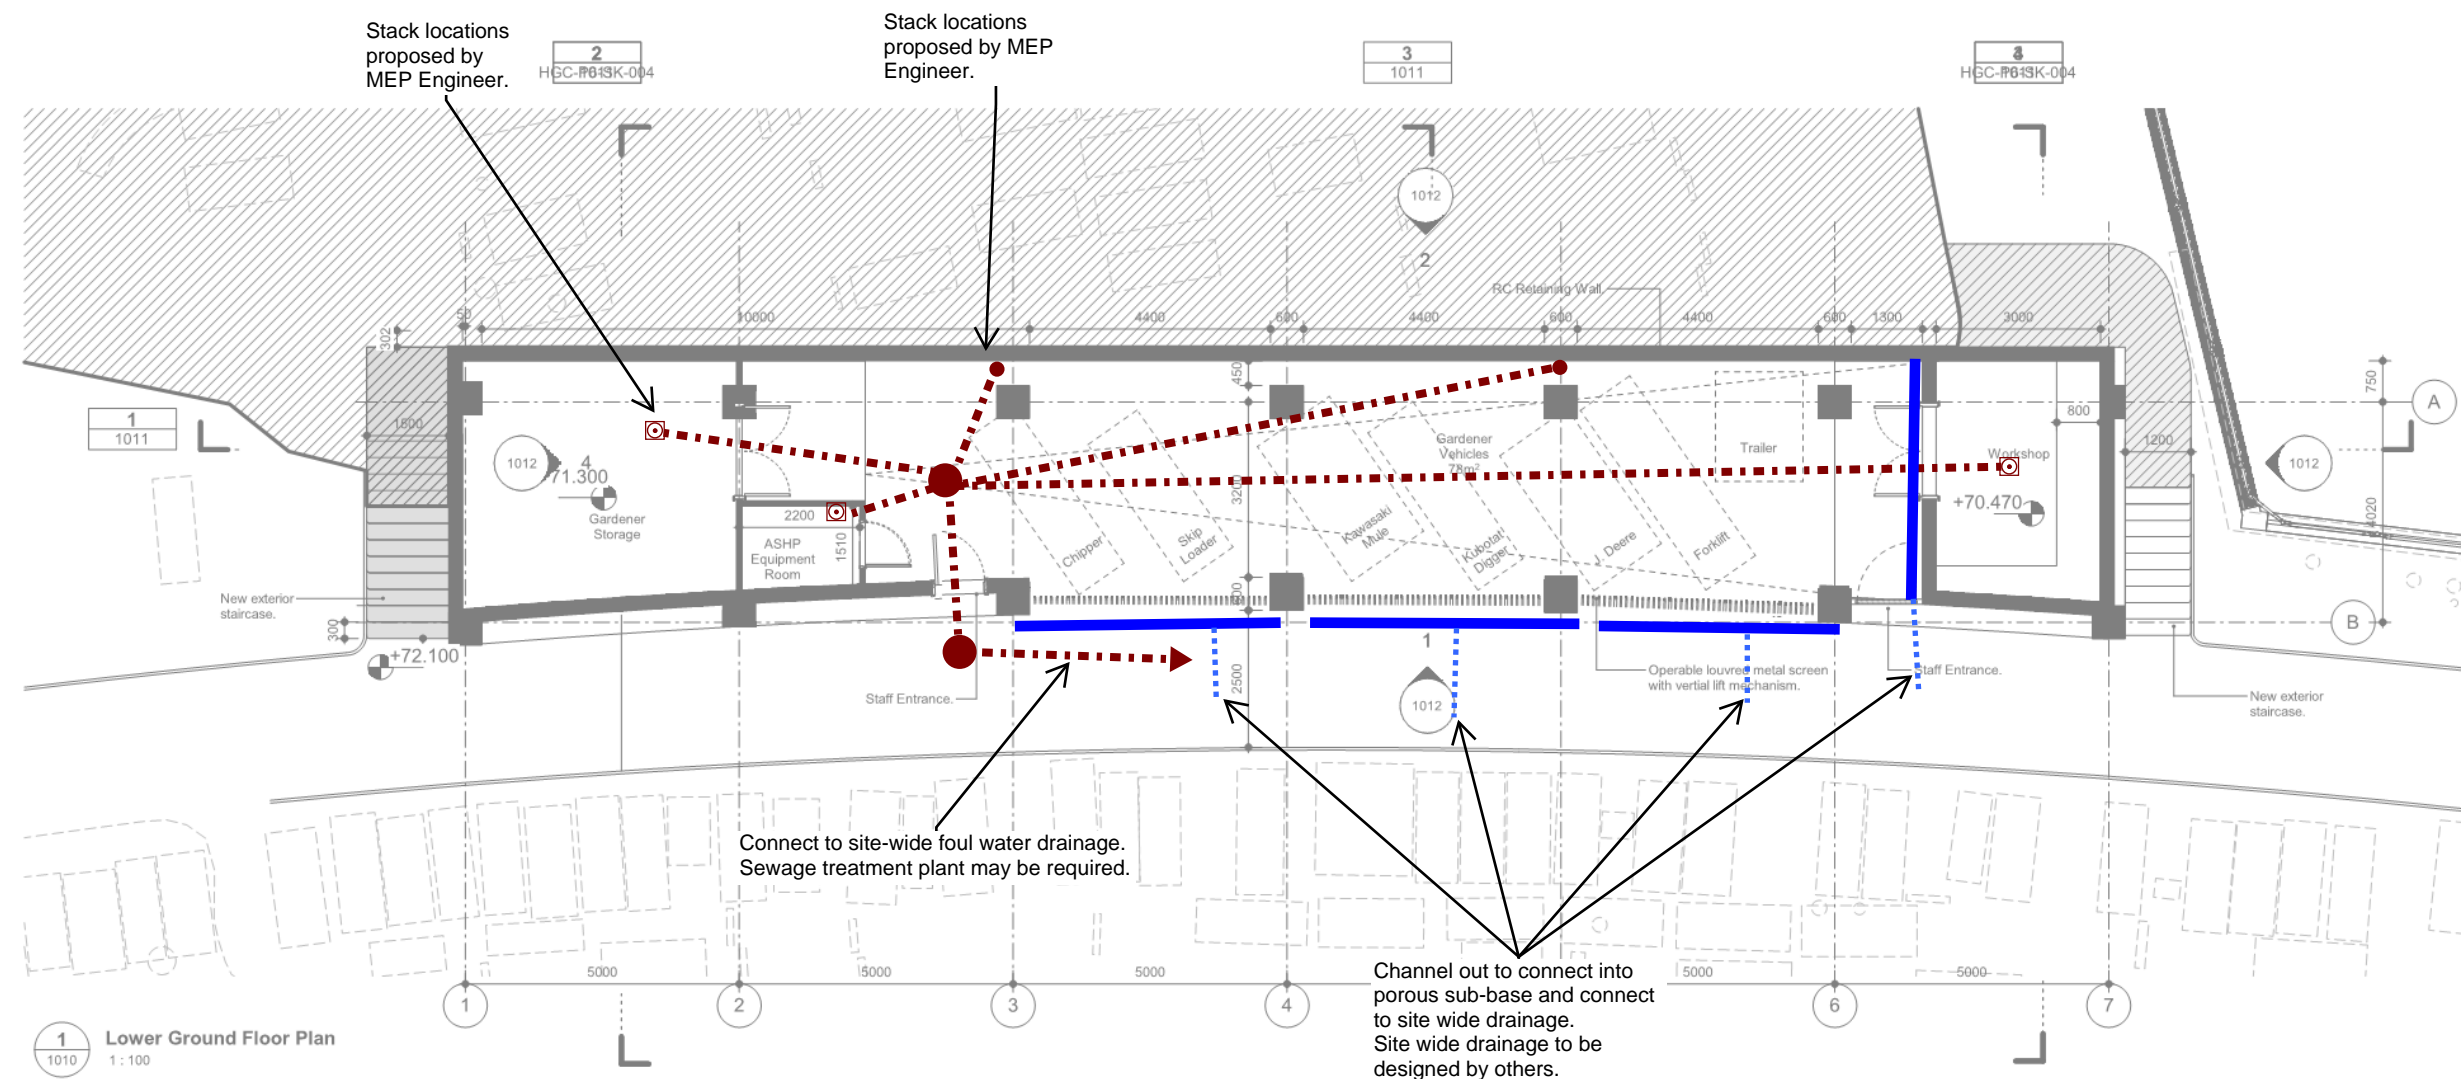

**WEBB
YATES** ENGINEERS

020 3696 1550
london@webbyates.com
www.webbyates.com

Drawing No. J4565-C-SK-0005			
Project Highgate Cemetery			Status S3
Drawing Title P6 - Basement - Gardeners building			
Date 03.07.24	Drawn by ZA	Scale NTS	Revision DRAFT

APPENDIX D. EXISTING DRAINAGE AND GROUND INVESTIGATION REPORTS



Our ref: EJM/CH/20360~02

29th July 2021

Ross Macaskill
Artelia UK
High Holborn House
52-54 High Holborn
London WC1V 6RL

by email only: ross.macaskill@uk.arteliagroup.com

Dear Ross,

RE: HIGHGATE CEMETERY, SWAIN'S LANE, HIGHGATE, LONDON N6 6PJ

We have now received the final report from Albury SI. We had agreed to provide a summary report of the findings and we do so below.

The site investigation was carried out in June 2021 and involved 2No boreholes to depth and 10No trial pits to existing buildings across the site. A desk based study of the site and its history was also included.

The site historically was part of the 17thC Ashurst estate until the founding of the cemetery in the 1830's. There is no evidence of industrial use on the site and no contamination or hazardous waste was found during the investigation. There is also no evidence of UXO's in close proximity and the risk is considered small for any being on site.

Borehole 1 extended to a depth of 25m and revealed 200mm made ground over 4m of soft clay over London Clay formation to the base of the borehole. From nearby published data, the layer of London Clay is approximately 125m thick. Standpipes were installed in the boreholes to monitor long term water levels. Monitoring indicates that there is groundwater 2.5m below ground level which could be the result of a perched water table.

Borehole 2 also extended to a depth of 25m and revealed 1m of made ground over 1.5m soft clay over stiffer London Clay formation to the base of the borehole. Ground water in borehole 2 was recorded at 1.5 and 1.2m below ground level following return visits and 5m depth during drilling.

The trial pits exposed stepped brick footings and concrete strip foundations to the various buildings and structures as one would expect. The ground around these structures was generally made ground and water levels varied between 1.2m and 3.3m below ground level. Sections and photographs of the existing foundation arrangements are in the full report.

Laboratory testing was carried out to samples retrieved from the boreholes. The mechanical properties are included in the report which will provide data for foundation and pile design and retaining wall design.

The report concludes that traditional mass concrete foundations can achieve a permissible bearing pressure of 100kPa provided the foundations extend into the Clay formation and not the made ground. Considerations will be required in close proximity to trees where tree roots can cause volumetric change of shrinkable clay. To avoid risks of settlement or if the loads will apply greater pressures than 100kPa consideration of piled foundations will be necessary.

If basement structures are proposed, heave will need to be considered and allowed for. The report suggests that the underlying soils have moderate to high potential of heave occurring. Therefore if any overburden is removed, the ground will apply upwards pressure as heave recovery occurs so it will be necessary to consider ground anchors or suspended floor slabs with anti heave protection under.

The report has identified a perched water table across the site therefore any large excavations will need a dewatering system to manage the inflow of groundwater or a water exclusion system to prevent water entering the excavation. The permanent structure will also need to be designed to resist hydrostatic pressures.

RE: HIGHGATE CEMETERY, SWAIN'S LANE, HIGHGATE, LONDON N6 6PJ

Any buried concrete in contact with the ground should have a design sulphate class of DS-2.

A preliminary test of the ground for waste assessment has concluded that any materials removed from site can be disposed of as non hazardous waste. Regular testing of any excavated material will need to be carried out as excavations are ongoing.

If you have any comments or queries on the above then please do not hesitate to contact me.

Yours sincerely

For THE MORTON PARTNERSHIP LTD

A handwritten signature in blue ink, appearing to read 'Peter Corcoran', written over a light blue horizontal line.

PETER CORCORAN BSc (Hons) MICE CEng

If a building becomes architecture, then it is art. Clearly, if a building is not functionally and technically in order, then it isn't architecture either – it's just a building.
Arne Jacobsen


Mechanical Engineering
Lighting Design
Sustainable Design
Electrical Engineering

Copenhagen
London
Sydney
Hong Kong
New York

4th Floor Noland House, 12-13 Poland Street
London W1F 8QB, United Kingdom
CRN 08 63 62 80
t : +44 20 7734 1255
e : info@steensenvarming.com

BUILDING SERVICES

STEENSEN VARMING

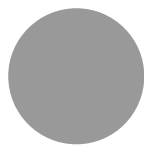

Highgate Cemetery M&E Infrastructure Review

Project No: 204057

London 23/11/2021
Project No. 204057

Tom Taylor
Associate Director

tom.taylor@steensenvarming.com

Document Revision and Status

Date	Rev	Issue	Notes	Checked	Approved
23/11/2021	01	Draft	For Comment	TT	TT

Table of Contents

1.0	Introduction	2
2.0	Services Overview.....	3
2.1	West Cemetery.....	3
2.2	East Cemetery	5
3.0	Findings in relation to masterplan proposals	7
3.1	Existing Services	7
3.2	Capacity to serve any new development	7
4.0	Appendix A – Existing Services Sketches	9
5.0	Appendix B – GRP Surveys.....	10

Disclaimers and Caveats:

Copyright © 2021, by Steensen Varming Pty Ltd.

All rights reserved. No part of this report may be reproduced or distributed in any form or by any means, or stored in a database or retrieval system, without the prior written permission of Steensen Varming Pty Ltd.

This document is confidential and contains privileged information regarding existing and proposed services for the Building. The information contained in the documents is not to be given to or discussed with anyone other than those persons who are privileged to view the information. Privacy protection control systems designed to ensure the highest security standards and confidentiality are to be implemented. You should only re-transmit, distribute or commercialise the material if you are authorised to do so.

Page 1 / 10

If a building becomes architecture, then it is art. Clearly, if a building is not functionally and technically in order, then it isn't architecture either – it's just a building.
Arne Jacobsen


Mechanical Engineering
Lighting Design
Sustainable Design
Electrical Engineering

Copenhagen
London
Sydney
Hong Kong
New York

4th Floor Noland House, 12-13 Poland Street
London W1F 8QB, United Kingdom
CRN 08 63 62 80
t : +44 20 7734 1255
e : info@steensenvarming.com

BUILDING SERVICES

STEENSEN VARMING

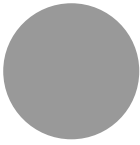

1.0 Introduction

Steensen Varming were appointed in November 2020 to undertake surveys and site investigations in order to establish the extent of existing services infrastructure at Highgate Cemetery.

Following an initial site visit and visual survey at the end of 2020 the project was paused before a follow up Ground Penetrating Radar (GPR) survey was completed in October 2021.

This report presents the findings from the initial non-intrusive visual survey and the follow up GPR survey. The report also includes some commentary with regards to the extent of the existing services and incoming supplies to the site in light of planned future development works. It should however be noted that Steensen Varming have not re-visited the site since late 2020 and as such the commentary included in this report with respect to the existing services relates to the findings from the initial site visit.

Sketches summarising the existing services and the full GPR survey results are included as appendices to this report.

If a building becomes architecture, then it is art. Clearly, if a building is not functionally and technically in order, then it isn't architecture either – it's just a building.
Arne Jacobsen

Mechanical Engineering
Lighting Design
Sustainable Design
Electrical Engineering

Copenhagen
London
Sydney
Hong Kong
New York

4th Floor Noland House, 12-13 Poland Street
London W1F 8QB, United Kingdom
CRN 08 63 62 80
t : +44 20 7734 1255
e : info@steensenvarming.com

STEENSEN VARMING

2.0 Services Overview

The services as described below are marked on the existing services sketch and GPR survey information included in the appendices to this report.

2.1 West Cemetery

Water

There is a single incoming water supply to the West Cemetery at the North Lodge. The supply runs through the West Cemetery to serve the South Lodge and the Main Office/ Chapel. Additional pipework branches serve watering points along the route. A second supply runs parallel to the site supply to serve a private house adjacent to the cemetery grounds.

Electricity

There are three incoming electrical supplies (fed from Swain's Lane) to the West Cemetery feeding the Main Office/ Chapel; the South Lodge; and the North Lodge.



Figure 1 and 2 – Main Office Electrical Intake and Distribution Board



Figure 3 – South Lodge Electric Meter/ Distribution Board and Gas Meter

Secondary supplies are taken from the North Lodge intake to serve the Terrace Catacombs; the Julius Beer Mausoleum; and the Simpson Vault.



Figure 4 and 5 – North Lodge Electrical Distribution Board and Secondary Supply

Secondary supplies are taken from the Office/ Chapel intake to serve the adjacent WC block; the Colonnade; and the Gardener's Compound containers.



Figure 6 and 7 Electrical Distribution Boards in Colonnade and Gardener's Compound

As the above images show, the existing electrical installations vary in age and condition. The installation in the South Lodge is relatively new. The Main Office/ Chapel incoming supply and associated switchgear is considerably older (and difficult to access). The externally mounted 'secondary' distribution boards are generally in poor condition have been exposed to external conditions.

Gas

There are two gas supplies to the West Cemetery, one serving the South Lodge via an internal meter (Figure 3) and one serving the Office/ Chapel via an external gas meter (Figure 8).



Figure 8 – Main Office/ Chapel Gas Meter

The existing supplies which are typical for domestic installations each serve a single gas boiler. The supplies are fed from a gas main in Swain's Lane.

BT/ Fibre

A BT supply fed from Swain's Lane serves the Main Office/ Chapel.

Drainage

Refer to GPS survey results for details of surface, foul and combined drains.

2.2 East Cemetery

Water

A single incoming supply serves the East Cemetery. The supply enters the site at the Chester Road entrance from where it runs through the site to serve the Gardener's Compound, branching off to serve various watering points along the route.

Electricity

There are two electrical supplies to the East Cemetery.

A relatively new 3-phase supply has been installed at the Chester Road entrance.

An older single-phase supply feeds an external electrical intake adjacent to the Strathcona. The external intake in turn supplies the Strathcona, the Entrance Kiosk, and the East Cemetery Gardener's Compound.



Figure 9 and 10 – Strathcona Electrical Intake

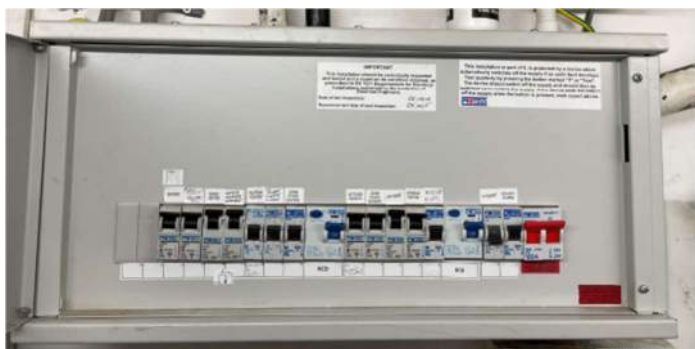


Figure 11 – East Cemetery Gardener's Compound Distribution Board

If a building becomes architecture, then it is art. Clearly, if a building is not functionally and technically in order, then it isn't architecture either – it's just a building.
Arne Jacobsen

Mechanical Engineering
Lighting Design
Sustainable Design
Electrical Engineering

Copenhagen
London
Sydney
Hong Kong
New York

4th Floor Noland House, 12-13 Poland Street
London W1F 8QB, United Kingdom
CRN 08 63 62 80
t : +44 20 7734 1255
e : info@steensenvarming.com

STEENSEN VARMING

Gas

There is no gas supply to the East Cemetery.

BT/ Fibre

A BT supply fed from Swain's Lane serves the Entrance Kiosk.

Drainage

Refer to GPS survey results for details of surface, foul and combined drains.

3.0 Findings in relation to masterplan proposals

It is understood that the main area of interest in terms of future development plans is the area identified as 'Project Area 01' on the existing services sketch in Appendix A which comprises the Main Office and Chapel; the Colonnade; and the courtyard in between.

The existing services in the vicinity of Project Area 01 are of interest with respect to both potential clashes with the any new development works and the potential to meet the services demands of any new development.

3.1 Existing Services

The site survey sketch and GRP survey outputs in the appendices show that there are multiple services running below ground within the courtyard area including electrical feeds from the main office building to the WC Block, Colonnade and Gardener's Compound; and a combined sewer. In addition, there are several unidentified traces.

Whilst there are multiple services running below ground, the GPR survey results suggest that these services generally run around the perimeter of the courtyard, and that the central courtyard area is relatively free from any existing services that could potentially be impacted by any excavation works with the main incoming electrical and gas supplies to the site are fed from Swain's Lane and stop short of the courtyard.

3.2 Capacity to serve new development

Water

The existing water supply to the Western Cemetery is fed through the site from the North Lodge.

Whilst the existing supply is understood to be sufficient to meet the existing water demand across the Western Cemetery, depending on the demands associated with any new development, it may be necessary to upgrade the supply which could mean renewing the existing pipework from the point of entry to the site at the North Lodge. Alternatively, it may be possible to install local storage to help meet any peaks in demand that may be associated with any new development.

Electricity

There are two existing electrical supplies in the area of the proposed development works, one which serves the Main Office/ Chapel building, and one serving the South Lodge. Secondary supplies are taken from the Main Office/ Chapel intake to serve adjacent buildings and areas including the Colonnade and Gardener's Compound.

Whilst dependent on the extent of works, it is likely that any significant new build works would require a new electrical supply connection from Swain's Lane, with any significant works in the area of the Courtyard perhaps presenting the opportunity to upgrade and rationalise the existing electrical supply and local distribution in this area.

Whilst the extent of proposed works are unknown, it may be necessary to install a new 3-phase supply to serve any new development, particularly if there are likely to be significant electrical loads as may for example be associated with heat pumps or cooling equipment.

Gas

There are two existing gas supplies in the area of the proposed development works, one supplying the Main Office/ Chapel and one supplying the South Lodge. Both supplies and associated meters are as would be expected for a typical domestic installation.

If there is likely to be any significant gas demand associated with the new development, for example as may be expected of a commercial size gas boiler, or a commercial kitchen, it is likely that a new supply connection (from Swain's Lane) or an upgrade to one of the existing supplies would be required to meet the associated demand.

Drainage

A combined sewer runs behind the Main Office/ Chapel building. It is assumed that this sewer picks up foul and surface water drainage connections from the Main Office/ Chapel building, and the adjacent WC block before discharging to the public sewer in Swain's Lane.

Depending on the extent of any proposed development works, it may be possible to utilise the existing sewer, with alterations as may be required, to meet associated drainage demands.

If a building becomes architecture, then it is art. Clearly, if a building is not functionally and technically in order, then it isn't architecture either – it's just a building.
Arne Jacobsen

Mechanical Engineering
Lighting Design
Sustainable Design
Electrical Engineering

Copenhagen
London
Sydney
Hong Kong
New York

4th Floor Noland House, 12-13 Poland Street
London W1F 8QB, United Kingdom
CRN 08 63 62 80
t : +44 20 7734 1255
e : info@steensenvarming.com

STEENSEN VARMING

4.0 Appendix A – Existing Services Sketches

HIGHGATE CEMETERY
EXISTING SERVICES SKETCH - EAST CEMETERY

● WATERING POINTS
REFER TO GPS SURVEY
FOR DETAILS OF DRAINAGE
AND BT

METER KIOSK HOUSING
100A 3-PHASE SUPPLY TO
SERVE FUTURE GATE
INSTALLATION

INCOMING ELECTRICAL
SUPPLY

INCOMING WATER
SUPPLY AND METER

WATER STOP COCK

CHESTER ROAD ENTRANCE

PROJECT AREA 3:
GARDENER'S COMPOUND


STRATHCONA, ENTRANCE KIOSK AND
GARDENER'S COMPOUND SERVED FROM
STRATHCONA ELECTRICAL INTAKE

INCOMING
ELECTRICAL
SUPPLY AND
METER


STRATHCONA

ENTRANCE
KIOSK

ASSUMED ROUTE OF WATER
PIPEWORK TO GARDENER'S
COMPOUND

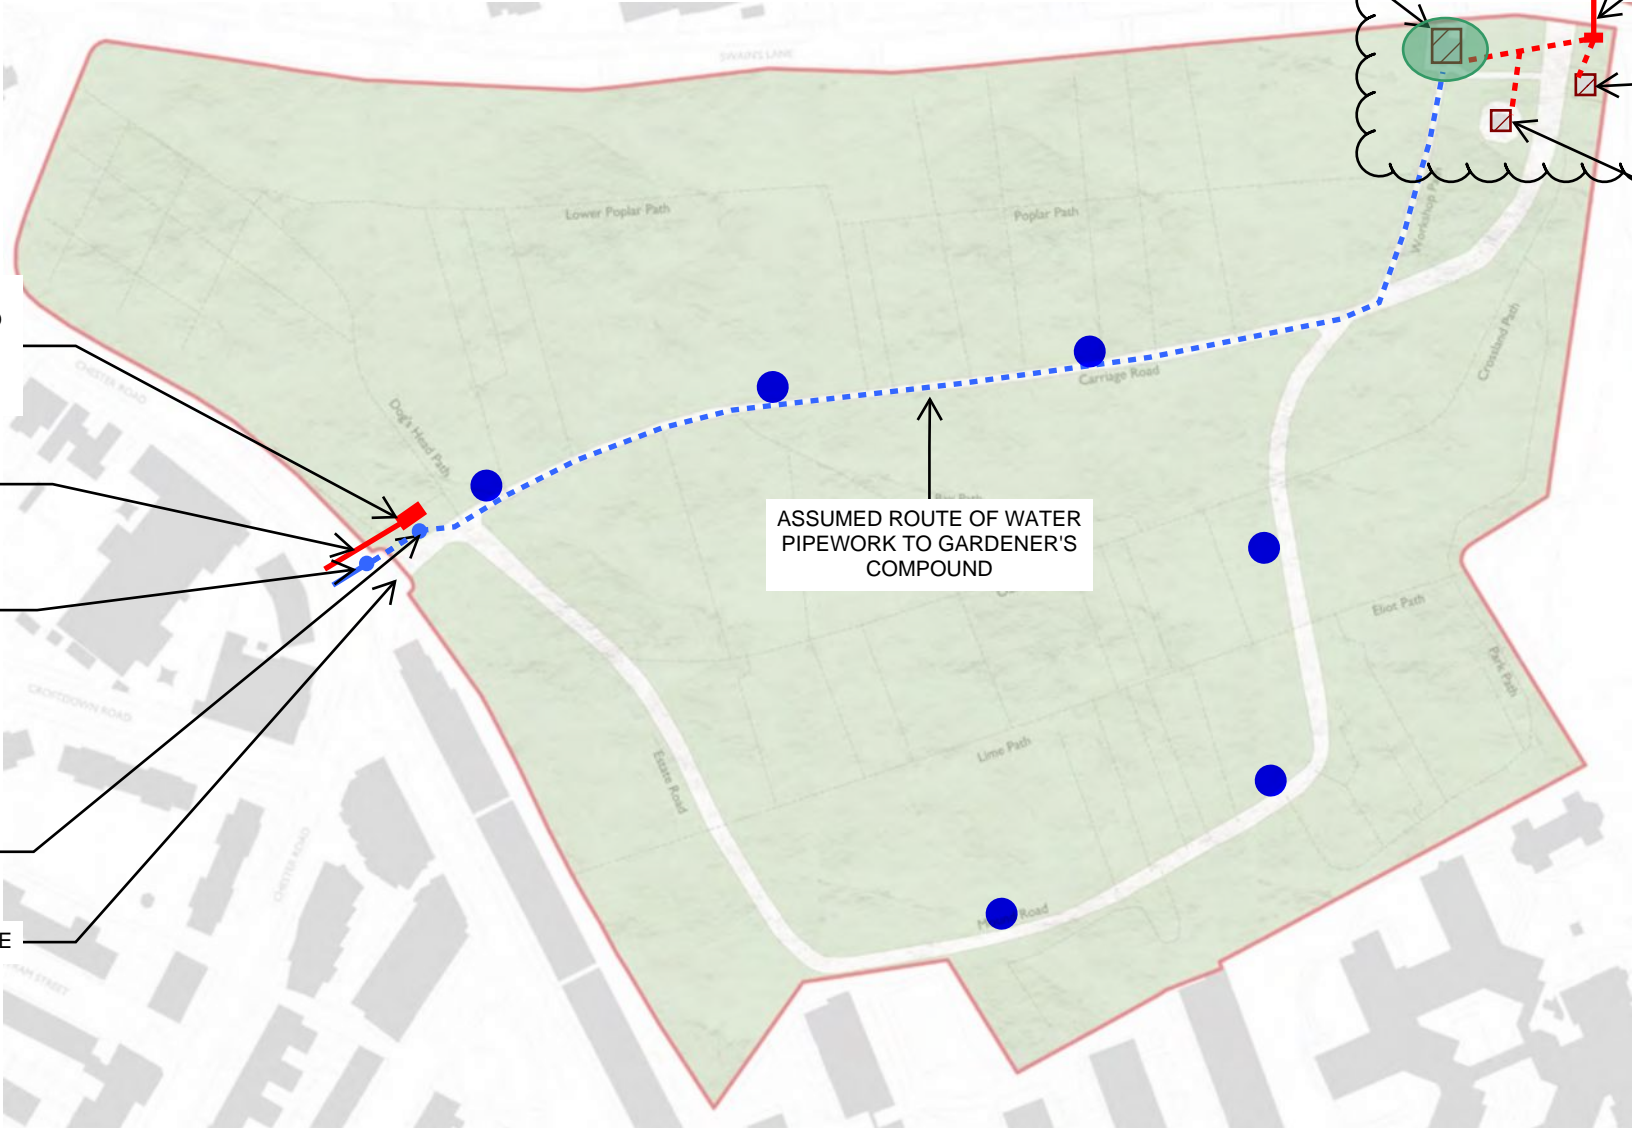

HIGHGATE CEMETERY
EXISTING SERVICES SKETCH - WEST CEMETERY

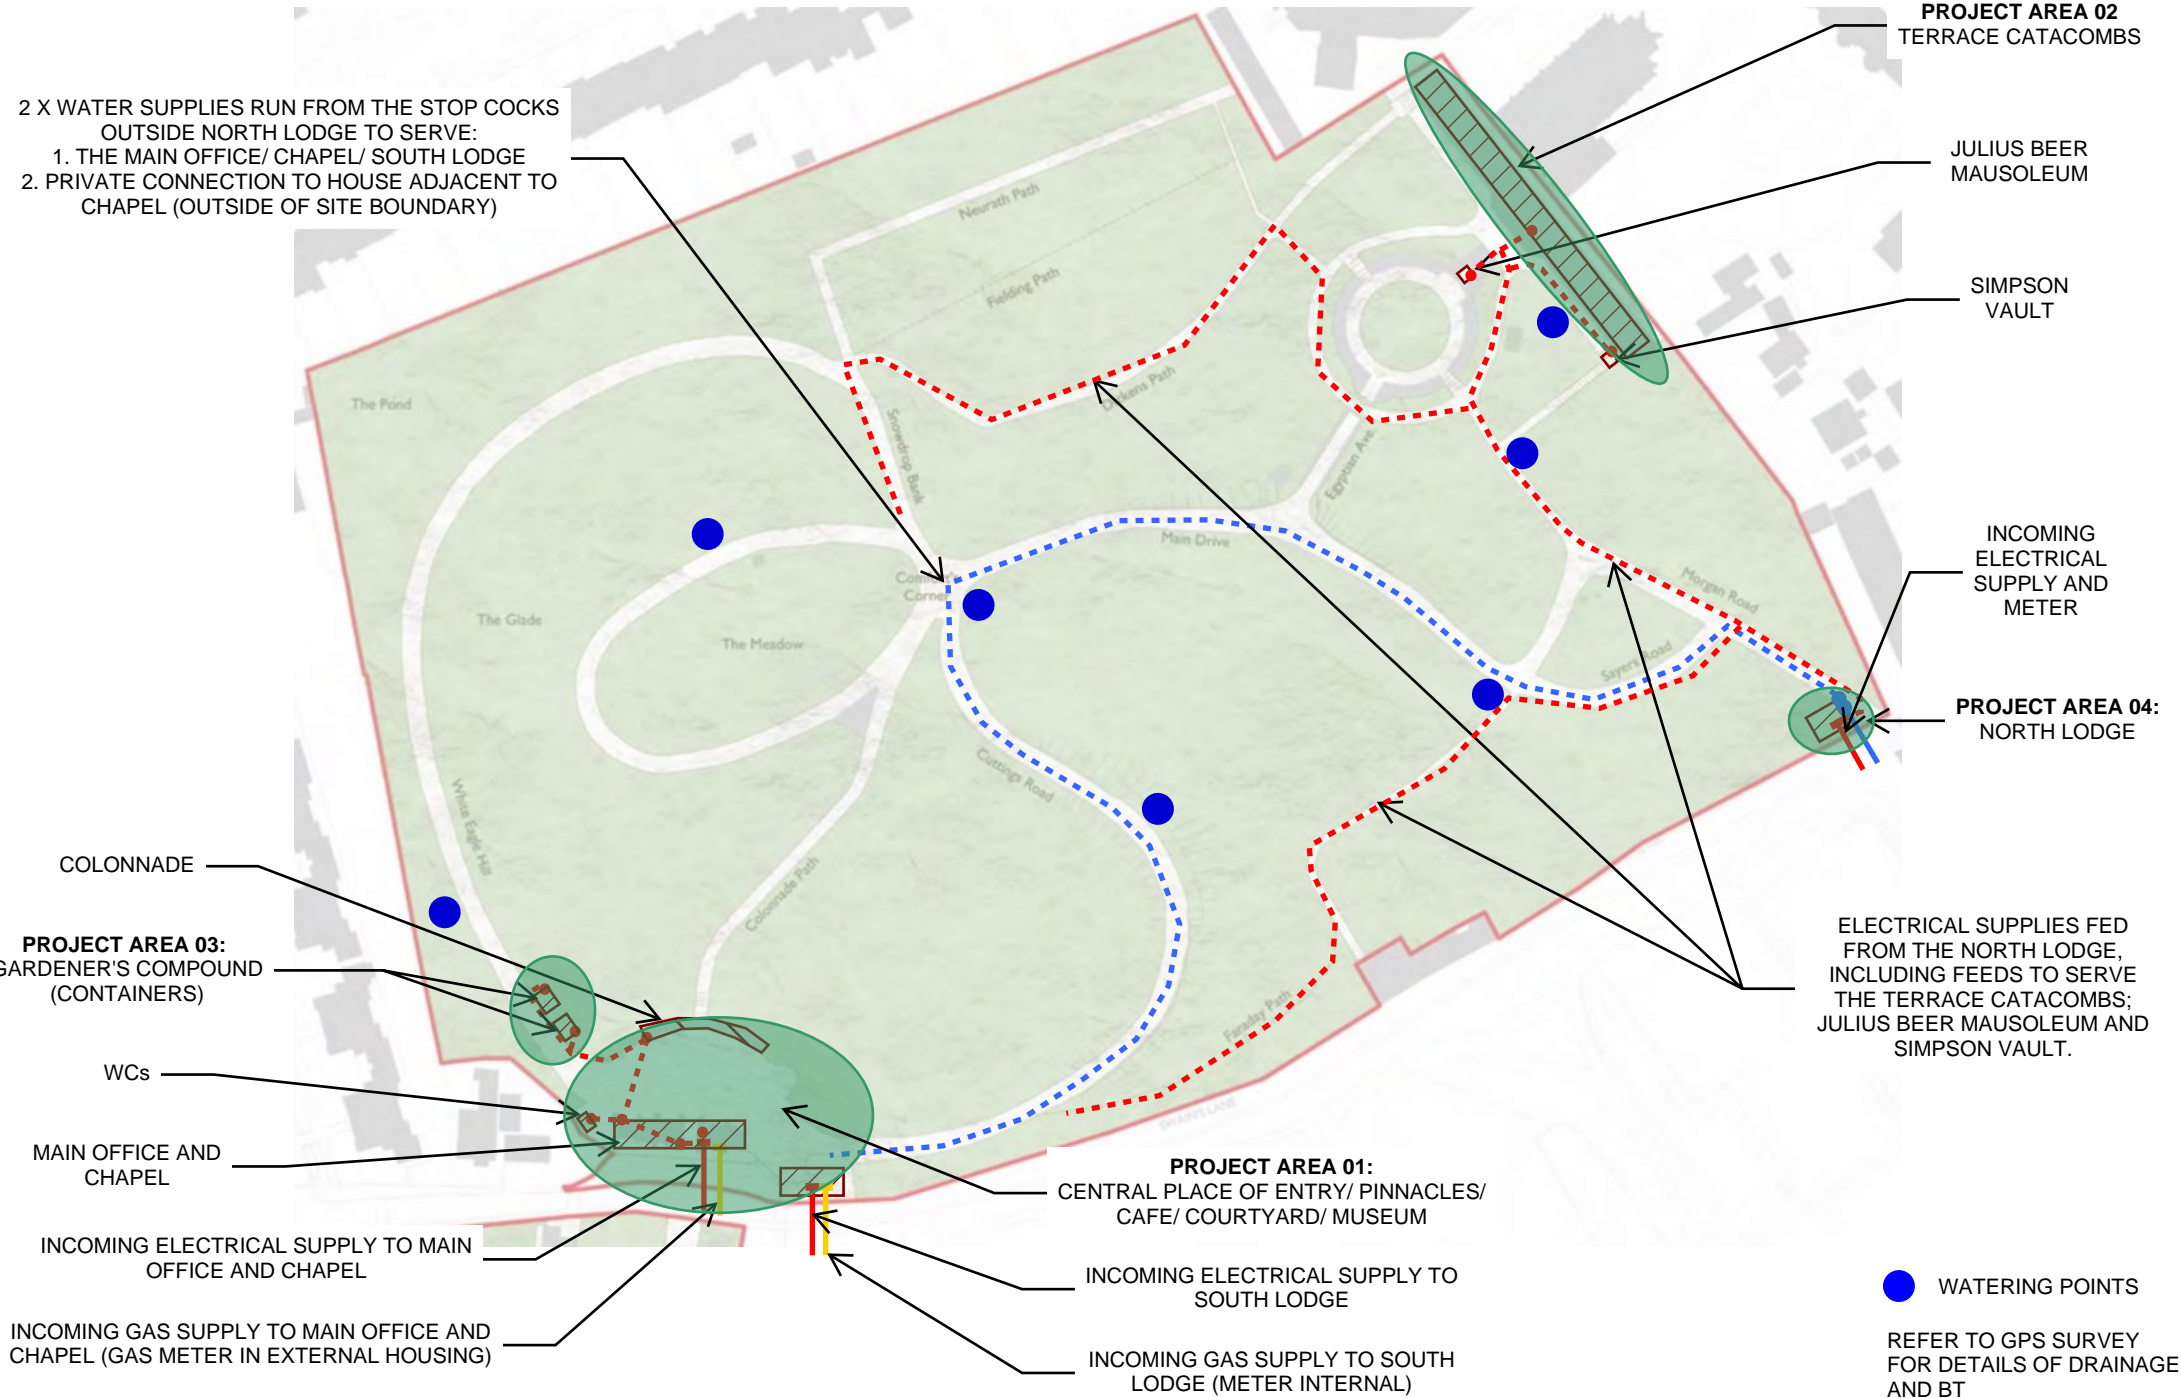

If a building becomes architecture, then it is art. Clearly, if a building is not functionally and technically in order, then it isn't architecture either – it's just a building.
Arne Jacobsen

Mechanical Engineering
Lighting Design
Sustainable Design
Electrical Engineering

Copenhagen
London
Sydney
Hong Kong
New York

4th Floor Noland House, 12-13 Poland Street
London W1F 8QB, United Kingdom
CRN 08 63 62 80
t : +44 20 7734 1255
e : info@steensenvarming.com

STEENSEN VARMING

5.0 Appendix B – GRP Surveys

[illegible]

Original Sheet Size Add


This survey has been carried out in accordance with PAS 128: 2014 & our version of the Royal Institution of Chartered Surveyors (RICS) specification for Measured Surveys of Land, Buildings and Utilities. Our survey extents have been agreed and confirmed with formal acceptance of 32482BWUG-01 from STEENSEN VARMING. If you have any queries regarding the final services layout, please may we ask you to carefully read all the information within this title block in its entirety before continuing to do so.

GENERAL SITE CONDITIONS	
BELOW AVERAGE	
ADDITIONAL INFORMATION	EFFECT ON SURVEY RESULTS
GRAVESTONES AND UNEVEN GROUND	SURVEYED WHERE POSSIBLE IN PATHS

LIST RECOMMENDATIONS TO IMPROVE SURVEY DATA

Due to the geophysical nature of subsurface technology, we always recommend excavation works to be carried out for verification, especially within critical areas.

We would suggest an up to date, more detailed and comprehensive topographical survey.

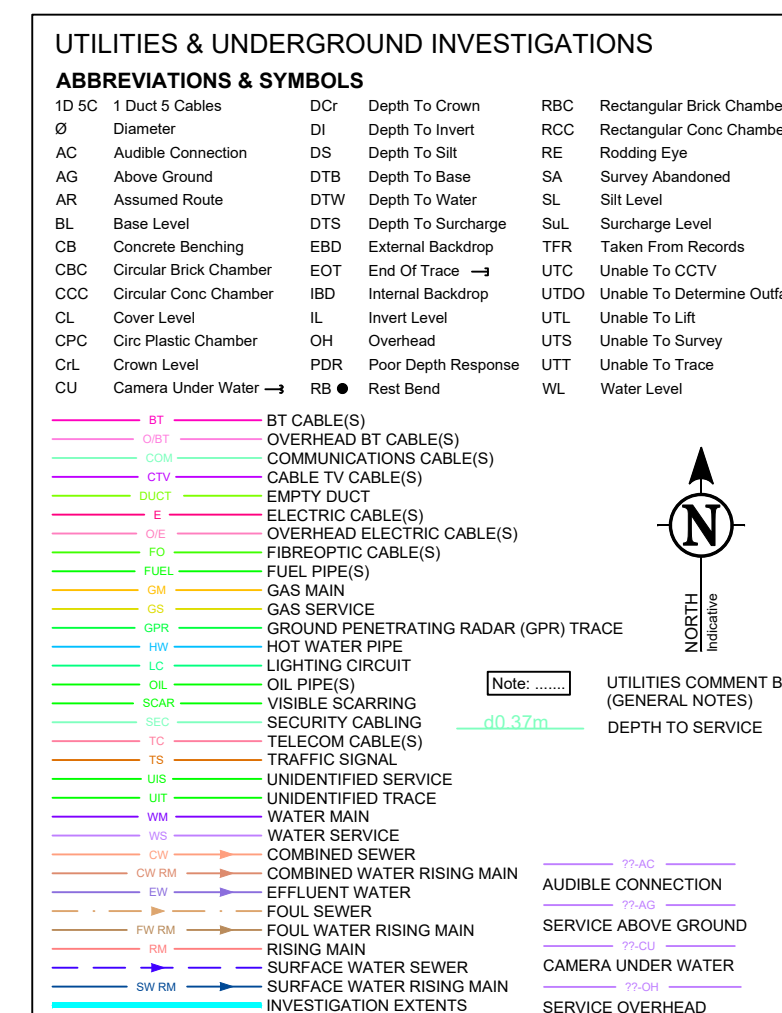

DRAWING NOTES

All below ground details shown have been identified from above ground without excavation. Survey Solution use electro-magnetic and/or ground penetrating radar (GPR) methods to investigate for underground utilities, services and features. Results using these methods are not infallible and we recommend trial excavation are carried out for verification of positions, depths and identification.

Any areas on the drawing where services or features have not been shown are not necessarily clear of services or features but are an indication that no items have been identified during our investigations. All reasonable care and normal good practice should still be employed during design and construction processes.

Certain types of services such as plastic or concrete pipes, some conduit and ducting where direct access can not be achieved for tracing may not be shown as alternative locating methods should be used.

Survey Solutions has used all reasonable care to research available service records but the completeness or use of the service records supplied to or by Survey Solutions cannot be guaranteed. Therefore Survey Solutions cannot be held responsible for any features annotated as 'taken from records' (TFR).

Depths obtained using electro-magnetic or GPR are effected by ground conditions and should be treated as indicative only. Electro-magnetic depths to utilities and services are generally taken to the centre of a feature, GPR depths to the top of a feature and drainage depth shown to inverts, unless otherwise indicated.

Drainage pipe sizes will be obtained without entering the chamber and therefore should be treated as approximate. Pipe dimensions which have not been obtained visually will be taken from records when available.

All services, drainage and utilities routes are assumed straight between access points, unless otherwise stated. The numbers of cables in runs will not be shown unless specifically requested. All services are below ground unless indicated.

Services, utilities and features may not have been surveyed if obstructed or not reasonably visible or accessible at the time of survey.

Survey Solutions accept no responsibility for the completeness or accuracy of either the topographical survey or base mapping on this project.

All critical dimensions and measurements should be checked and verified with an errors or discrepancies notified to Survey Solutions immediately. The accuracy of

The contractor must check and verify all site and building dimensions, levels, utilities and drainage details and connections prior to commencing work.

© Land Survey Solutions Limited hold the copyright to all the information contained within this document and their written consent must be obtained before copying or using the data other than for the purpose it was originally supplied.

DESKTOP UTILITY RECORDS (PAS 128: 2014 SURVEY TYPE D)		
PREREQUISITE FOR PAS 128: 2014 SURVEY TYPE B		
COMMISSIONED: NO		
UTILITY	AVAILABILITY	UTILITY COMPANY PROVIDER
SEWER	NO	N/A
WATER MAIN	NO	N/A
GAS MAIN	NO	N/A
TELECOM	PUBLIC	BRITISH TELECOMS
CABLE TV	NO	N/A
ELECTRICITY	NO	N/A
OIL PIPES	NO	N/A
OTHER	NO	N/A

Q-LEVEL	DESCRIPTION	ACC	Q-LEVEL	DESCRIPTION
Q-L-0	Remove practices listed from records.	Unaffected	Q-L-1	Remove internal incident logging only into background checks.
Q-L-2	Verify existence of service existence and accessibility to organizational technology.	Unaffected	Q-L-31	Reformat & validate backup software using multiple methods.
Q-L-34	Indefinite service present through out an assumed time (48h)	Unaffected	Q-L-A	Reformat & validate practice verification by types (external, internal and/or specific practices).
Q-L-35	Reformat existing into a new practice/technology but not the data.	Unaffected		

DETECTION METHOD

DRAINAGE SURVEY
All accessible Manholes and Inspection chambers have had their respective covers lifted with pipe sizes, inverts, chamber sizes/types and service data recorded from ground level. All connections from DP's, Gullies, Drains, VP's, RE and lampholes have been proven wherever possible using audible connections (AC) and/or sonde instrumentation where applicable. Where these methods have proved unsuccessful then assumed (AR) straight line connectors will be shown.

CCTV DRAINAGE SURVEY
All accessible Manholes and Inspection chambers have had their respective covers lifted with pipe sizes, Inverts, chamber sizes/type and service data recorded from ground level. Pipework has been traced, accessed and collected for post processing. Drainage layout, including manhole covers not located by topographical survey, may be taken from CCTV chainage and will be shown as indicative only.

Electricity
Elec cables will have been predominantly located using EML methodology with electronically derived depths shown. GPR techniques will be employed to achieve greater quality levels as required.

British Telecoms
BT cables will have been predominantly located using EMI methodology with electronically derived depths shown. GPR techniques will be employed to achieve greater quality levels as required. Due to current laws and legislation protecting all BT apparatus, cabling can only be located remotely. We therefore compare all our telecom findings against record information to produce the final service layout. In some instances, where high amount of cable ducts are present we may only be able to identify a linear centre peak signal rather than identifying all the individual duct positions. For further information regarding Telecoms apparatus, please contact Openreach directly.

Cable TV & Communications
CTV and/or Com cables will have been predominantly located using EML methodology with electronically derived depths shown. GPR techniques will be employed to achieve greater quality levels as required.

Fibre Optic
FD cables will have been predominantly located using GPR methodology. This is due to the materials used within fibre optic cabling. In some rare instances, trace cabling or conductive non fibre optic cabling will be present within some or all ducting. When this is the case, both EML and GPR methodology will be combined to identify service network and achieve greater quality levels.

Lighting, Traffic Signal & Security Cables
LC, TS and/or Sec cables will have been predominantly located using EML methodology with electronically derived depths shown. GPR techniques will be employed to achieve greater quality levels as required.

Gas & Water Inc. Fuel Pipes and Hot Water Pipes

GM/GS and/or VMWWS pipe work will have been attempted and located using both EML & GPR methodology with electronically derived depths shown for the former and depths to crown levels shown for the latter.

When the Gas/Water pipe work is constructed using conductive materials, then we are able to employ multiple geophysical techniques to identify service network and achieve greater quality levels. When a non conductive material is used, GPR methodology will be employed to locate and plot the final service layout.

Ground Penetrating Radar
GPR methodology is used to identify and locate all non metallic, non conductive piping and cabling. We also employ GPR to obtain a greater accuracy levels on EML locate services. The GPR has a greater success rate on pipe or service diameter upward of Ø63mm, C63mm, as size increments increase, so does the chance of detection. The GPR can produce varying results and as such, wouldn't be used as an independent utility surveying instrument.

Unidentified Traces
All UITS will have been predominantly located using EML methodology with electronically derived depths shown. GPR techniques will be employed to achieve greater quality levels as required. Every effort has been made to identify the service but in this instance, is not achievable. We recommend excavation work to determine identity and depth where applicable.

Scarring (OL-C)
Scarring has been identified on site with a potential of an undetectable service present.

Assumed Routes & Taken from Records (GL-B4/D)
Assumed routes (AR) are shown if there is evidence that a service exists but we are unable to trace it whilst on site. The surveyor will attempt to locate various risers/valves/meters (service evidence) etc. around site area to successfully determine an assumed route between these points. If there is little evidence on site but they believe a service is still present, then a common sense approach to an assumed route shall be employed.

Taken from records (TFR) are service routes that are taken from STAT record plans or previous survey information and overlaid onto our drawings.

© Land Survey Solutions Limited 01/01/2022

Original Sheet Size A/H

This survey has been carried out in accordance with PAS 128: 2014 & our version of the Royal Institution of Chartered Surveyors (RICS) specification for Measured Surveys of Land, Buildings and Utilities. Our survey extents have been agreed and confirmed with formal acceptance of 32482BWG-01 from STEENSEN VARMING. If you have any queries regarding the final services layout, please may we ask you to carefully read all the information within this title block in its entirety before continuing to do so.

GENERAL SITE CONDITIONS	
BELOW AVERAGE	
ADDITIONAL INFORMATION	EFFECT ON SURVEY RESULTS
GRAVESTONES AND UNEVEN GROUND.	SURVEYED WHERE POSSIBLE IN PATHS

LIST RECOMMENDATIONS TO IMPROVE SURVEY DATA

Due to the geophysical nature of subsurface technology, we always recommend excavation works to be carried out for verification, especially within critical areas.

We would suggest an up to date, more detailed and comprehensive topographical survey.

DETECTION METHOD
IN ACCORDANCE WITH PAS 128: 2014 SURVEY TYPE B

DRAINAGE SURVEY All accessible Manholes and Inspection chambers have had their respective covers lifted with pipe sizes, inverts, chamber sizes/types and service data recorded from ground level. All connections from DPs, Gullies, Drains, VP's, RE and lampholes have been proven wherever possible using audible connections (AC) and/or sonde instrumentation where applicable. Where these methods have proved unsuccessful then assumed (AR) straight line connections will be shown.

All accessible Manholes and Inspection chambers have had their respective covers lifted with pipe sizes, Inverts, chamber sizes/type and service data recorded from ground level. Pipework has been traced, accessed and collected for post processing. Drainage layout, including manhole covers not located by topographical survey, may be taken from CCTV chainage and will be shown as indicative only.

Electricity
Elec cables will have been predominantly located using EML methodology with electronically derived depths shown. GPR techniques will be employed to achieve greater quality levels as required.

British Telecoms BT cables will have been predominantly loaded using EML methodology with electronically derived depths shown. GPR techniques will be employed to achieve greater quality levels as required. Due to current laws and legislation protecting all BT apparatus, cabling can only be located remotely. We therefore compare all our telecom findings against recorded information to produce the final service layout. In some instances, where high amount of cable ducts are present we may only be able to identify a linear centre peak signal rather than identify all the individual duct positions. For further information regarding Telecoms apparatus, please contact Openreach directly.

Cable TV & Communications
CTV and/or Com cables will have been predominantly located using EML methodology with electronically derived depths shown. GPR techniques will be employed to achieve greater quality levels as required.

Fibre Optic: FD cables will have been predominantly located using GPR methodology. This due to the materials used within fibre optic cabling. In some rare instances, trace cabling or conductive non fibre optic cabling will be present within some or all ducting. When this is the case, both EML and GPR methodology will be combined to identify service network and achieve greater quality levels.

Lighting, Traffic Signal & Security Cables
LC, TS and/or Sec cables will have been predominantly located using EML methodology with electronically derived depths shown. GPR techniques will be employed to achieve greater quality levels as required.

Gas & Water Inc. Fuel Pipes and Hot Water Pipes
GMMGS and/or WMM/WS pipe work will have been attempted and located using both EML & GPR methodology with electronically derived depths shown for the former and depths to crown levels shown for the latter.
When the Gas/Water pipe work is constructed using conductible materials, then we are able to employ multiple geophysical techniques to identify service network and achieve greater quality levels. When a non conductible material is used, GPR methodology will be employed to locate and plot the final service layout.

Ground Penetrating Radar
GPR methodology is used to identify and locate all non metallic, non conductive piping and cabling. We also employ GPR to obtain a greater accuracy levels on EML locate services. The GPR has a greater success rate on pipe or service diameter upward of 263mm, C63mm, as size increments increase, so does the chance of detection. The GPR can produce varying results and as such, wouldn't be used as an independent utility surveying instrument.

Unidentified Traces
All UITS will have been predominantly located using EML methodology with electronically derived depths shown. GPR techniques will be employed to achieve greater quality levels as required. Every effort has been made to identify the service but in this instance, is not achievable. We recommend excavation work to determine identity and depth where applicable.

Scarring (QL-C)
Scarring has been identified on site with a potential of an undetectable service present.

Assumed Routes & Distances from Records (CL-B4(D))
Assumed routes (AR) are shown if there is evidence that a service exists but we are unable to trace it whilst on site. The surveyor will attempt to locate various risers/cavities/meters (service evidence) etc. around site area to successfully determine an assumed route between these points. If there is little evidence on site but they believe a service is still present, then a common sense approach to an assumed route shall be employed.

Taken from records (TFR) are service routes that are taken from STAT record plans or previous survey information and overlaid onto our drawings.

DRAWING NOTES

All below ground details shown have been identified from above ground without excavation. Survey Solution use electro-magnetic and/or ground penetrating radar (GPR) methods to investigate for underground utilities, services and features. Results using these methods are not infallible and we recommend trial excavations are carried out for verification of positions, depths and identification.

Any areas on the drawing where services or features have not been shown are not necessarily clear of services or features but are an indication that no items have been identified during our investigations. All reasonable care and normal good practice should still be employed during design and construction processes.

Certain types of services such as plastic or concrete pipes, some conduit and ducting where direct access can not be achieved for tracing may not be shown and alternative locating methods should be used.

Survey Solutions has used all reasonable care to research available service records but the completeness or use of the service records supplied to or by Survey Solutions cannot be guaranteed. Therefore Survey Solutions cannot be held responsible for any features annotated as 'taken from records' (TFR).

Depths obtained using electro-magnetic or GPR are effected by ground conditions and should be treated as indicative only. Electro-magnetic depths to utilities and services are generally taken to the centre of a feature, GPR depths to the top of a feature and drainage depth shown to inverts, unless otherwise indicated.

Drainage pipe sizes will be obtained without entering the chamber and therefore should be treated as approximate. Pipe dimensions which have not been obtained visually will be taken from records when available.

All services, drainage and utilities routes are assumed straight between access points, unless otherwise stated. The numbers of cables in runs will not be shown unless specifically requested. All services are below ground unless indicated.

Services, utilities and features may not have been surveyed if obstructed or not reasonably visible or accessible at the time of survey.

Survey Solutions accept no responsibility for the completeness or accuracy of either the topographical survey or base mapping on this project.

All critical dimensions and measurements should be checked and verified with any errors or discrepancies notified to Survey Solutions immediately. The accuracy of

The contractor must check and verify all site and building dimensions, levels, utilities and drainage details and connections prior to commencing work.

© Land Survey Solutions Limited hold the copyright to all the information contained within this document and their written consent must be obtained before copying or using the data other than for the purpose it was originally supplied.

Do not scale from this drawing.

DESKTOP UTILITY RECORDS (PAS 128: 2014 SURVEY TYPE D)		
PREREQUISITE FOR PAS 128: 2014 SURVEY TYPE B		
COMMISSIONED: NO		
UTILITY	AVAILABILITY	UTILITY COMPANY PROVIDER
SEWER	NO	N/A
WATER MAIN	NO	N/A
GAS MAIN	NO	N/A
TELECOM	PUBLIC	BRITISH TELECOMS
CABLE TV	NO	N/A
ELECTRICITY	NO	N/A
OIL PIPES	NO	N/A
OTHER	NO	N/A

GCV	FILED/REVIEW/CM	PURCHASE	MOOD	PLATE
-----	-----------------	----------	------	-------



SURVEY SOLUTIONS

LAND SURVEYING
BUILDING SURVEYING
UNDERGROUND SURVEYING
SITE ENGINEERING
MONITORING

0845 040 5969
survey-solutions.co.uk

PIMLICH BEDFORD COVENTRY GLASGOW LONDON MANCHESTER NORWICH
NOTTINGHAM YEOX

PROJECT TITLE
HIGHGATE CEMETERY, SWAINS LANE,
LONDON, N6 6PJ.

DRAWING DETAIL
UTILITIES AND DRAINAGE SURVEY.
SHEET 5 OF 8

CLIENT STEENSEN VARMING				SCALE 1:250
SURVEYOR LJT	SURVEY DATE 20/10/2021	CHECKED BY JAB	APPROVED BY GSB	DWG STATUS FINAL
DRAWING NUMBER 32482BWJG-05			REVISION	ISSUE DATE 28/10/2021




This survey has been carried out in accordance with PAS 128: 2014 & our version of the Royal Institution of Chartered Surveyors (RICS) specification for Measured Surveys of Land, Buildings and Utilities. Our survey extents have been agreed and confirmed with formal acceptance of 32482BWUG-01 from STEENSEN VARMING. If you have any queries regarding the final services layout, please may we ask you to carefully read all the information within this title block in its entirety before continuing to do so.

GENERAL SITE CONDITIONS BELOW AVERAGE	
ADDITIONAL INFORMATION	EFFECT ON SURVEY RESULTS
GRAVESTONES AND UNEVEN GROUND	SURVEYED WHERE POSSIBLE IN PATHS

LIST RECOMMENDATIONS TO IMPROVE SURVEY DATA

Due to the geophysical nature of subsurface technology, we always recommend excavation works to be carried out for verification, especially within critical areas.

We would suggest an up to date, more detailed and comprehensive topographical survey.

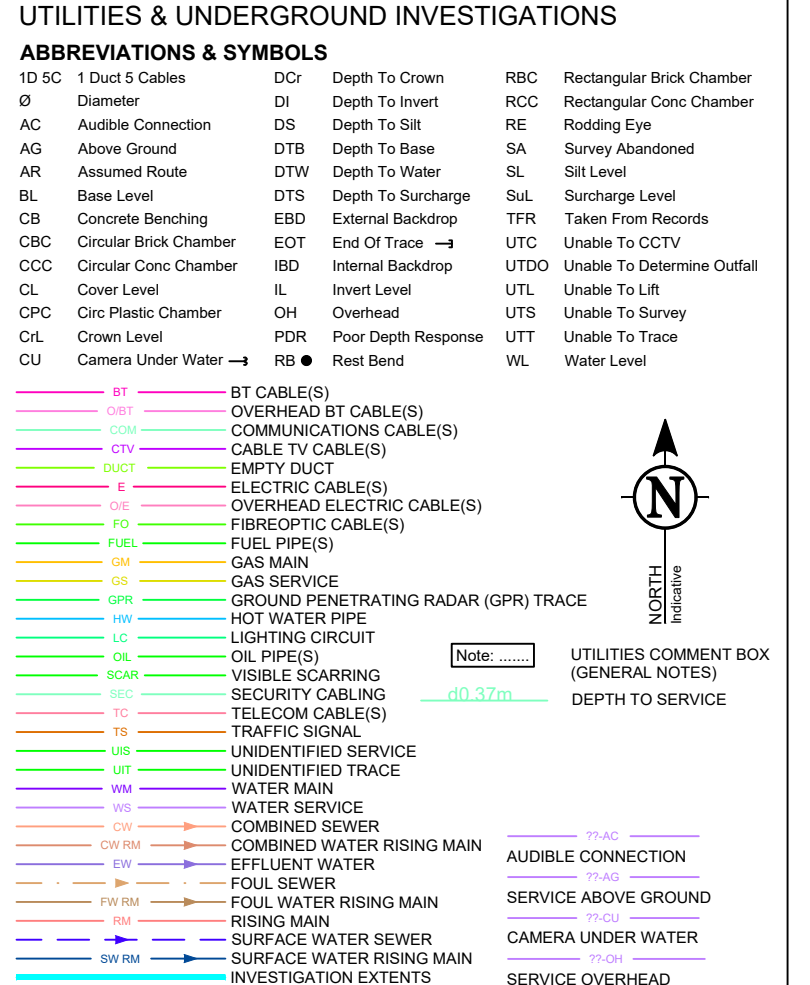

Q-LEVEL	DESCRIPTION	ACC.	Q-LEVEL	DESCRIPTION
QL-D	Service positions taken from records.	Unaided	QL-Q2	Horizontal & vertical location using only one coordinate technique.
QL-C	Visual estimation of service position based on identifiable by geographical technology.	Unaided	QL-Q1	Horizontal & vertical location using multiple geographical techniques.
QL-B4	Unaided service position taken as an assumed value.	As assumed	QL-A	Horizontal & vertical position verification by open examination, mapfiles and/or inspection standards.
QL-B3	Horizontal location by any geographical technique that will work in your system information.			

DRAINAGE SURVEY
All accessible Manholes and Inspection chambers have had their respective covers lifted with pipe sizes, inverts, chamber sizes/types and service data recorded from ground level. All connections from DPs, Gullies, Drains, VP's, RE's and lampholes have been proven wherever possible using audible connections (AC) and/or sonde instrumentation where applicable. Where these methods have proved unsuccessful then assumed (AR) straight line connections will be shown.

Electricity
Elec cables will have been predominantly located using EML methodology with electronically derived depths shown. GPR techniques will be employed to achieve greater quality levels as required.

CTV and/or Com cables will have been predominantly located using EML methodology with electronically derived depths shown. GPR techniques will be employed to achieve greater quality levels as required.

LC, TS and/or Sec cables will have been predominantly located using EML methodology with electronically derived depths shown. GPR techniques will be employed to achieve greater quality levels as required.

GPR methodology is used to identify and locate all non metallic, non conductive piping and cabling. We also employ GPR to obtain a greater accuracy levels on EML located services. The GPR has a greater success rate on pipe or service diameter upward of Ø63mm, C63mm, as size increments increase, so does the chance of detection. The GPR can produce varying results and as such, wouldn't be used as an independent utility surveying instrument.

Scarring has been identified on site with a potential of an undetectable service present.

plans or previous survey information and overlaid onto our drawings.

DESKTOP UTILITY RECORDS (PAS 128: 2014 SURVEY TYPE D)		
PREREQUISITE FOR PAS 128: 2014 SURVEY TYPE B		
COMMISSIONED: NO		
UTILITY	AVAILABILITY	UTILITY COMPANY PROVIDER
SEWER	NO	N/A
WATER MAIN	NO	N/A
GAS MAIN	NO	N/A
TELECOM	PUBLIC	BRITISH TELECOMS
CABLE TV	NO	N/A
ELECTRICITY	NO	N/A
OIL PIPES	NO	N/A
OTHER	NO	N/A

 <h1 style="margin: 0;">SURVEY SOLUTIONS</h1>													
<p>LAND SURVEYING BUILDING SURVEYING UNDERGROUND SURVEYING SITE ENGINEERING MONITORING</p>													
<p>0845 040 5969 survey-solutions.co.uk</p>		<p>PERMICH BEDFORD COVENTRY GLASGOW LONDON MANCHESTER NORWICH</p>											
<table border="1" style="width: 100%; border-collapse: collapse;"> <thead> <tr> <th style="width: 60%;">REV</th> <th style="width: 20%;">DESCRIPTION</th> <th style="width: 10%;">ORIGIN</th> <th style="width: 10%;">APPROV</th> <th style="width: 10%;">DATE</th> </tr> </thead> <tbody> <tr> <td> </td> <td> </td> <td> </td> <td> </td> <td> </td> </tr> </tbody> </table>				REV	DESCRIPTION	ORIGIN	APPROV	DATE					
REV	DESCRIPTION	ORIGIN	APPROV	DATE									
<p>PROJECT TITLE HIGHGATE CEMETERY, SWAINS LANE, LONDON, N6 6PJ.</p> <p>DRAWING DETAIL UTILITIES AND DRAINAGE SURVEY.</p> <p>SHEET 6 OF 8</p>													
<p>CLIENT STEENSEN VARMING</p>			<p>SCALE 1:250</p>										
<p>SURVEYOR LJT</p>	<p>SURVEY DATE 20/10/2021</p>	<p>CHECKED BY JAB</p>	<p>APPROVED BY GSB</p>										
<p>DRAWING NUMBER 32482BWUG-06</p>			<p>REVISION ISSUE DATE 28/10/2021</p>										
<div style="display: flex; justify-content: space-around; align-items: center;">       </div>													
<p>ISS 24/01/2013 10:53</p>													

This survey has been carried out in accordance with PAS 128: 2014 & our version of the Royal Institution of Chartered Surveyors (RICS) specification for Measured Surveys of Land, Buildings and Utilities. Our survey extents have been agreed and confirmed with formal acceptance of 32482BWUG-01 from STEENSEN VARMING. If you have any queries regarding the final services layout, please may we ask you to carefully read all the information within this title block in its entirety before continuing to do so.


GENERAL SITE CONDITIONS	
BELOW AVERAGE	
ADDITIONAL INFORMATION	EFFECT ON SURVEY RESULTS
GRAVESTONES AND UNEVEN GROUND.	SURVEYED WHERE POSSIBLE IN PATHS

LIST RECOMMENDATIONS TO IMPROVE SURVEY DATA

We would suggest an up to date, more detailed and comprehensive topographical survey.

DETECTION METHOD

Taken from records (TFR) are service routes that are taken from STAT record plans or previous survey information and overlaid onto our drawings.



All below ground details shown have been identified from above ground without excavation. Survey Solution use electro-magnetic and/or ground penetrating radar (GPR) methods to investigate for underground utilities, services and features. Results using these methods are not infallible and we recommend trial excavations are carried out for verification of positions, depths and identification.

Any areas on the drawing where services or features have not been shown are not necessarily clear of services or features but are an indication that no items have been identified during our investigations. All reasonable care and normal good practice should still be employed during design and construction processes.

Certain types of services such as plastic or concrete pipes, some conduit and ducting where direct access can not be achieved for tracing may not be shown and alternative locating methods should be used.

Survey Solutions has used all reasonable care to research available service records but the completeness or use of the service records supplied to or by Survey Solutions cannot be guaranteed. Therefore Survey Solutions cannot be held responsible for any features annotated as 'taken from records' (TFR).

Depths obtained using electro-magnetic or GPR are effected by ground conditions and should be treated as indicative only. Electro-magnetic depths to utilities and services are generally taken to the centre of a feature, GPR depths to the top of a feature and drainage depth shown to inverts, unless otherwise indicated.

Drainage pipe sizes will be obtained without entering the chamber and therefore should be treated as approximate. Pipe dimensions which have not been obtained visually will be taken from records when available.

All services, drainage and utilities routes are assumed straight between access points, unless otherwise stated. The numbers of cables in runs will not be shown unless specifically requested. All services are below ground unless indicated.

Services, utilities and features may not have been surveyed if obstructed or not reasonably visible or accessible at the time of survey.

Survey Solutions accept no responsibility for the completeness or accuracy of either the topographical survey or base mapping on this project.

All critical dimensions and measurements should be checked and verified with any errors or discrepancies notified to Survey Solutions immediately. The accuracy of

The contractor must check and verify all site and building dimensions, levels, utilities and drainage details and connections prior to commencing work.

© Land Survey Solutions Limited hold the copyright to all the information contained within this document and their written consent must be obtained before copying or using the data other than for the purpose it was originally supplied.

DESKTOP UTILITY RECORDS (PAS 128: 2014 SURVEY TYPE D)
PREREQUISITE FOR PAS 128: 2014 SURVEY TYPE B
COMMISSIONED: NO

UTILITY	AVAILABILITY	UTILITY COMPANY PROVIDER
SEWER	NO	N/A
WATER MAIN	NO	N/A
GAS MAIN	NO	N/A
TELECOM	PUBLIC	BRITISH TELECOMS
CABLE TV	NO	N/A
ELECTRICITY	NO	N/A
OIL PIPES	NO	N/A
OTHER	NO	N/A

REV	DESCRIPTION	DRAWN	APPROV	DATE



SURVEY SOLUTIONS

LAND SURVEYING
BUILDING SURVEYING
UNDERGROUND SURVEYING
SITE ENGINEERING
MONITORING

0845 040 5969

survey-solutions.co.uk

SPRINK BEDFORD COVENTRY GLASGOW LONDON MANCHESTER NORWICH
NOTTINGHAM TRURO

PROJECT TITLE
HIGHGATE CEMETERY, SWAINS LANE,

LONDON, N6 6PJ.

DRAWING DETAIL
UTILITIES AND DRAINAGE SURVEY.
SHEET 7 OF 8

CLIENT STEENSEN VARMING				SCALE 1:250
SURVEYOR LJT	SURVEY DATE 20/10/2021	CHECKED BY JAB	APPROVED BY GSB	DWG STATUS FINAL
DRAWING NUMBER 32482BWUG-07			REVISION	ISSUE DATE 28/10/2021

GENERAL SYNOPSIS

This survey has been carried out in accordance with PAS 128: 2014 & our version of the Royal Institution of Chartered Surveyors (RICS) specification for Measured Surveys of Land, Buildings and Utilities. Our survey extents have been agreed and confirmed with formal acceptance of 32482BWUG-01 from STEENSEN VARMING. If you have any queries regarding the final services layout, please may we ask you to carefully read all the information within this title block in its entirety before continuing to do so.

GENERAL SITE CONDITIONS BELOW AVERAGE	
ADDITIONAL INFORMATION	EFFECT ON SURVEY RESULTS
GRAVESTONES AND UNEVEN GROUND.	SURVEYED WHERE POSSIBLE IN PATHS

SURVEY RECOMMENDATIONS

LIST RECOMMENDATIONS TO IMPROVE SURVEY DATA

Due to the geophysical nature of subsurface technology, we always recommend excavation works to be carried out for verification, especially within critical areas.

We would suggest an up to date, more detailed and comprehensive topographical survey.

PAS 128: 2014 QUALITY LEVEL GUIDE				
Q-LEVEL	DESCRIPTION	ACC	Q-LEVEL	DESCRIPTION
Q-LD	Passive protection, basic fire, security.	Low	Q-LB2	Enhanced & vertical isolation using only passive techniques
Q-LD	Visual evidence of fire resistance but no evidence of structural performance	Low	Q-LB1	Enhanced & vertical isolation using multiple active techniques
Q-LB	Enhanced protection, physical barriers for personnel, security, fire	Med	Q-LA	Enhanced & vertical isolation for open penetration, machines, public inspection barriers
Q-LB4	Enhanced protection for the new penetration technique but with little to poor, much information	Med		

DETECTION METHOD
IN ACCORDANCE WITH PAS 128: 2014 SURVEY TYPE B

DRAINAGE SURVEY
All accessible Manholes and Inspection chambers have had their respective covers fitted with pipe sizes, inverts, chamber sizes/types and service data recorded from ground level. All connections from DP's, Gullies, Drains, VP's, RE's and lampholes have been proven wherever possible using audible connections (AC) and/or sonde instrumentation where applicable. Where these methods have proved unsuccessful then assumed (AR) straight line connections will be shown.

All accessible Manholes and Inspection chambers have had their respective covers lifted with pipe sizes, inverts, chamber sizes/type and service data recorded from ground level. Pipework has been traced, accessed and collected for post processing. Drainage layout, including manhole covers not located by topographical survey, may be taken from CCTV chainage and will be shown as indicative only.

Electricity
Elec cables will have been predominantly located using EML methodology with electronically derived depths shown. GPR techniques will be employed to achieve greater quality levels as required.

British Telecoms

BT cables will have been predominantly located using EML methodology with electronically derived depths shown. GPR techniques will be employed to achieve greater quality levels as required. Due to current laws and legislation protecting all BT apparatus, cabling can only be located remotely. We therefore compare all our telecom findings against record information to produce the final service layout. In some instances, where high amount of cable ducts are present, we may only be able to identify a linear centre peak signal rather than identifying all the individual duct positions. For further information regarding Telecoms apparatus, please contact Openreach directly.

Cable TV & Communications
CTV and/or Com cables will have been predominantly located using EML methodology with electronically derived depths shown. GPR techniques will be employed to achieve greater quality levels as required.

Fibre Optic
FO cables will have been predominantly located using GPR methodology. This is due to the materials used within fibre optic cabling. In some rare instances, tracer cabling or conductive non fibre optic cabling will be present within some or all ducting. When this is the case, both EML and GPR methodology will be combined to identify service network and achieve greater quality levels.

LC, TS and/or Sec cables will have been predominantly located using EML methodology with electronically derived depths shown. GPR techniques will be employed to achieve greater quality levels as required.

GMS & Water Inc. Fuel Pipes and Hot Water Pipes
GMS and/or WMMWS pipe work will have been attempted and located using both EML & GPR methodology with electronically derived depths shown for the former and depths to crown levels shown for the latter.
When the Gas/Water pipe work is constructed using conductive materials, then we are able to employ multiple geophysical techniques to identify service network and achieve greater quality levels. When a non conductive material is used, GPR methodology will be employed to locate and plot the final service layout.

Ground Penetrating Radar
GPR methodology is used to identify and locate all non metallic, non conductive piping and cabling. We also employ GPR to obtain a greater accuracy levels on EML located services. The GPR has a greater success rate on pipe or service diameter upward of Ø63mm, C63mm, as size increments increase, so does the chance of detection. The GPR can produce varying results and as such, wouldn't be used as an independent utility surveying instrument.

All UITS will have been predominantly located using EMI methodology with electronically derived depths shown. GPR techniques will be employed to achieve greater quality levels as required. Every effort has been made to identify the service but in this instance, is not achievable. We recommend excavation work to determine identity and depth where applicable.

Scarring (QL-C)
Scarring has been identified on site with a potential of an undetectable service present.

Assumed Routes & Taken from Records (QL-B4/D)

Assumed routes (AR) are shown if there is evidence that a service exists but we are unable to trace it whilst on site. The surveyor will attempt to locate various risers/cables/meters (service evidence) etc. around site area to successfully determine an assumed route between these points. If there is little evidence on site but they believe a service is still present, then a common sense approach to an assumed route shall be employed.

Taken from records (TFR) are service routes that are taken from STAT record plans or previous survey information and overlaid onto our drawings.

[illegible]

DRAWING NOTES

All below ground details shown have been identified from above ground without excavation. Survey Solution use electro-magnetic and/or ground penetrating radar (GPR) methods to investigate for underground utilities, services and features. Results using these methods are not infallible and we recommend trial excavations are carried out for verification of positions, depths and identification.

Any areas on the drawing where services or features have not been shown are not necessarily clear of services or features but are an indication that no items have been identified during our investigations. All reasonable care and normal good practice should still be employed during design and construction processes.

Certain types of services such as plastic or concrete pipes, some conduit and ducting where direct access can not be achieved for tracing may not be shown and alternative locating methods should be used.

Survey Solutions has used all reasonable care to research available service records but the completeness or use of the service records supplied to or by Survey Solutions cannot be guaranteed. Therefore Survey Solutions cannot be held responsible for any features annotated as 'taken from records' (TFR).

Depths obtained using electro-magnetic or GPR are effected by ground conditions and should be treated as indicative only. Electro-magnetic depths to utilities and services are generally taken to the centre of a feature, GPR depths to the top of a feature and drainage depth shown to inverts, unless otherwise indicated.

Drainage pipe sizes will be obtained without entering the chamber and therefore should be treated as approximate. Pipe dimensions which have not been obtained visually will be taken from records when available.

All services, drainage and utilities routes are assumed straight between access points, unless otherwise stated. The numbers of cables in runs will not be shown unless specifically requested. All services are below ground unless indicated.

Services, utilities and features may not have been surveyed if obstructed or not reasonably visible or accessible at the time of survey.

Survey Solutions accept no responsibility for the completeness or accuracy of either the topographical survey or base mapping on this project.


All critical dimensions and measurements should be checked and verified with any errors or discrepancies notified to Survey Solutions immediately. The accuracy of the digital data is the same as the plotting scale implies. All dimensions are in

The contractor must check and verify all site and building dimensions, levels, utilities and drainage details and connections prior to commencing work.

Do not scale from this drawing.

DESKTOP UTILITY RECORDS (PAS 128: 2014 SURVEY TYPE D)		
PREREQUISITE FOR PAS 128: 2014 SURVEY TYPE B		
COMMISSIONED: NO		
UTILITY	AVAILABILITY	UTILITY COMPANY PROVIDER
SEWER	NO	N/A
WATER MAIN	NO	N/A
GAS MAIN	NO	N/A
TELECOM	PUBLIC	BRITISH TELECOMS
CABLE TV	NO	N/A
ELECTRICITY	NO	N/A
OIL PIPES	NO	N/A
OTHER	NO	N/A

REV.	DESCRIPTION	ORIGIN	APPR.	DATE	
<div style="display: flex; align-items: center; justify-content: space-between;"> <div style="text-align: center;">  <p>SURVEY SOLUTIONS</p> <p>LAND SURVEYING BUILDING SURVEYING UNDERGROUND SURVEYING SITE ENGINEERING MONITORING</p> </div> <div style="text-align: center;"> <p>0845 040 5969 survey-solutions.co.uk</p> </div> </div>					
<p>PENWITH BEDFORD COUNTRY GLASGOW LONDON MANCHESTER NORWICH NOTTINGHAM YORK</p>					
<p>PROJECT TITLE HIGHGATE CEMETERY, SWAINS LANE, LONDON, N6 6PJ.</p> <p>DRAWING DETAIL UTILITIES AND DRAINAGE SURVEY. SHEET 5 OF 6</p>					
<p>CLIENT STEENSEN VARMING</p>				<p>SCALE 1:250</p>	
<p>SURVEYOR DAVID JONES</p>		<p>ISSUE DATE 20/10/2021</p>		<p>DWG STATUS FINAL</p>	
<p>CHECKED BY JAB</p>		<p>APPROVED BY GCB</p>		<p>REVISION</p>	
<p>DRAWING NUMBER 32452BWUG-08</p>		<p>ISSUE DATE 28/10/2022</p>			
<div style="display: flex; justify-content: space-around; align-items: center;">       </div>					

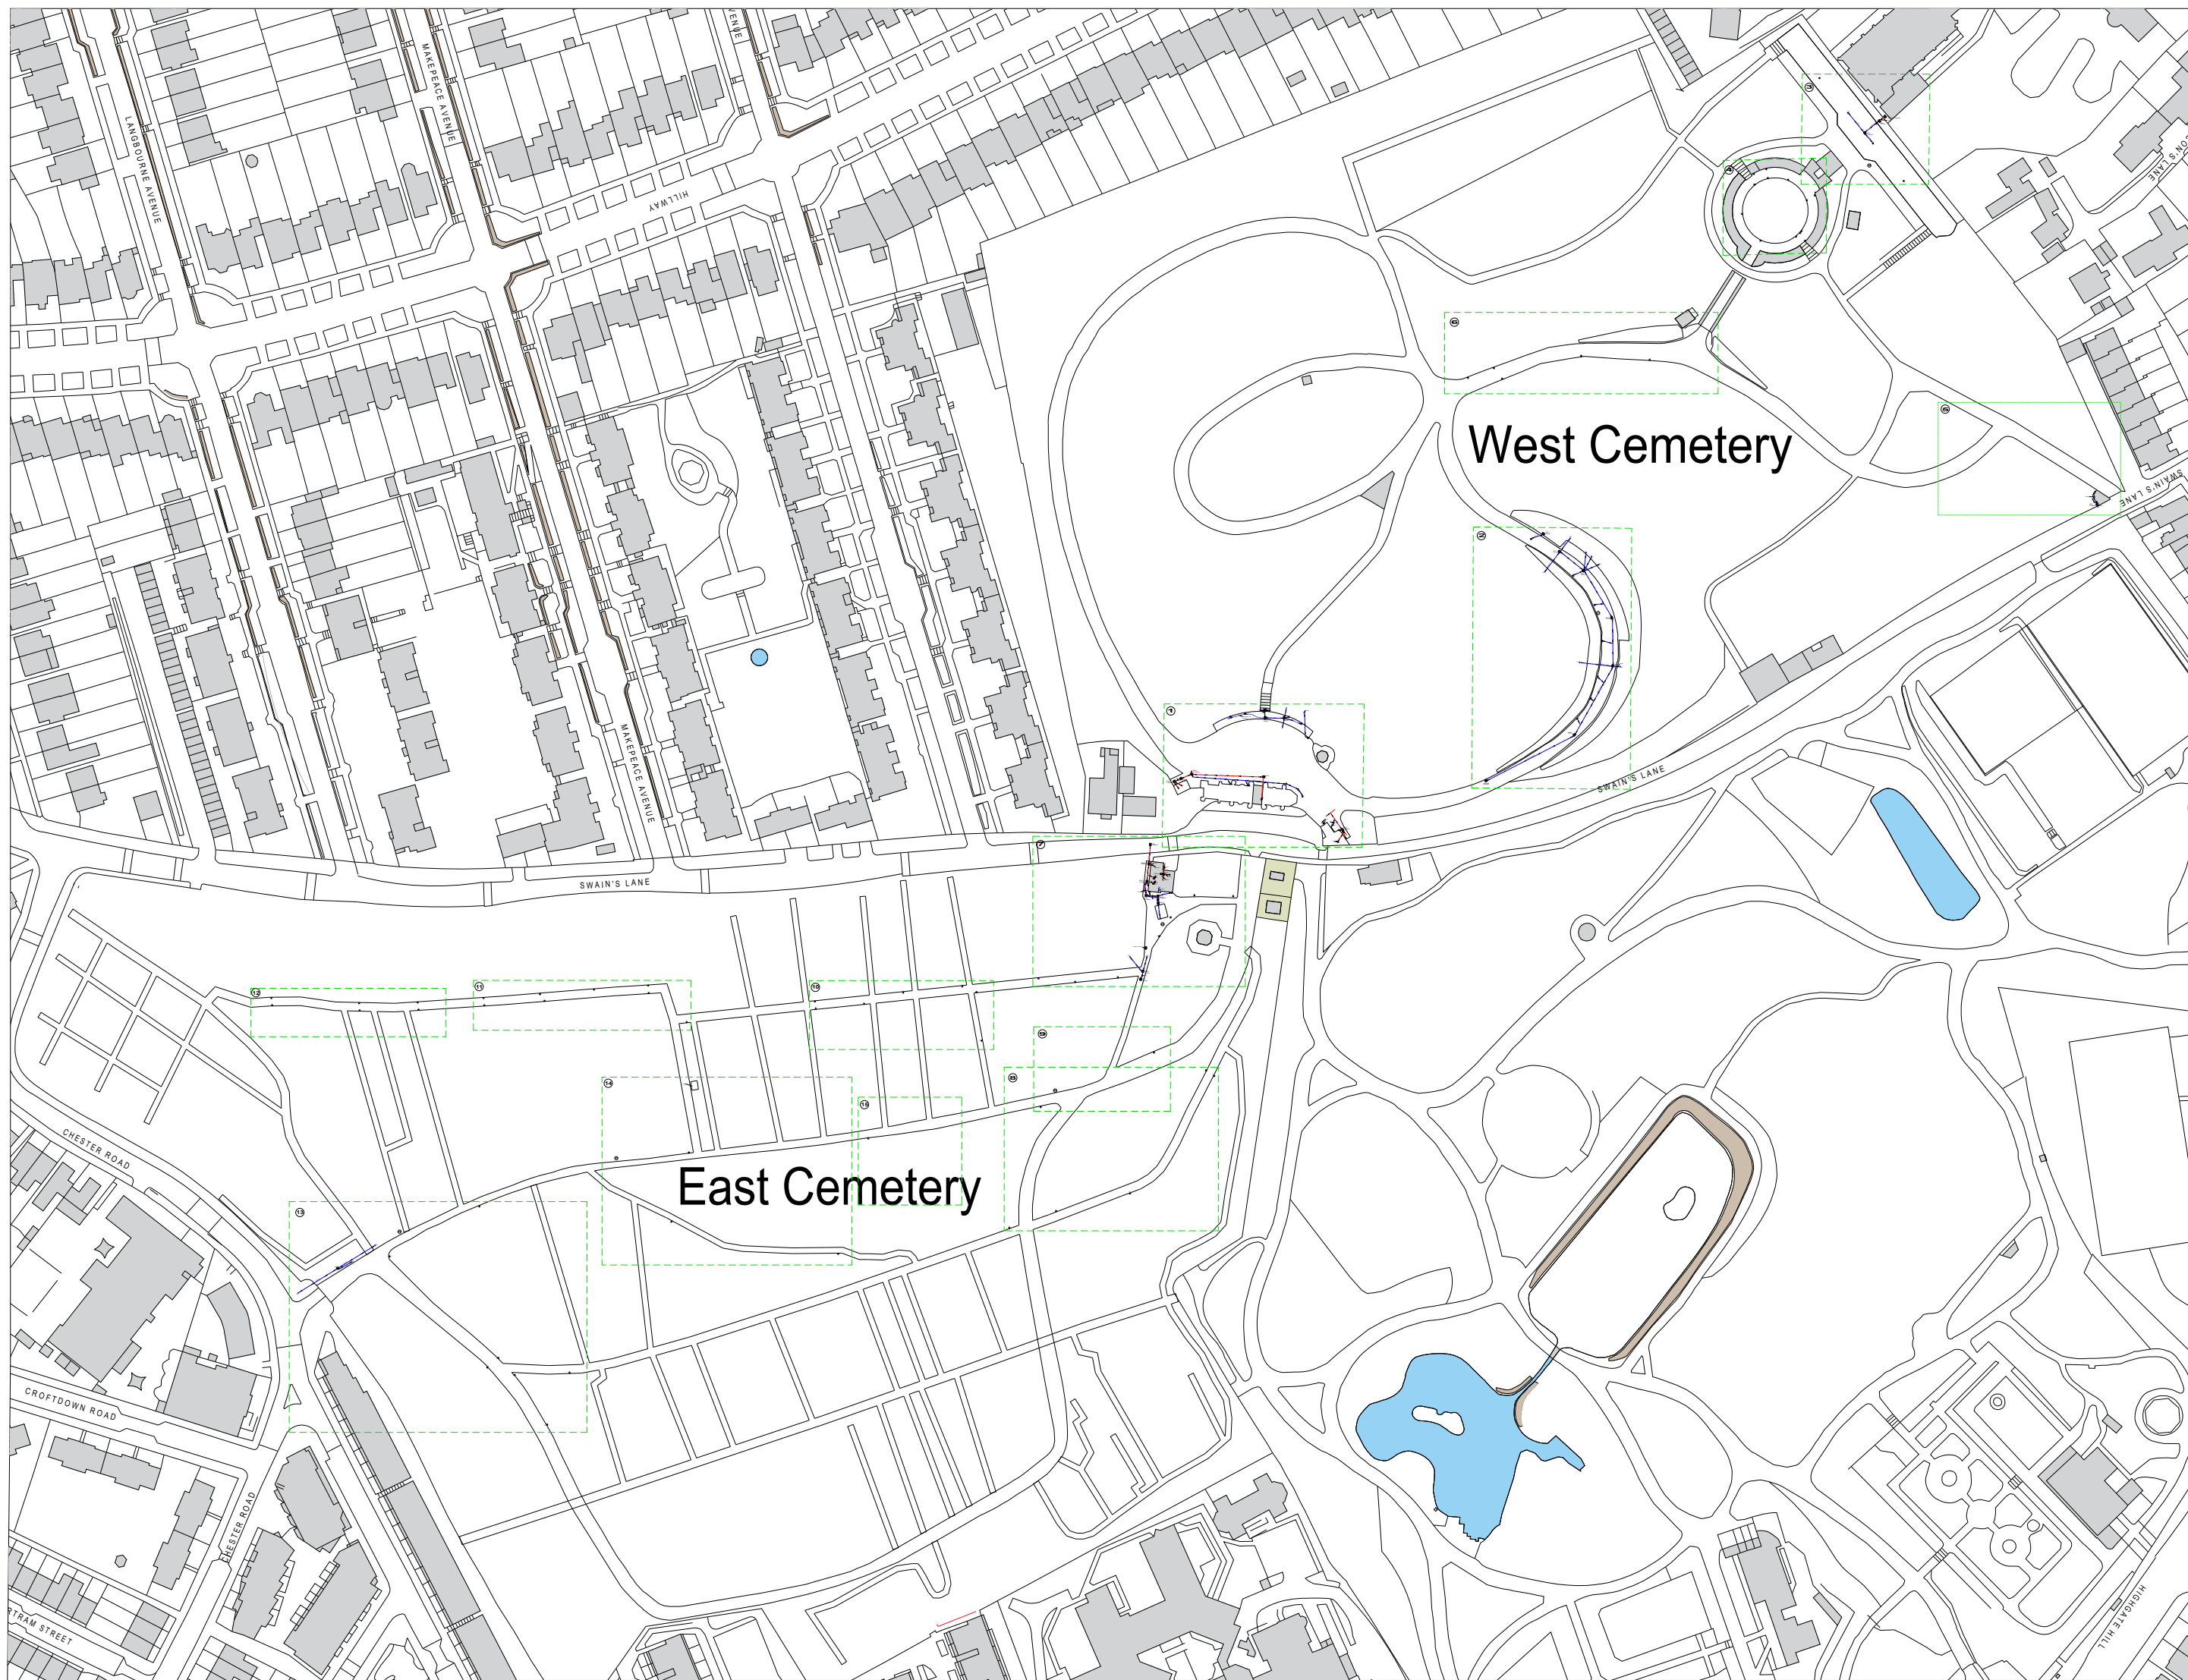

THE GENERAL CONTRACTOR IS TO CHECK ALL DIMENSIONS AND NOTIFY THE DESIGNERS OF ANY DISCREPANCIES OR OMISSIONS.

Symbols Key	
Preview	Block Name
---	Not Surveyed
---	Pumped Run
---	Foul Drain
---	Storm/ Grey Water Drain
---	Gully
---	Manhole
---	RWP
---	Acco Drain
---	SVP
---	Survey Abandoned
---	Direction of Flow
---	Water Main

DATE REVISIONS


Drainage & Asbestos
Kent Drainage Limited Unit 10/21 Laurence Avenue 20/20 Industrial
Estate Maidstone Kent ME16 9LL
TEL 01622 919012

CLIENT

PROJECT

Highgate Cemetery
Swain's Ln
London
N6 6PJ

TITLE




Drainage Survey

SCALE Indicative Only - Not To Scale

DATE 20/03/2024 DRAWN SHP

DRG No. Highgate Cemetery REV. 0

1

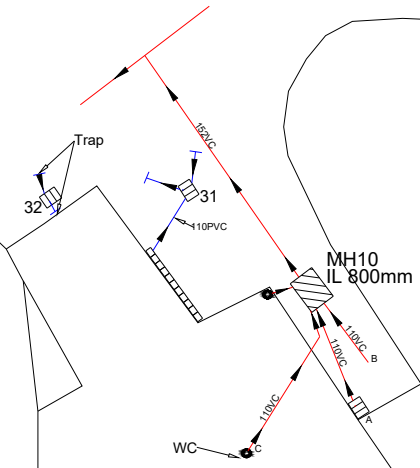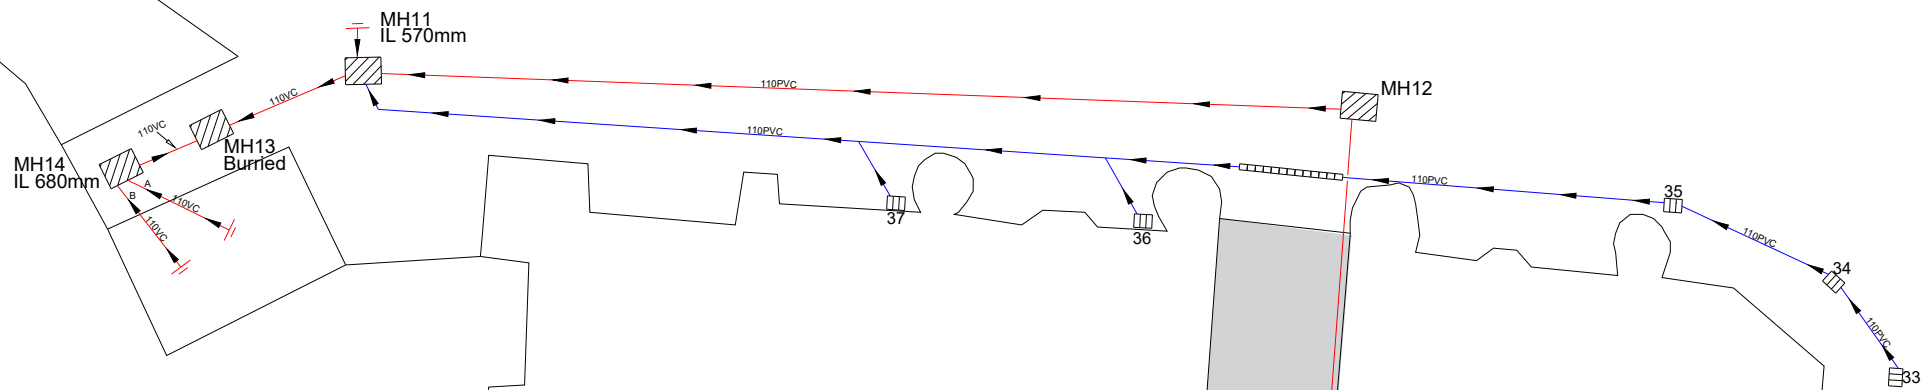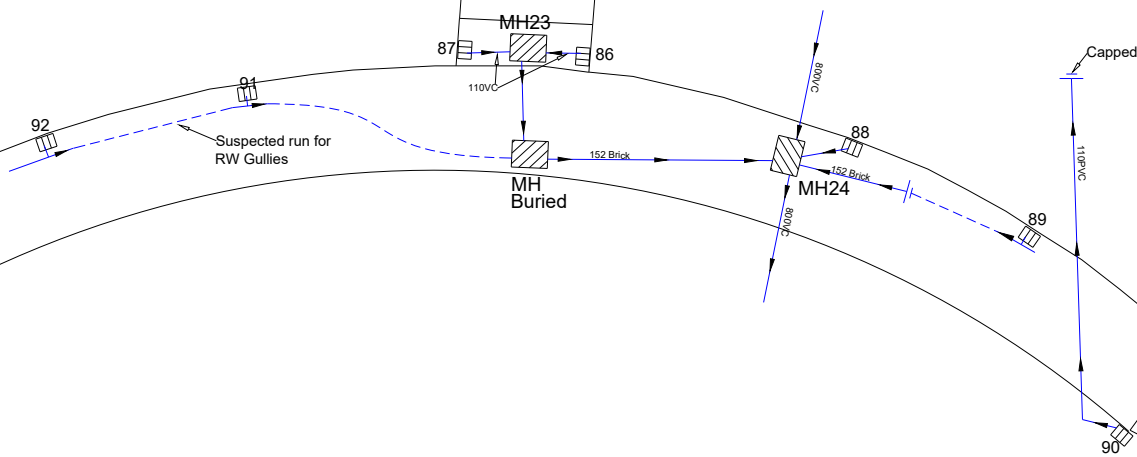

THE GENERAL CONTRACTOR IS TO CHECK ALL DIMENSIONS AND NOTIFY THE DESIGNERS OF ANY DISCREPANCIES OR OMISSIONS.

Symbols Key	
Preview	Block Name
---	Not Surveyed
---	Pumped Run
---	Foul Drain
---	Storm/ Grey Water Drain
---	Gully
---	Manhole
---	RWP
---	Acco Drain
---	SVP
SA	Survey Abandoned
---	Direction of Flow
---	Water Main

DATE REVISIONS



CLIENT

PROJECT

Highgate Cemetery
Swain's Ln
London
N6 6PJ

TITLE

Drainage Survey

SCALE Indicative Only - Not To Scale


DATE 20/03/2024

DRAWN SHP

DRG No. Highgate Cemetery

REV. 0

2

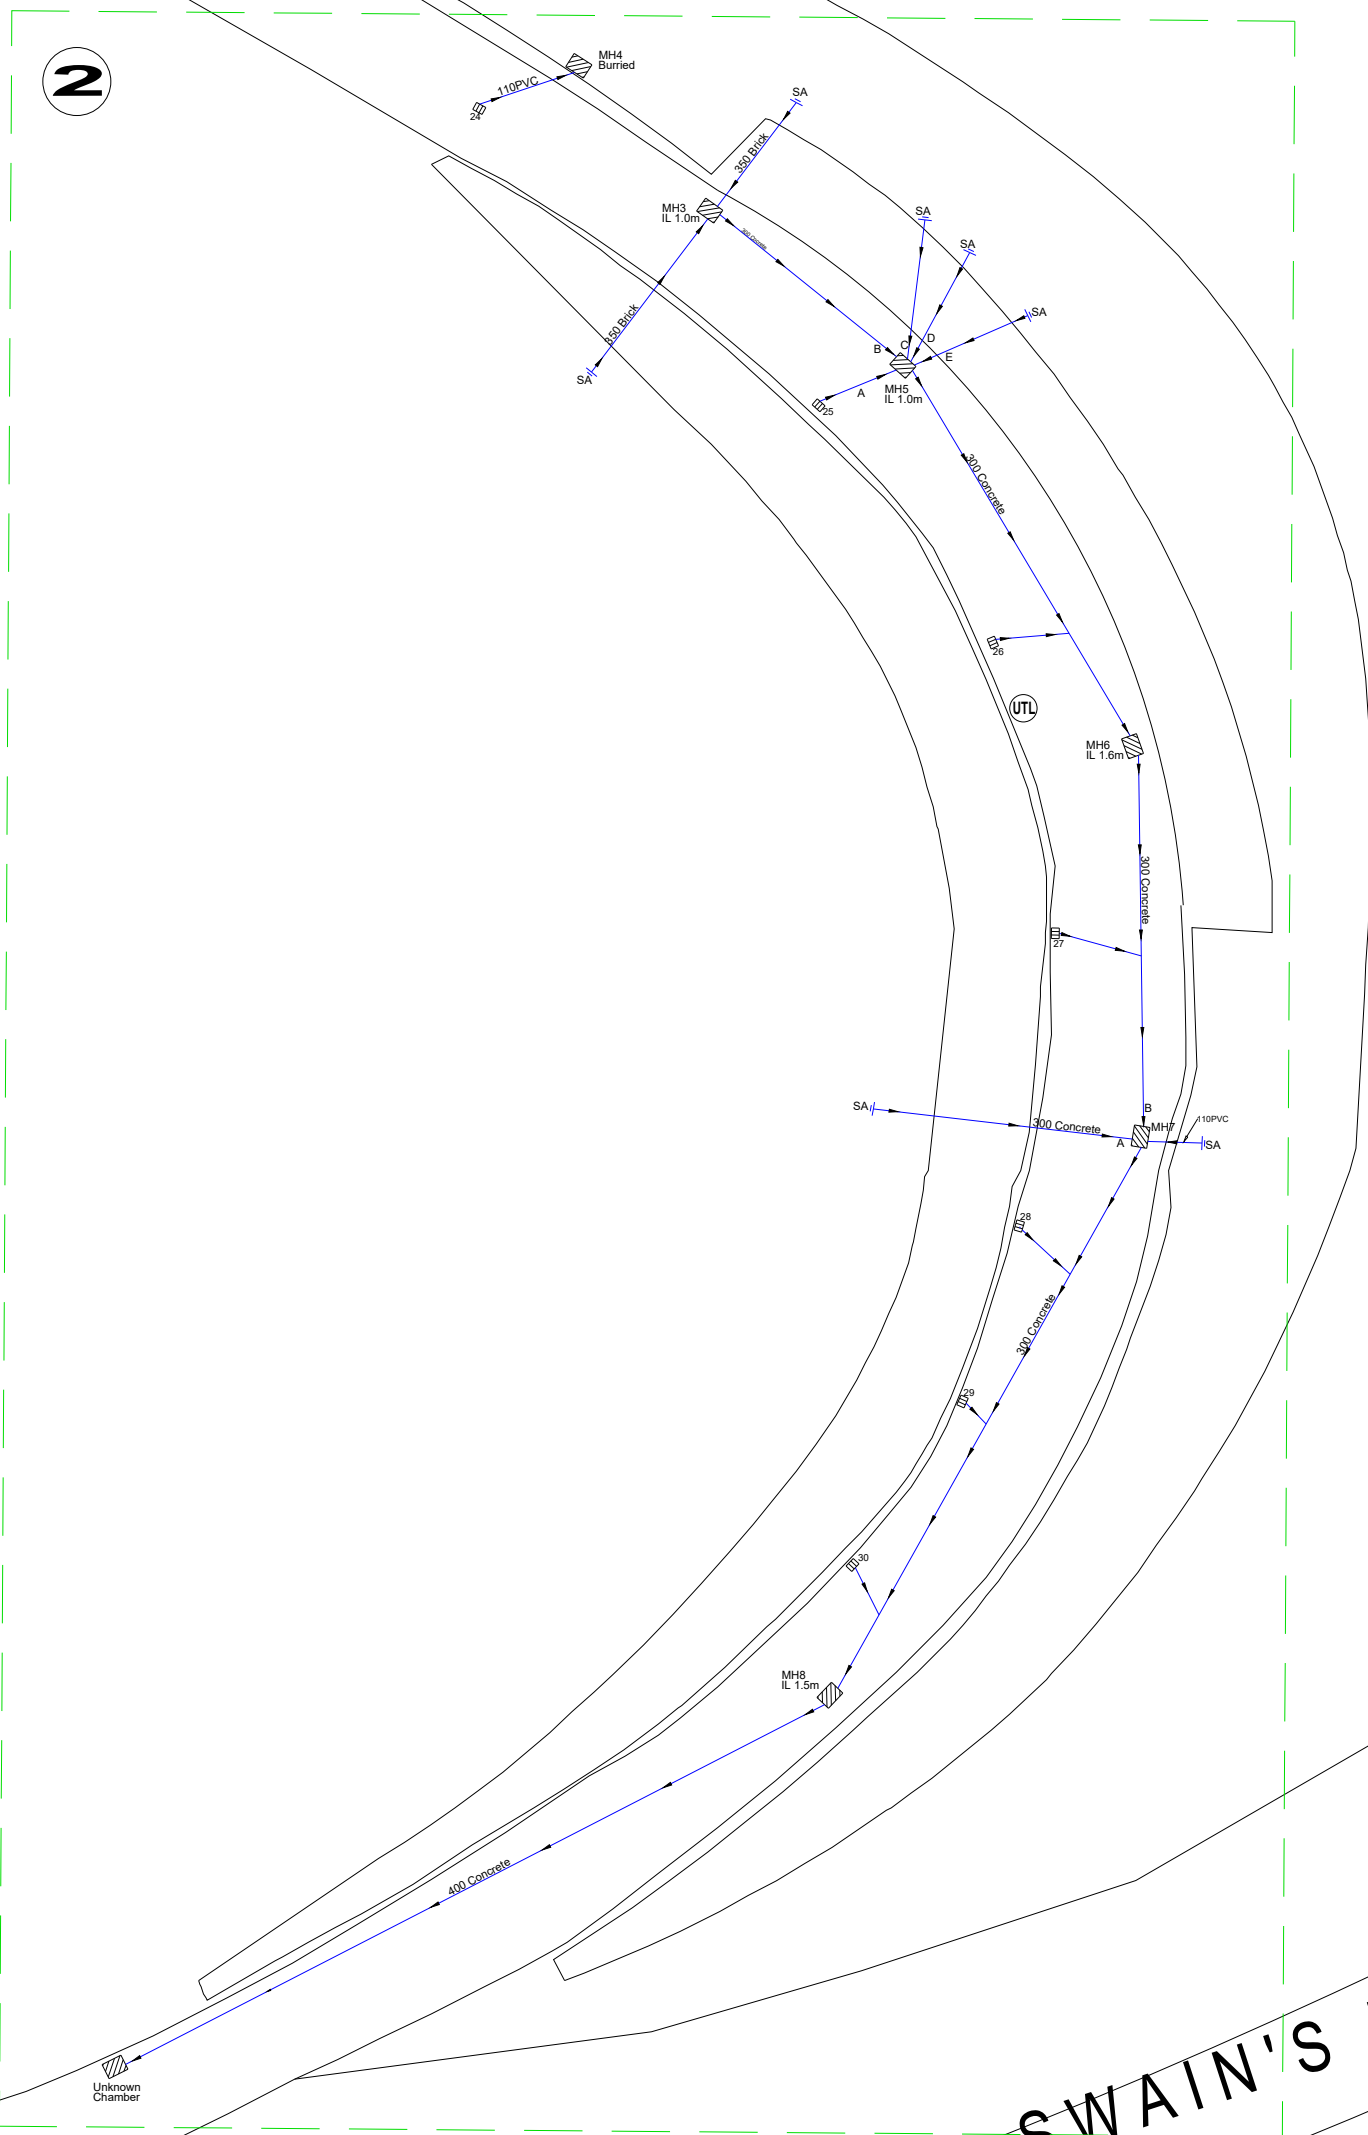

THE GENERAL CONTRACTOR IS TO CHECK ALL DIMENSIONS AND NOTIFY THE DESIGNERS OF ANY DISCREPANCIES OR OMISSIONS.

Symbols Key	
Preview	Block Name
---	Not Surveyed
---	Pumped Run
---	Foul Drain
---	Storm/ Grey Water Drain
---	Gully
---	Manhole
---	RWP
---	Acco Drain
---	SVP
---	Survey Abandoned
---	Direction of Flow
---	Water Main


Drainage & Asbestos
Kent Drainage Limited Unit 10/21 Laurence Avenue 20/20 Industrial
Estate Maidstone Kent ME16 9LL
TEL 01622 919012

CLIENT

PROJECT

Highgate Cemetery
Swain's Ln
London
N6 6PJ

TITLE

Drainage Survey

SCALE Indicative Only - Not To Scale

DATE 20/03/2024 DRAWN SHP

DRG No. Highgate Cemetery REV. 0



THE GENERAL CONTRACTOR IS TO CHECK ALL DIMENSIONS AND NOTIFY THE DESIGNERS OF ANY DISCREPANCIES OR OMISSIONS.

Symbols Key	
	Block Name
	Not Surveyed
	Pumped Run
	Foul Drain
	Storm/ Grey Water Drain
	Gully
	Manhole
	RWP
	Acco Drain
	SVP
	Survey Abandoned
	Direction of Flow
	Water Main

Drainage & Asbestos
Kent Drainage Limited Unit 10/11 Laurence Avenue 20/20 Industrial Estate Maidstone Kent ME16 0LL
TEL 01622 919012

CLIENT

PROJECT

Highgate Cemetery
Swain's Ln
London
N6 6PJ


TITLE

Drainage Survey

SCALE Indicative Only - Not To Scale

DATE 20/03/2024 DRAWN SHP

DRG No. Highgate Cemetery REV. 0

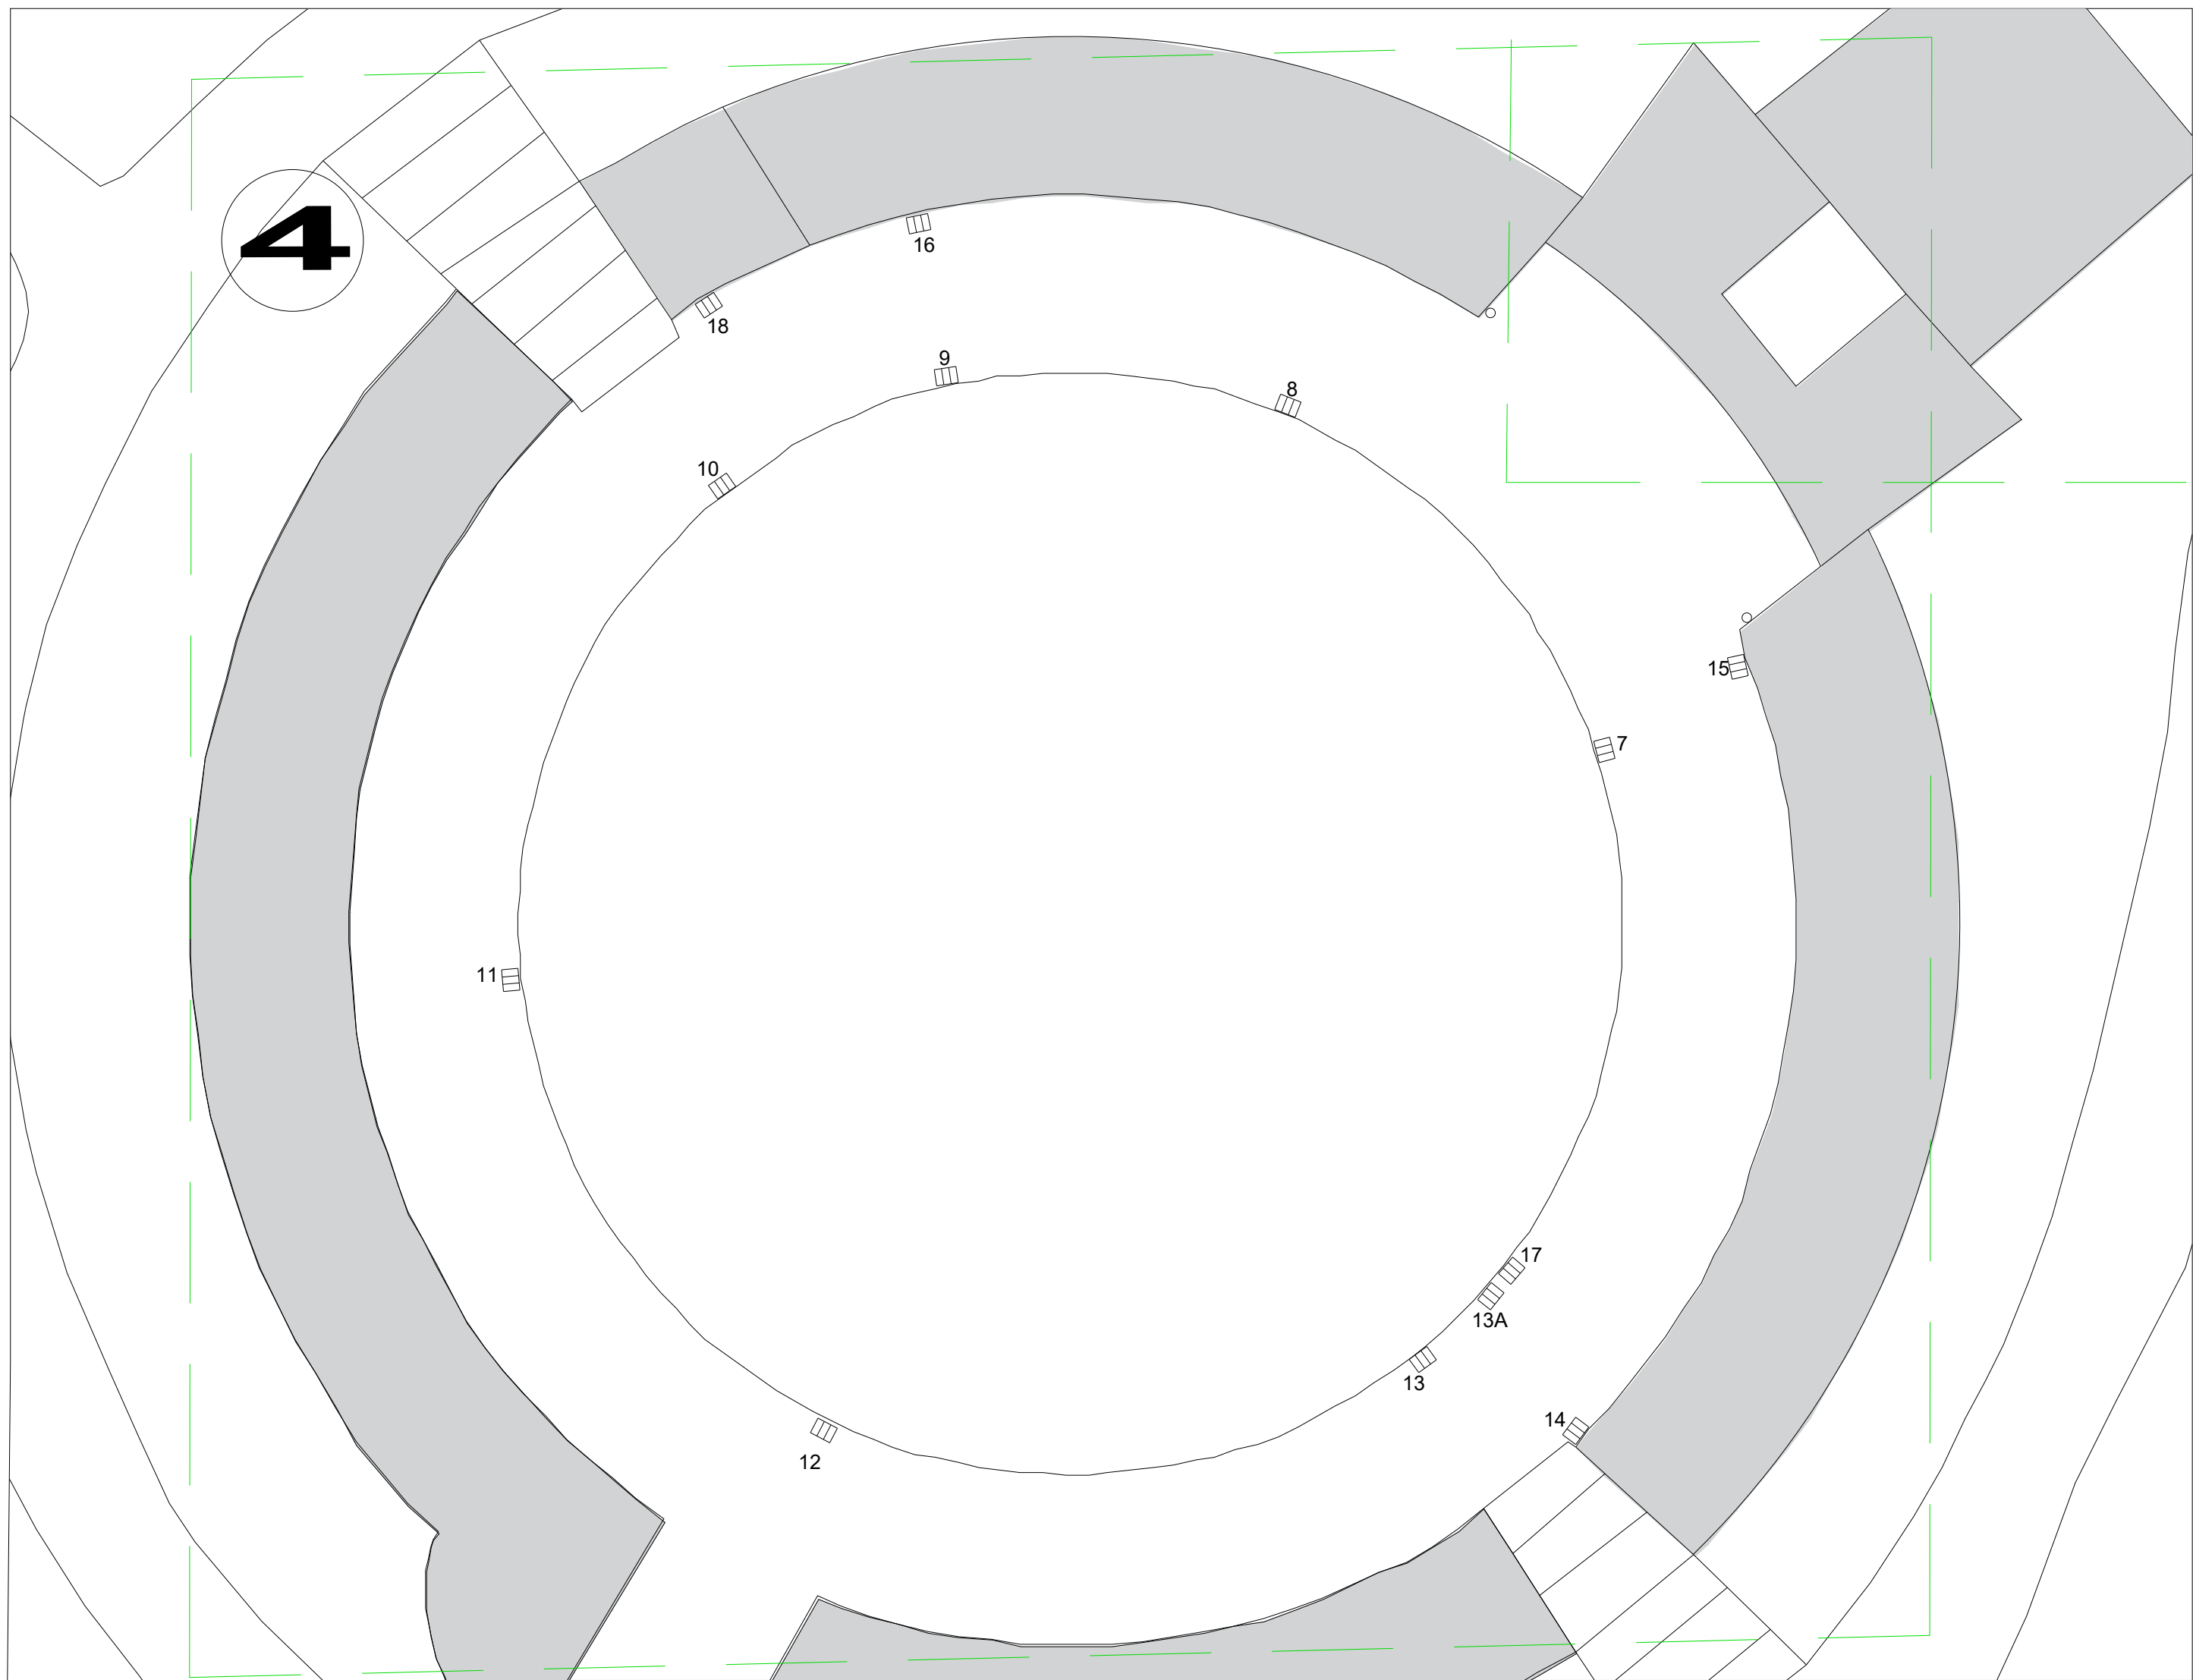

Symbols Key	
	Block Name
	Not Surveyed
	Pumped Run
	Foul Drain
	Storm/ Grey Water Drain
	Gully
	Manhole
	RWP
	Acco Drain
	SVP
	Survey Abandoned
	Direction of Flow
	Water Main



Drainage & Asbestos
Kent Drainage Limited Unit 10/21 Laurence Avenue 20/20 Industrial
Estate Maidstone Kent ME16 0LL
TEL 01622 919012

CLIENT

PROJECT
Highgate Cemetery
Swain's Ln
London
N6 6PJ

TITLE
Drainage Survey

SCALE Indicative Only - Not To Scale

DATE 20/03/2024 DRAWN SHP

DRG No. Highgate Cemetery REV. 0

5

110PVC
MH9
IL 600mm
SA
110PVC

Symbols Key	
Preview	Block Name
	Not Surveyed
	Pumped Run
	Foul Drain
	Storm/ Grey Water Drain
	Gully
	Manhole
	RWP
	Acco Drain
	SVP
	Survey Abandoned
	Direction of Flow
	Water Main

DATE	REVISIONS
------	-----------

Drainage & Asbestos
Kent Drainage Limited Unit 10, St Laurence Avenue 20/20 Industrial Estate Maidstone Kent ME16 0LL
TEL 01622 919012

COPYRIGHT

CLIENT

PROJECT

Highgate Cemetery
Swain's Ln
London
N6 6PJ

TITLE

Drainage Survey

SCALE

Indicative Only - Not To Scale

DATE

20/03/2024

DRAWN


SHP

DRG No.

Highgate Cemetery

REV.

0

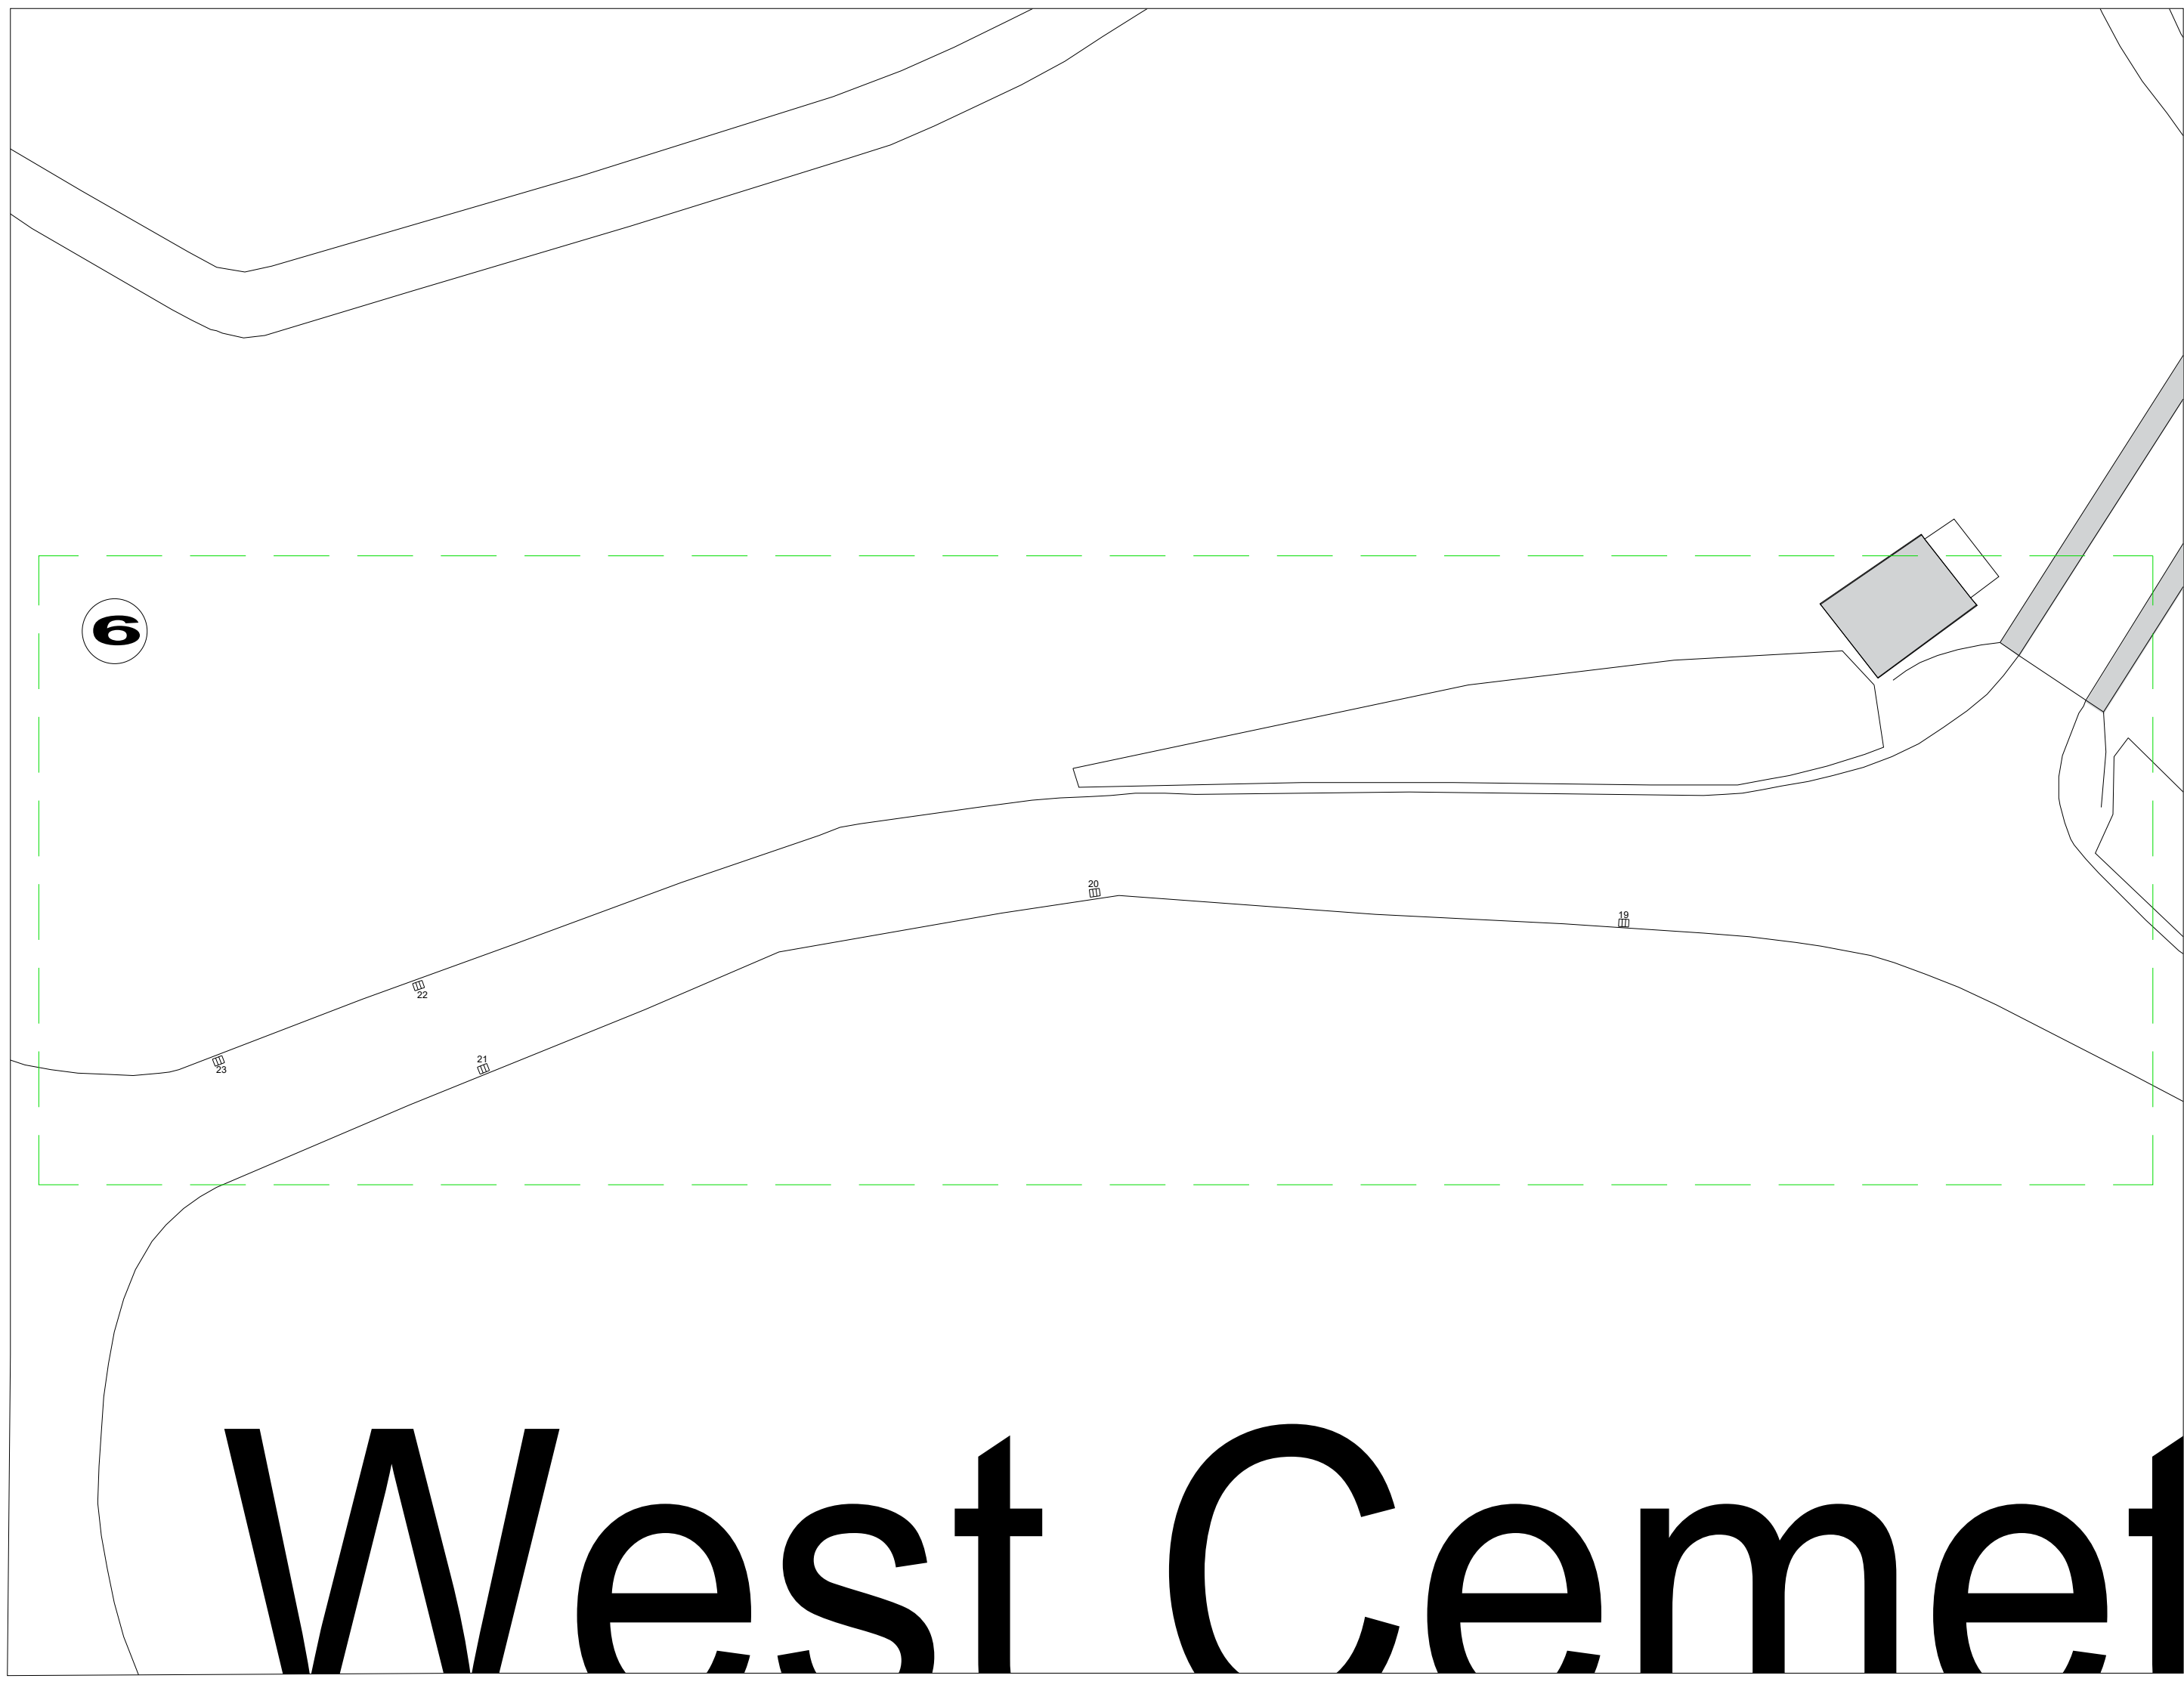

6

THE GENERAL CONTRACTOR IS TO CHECK ALL DIMENSIONS AND NOTIFY THE DESIGNERS OF ANY DISCREPANCIES OR OMISSIONS.

Symbols Key	
	Block Name
	Not Surveyed
	Pumped Run
	Foul Drain
	Storm/ Grey Water Drain
	Gully
	Manhole
	RWP
	Acco Drain
	SVP
	Survey Abandoned
	Direction of Flow
	Water Main

DATE	REVISIONS
------	-----------



Drainage & Asbestos
Kent Drainage Limited Unit 10/21 Laurence Avenue 20/20 Industrial
Estate Maidstone Kent ME16 9LL
TEL 01622 919012

Copyright

CLIENT


PROJECT
Highgate Cemetery
Swain's Ln
London
N6 6PJ

TITLE
Drainage Survey

SCALE Indicative Only - Not To Scale

DATE 20/03/2024 DRAWN SHP

DRG No. Highgate Cemetery REV. 0

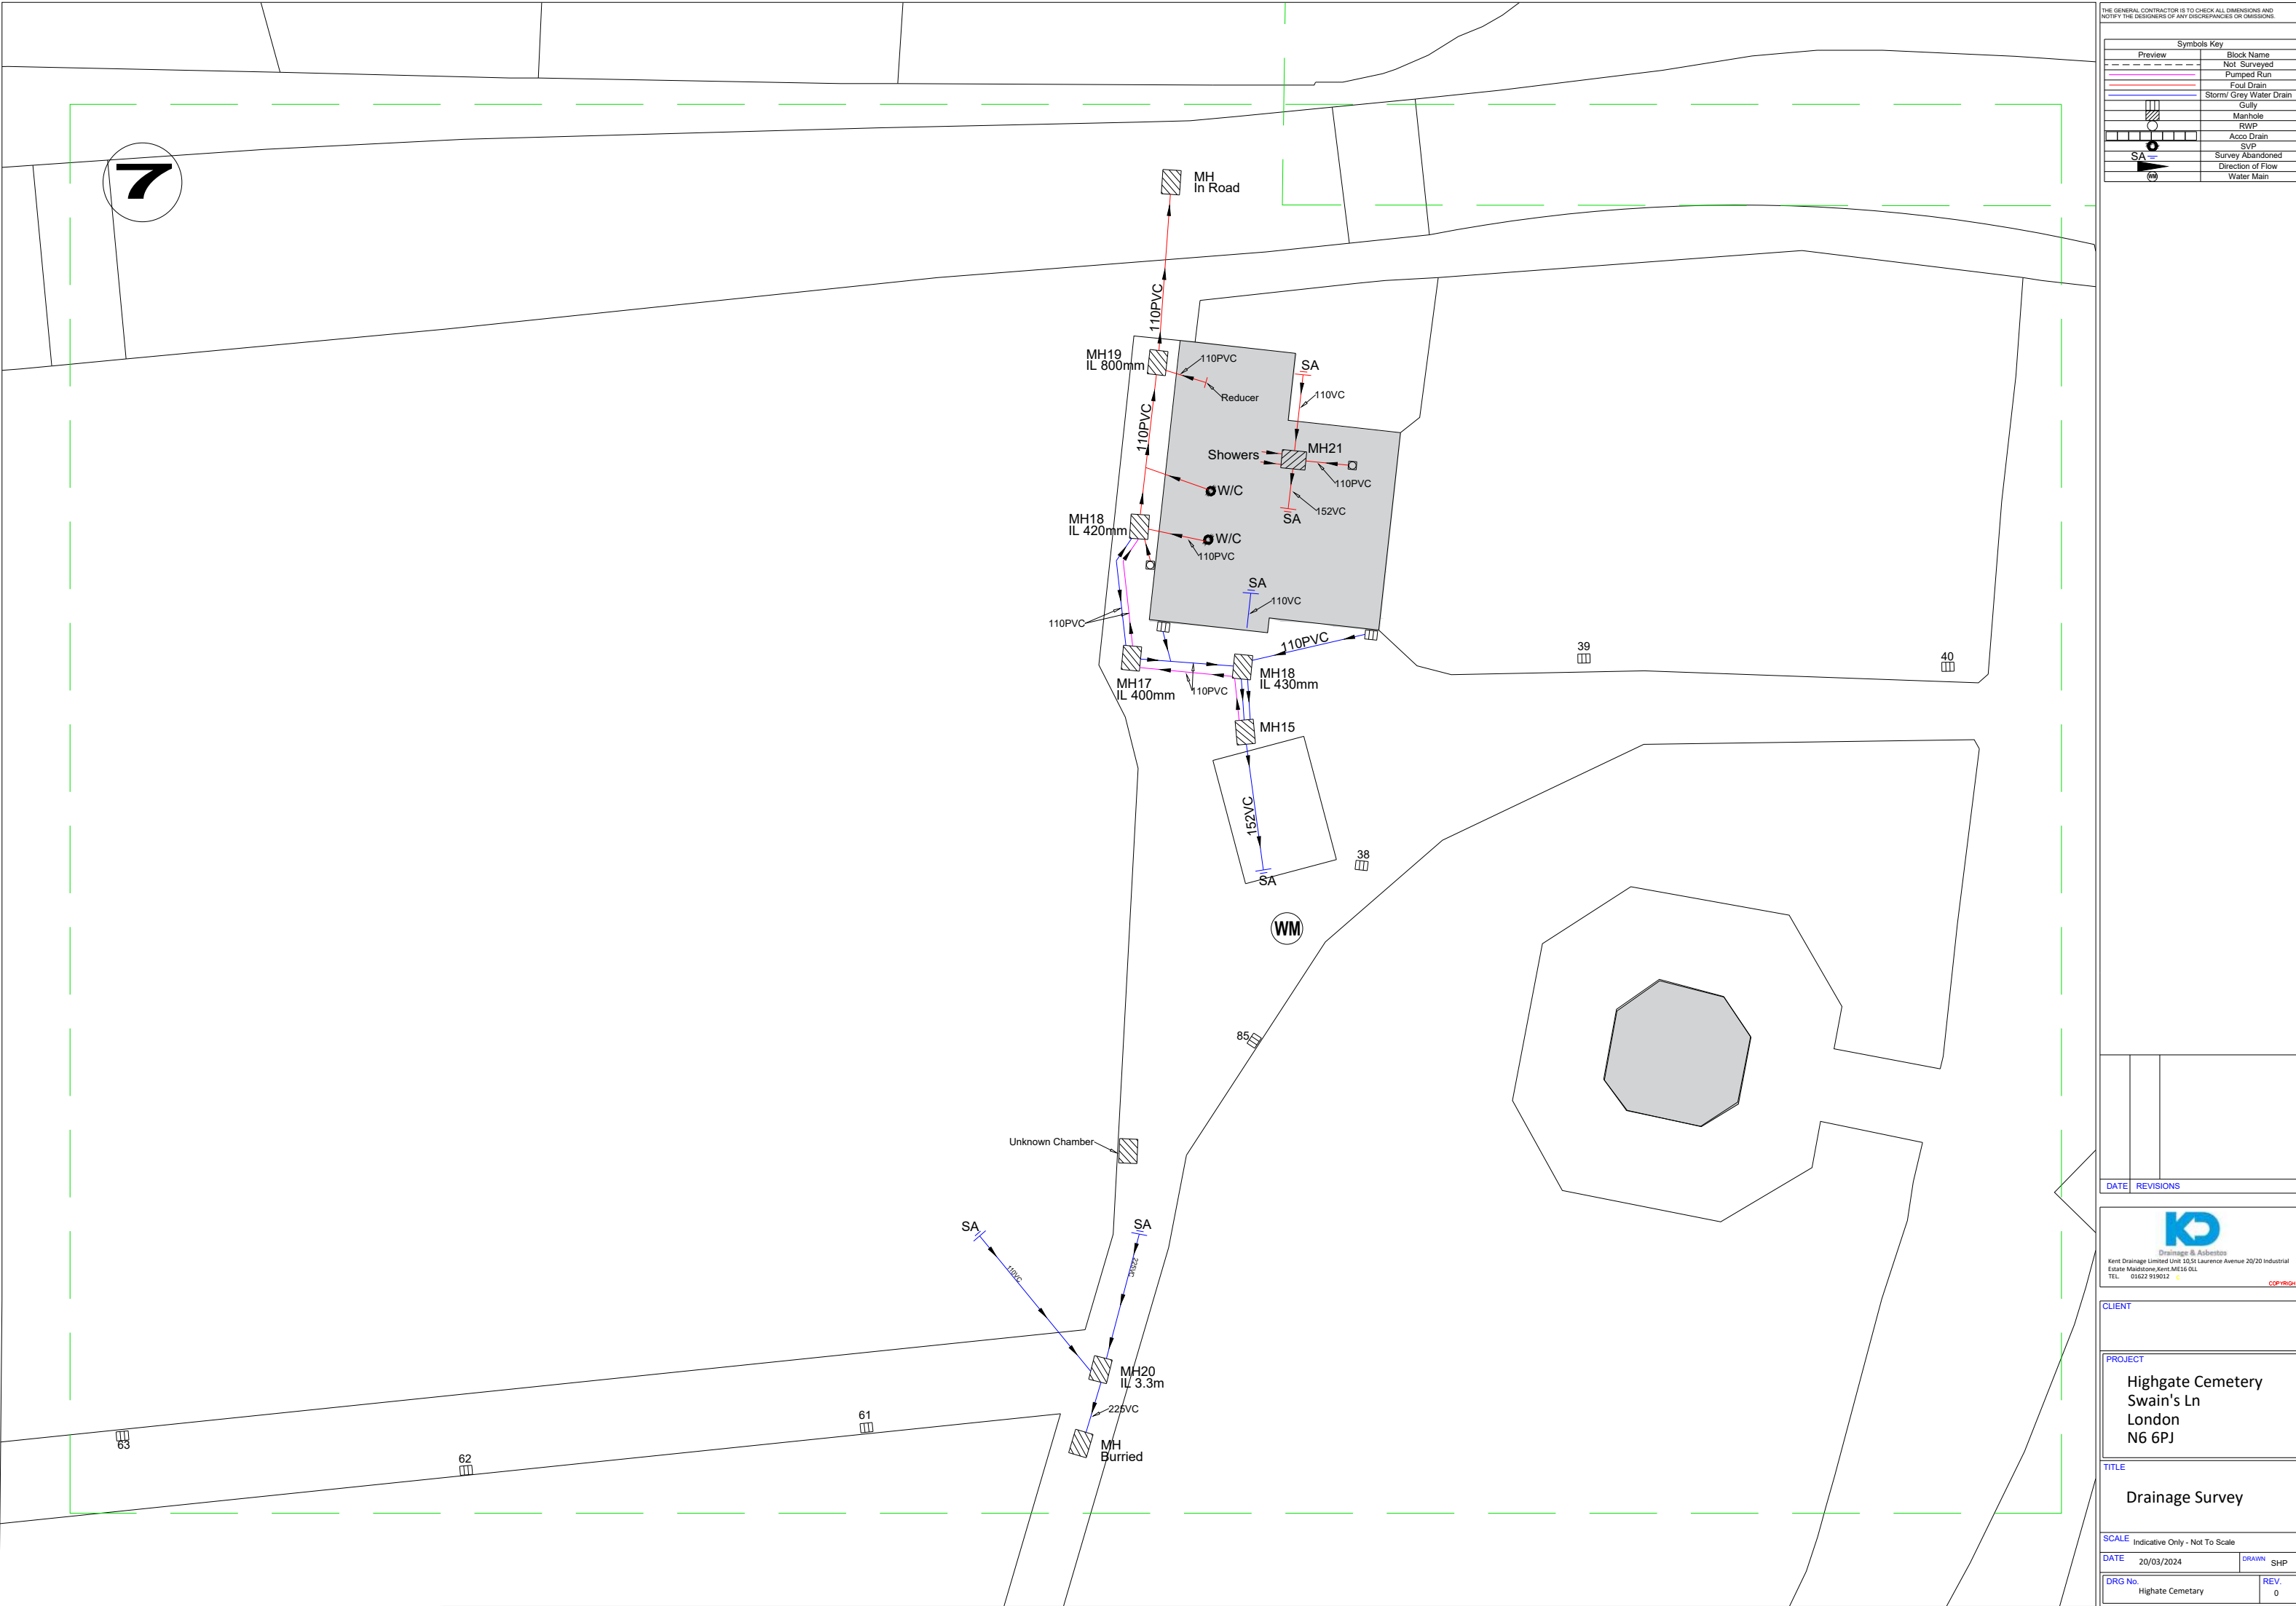

Symbols Key		
Preview	Block Name	
---	Not Surveyed	
---	Pumped Run	
---	Foul Drain	
---	Storm/ Grey Water Drain	
---	Gully	
---	Manhole	
---	RWP	
---	Acco Drain	
---	SVP	
SA	Survey Abandoned	
---	Direction of Flow	
---	Water Main	

DATE REVISIONS



Drainage & Asbestos
Kent Drainage Limited Unit 10/21 Laurence Avenue 20/20 Industrial
Estate Maidstone Kent ME16 9LL
TEL 01622 919012

CLIENT

PROJECT

Highgate Cemetery
Swain's Ln
London
N6 6PJ


TITLE

Drainage Survey

SCALE Indicative Only - Not To Scale

DATE 20/03/2024 DRAWN SHP

DRG No. Highgate Cemetery REV. 0

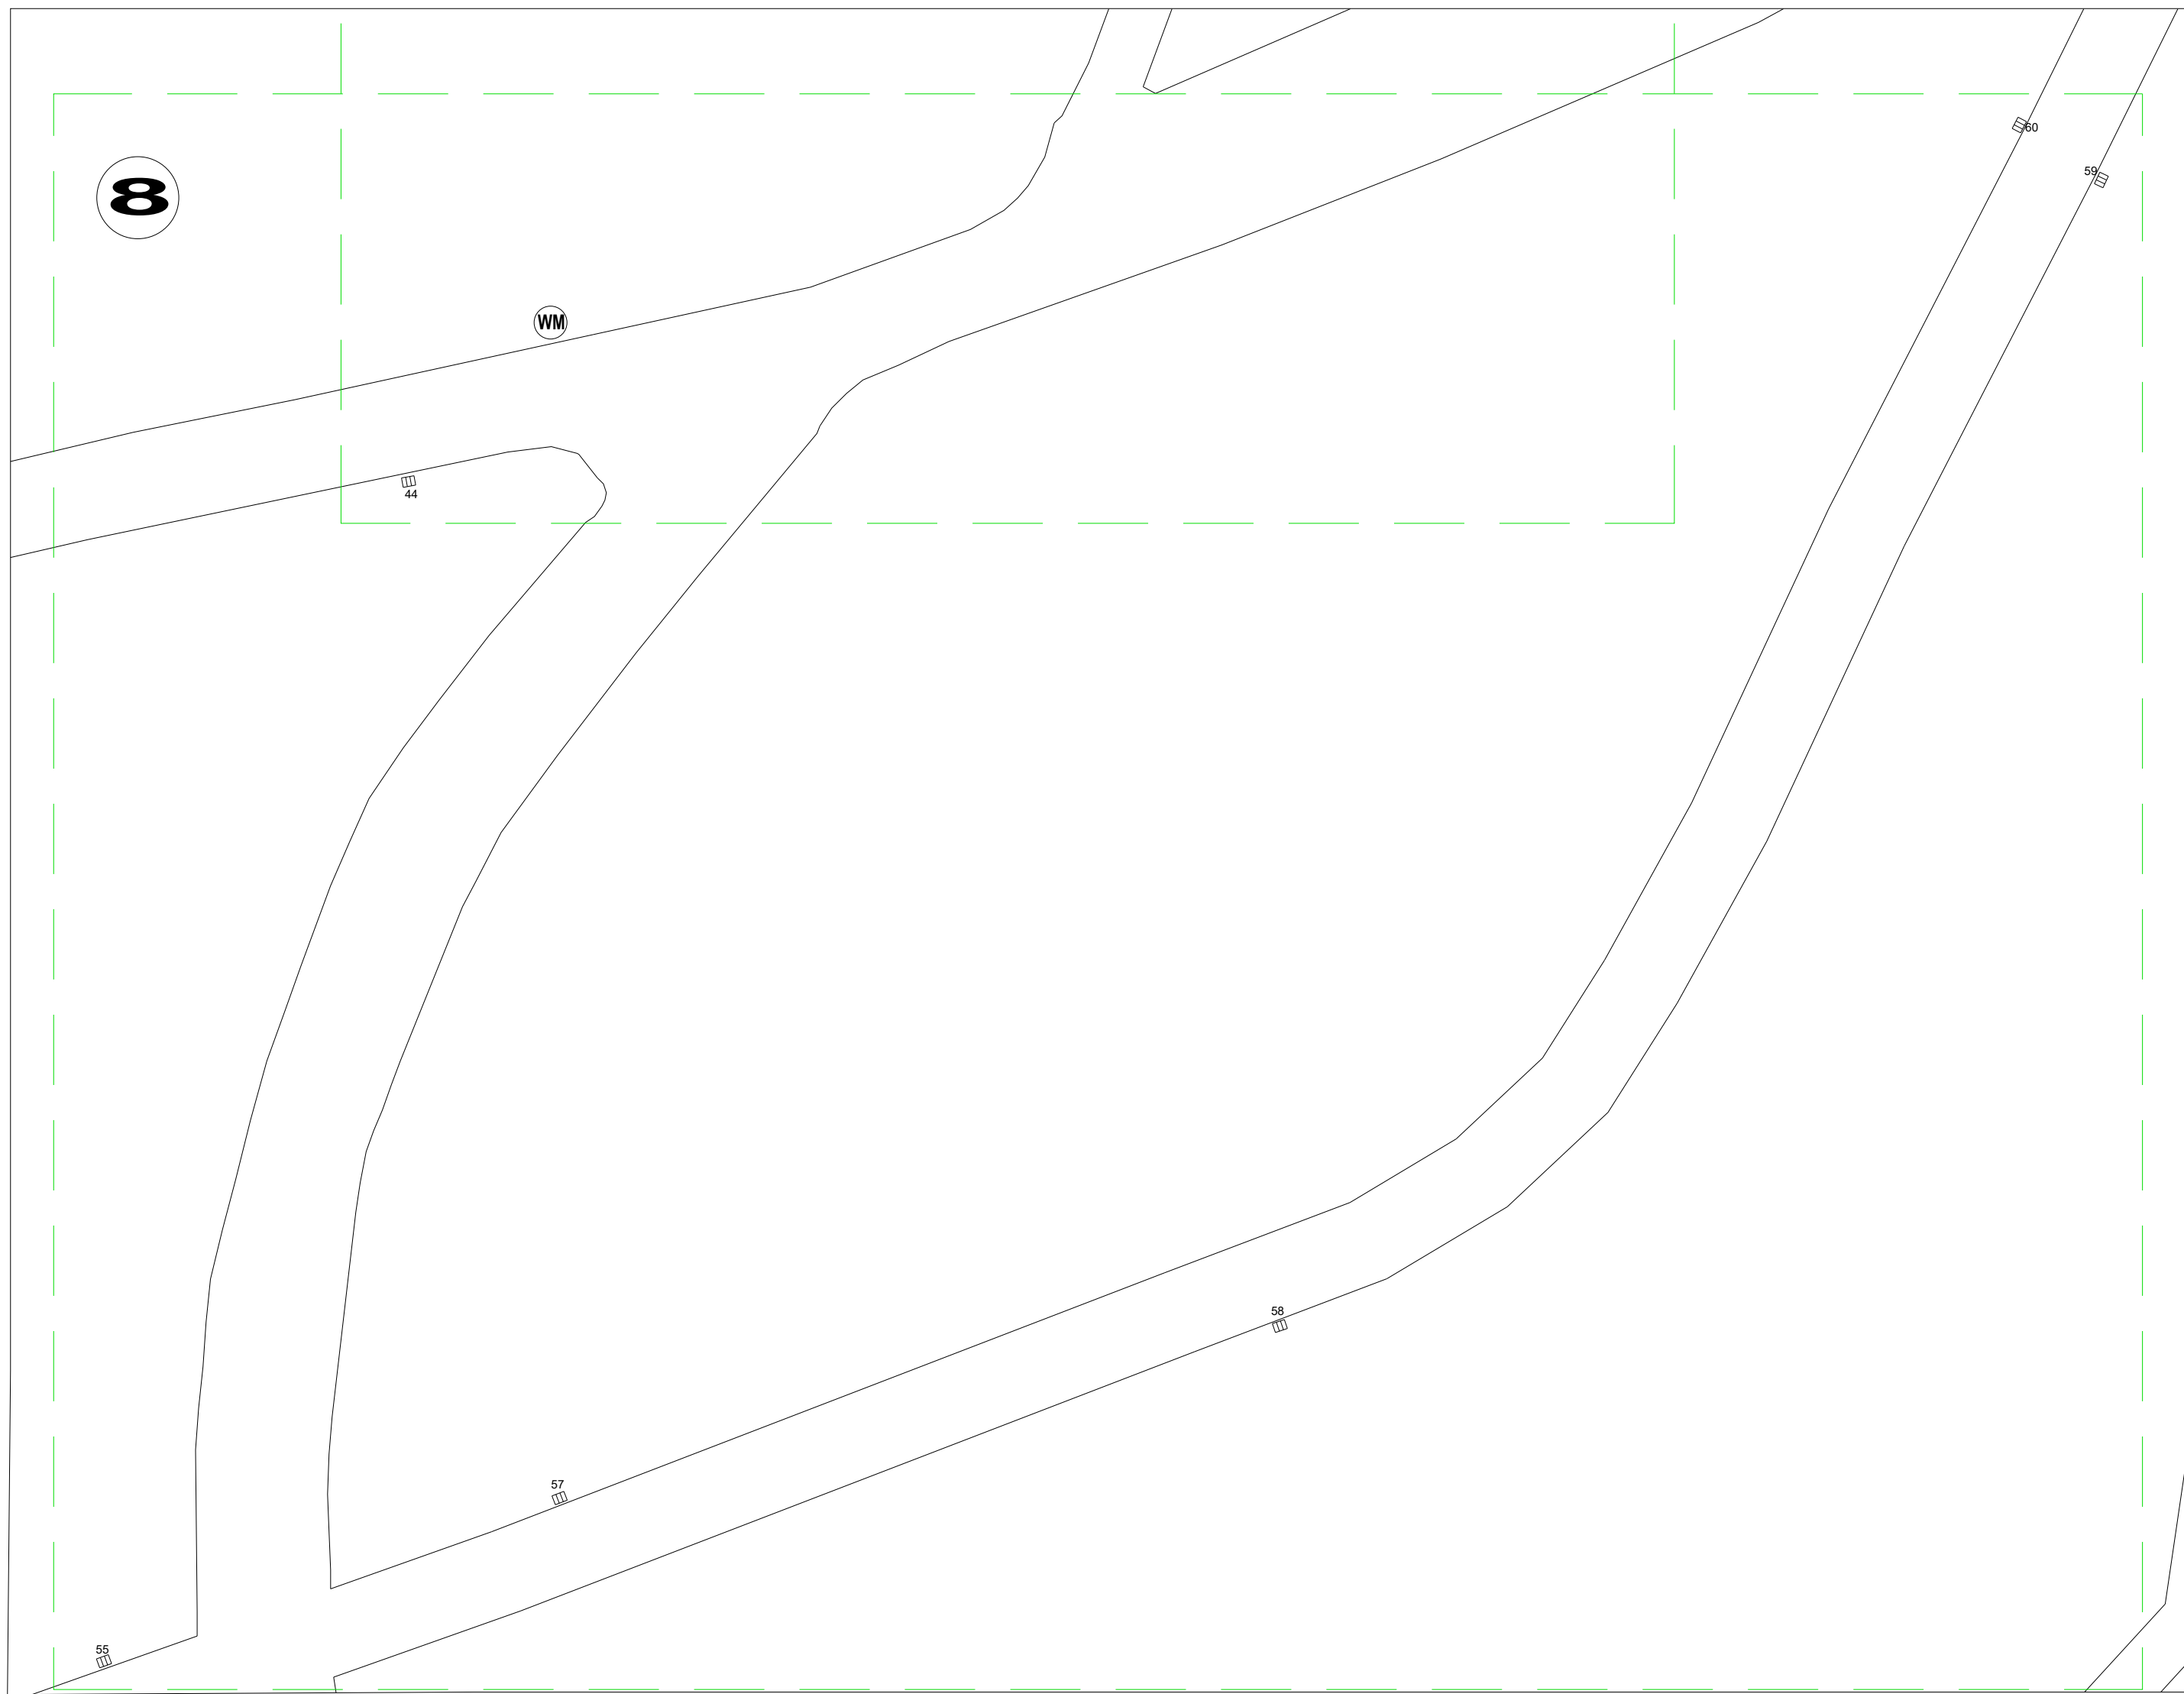

THE GENERAL CONTRACTOR IS TO CHECK ALL DIMENSIONS AND NOTIFY THE DESIGNERS OF ANY DISCREPANCIES OR OMISSIONS.	
Symbols Key	
Preview	Block Name
---	Not Surveyed
---	Pumped Run
---	Foul Drain
---	Storm/ Grey Water Drain
---	Gully
---	Manhole
---	RWP
---	Acco Drain
---	SVP
SA	Survey Abandoned
---	Direction of Flow
---	Water Main

--	--	--

DATE	REVISIONS
------	-----------



Drainage & Asbestos
Kent Drainage Limited Unit 10, St Laurence Avenue 20/20 Industrial Estate Maidstone Kent ME16 9LL
TEL 01622 919012

COPYRIGHT

CLIENT

PROJECT

Highgate Cemetery
Swain's Ln
London
N6 6PJ


TITLE

Drainage Survey

SCALE Indicative Only - Not To Scale

DATE	20/03/2024	DRAWN	SHP
------	------------	-------	-----

DRG No.	Highgate Cemetery	REV.	0
---------	-------------------	------	---

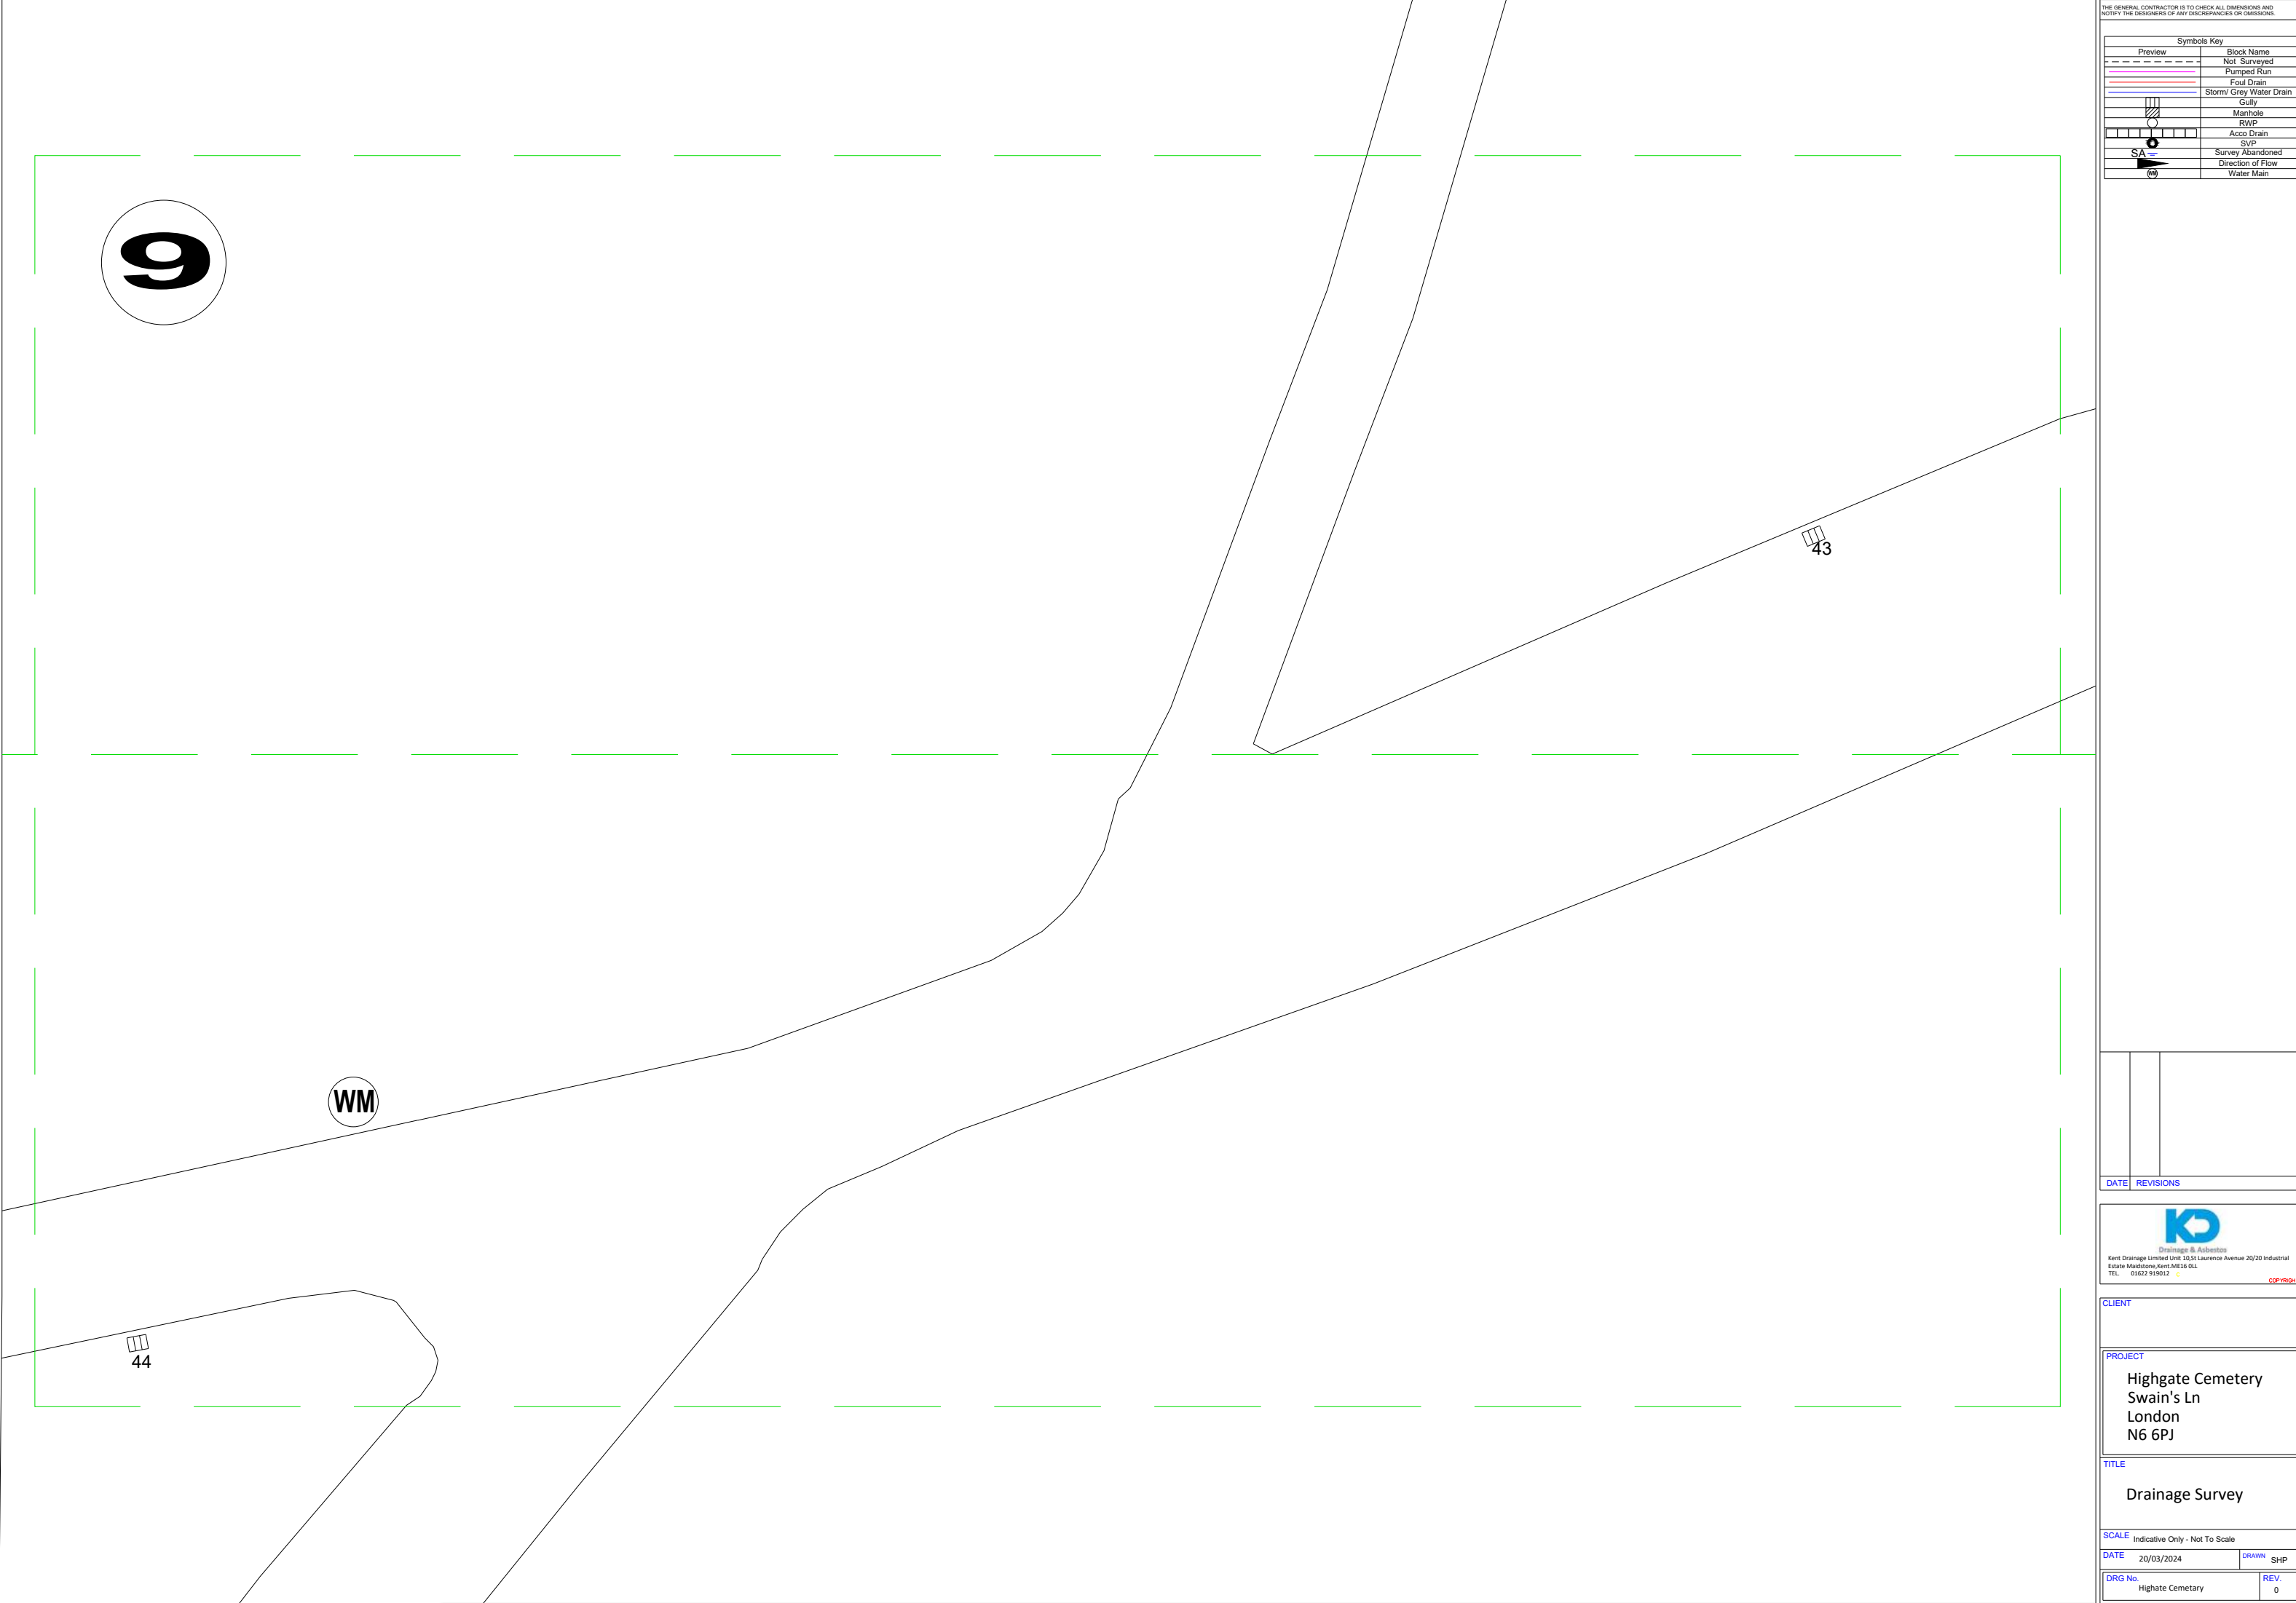

Symbols Key	
Preview	Block Name
- - - - -	Not Surveyed
- - - - -	Pumped Run
- - - - -	Foul Drain
- - - - -	Storm/ Grey Water Drain
- - - - -	Gully
- - - - -	Manhole
- - - - -	RWP
- - - - -	Acco Drain
- - - - -	SVP
- - - - -	Survey Abandoned
- - - - -	Direction of Flow
- - - - -	Water Main

DATE	REVISIONS
------	-----------



Drainage & Asbestos
Kent Drainage Limited Unit 10/21 Laurence Avenue 20/20 Industrial
Estate Maidstone Kent ME16 9LL
TEL 01622 919012

COPYRIGHT

CLIENT

PROJECT

Highgate Cemetery
Swain's Ln
London
N6 6PJ

TITLE

Drainage Survey

SCALE Indicative Only - Not To Scale

DATE	20/03/2024	DRAWN	SHP
------	------------	-------	-----

DRG No.	Highgate Cemetery	REV.	0
---------	-------------------	------	---

10

69

68

67

66

65

64

84

THE GENERAL CONTRACTOR IS TO CHECK ALL DIMENSIONS AND NOTIFY THE DESIGNERS OF ANY DISCREPANCIES OR OMISSIONS.	
Symbols Key	
Preview	Block Name
	Not Surveyed
	Pumped Run
	Foul Drain
	Storm/ Grey Water Drain
	Gully
	Manhole
	RWP
	Acco Drain
	SVP
	Survey Abandoned
	Direction of Flow
	Water Main

DATE	REVISIONS	



Drainage & Asbestos
Kent Drainage Limited Unit 10, St Laurence Avenue 20/20 Industrial Estate Maidstone Kent ME16 0LL
TEL 01622 919012

COPYRIGHT

CLIENT

PROJECT

Highgate Cemetery
Swain's Ln
London
N6 6PJ


TITLE

Drainage Survey

SCALE Indicative Only - Not To Scale

DATE	20/03/2024	DRAWN	SHP
------	------------	-------	-----

DRG No.	Highgate Cemetery	REV.	0
---------	-------------------	------	---

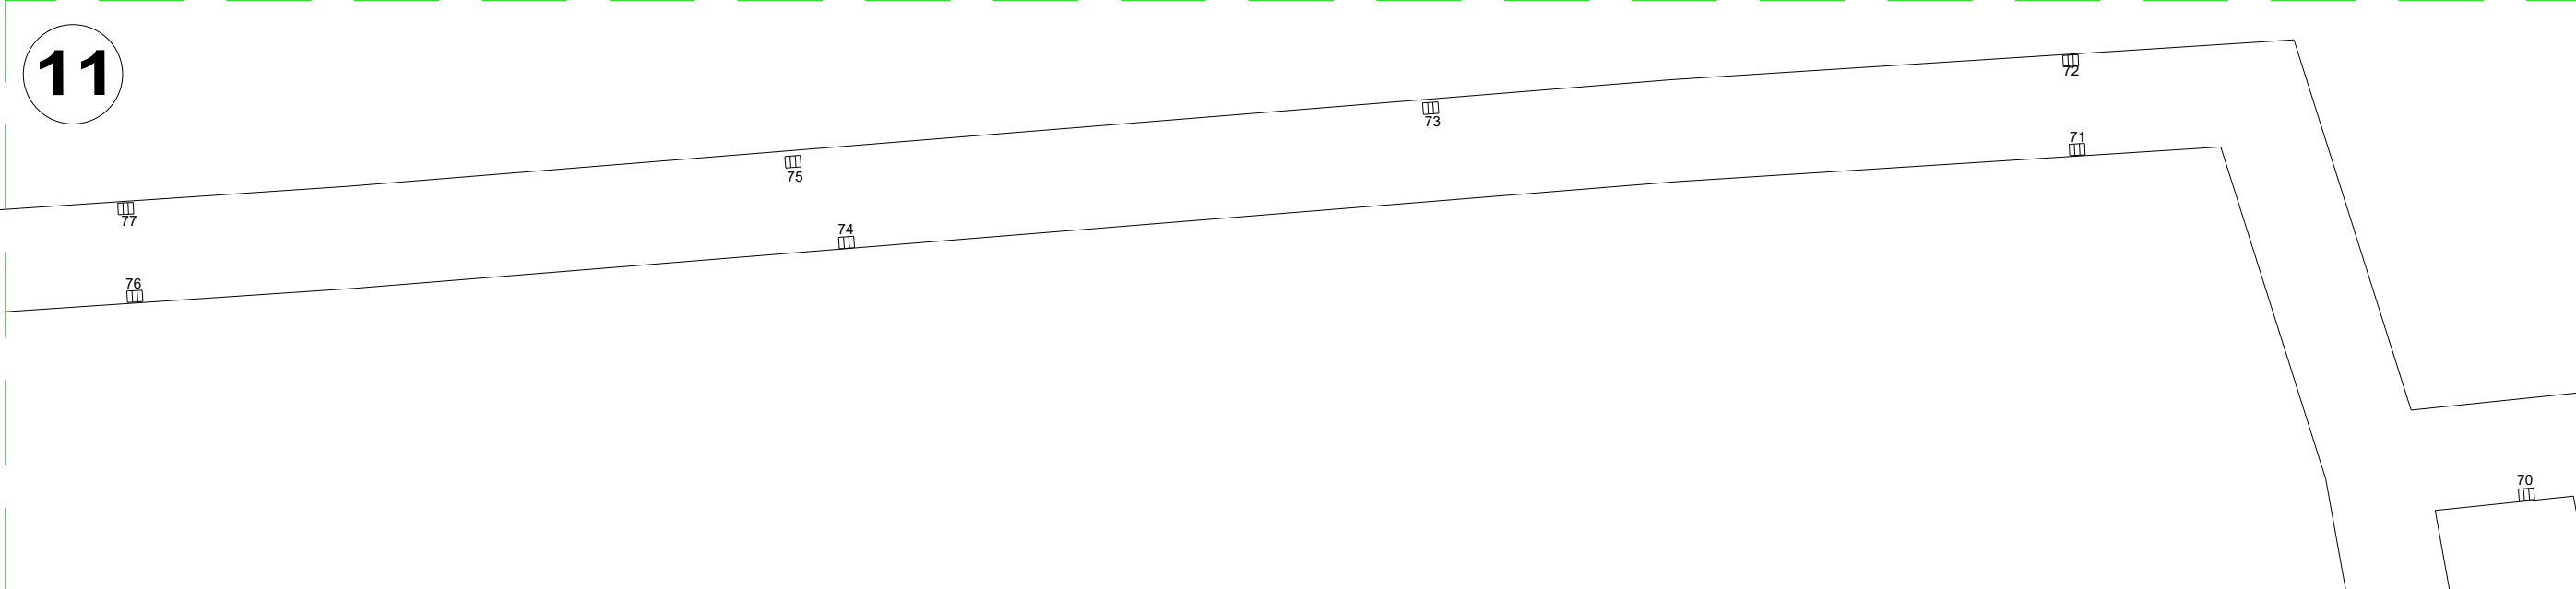

THE GENERAL CONTRACTOR IS TO CHECK ALL DIMENSIONS AND NOTIFY THE DESIGNERS OF ANY DISCREPANCIES OR OMISSIONS.

Symbols Key	
Preview	Block Name
---	Not Surveyed
---	Pumped Run
---	Foul Drain
---	Storm/ Grey Water Drain
---	Gully
---	Manhole
---	RWP
---	Acco Drain
---	SVP
SA	Survey Abandoned
---	Direction of Flow
(m)	Water Main

DATE	REVISIONS	



Drainage & Asbestos
Kent Drainage Limited Unit 10/21 Laurence Avenue 20/20 Industrial Estate Maidstone Kent ME16 0LL
TEL 01622 919012

Copyright

CLIENT


PROJECT
Highgate Cemetery
Swain's Ln
London
N6 6PJ

TITLE
Drainage Survey

SCALE Indicative Only - Not To Scale

DATE 20/03/2024 DRAWN SHP

DRG No. Highgate Cemetery REV. 0

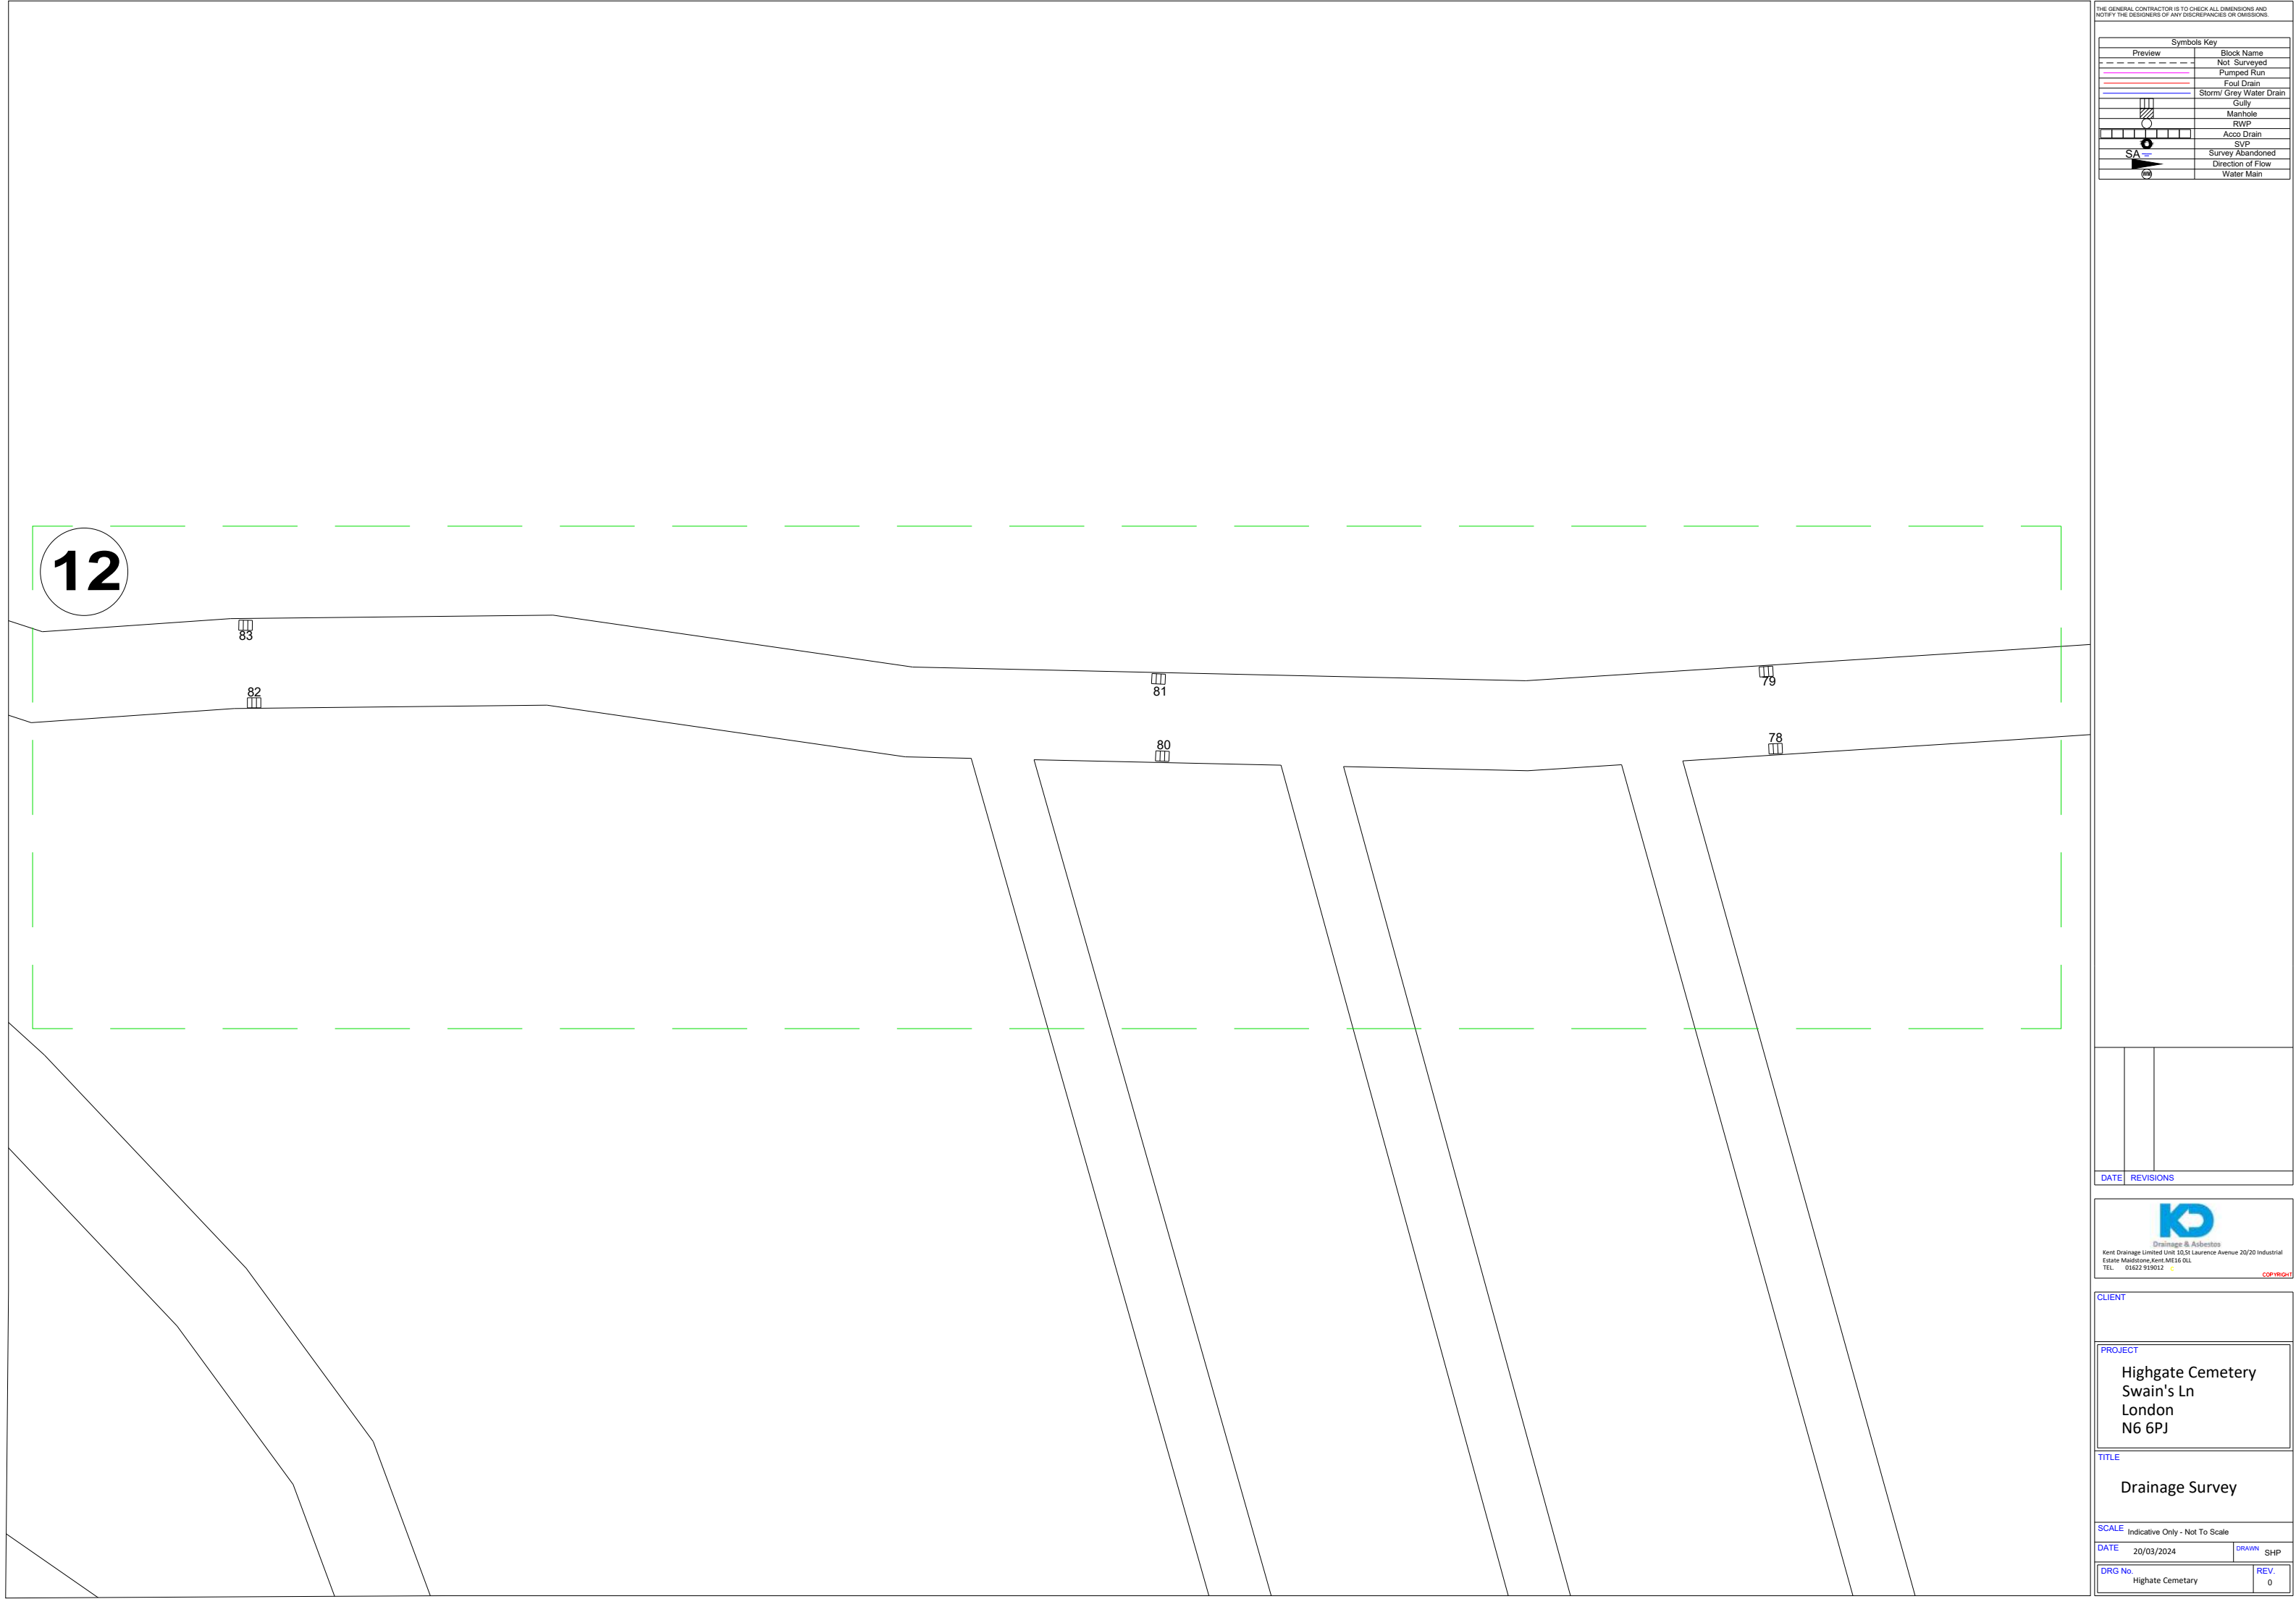

Symbols Key	
Preview	Block Name
- - - - -	Not Surveyed
- - - - -	Pumped Run
- - - - -	Foul Drain
- - - - -	Storm/ Grey Water Drain
- - - - -	Gully
- - - - -	Manhole
- - - - -	RWP
- - - - -	Acco Drain
- - - - -	SVP
- - - - -	Survey Abandoned
- - - - -	Direction of Flow
- - - - -	Water Main

DATE	REVISIONS	



Drainage & Asbestos
Kent Drainage Limited Unit 10/21 Laurence Avenue 20/20 Industrial
Estate Maidstone Kent ME16 9LL
TEL 01622 919012

COPYRIGHT

CLIENT

PROJECT

Highgate Cemetery
Swain's Ln
London
N6 6PJ


TITLE

Drainage Survey

SCALE Indicative Only - Not To Scale

DATE 20/03/2024 DRAWN SHP

DRG No.	Highgate Cemetery	REV.	0
---------	-------------------	------	---

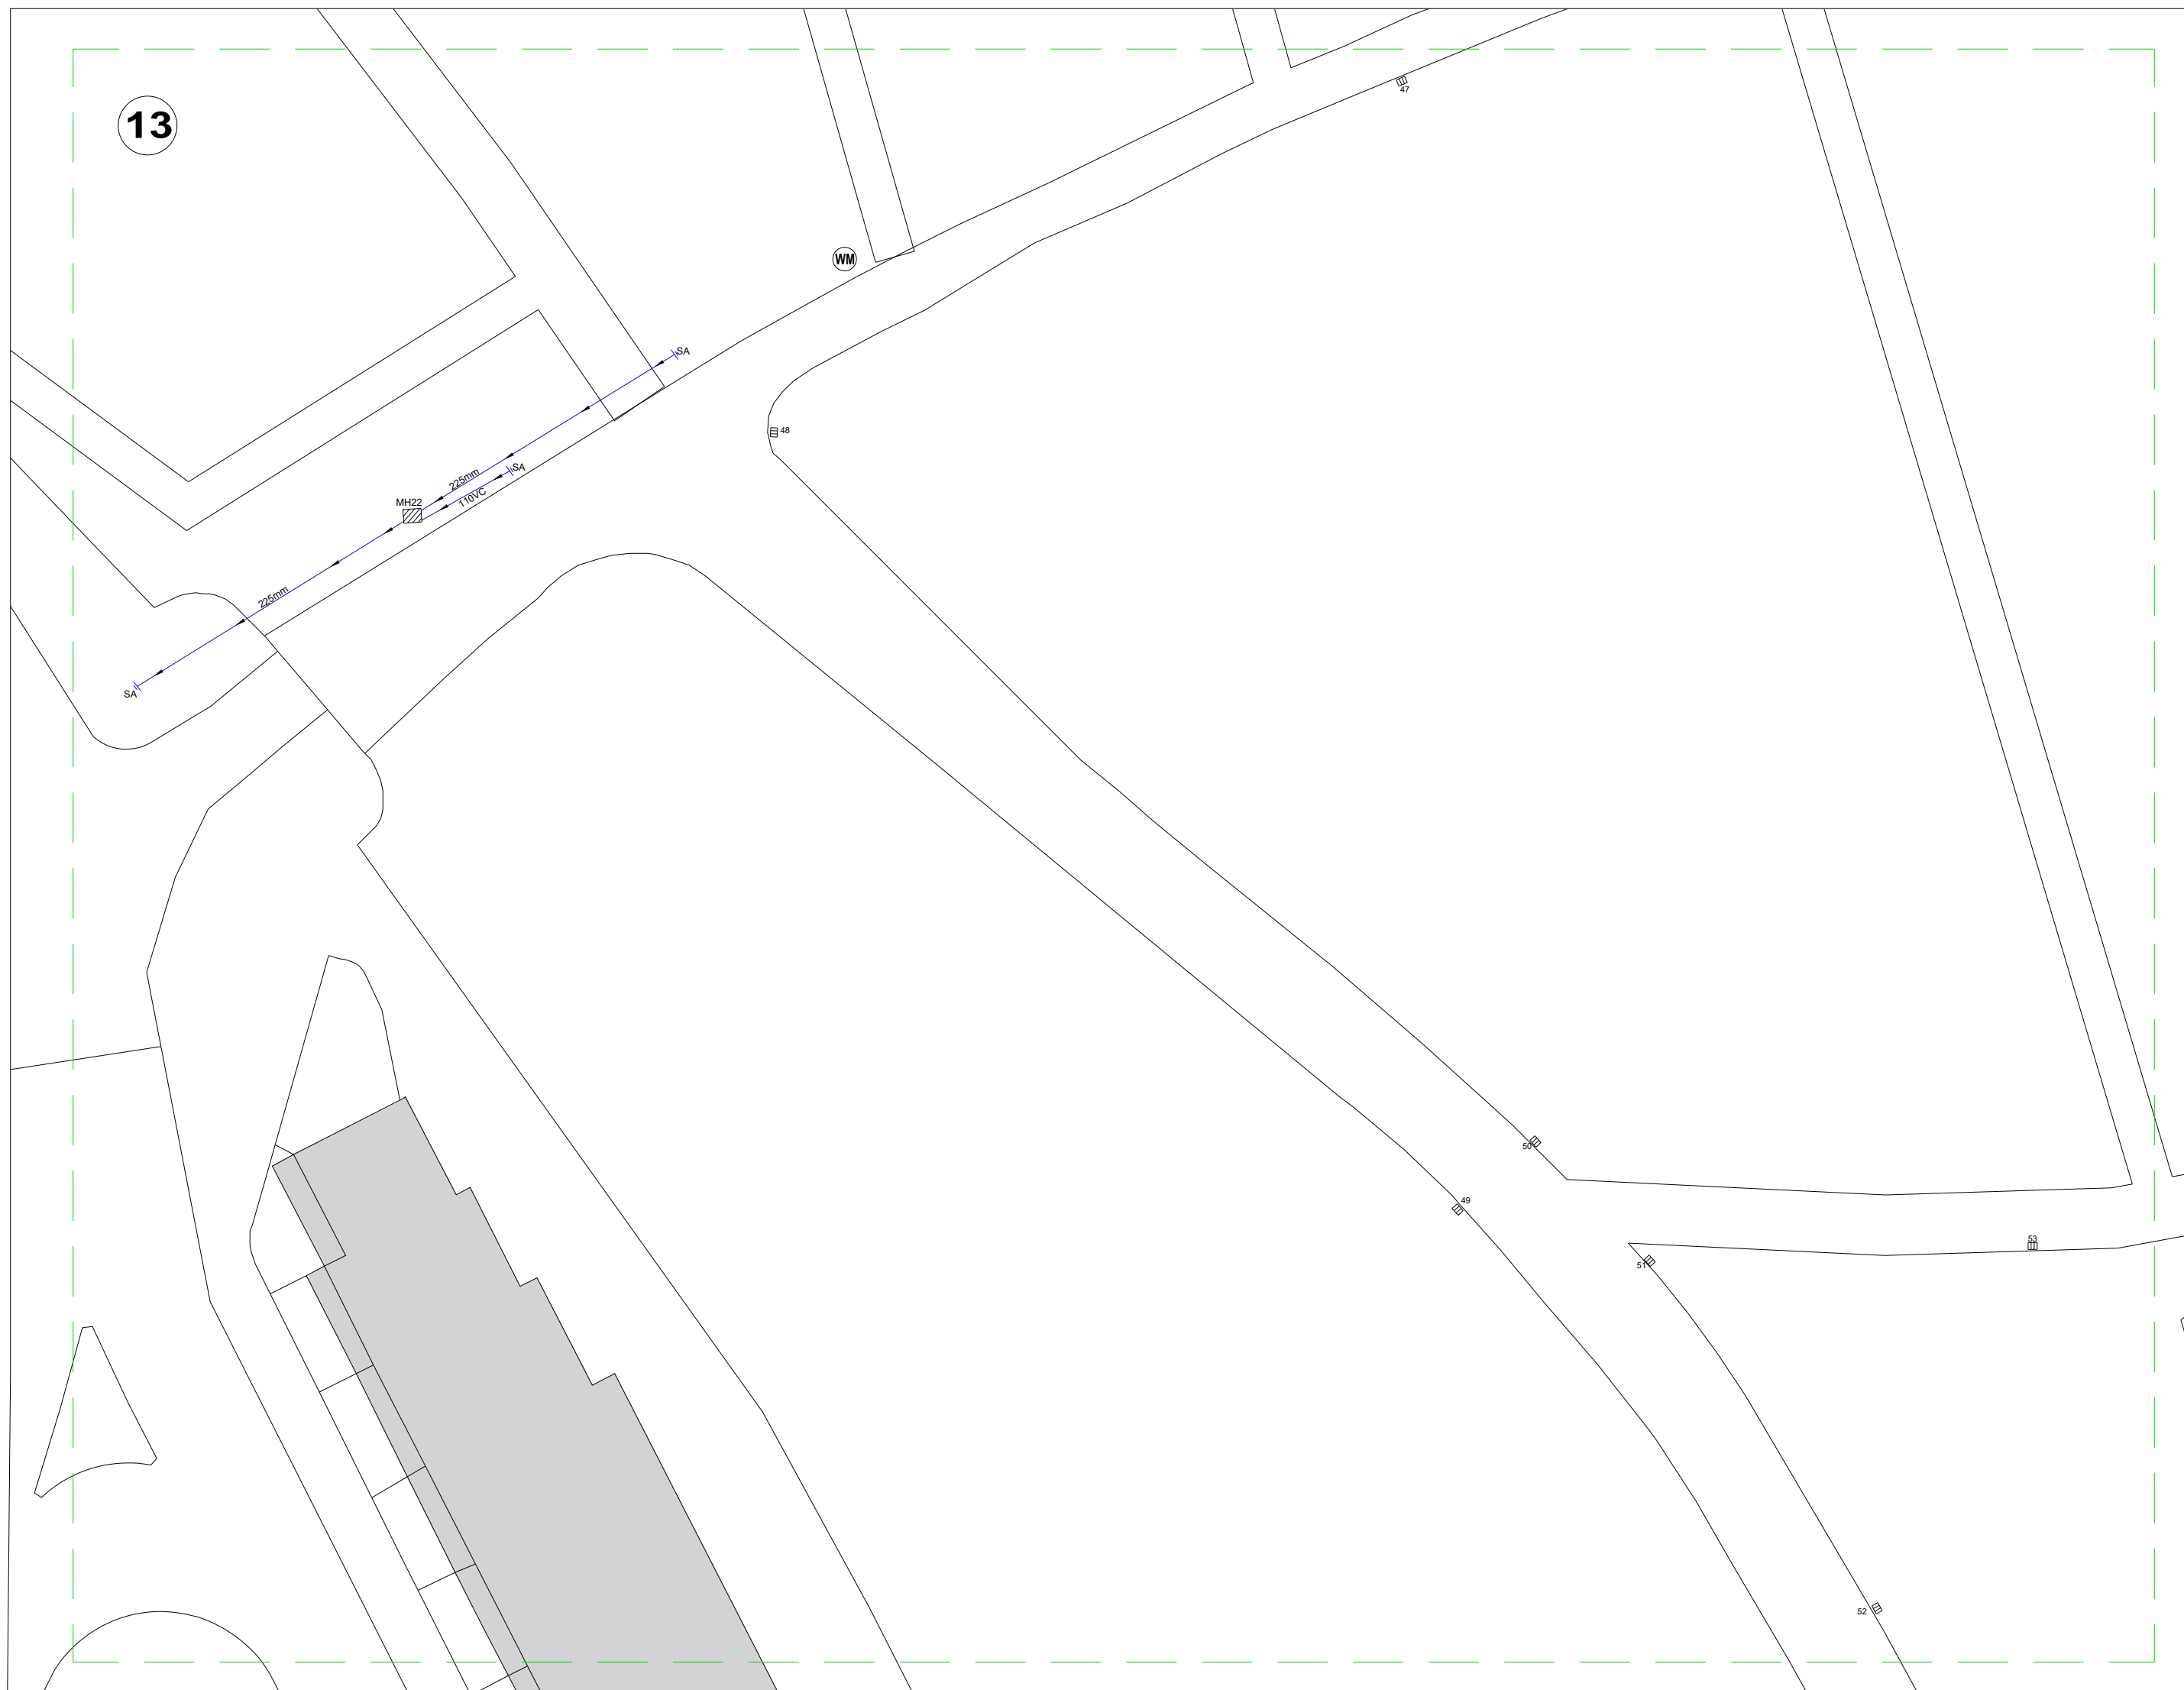

13

THE GENERAL CONTRACTOR IS TO CHECK ALL DIMENSIONS AND NOTIFY THE DESIGNERS OF ANY DISCREPANCIES OR OMISSIONS.

Symbols Key	
Preview	Block Name
---	Not Surveyed
---	Pumped Run
---	Foul Drain
---	Storm/ Grey Water Drain
---	Gully
---	Manhole
---	RWP
---	Acco Drain
---	SVP
SA	Survey Abandoned
---	Direction of Flow
---	Water Main

CLIENT

PROJECT

Highgate Cemetery
Swain's Ln
London
N6 6PJ

TITLE

Drainage Survey

SCALE Indicative Only - Not To Scale

DATE 20/03/2024 **DRAWN** SHP

DRG No. Highgate Cemetery **REV.** 0

Shaft
D

56

WM

56

54

East Cer

Symbols Key	
Preview	Block Name
	Not Surveyed
	Pumped Run
	Foul Drain
	Storm/ Grey Water Drain
	Gully
	Manhole
	RWP
	Acco Drain
	SVP
	Survey Abandoned
	Direction of Flow
	Water Main

DATE REVISIONS



Drainage & Asbestos
Kent Drainage Limited Unit 10/21 Laurence Avenue 20/20 Industrial
Estate Maidstone Kent ME16 9LL
TEL 01622 919012

Copyright

CLIENT

PROJECT

Highgate Cemetery
Swain's Ln
London
N6 6PJ


TITLE

Drainage Survey

SCALE Indicative Only - Not To Scale

DATE 20/03/2024 DRAWN SHP

DRG No. Highate Cemetary REV. 0

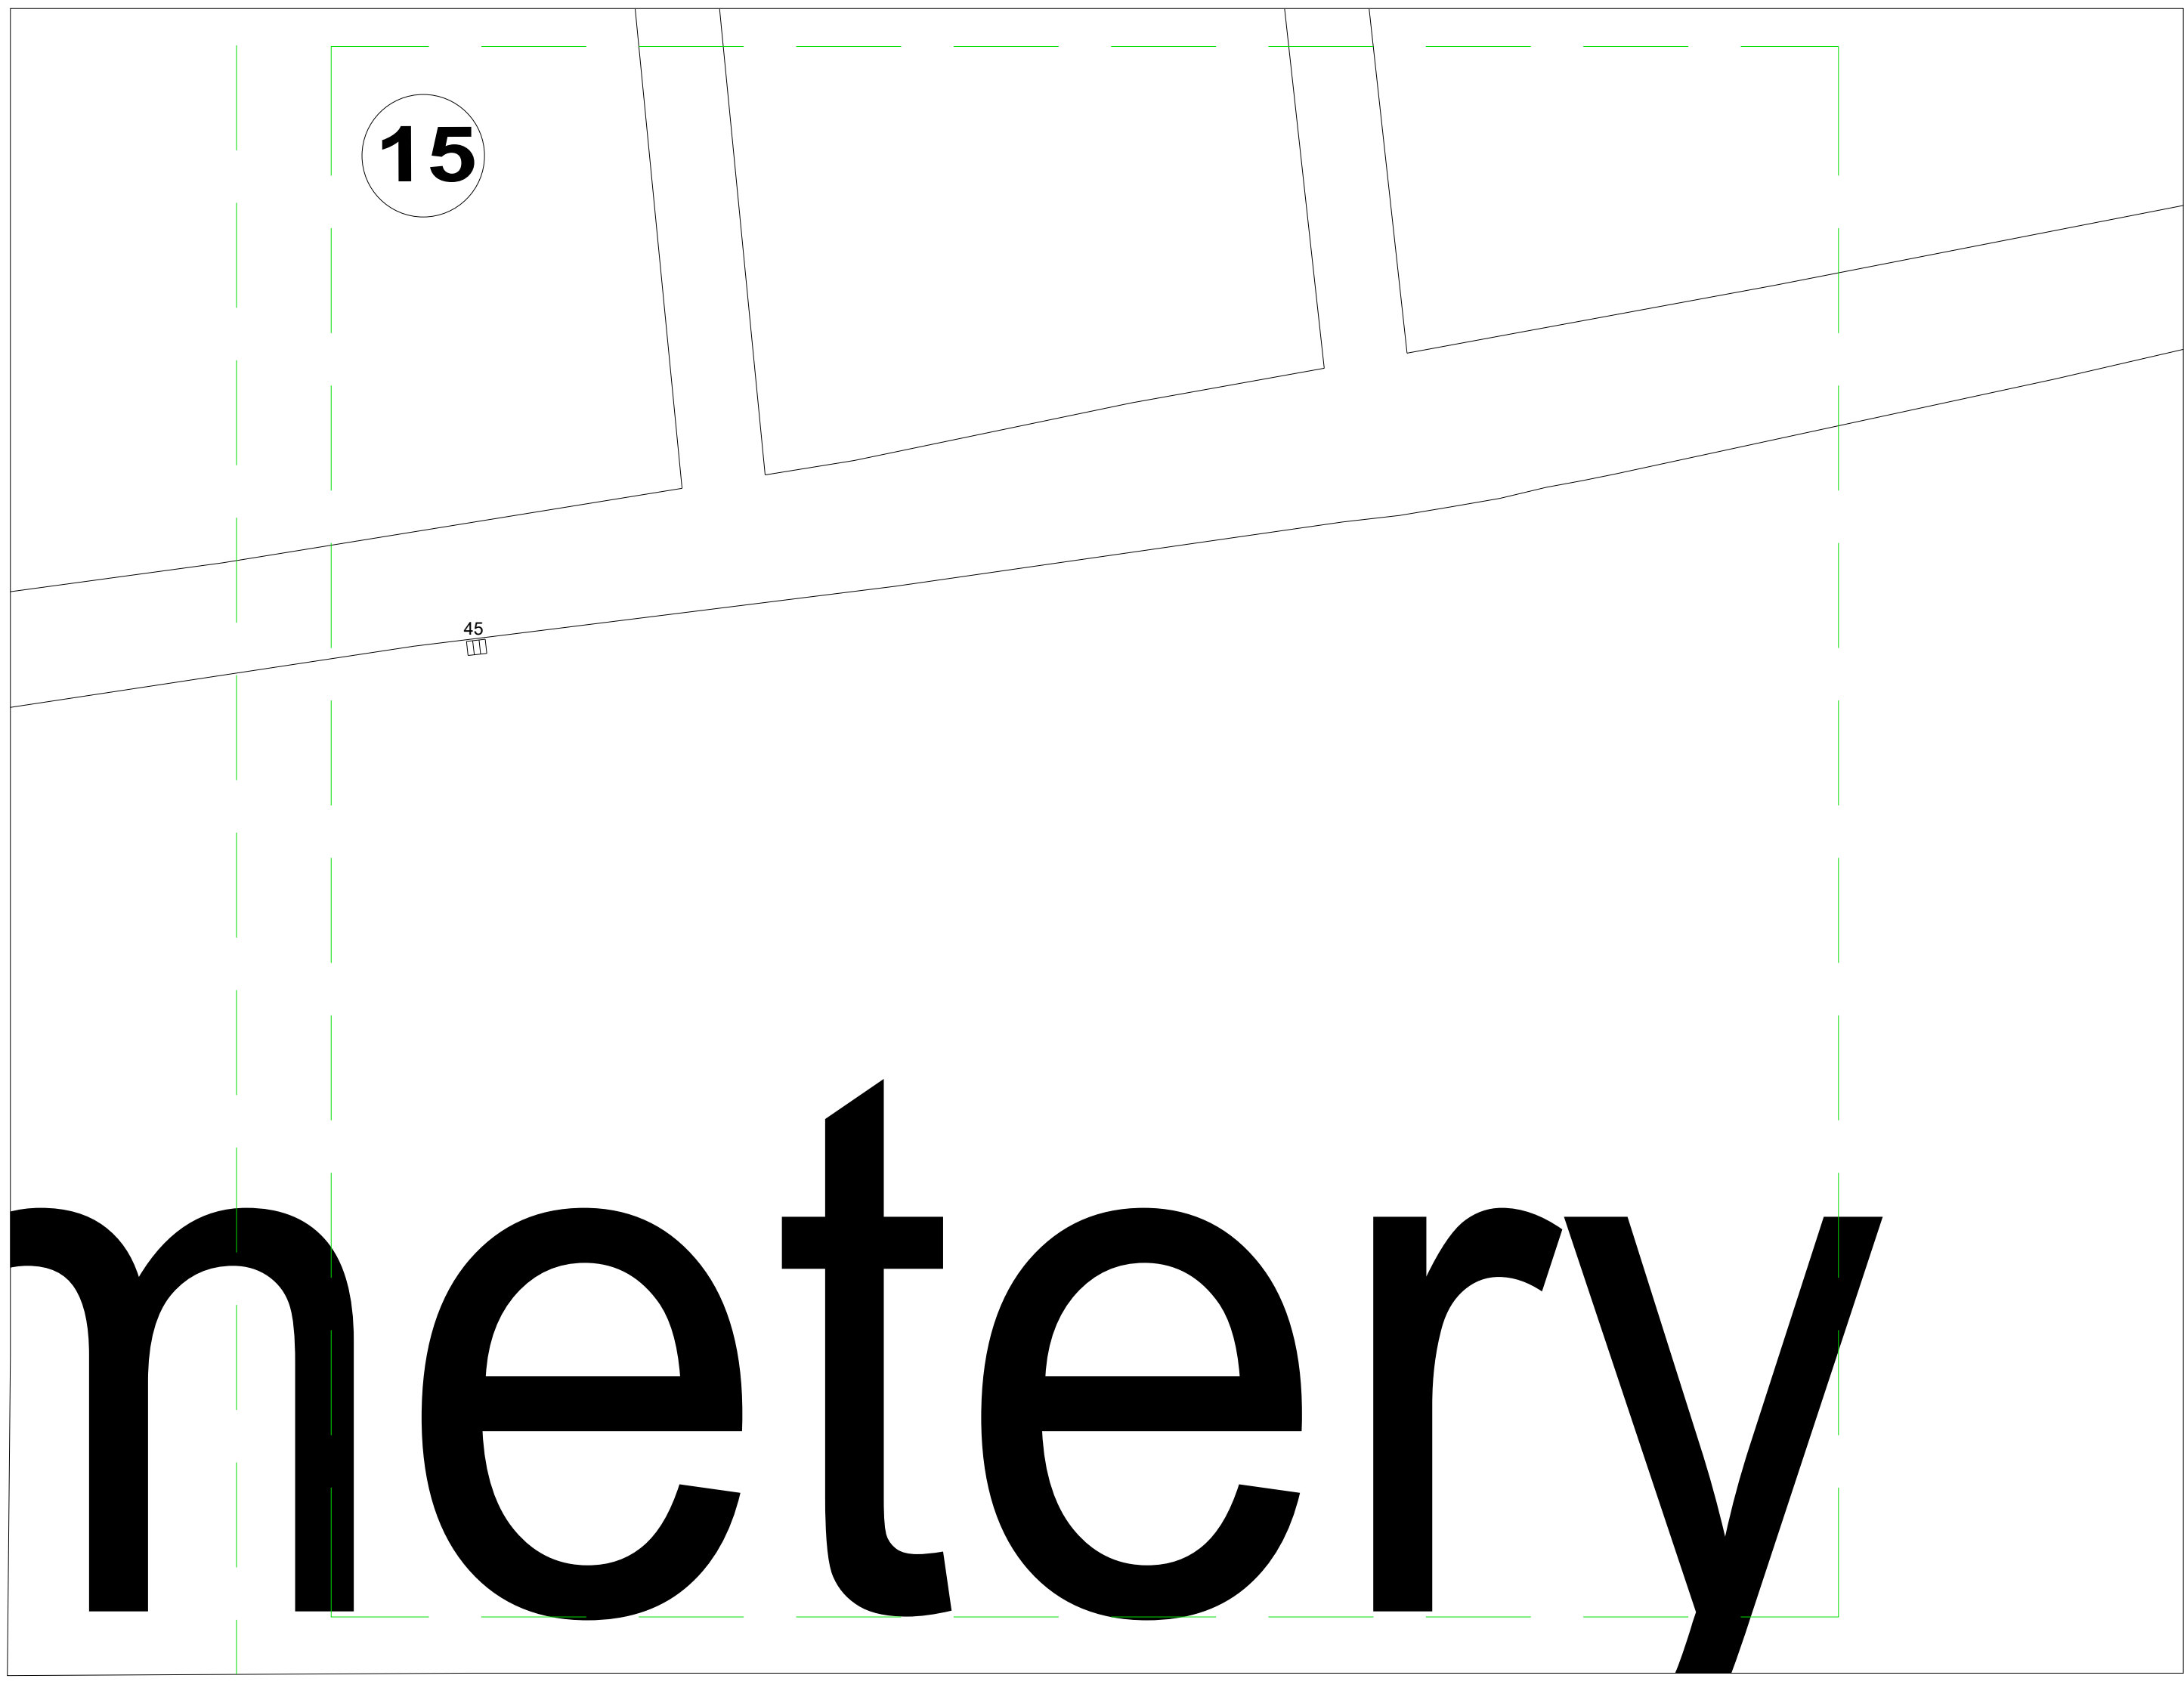

THE GENERAL CONTRACTOR IS TO CHECK ALL DIMENSIONS AND NOTIFY THE DESIGNERS OF ANY DISCREPANCIES OR OMISSIONS.

Symbols Key	
	Block Name
	Not Surveyed
	Pumped Run
	Foul Drain
	Storm/ Grey Water Drain
	Gully
	Manhole
	RWP
	Acco Drain
	SVP
	Survey Abandoned
	Direction of Flow
	Water Main

DATE	REVISIONS	

Drainage & Asbestos
Kent Drainage Limited Unit 10, 51 Laurence Avenue 20/20 Industrial
Estate Maidstone Kent ME16 0LL
TEL 01622 919012

COPYRIGHT

CLIENT

PROJECT

Highgate Cemetery
Swain's Ln
London
N6 6PJ

TITLE

Drainage Survey

SCALE Indicative Only - Not To Scale


DATE 20/03/2024 DRAWN SHP

DRG No. Highate Cemetery REV. 0



by
Block Name
Blocked Drain
Combined Drain
Foul Drain
Storm Drain
Direction of Flow
Gully
Manhole
RWP
Road Gully
Rodding Eye

Symbols Key	
Preview	Block Name
	Blocked Drain
	Combined Drain
	Foul Drain
	Storm/ Grey Water Drain
	Gully
	Manhole
	RWP
	Road Gully
	Rodding Eye
	SVP
	Tank
	Direction of Flow

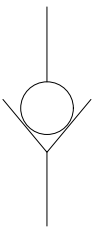

MH_Ref-FW 1
AS_IL-10.000

[illegible]



A-squared Studio

A-squared Studio Engineers Ltd

One Westminster Bridge Rd
London, SE1 7XW

020 7620 2868

contact@a2-studio.com

www.a2-studio.com

