

University College of London – Compliance Project

UPN237 - Great Ormond Street Institute of Child Health

Planning Details

Description of Works

The proposed works comprises of mechanical and electrical works that are required to meet Home Office compliance that is directly related to the control of the temperature and humidity and maintaining the required ventilation rates.

Mechanical & Electrical

There are 6 existing AHUs that are dedicated to the facility which require either refurbishment or replacement (detailed below) due to increased ventilation rates required to meet home office compliance and the condition of the equipment that is also nearing end of life.

The replacement AHU 03 and components within the remaining AHU's will be constructed in accordance with Ecodesign (ErP) directive.

Installation of 2 new split AC condensers to serve the Laboratory rooms.

All redundant plant emanating from these works will be removed.

- AHU 54 Extract - Refurbishment of component parts within existing casing
- AHU 55 Supply - Refurbishment of component parts within existing casing
- AHU 57 Extract - Refurbishment of component parts within existing casing
- AHU 58 Supply - Refurbishment of component parts within existing casing
- AHU 03 Supply - Complete replacement of unit
- Condenser unit 1 - Replacement unit to supply Laboratory room
- Condenser unit 2 - New unit to supply Laboratory room




Due to the clean areas in the facilities the supply diffuser has HEPA filters that have 6nr CAVs, as these are life expired and difficult to re-commissioned to the new ventilation rates, these are being replaced.

Location of Equipment


The location of the existing equipment is located on the level 5 roof of the building and can be seen on the below layout drawing, with the new locations of the additional humidifiers shown in red.

The following key colours will be used to identify the plant on the drawings below:

- Green – Plant to be replaced
- Yellow – Plant to be refurbished
- Red – New plant to be installed

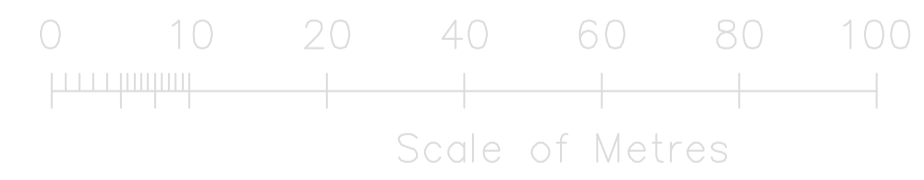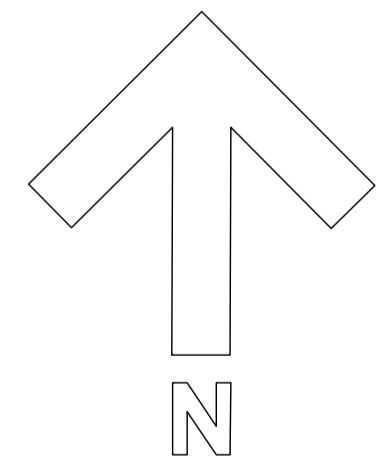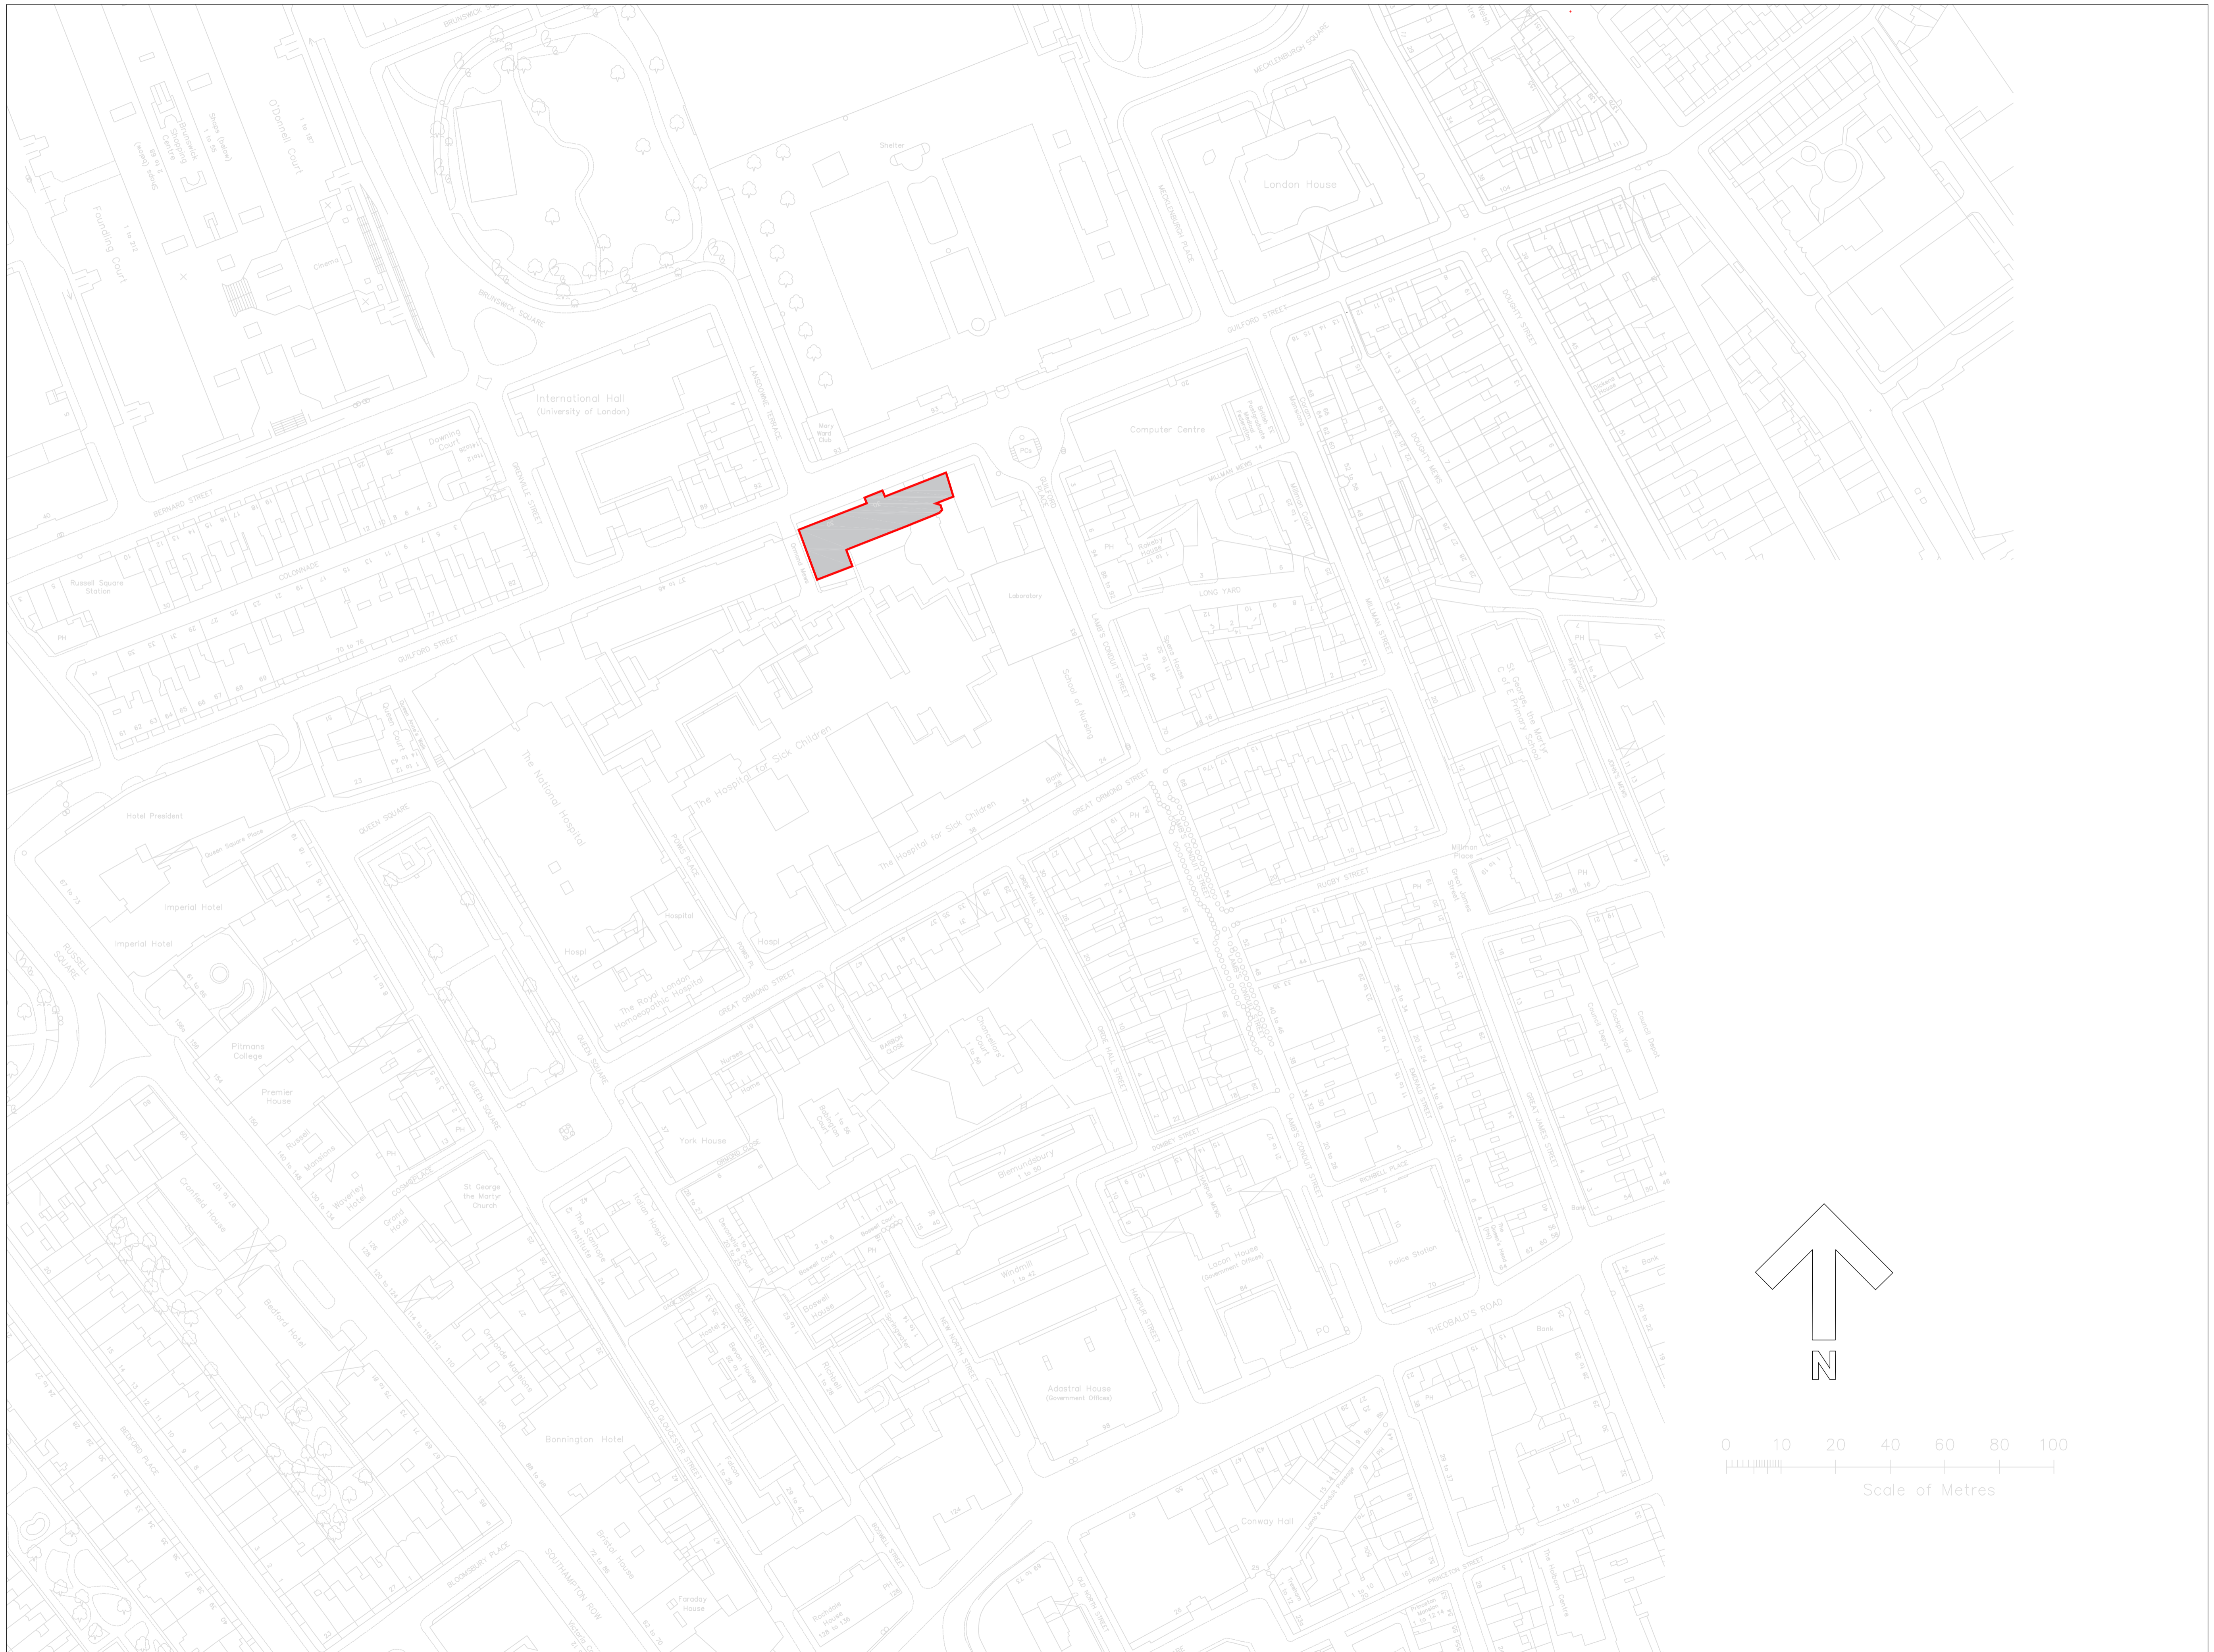


REV	DESCRIPTION	DATE
STATUS: Planning Approval		
CLIENT: University College London		
PROJECT: UCL BSU Compliance Project		
DRAWING TITLE: UPN237 Site Location Plan		
 MAKING BUILDINGS WORK BETTER.		
5 BEAUFORT HOUSE, BEAUFORT COURT, SIR THOMAS LONGLEY WAY, MEDWAY CITY ESTATE, ROCHESTER, KENT ME2 4FB		
DATE:	NOV 2024	DRAWN BY: CS
SCALE:	1:1250@A1	APP BY: IMcG
DRAWING NO.:	DMA-237-PP-001	Rev: 00

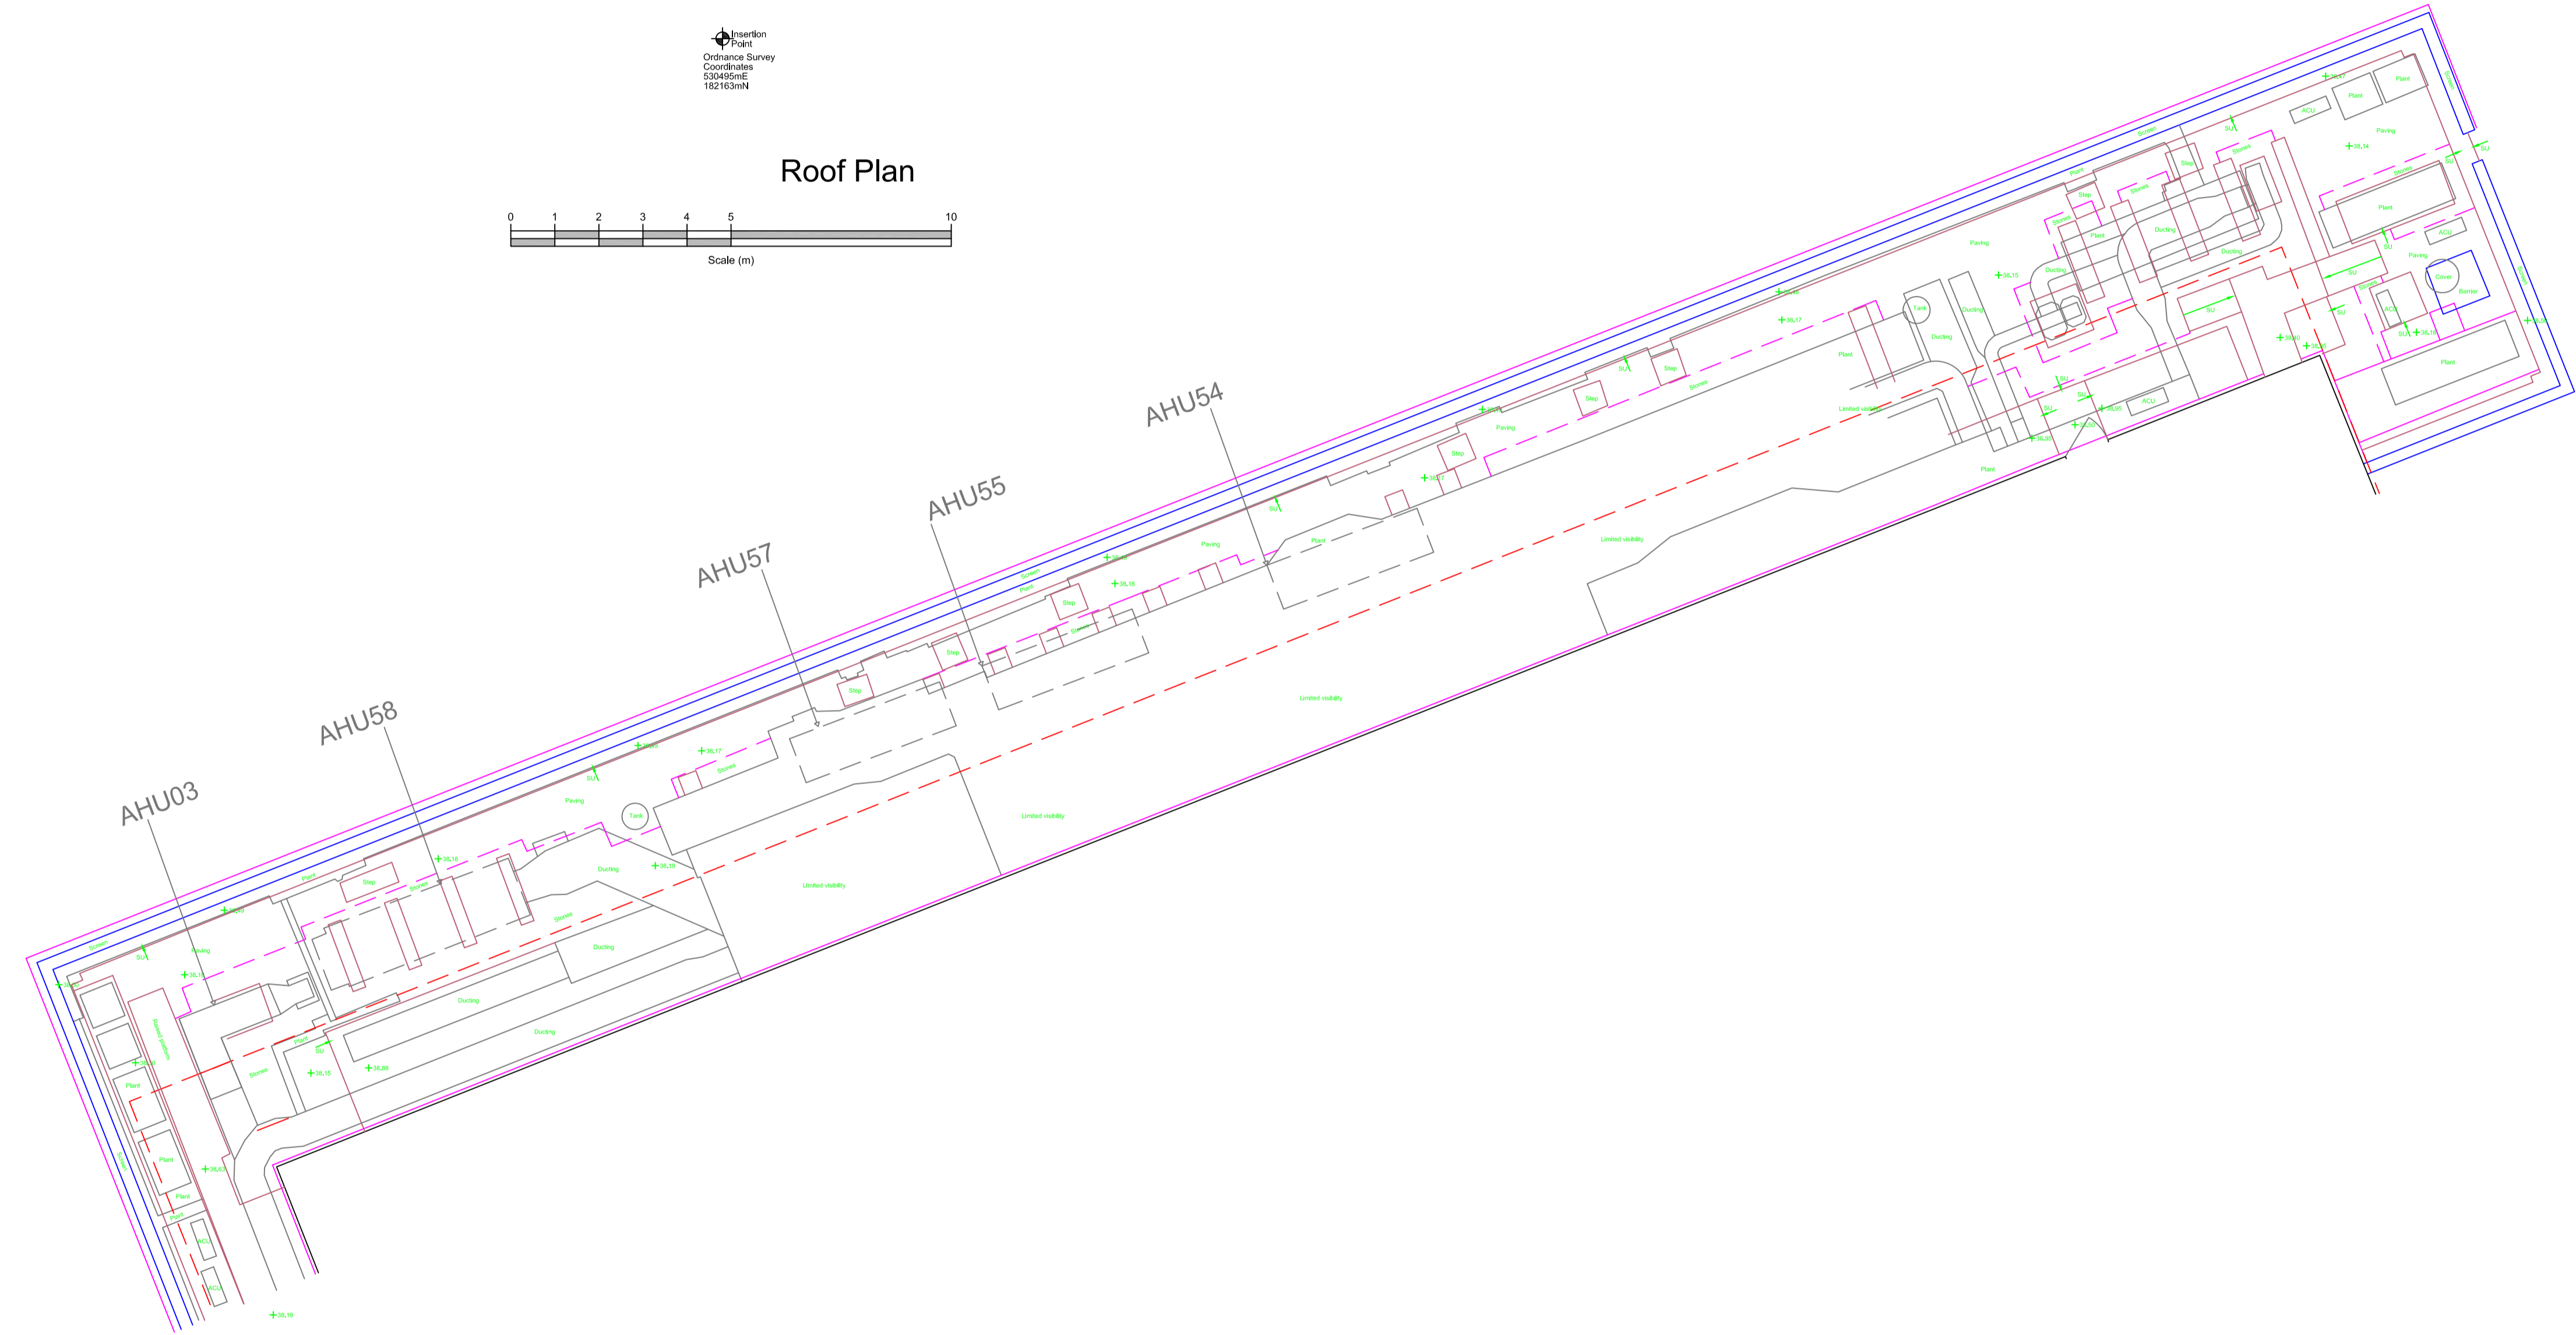

Insertion Point
Ordnance Survey
Coordinate
324485mE
162163mN

Roof Plan

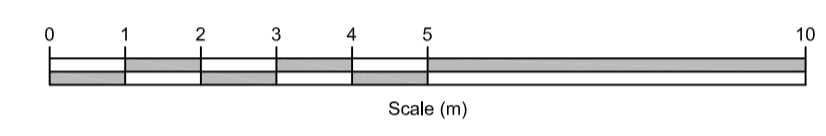

Project Datum


All levels and coordinates are related to the Ordnance Survey national grid by means of GPS. One survey control point has been fixed using GPS and then the survey orientated to additional GPS points. No scale factor has been applied therefore only the fixed GPS point is a true Ordnance Survey position.

Measured Building Survey Legend

- ACL Arch Center Level / Height above floor
- ASL Arch Spring Level / Height above floor
- CH Window Cill to Window Head Dimension
- CLG Ceiling Level / Height above floor
- DH Door Head Height above floor
- DHL Door Head Level
- F-C Floor to Window Cill Dimension
- FL Floor Level
- RU Ramp Up
- SCLG Suspended / False Ceiling Level / Height above floor
- SL Slat Level
- SU Steps Up
- TH Threshold Height above floor
- TWL Top of Wall Level
- US Underside Level / Height above floor
- USB Underside of Beam Level / Height to underside above floor
- USJ Underside of joint level / Height to underside above floor
- WACL Window Arch Center Level
- WASL Window Arch Spring Level
- WCL Window Cill Level
- WHL Window Head Level

- Sloping Roof
- Sloped Ceiling (Points up)
- Arched / Vaulted Ceiling
- Building Line / Wall Line
- Detail
- Steps
- Overhead Detail
- Partitions
- Glazing

All building measurements are taken to existing finishes or faces which are constant and represent an average face or wall line. All levels and dimensions are quoted in metres.
All window head and window cill levels are internal measurements.
Ceiling height measurements are taken to a point which best represents the general room height.

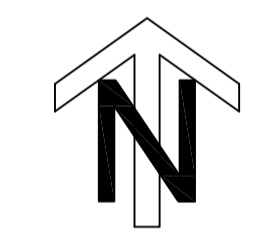

Drawing Revisions

Rev No.	Date	Details
B		
A		
Original	See below	Original survey carried out



Unit 5 Hoath Business Centre
Hoath Lane
Gillingham
Kent ME8 0BF

+44 (0)1634 751 002
www.OmegaGeo.co.uk
survey@OmegaGeo.co.uk

Client
DMA Maintenance Ltd

Project
UCL GOSICH,
30 Guilford Street, London,
WC1N 1EH

Original Survey Date
November 2024

Job Ref
2415145



Presentation Scale
1:100 @ A1

Drawing Number
1 of 1

© Omega Geomatics Ltd
This drawing and any intellectual property within it remain the property of Omega Geomatics Ltd and should not be copied or passed to any third parties without prior consent from Omega Geomatics Ltd.

Insertion Point
Ordinance Survey
Coordinates
530495mE
182163mN

Roof Plan

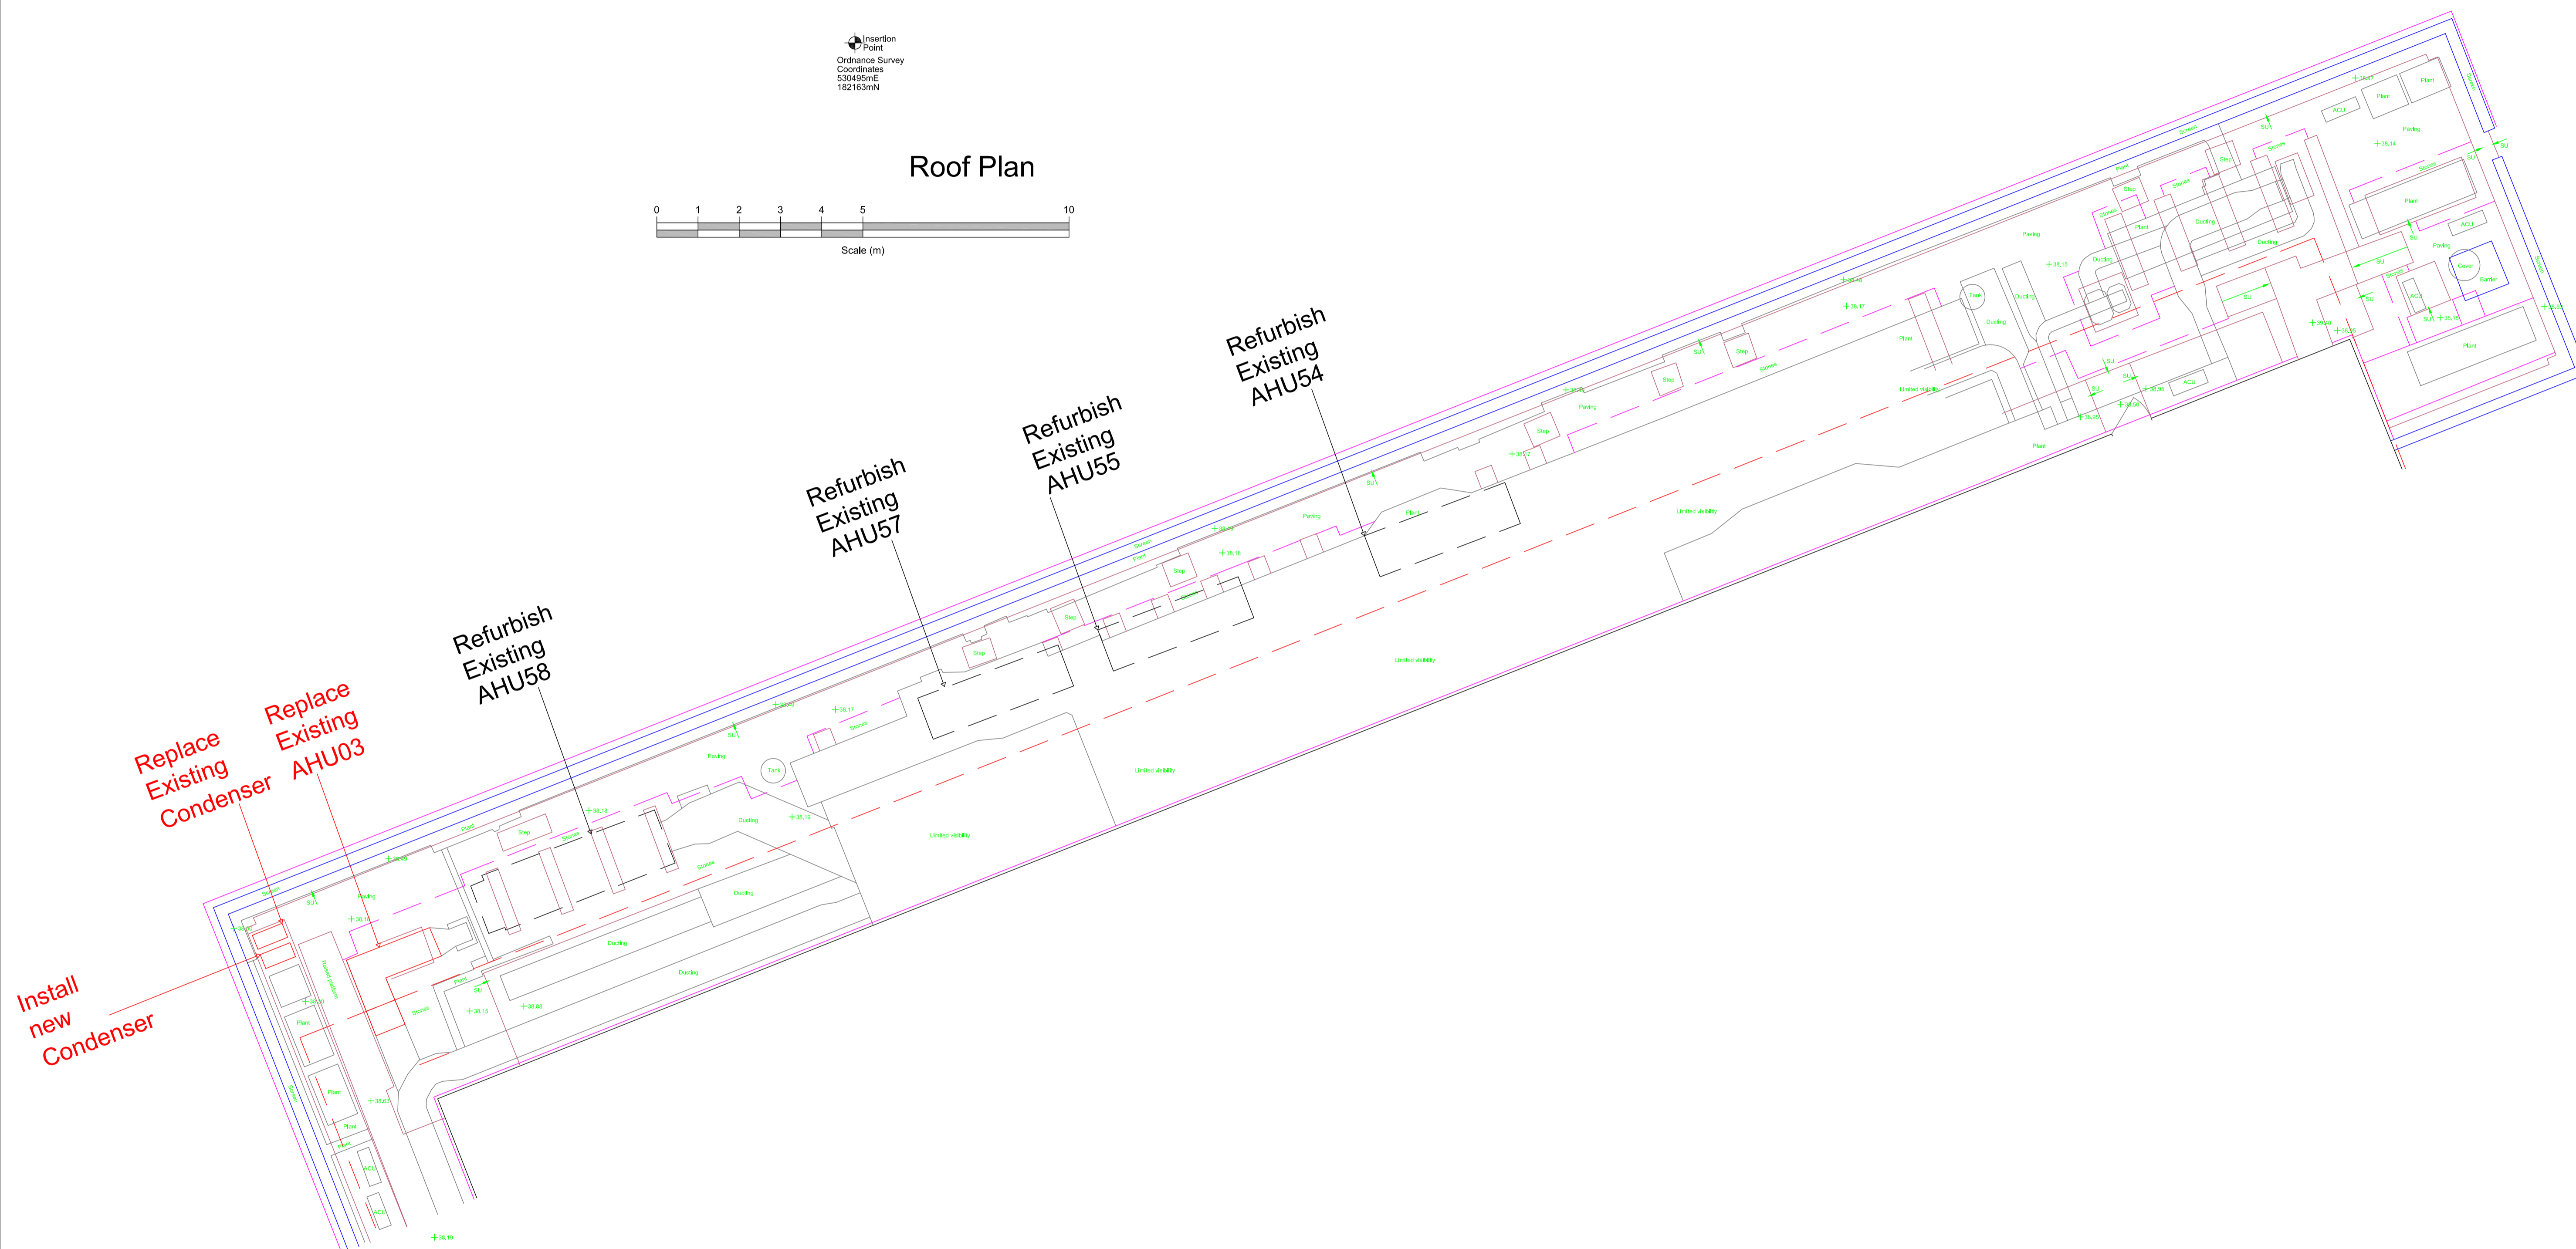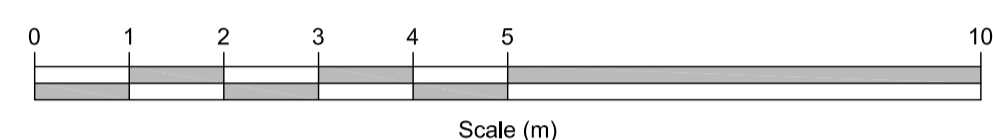

01	UPDATE TO PROPOSED	26.11.24
DATE	REVISION	DATE

Planning

University College of London

UPN237 GOSICH

PROPOSED ROOF PLAN



5 BEAUFORT HOUSE, BEAUFORT COURT,
SIR THOMAS LONGLEY WAY,
MEDWAY CITY ESTATE,
ROCHESTER, KENT ME2 4FB
Telephone: 01634 384060

DATE: NOV 2024 DRAWN BY: CS

SCALE: 1:100@A0 APP BY: IMcG

PROJECT NO: DMA-M2095-UPN237-RP-001

Dimensions of equipment

Equipment (Quantity)	Dimensions	Existing (mm)	Proposed (mm)
AHU 54	Length	5310	No change
	Width	1200	No change
	Height	1650	No change
AHU 55	Length	6500	No change
	Width	1200	No change
	Height	1650	No change
AHU 57	Length	6500	No change
	Width	1200	No change
	Height	1650	No change
AHU 58	Length	5310	No change
	Width	1200	No change
	Height	1650	No change
AHU 3 L shape	Length	1150 +2500	910 + 2610
	Width	700	872
	Height	850	822
Condenser 1	Length	1100	No change
	Depth	460	No change
	Height	870	No change
Condenser 2	Length		1100
	Depth		460
	Height		870

Scope of Works AHU's 54 & 55 - Supply

The refurbishment works will result in a reduction of noise emitted.

- Replacement of LTHW reheat coil
- Replacement of CHW cooling coil
- Replacement of Supply fan with VSD EC Fans (quieter)
- Replacement of Filter sets
- Replacement of Motorised inlet damper Controls
- Replacement of Run around coil heat recovery system

Scope of Works AHU's 57 & 58 - Extract

The refurbishment works will result in a reduction of noise emitted.

- Replacement of Extract fan with VSD EC Fans (quieter)
- Replacement of Filter sets
- Replacement of Motorised inlet damper Controls
- Replacement of Run around coil heat recovery system



Fig 1. Existing AHU 54 Being Refurbished

AHU 55 Supply



Fig 2. Existing AHU 55 Being Refurbished

AHU 57 Supply



Fig 3. Existing AHU 57 Being Refurbishment

AHU 58 Extract



Fig 4. Existing AHU 58 Being Refurbishment

AHU 3



Fig 5. Existing AHU 3 being Replaced



Fig 6. New AC Condenser