

NOTES

- This drawing to be read in conjunction with the design risk assessment prepared by Craft Architects Limited.
- This drawing to be read in conjunction with all relevant drawings and specifications produced by CA and other members of the design team.
- All dimensions are in millimetres unless otherwise stated.
- Do not scale this drawing.
- Any discrepancies in dimensions are to be reported to the architect immediately.
- All information subject to detailed site survey, it is the duty of the contractor and his agent to check all dimensions on site.
- This drawing is the copyright © of Craft Architects, do not reproduce without permission.




KEY

- - - Site Boundary
- Existing building fabric
- Currently newly built fabric

Note:

- For As-Built structural scheme refer to S.E drawings and report

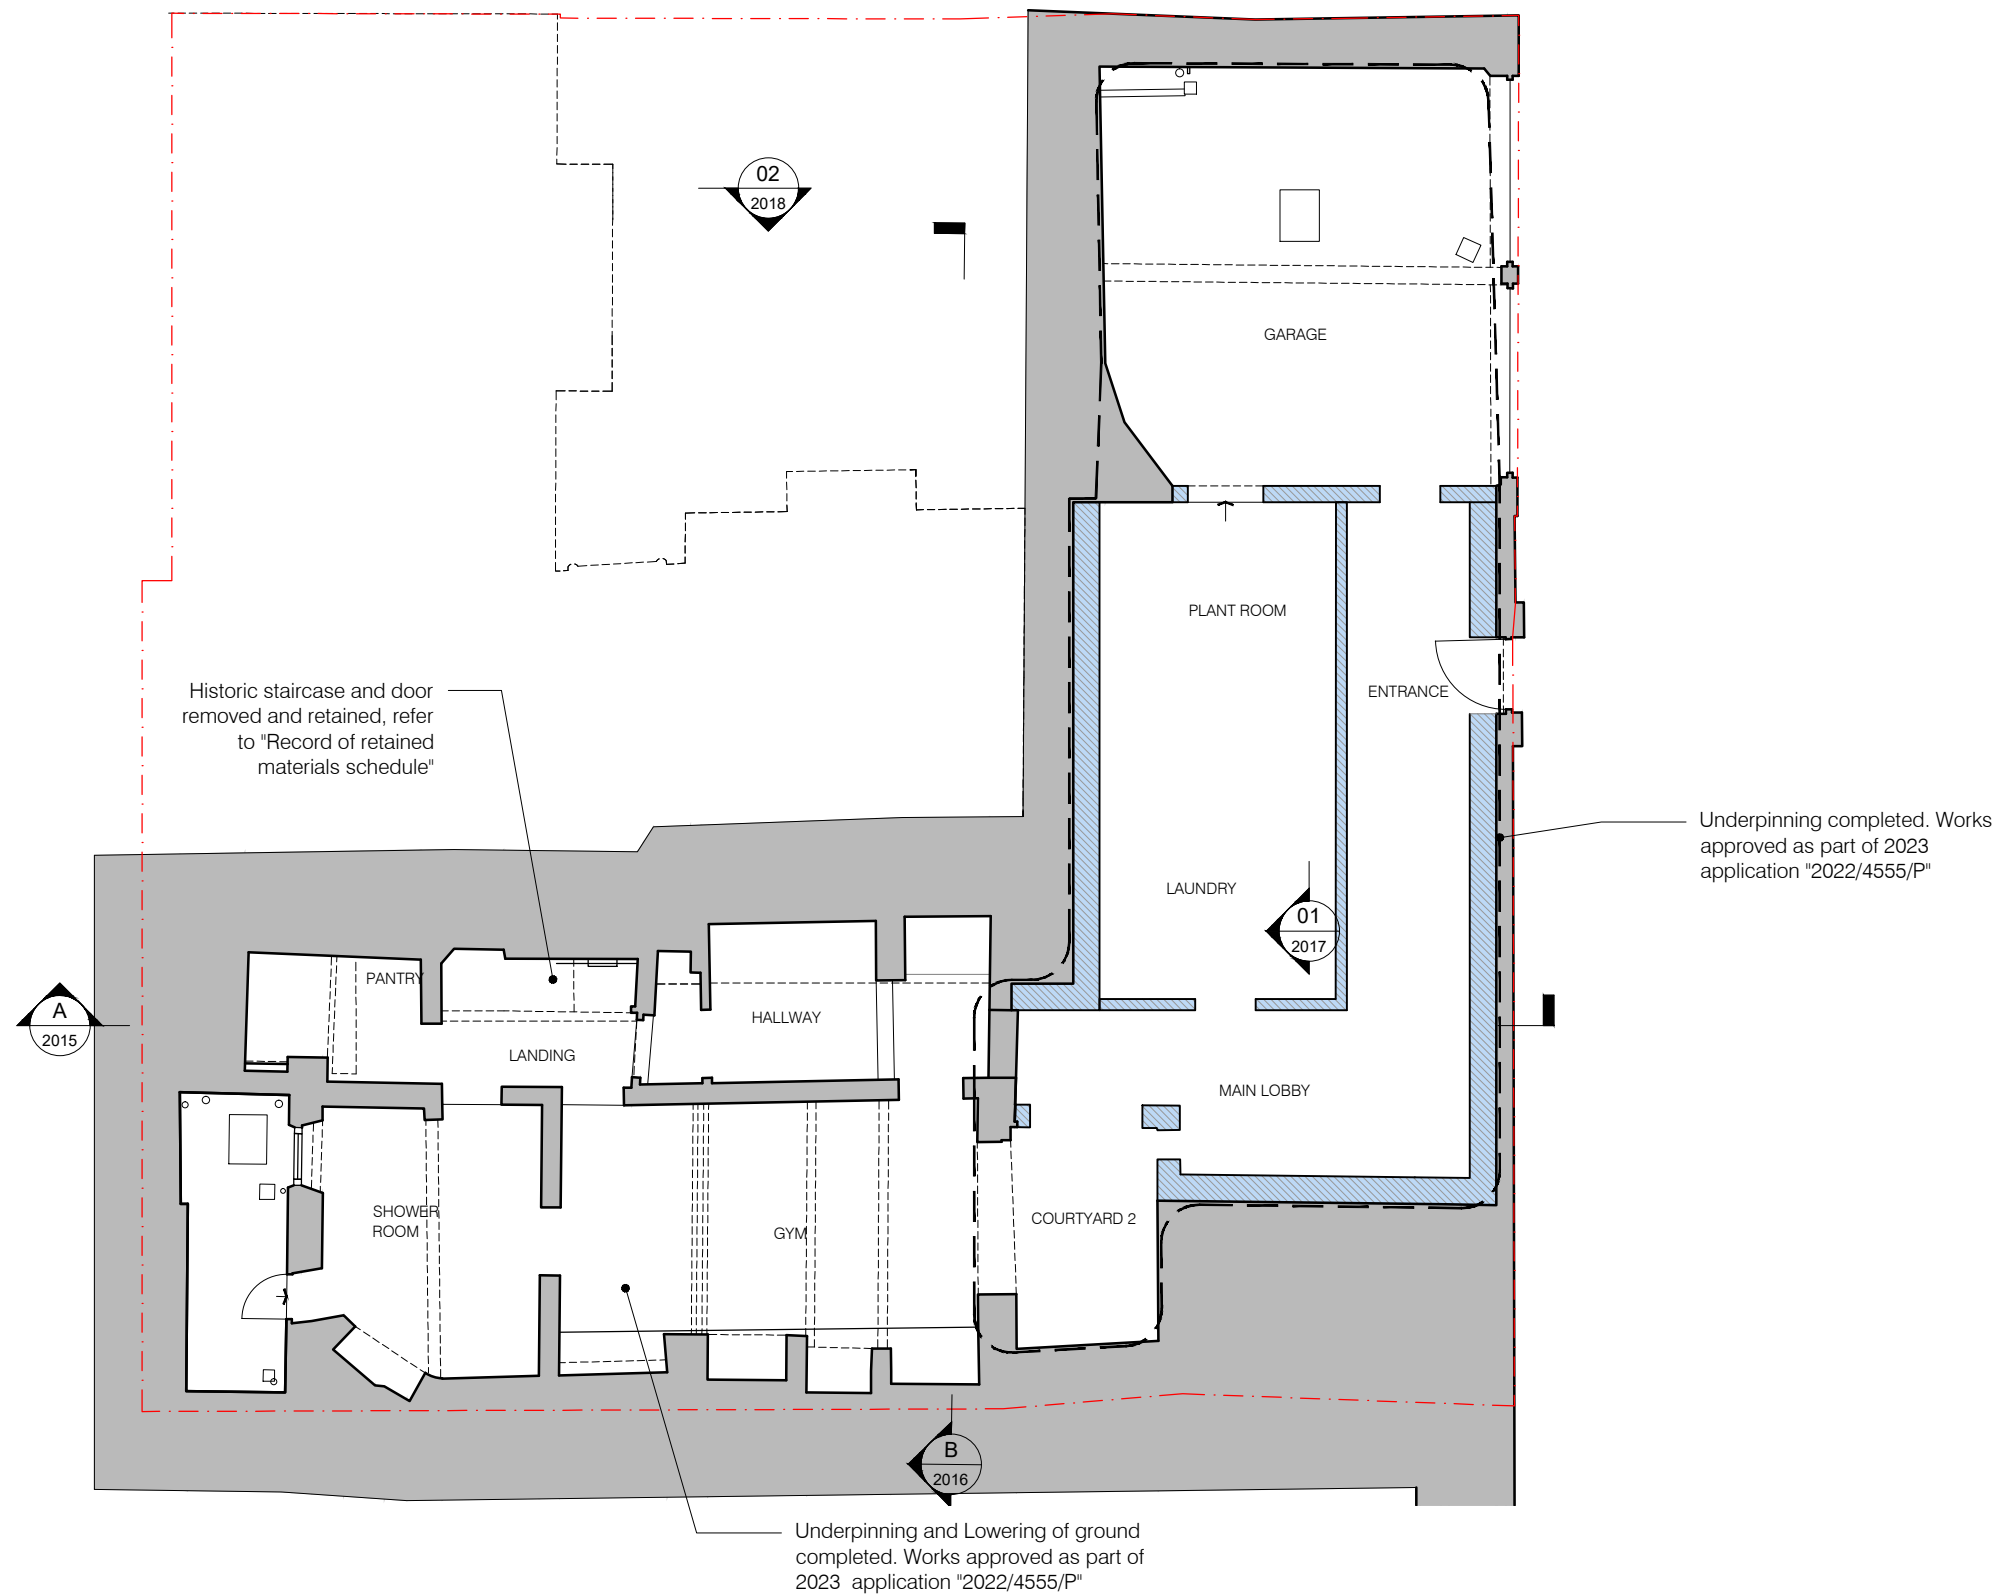

/ 18/11/24 ISSUED FOR PLANNING & LBC AMu
 REV DATE DESCRIPTION DRAWN BY

PLANNING APPLICATION

project title
9 The Mount
 London NW3 6SZ

Drawing Title
AS-BUILT
BASEMENT PLAN

drawing number revision
2405 PA AB 2010 /

scale
1:100 @A3

date / drawn by / checked by
05.01.2024 / AMu / CA

01 Basement
 - 1 : 100 @ A3



415 Cocoa Building
 The Biscuit Factory
 Drummond Road
 London, SE16 4DG
 Tel. 020 8037 9322
 www.craftarchitects.co.uk

CRAFT
 ARCHITECTS