

NOTES

- This drawing to be read in conjunction with the design risk assessment prepared by Craft Architects Limited.
- This drawing to be read in conjunction with all relevant drawings and specifications produced by CA and other members of the design team.
- All dimensions are in millimetres unless otherwise stated.
- Do not scale this drawing.
- Any discrepancies in dimensions are to be reported to the architect immediately.
- All information subject to detailed site survey, it is the duty of the contractor and his agent to check all dimensions on site.
- This drawing is the copyright © of Craft Architects, do not reproduce without permission.



KEY

- - - Site Boundary
- Existing building fabric
- Currently newly built fabric

Note:

- For As-Built structural scheme refer to S.E drawings and report

REV	DATE	DESCRIPTION	DRAWN BY
/	18/11/24	ISSUED FOR PLANNING & LBC	AMu

PLANNING APPLICATION

project title  
**9 The Mount**  
 London NW3 6SZ

Drawing Title  
**AS-BUILT**  
**SECOND FLOOR PLAN**


drawing number revision  
**2405 PA AB 2013 /**

scale  
**1:100 @A3**

date / drawn by / checked by  
**05.01.2024 / AMu / CA**

415 Cocoa Building  
 The Biscuit Factory  
 Drummond Road  
 London, SE16 4DG  
 Tel. 020 8037 9322  
 www.craftarchitects.co.uk

**CRAFT**  
 ARCHITECTS

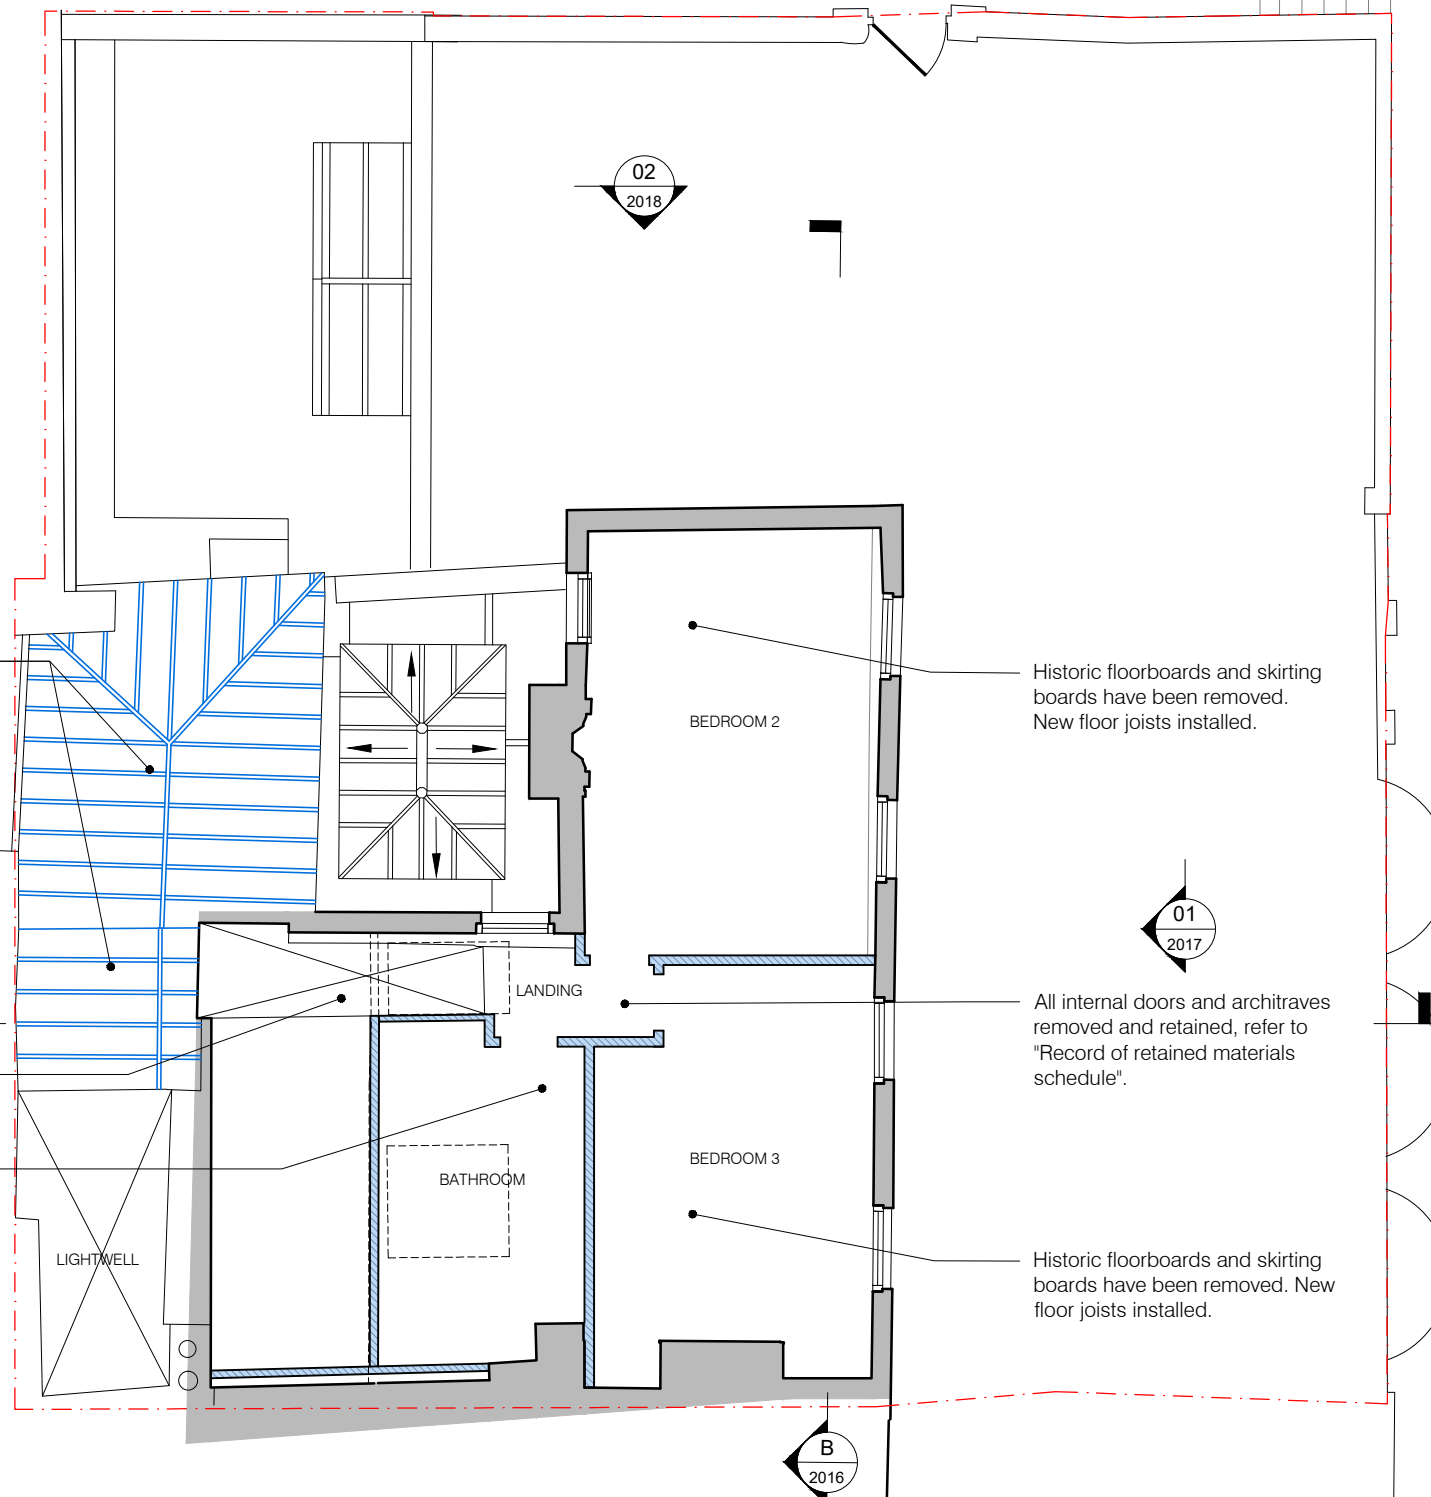

01 Second Floor Plan  
 1 : 100 @ A3

