STRUCTURAL ENGINEER'S DESIGN STATEMENT

SUMMARY OF SITE INSPECTIONS, EXISTING CONDITION, AND PROPOSED STRUCTURAL WORKS

9 THE MOUNT LONDON NW3 6SZ

Project Ref: 24-034

November 2024

Report by:

Bart Kolodziejczyk MEng CEng MIStructE

Revision history:

Issue	Date	Details
1	03/12/2024	First issue
2	06/12/2024	Minor updates and references to previous report added, issued for submission to the Council
3	09/12/2024	Updated following further comments.

Studio Strukt Ltd

Arch D, Hackney Downs Studios Amhurst Terrace, London E8 2BT

T: 078 508 75 271 E: bart@studiostrukt.co.uk W: studiostrukt.co.uk

1 <u>Introduction</u>

The purpose of this document is to provide an outline description of the proposed structural engineering works at 9 The Mount and present the rationale behind the key design decisions made. It is intended to form part of a Listed Building Consent application.

This document follows our site inspections in June and November 2024 and should be read together with Studio Strukt's Report dated 02/08/2024.

The building is Grade II listed. Extensive structural works have been carried out in the building recently, prior to our appointment. These included, in general terms:

- 1. Extension and deepening to the existing basement in front of the house
- 2. Underpinning of the existing foundations and deepening of existing basement under the house
- 3. Removal of internal timber floors and studwork walls, replacement with new timber structures and some steel beams
- 4. Removal and replacement of timber roof structures. This also involved raising the top of front and rear wall levels in the eastern/front part of the house.
- 5. Other minor alterations throughout, such as replacement of internal lintels and non-original steel beams, removal of some modern brick piers and replacement with steel columns.

Our understanding is that items 1 and 2 were carried out under a Listed Building Consent and in accordance with structural engineering design by Mitchinson Macken Engineers (whose drawings formed part of the consent). These works are outside the scope of Studio Strukt's assessment and design.

We understand that there was no such consent obtained for the remainder of the recently undertaken works, and, as far as we are aware, they were carried out without a structural engineer's design or supervision.

Our brief was to carry out a site inspection of the recently installed and remaining historic structures, review record photographs taken during the recent works, and then to carry out calculations and structural assessment for the recently installed elements and key historic ones and, finally, to provide design for required strengthening/repairs/replacements.

Included in the appendices are Studio Strukt drawings, as follows:

- Appendix A: Drawings 01-03 presenting our understanding of the existing structural layouts prior to the recent alterations
- Appendix B: Drawings 11-15 a summary of the findings of our site inspections in June and November 2024 these show structures as present on site on the date of this report.
- Appendix C: Drawings 21-25 plans showing the proposed structural works (strengthening, replacement, repairs, and further changes to suit the architectural design).

2 Observations and commentary on the proposed structural works

2.1 Studio Strukt's report dated August 2024 provides a detailed description of the structural layouts and condition/quality of the works as inspected at the time. As further inspections have been carried out since, with more of the recently installed and historic structures exposed, our understanding of the current and historic conditions has also improved and evolved in some areas.

The key items, an updated summary of our findings (following an inspection on November 2024) and structural assessment are noted on the drawings appended to this report (as listed on previous page). Wherever any discrepancies between these drawings (and this document) and the report dated August 2024 exist, the former supersedes the latter.

- 2.2 Our understanding (and some assumptions) of the structures present on site prior to the recent works is based on site inspection of 'traces' of those elements still left in situ, and a desk study of record photographs and measured survey drawings prepared prior to these works.
- 2.3 Various areas of the building had undergone structural alterations in the past (before the recent interventions). There were relatively modern steel beams under the basement ceiling, many original timber lintels had been replaced with concrete elements (including above some of the windows in the front façade), and the structure within the north-west area of the house (kitchen and the covered atrium) is of late 20th century origin, with steel beams, modern brickwork piers, and concrete floors.

There is evidence of extensive historic repairs and strengthening to timber floors at 1st and 2nd floor levels, with joists coupled with new or replaced completely. Similarly, the roof over the eastern part of the house (labelled Roof 04 on the plans) had undergone significant works in the past, with all rafters paired up with new ones, and a new ridge plate.

2.4 While the recently removed timber structures are now lost and cannot be restored using the original components, our design aims to reinstate the original load paths, span directions, and structural arrangements where they have been altered during the recent works.

Where possible, we have aimed to use timber joists, beams, and studwork, but we had to introduce several steel members where the required strength or stiffness could not be achieved with timber members of reasonable size (or without using engineered wood products). These are locations where the original structure appears to have been inadequate, leading to significant movement and serious defects over time; strengthening works involving steelwork would have been necessary in these locations even if the original structure was still in place.

Also, where possible and where such details were used originally, we are proposing a 'traditional' connection between the floor joists and masonry walls, with joist ends built into and bearing directly on the masonry, but with the timber ends wrapped in plastic sleeves for protection against moisture. This detail has also been used in the recently installed floor joists in the front part of the house.

Finally, where we could prove the recently installed elements to be structurally adequate and where they follow the original spans/load paths and do not adversely affect other, historic elements, we are proposing they are kept as installed.

- 2.5 Despite the previous repairs, the photographic records and the measured survey clearly show that there were ongoing structural issues with the historic structure. Some of those are still present and require addressing. In particular:
- 2.5.1 External walls (front and gable end walls) in the north-east corner of the building are significantly deformed, leaning outwards. It has led to breaks in the continuous timber wall plate supporting the joists at 2nd floor level (and which acts as a lintel across 1st floor windows), and, most likely, also in the (now removed) wall plate above 2nd floor windows.

While this may be caused to some extent by ground subsidence over the years and possibly inadequate support provided by the original front basement structure, it also appears that the original roof structure has contributed to the problem. The original roof comprised a series of A-frames – pairs of rafters joined at the top with a ridge plate, and with timber ties at about 2/3 of the rise. Such structure is prone to outward 'spread' at the base (eaves level), pushing the supporting walls out. Based on the deformations visible on record photographs, and evidence of unsuccessful previous repairs (coupled rafters and new ridge plate), this appears to be the case in this building.

The current (recently installed) roof structure fails to address this problem and is probably making it worse. As there are no horizontal ties between the current rafters, it is even more prone to the horizontal spread than the original roof.

See photographs on Page 12 of the August 2024 report for further information.

We are proposing to strengthen and tie the external walls at the top by using a continuous steel wall plate/ring beam at eaves level, and to rebuild the timber roof to match its earlier profile and structural diagram (timber rafters with horizontal ties matching the original). The steel members have been designed to withstand the horizontal forces applied by the roof rafters and thus prevent further outward movements.

We have considered several options for this strengthening/roof rebuild, including the introduction of steel ridge beams or primary steel A-frames/trusses. While we need to provide a steel element to 'arrest' the deformations in external masonry and prevent extensive movements in the roof in the future, the chosen solution replicates the original roof's structural diagram and its interaction with the masonry walls. Of the possible options, it is the closest match to the original form and layout of the roof structure.

2.5.2 There are timber plates buried in the external walls' brickwork, certainly throughout the front and end walls of the eastern part of the building, and possibly elsewhere. Such members are prone to long-term problems due to moisture penetrating the solid masonry walls, leading to rot damage. There is evidence of such damage to timber plates throughout the front wall, weakening the brickwork in general, and affecting the bearing of the joist ends built into the wall.

We propose that all the buried timber plates are removed in short segments, and the voids filled in with brickwork matching the existing and with lime mortar. This is an intervention commonly used in historic buildings to ensure the longevity of the brickwork structures and robustness of their connections with the floors.

2.5.3 There is no connection between timber floors/roofs and masonry walls where the walls run parallel with joists/rafters. The northern (gable end) wall in the front part of the house in particular lacks (and lacked historically) any lateral restraint, which is likely to have contributed to its deformation.

We are proposing that steel restraint straps are installed between the masonry walls and the timber joists/rafters in such locations. The strap ends will be built into small padstones cast into pockets cut on the inside of the walls. Again, this is a standard detail, commonly used to improve lateral restraint to external walls in historic buildings.

2.6 In the south-western part of the building (area under Roof 03 as noted on plans), the recent works resulted in a significant change to the structural arrangement and load paths.

The original structure appears to have comprised a timber beam (running north-south) within the 2nd floor, which supported the 2nd floor/1st floor ceiling joists in this area, and a purlin and low-level studwork wall under the roof. It is possible the beam worked together with a stud wall at the 1st floor level and a joist (directly under the wall) within the 1st floor. The 1st floor joists in this area used to run in the north-south direction and were supported on load-bearing studwork wall along the ground floor hallway. All the other historic joists ran east-west.

We have carried out outline checks on these timber elements (with sizes assumed/extrapolated from photographs only) and it seems they were potentially overstressed and would have deflected significantly. It is possible this is a result of a poorly executed historic alteration, where a supporting wall might have been removed at ground floor level. It is very likely that this structure would have needed to be strengthened if it was still in situ.

In the recently installed structure, the studwork wall along ground floor hallway is no longer loadbearing, and the weight of the roof and 2nd floor is transferred down onto a very long span 1st floor joists via studwork walls. This structure is inadequate, the 1st floor joists cannot support the resultant loads.

See photographs on Pages 8, 25 and 26 of the August 2024 report for further information.

We propose to restore the original layout by replacing the 1st floor joists with new ones running north-south and rebuild a load-bearing studwork wall along the ground floor hallway. There will be a steel beam needed within the 1st floor depth, to support a 1st floor stud wall (already in place) which then carries 2nd floor joists and the roof.

- 2.7 The above items are what we consider to be the primary engineering concerns and major aspects of the proposed structural works. There are other works being proposed, localised or more minor/less intrusive. Refer to the appended drawings for the full scope and specification for the proposed structural interventions.
- 2.8 The structural works we are proposing will address and remedy, for the long term, the inherent problems with the original structure, which we believe may have led to the recent unconsented works. It is a long-term solution aiming to avoid the need for ad-hoc repairs and strengthening in the foreseeable future. The proposed works will secure the longevity of the remaining historic fabric and leave the building in a much-improved condition to face the coming decades than it had been before the unauthorised works were commenced.

DISCLAIMERS

1. This report does not constitute a full survey of the premises.

2. Except where specifically indicated in the report, woodwork, brickwork or other parts of the property or its services, which are covered, unexposed, or inaccessible, have not been inspected and this report does not constitute any warranty that any such parts of the property are free from defects.


3. This report is prepared for the use of the person, firm or company to whom it is addressed (and that of any other person, firm or company whose interest was disclosed to us prior to its preparation) and no responsibility is accepted by us to any other party whatsoever for the whole or any part of its contents.



<u>Appendix A</u>

Drawings 01-03

Layout and condition of structure prior to recently undertaken works

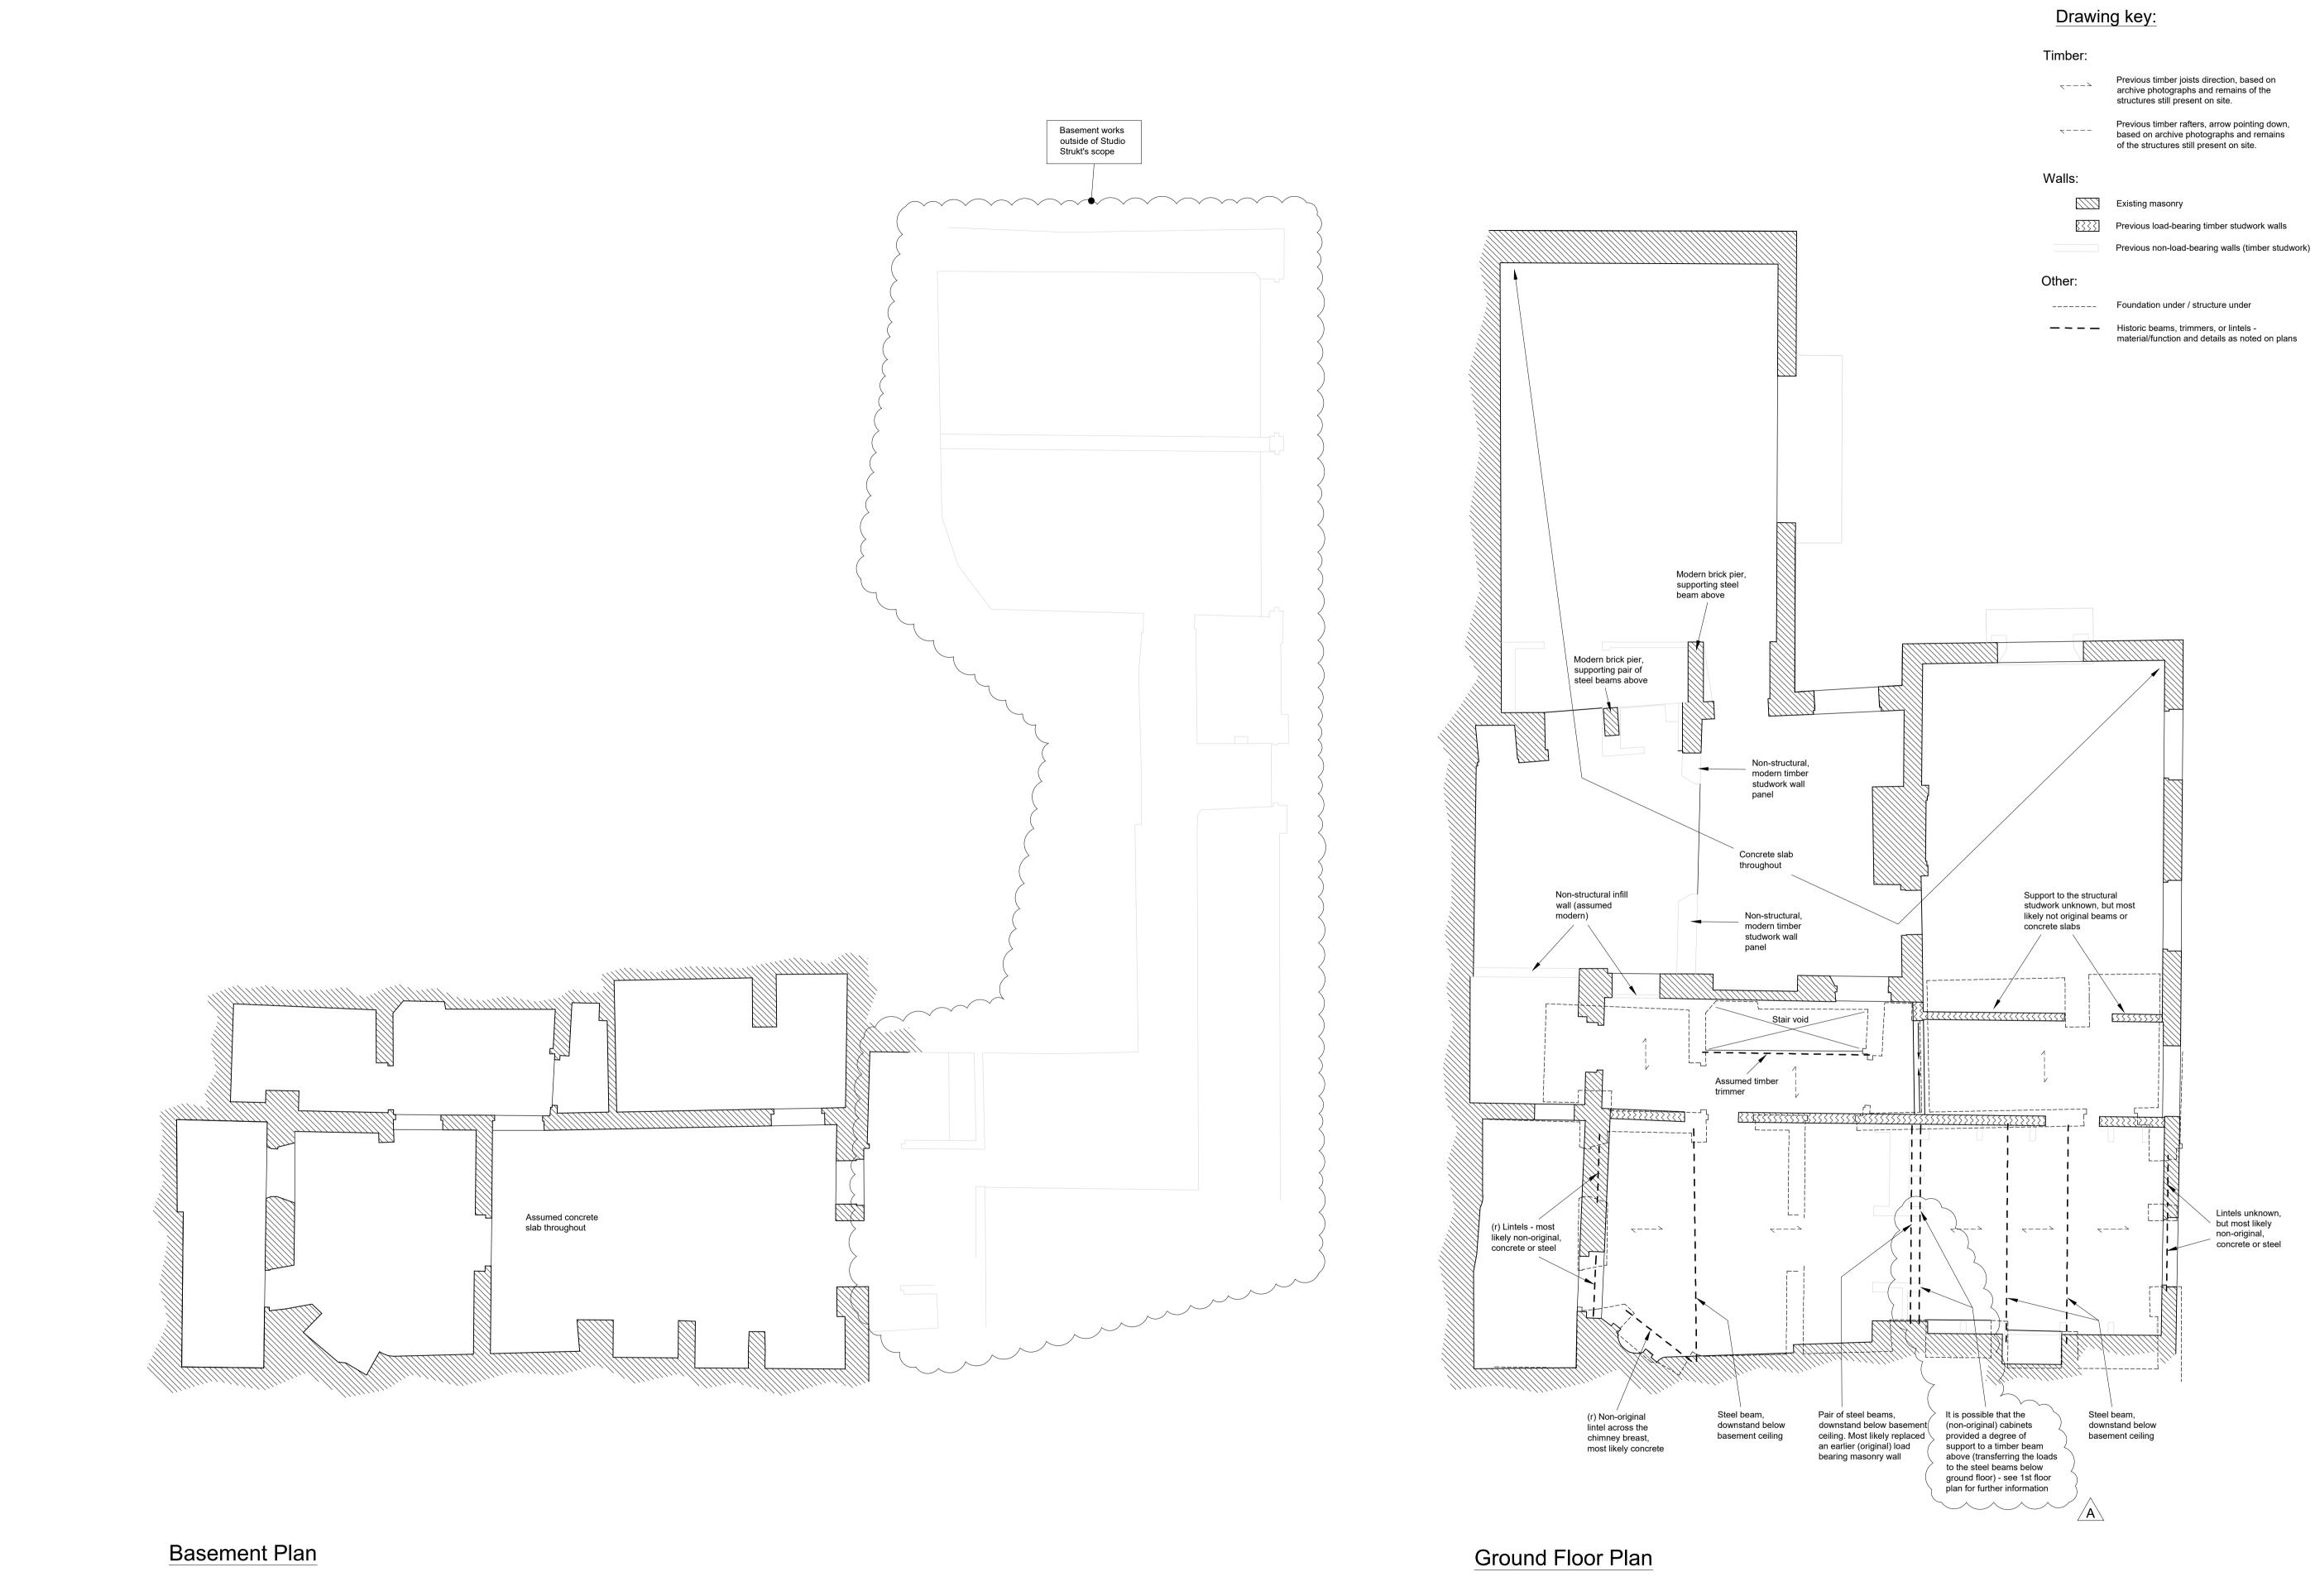

<>

GENERAL NOTES:

1. All Studio Strukt drawings are to be read in

conjunction with the relevant Architect's, Engineer's and Specialist Supplier's drawings and specifications.

based on archive photographs and remains

Previous load-bearing timber studwork walls


material/function and details as noted on plans

2. Do not scale from any Studio Strukt drawings. Use stated dimensions only. All dimensions to be verified on site by contractor. 3. Fire protection, thermal and sound insulation, and waterproofing are outside of Studio Strukt's scope. Any such elements are shown indicatively only. The Contractor is responsible for ensuring the stability of all structures within and adjacent to the site at all times during the contract, and is to design and provide all temporary works required. 5. All work subject to Building Control approval, Party Wall agreement, and Listed Building consent. Formation levels of all foundations to be approved on site by Building Control inspector. 6. All Studio Strukt plans are drawn 'looking down' and show structure within and immediately below the floor/level the plan refers to. For example, a 1st floor plan shows 1st floor joists, beams within and under 1st floor, and lintels above openings at ground floor level. DRAWING NOTE: This drawing represents our understanding of the building's structure as existed prior to the recent construction works. The layouts are based on combination of: remains of the former structures seen on site record photographs taken during the recent demolition and construction works measured survey drawings produced prior to the recent demolitions assumptions based on our knowledge of historic building methods and other examples of buildings of similar type and age Refer to drawings series 10 for the record of existing structures (recently installed) as inspected in June and November 2024 and series 20 for the proposed structural interventions. All structural member sizes marked with (r) have been retained during the recent works and remain in-situ. All other elements of floor and roof structures, and internal studwork walls (whether load-bearing or not) shown on this drawing have been removed. Masonry walls appear to generally have not been altered during the recent works, except where noted. Updated where clouded 06/12/24 BK Issued for comments/coordination and submission 03/12/24 BK to the Council Date By Description studio stru<mark>k</mark>t studiostrukt.co.uk 078 508 75 271 bart@studiostrukt.co.uk PRELIMINARY Not for construction Checked Date Scale Βv 1:50 @ A1 28/11/2024 BK Project 9 The Mount


Title


London NW3 6SZ


Layout and condition of structure prior to recently undertaken works: Basement and Ground Floor Plans Drawing No. Rev. 24-034/01 А

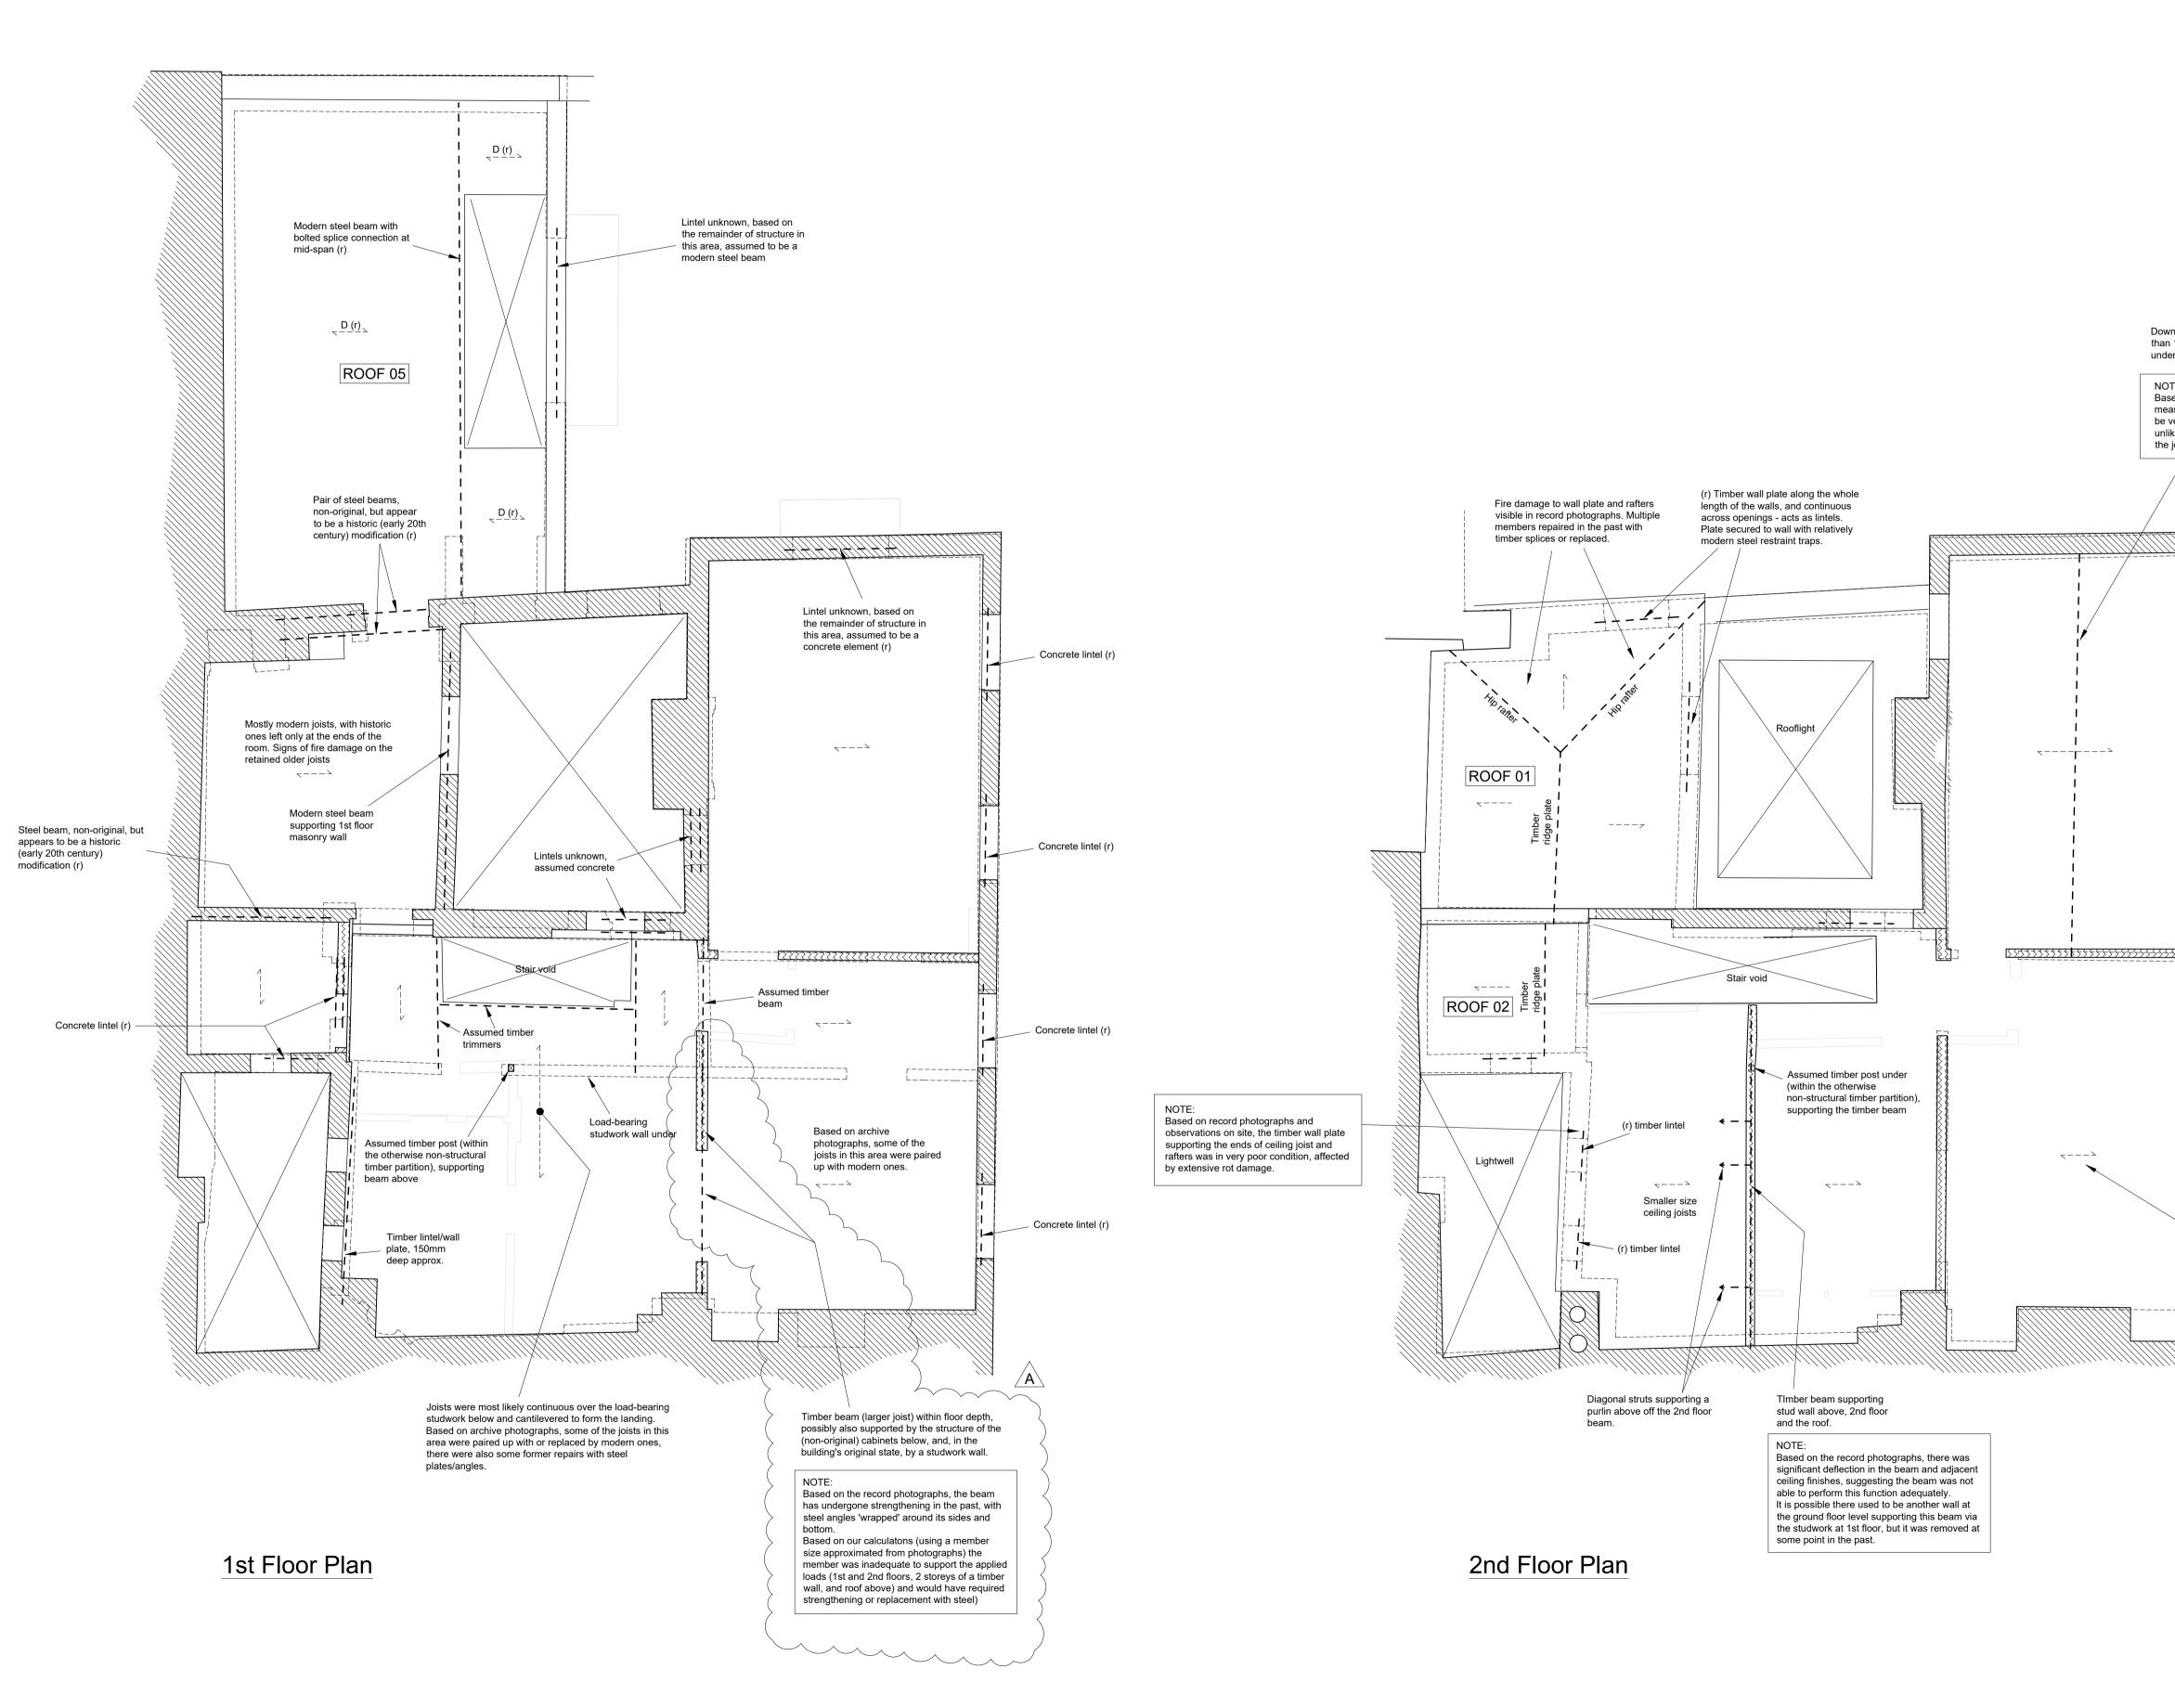


Drawing key: Fimber: Previous timber joists direction, based on archive photographs and remains of the structures still present on site. Previous timber rafters, arrow pointing down, based on archive shotographs and remains of the structures still present on site. Previous timber rafters, arrow pointing down, based on archive shotographs and remains of the structures still present on site. Previous timber rafters, arrow pointing down, based on archive shotographs and remains of the structures still present on site. Previous timber rafters, arrow pointing down, based on archive shotographs and remains of the structures still present on site. Previous load-bearing timber studwork walls Previous non-load-bearing walls (timber studwork) Previous non-load-bearing walls (timber studwork)	 GENERAL NOTES: All Studio Strukt drawings are to be read in conjunction with the relevant Architect's, Engineer's and Specialist Supplier's drawings and specifications. Do not scale from any Studio Strukt drawings. Use stated dimensions only. All dimensions to be verified on site by contractor. Fire protection, thermal and sound insulation, and waterproofing are outside of Studio Strukt's scope. Any such elements are shown indicatively only. The Contractor is responsible for ensuring the stability of all structures within and adjacent to the site at all times during the contract, and is to design and provide all temporary works required. All work subject to Building Control approval, Party Wall agreement, and Listed Building consent. Formation levels of all foundations to be approved on site by Building Control inspector. All Studio Strukt plans are drawn 'looking down' and show structure within and immediately below the floor/level the plan refers to. For example, a 1st floor plan shows 1st floor joists, beams within and under 1st floor, and lintels above openings at ground floor level. DRAWING NOTE: The layouts are based on combination of: record photographs taken during the recent demolition and construction works measured survey drawings produced prior to the recent demolitions.
TE: sed on record photographs and assured survey, the beam appears to very small profile for the span and ikely to have provided any support to a joists.	Refer to drawings series 10 for the record of existing structures (recently installed) as inspected in June and November 2024 and series 20 for the proposed structural interventions. All structural member sizes marked with (r) have been retained during the recent works and remain in-situ. All other elements of floor and roof structures, and internal studwork walls (whether load-bearing or not) shown on this drawing have been removed. Masonry walls appear to generally have not been altered during the recent works, except where noted.
(1) No lintels above windows, timber wall plate spans across the openings. NOTE: Wall plate is in poor condition, due to historic or ongoing water ingress through the brickwork (rot damage and loss of cross section) - it does not provide adequate support to joists in some areas. Also, because of outward movement of the brickwork, the timber plate is discontinuous in some locations, including at least one instance where it split above the window (and cannot perform its function as a lintel).	
(r) No lintels above windows, timber wall plate spans across the openings.	
NOTE: Joists strengthened in the past - almost all appear to have been coupled with relatively modern-looking additional joists.	A Updated where clouded 06/12/24 BK - Issued for comments/coordination and submission to the Council 03/12/24 BK Rev Description Date By Studiostrukt.co.uk 078 508 75 271 bart@studiostrukt.co.uk
	PRELIMINARY
	Not for construction Scale Date By Checked 1:50 @ A1 28/11/2024 BK Project 9 The Mount
	Title Layout and condition of structure prior to recently undertaken works: 1st and 2nd Floor Plans Drawing No. 24-034/02

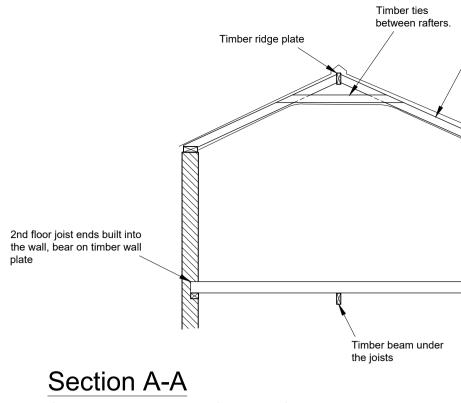

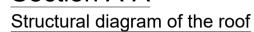

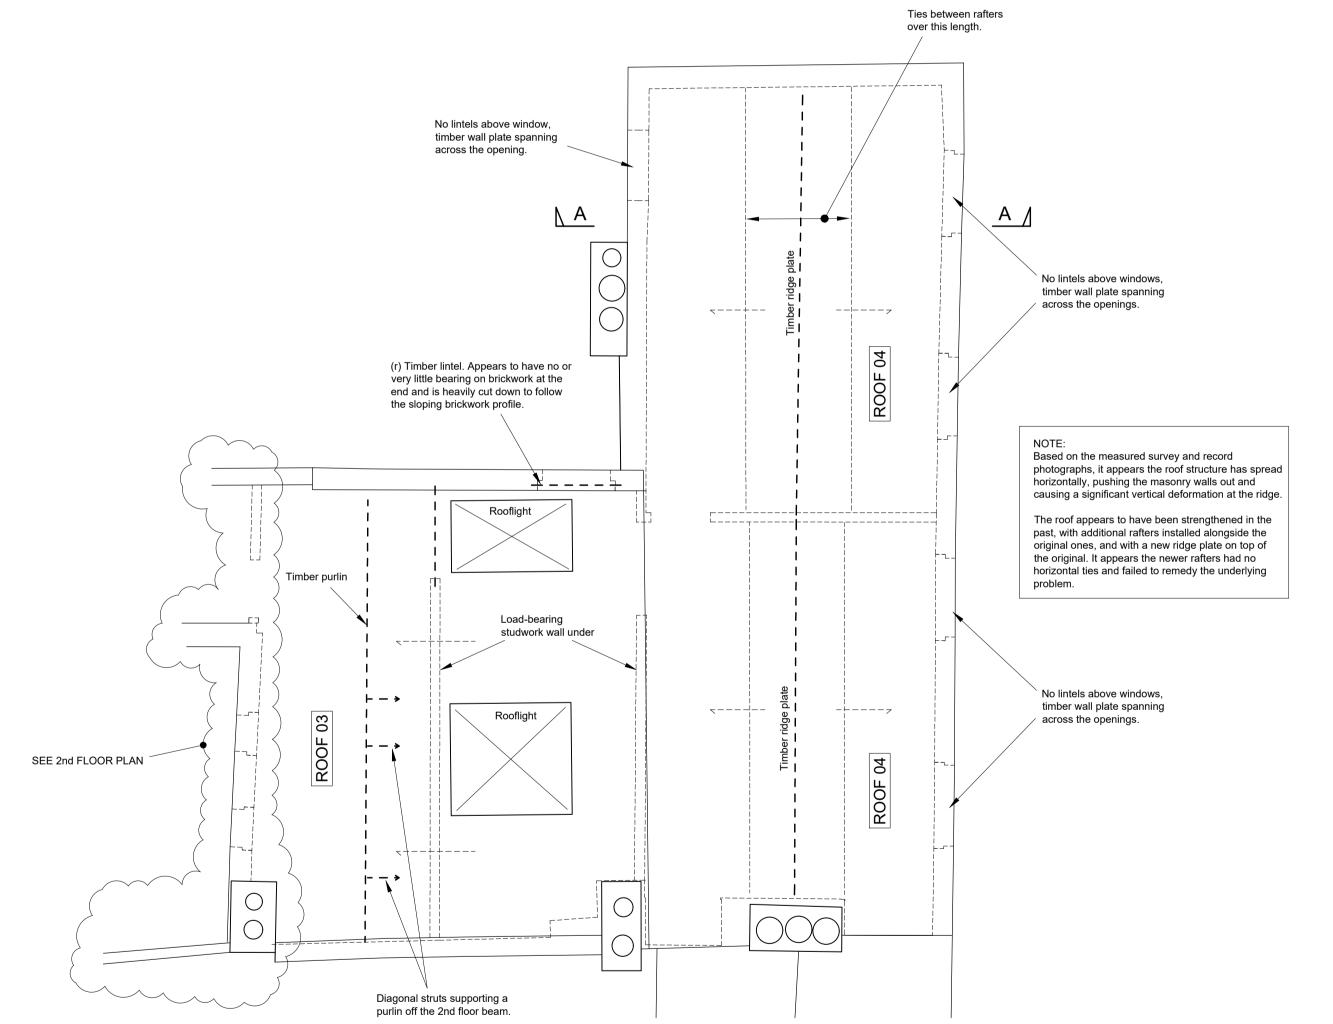

Roof Plan

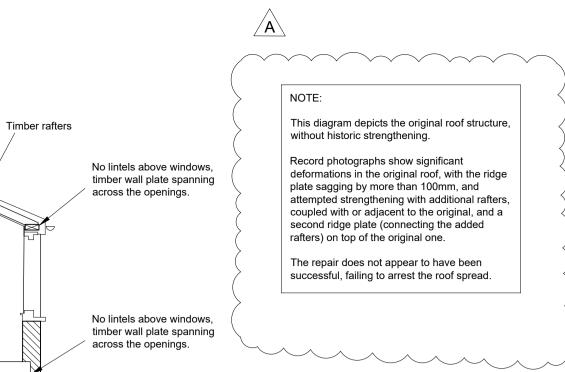

Drawing key:

Timber:

~---7

~----

Previous timber joists direction, based on archive photographs and remains of the structures still present on site.

Previous timber rafters, arrow pointing down, based on archive photographs and remains of the structures still present on site.

Walls:

 $\Box\Box$

Existing masonry

Previous load-bearing timber studwork walls Previous non-load-bearing walls (timber studwork)

Other:

Foundation under / structure under

- - - Historic beams, trimmers, or lintels material/function and details as noted on plans GENERAL NOTES:

- All Studio Strukt drawings are to be read in conjunction with the relevant Architect's, Engineer's and Specialist Supplier's drawings and specifications.
- 2. Do not scale from any Studio Strukt drawings. Use stated dimensions only. All dimensions to be verified on site by contractor.
- 3. Fire protection, thermal and sound insulation, and waterproofing are outside of Studio Strukt's scope. Any such elements are shown indicatively only.
- The Contractor is responsible for ensuring the stability of all structures within and adjacent to the site at all times during the contract, and is to design and provide all temporary works required.
- 5. All work subject to Building Control approval, Party Wall agreement, and Listed Building consent. Formation levels of all foundations to be approved on site by Building Control inspector.
- All Studio Strukt plans are drawn 'looking down' and show structure within and immediately below the floor/level the plan refers to. For example, a 1st floor plan shows 1st floor joists, beams within and under 1st floor, and lintels above openings at ground floor level.

DRAWING NOTE:

This drawing represents our understanding of the building's structure as existed prior to the recent construction works.

- The layouts are based on combination of: remains of the former structures seen on site record photographs taken during the recent demolition and construction works
- measured survey drawings produced prior to the recent demolitions assumptions based on our knowledge of historic
- building methods and other examples of buildings of similar type and age

Refer to drawings series 10 for the record of existing structures (recently installed) as inspected in June and November 2024 and series 20 for the proposed structural interventions.

All structural member sizes marked with (r) have been retained during the recent works and remain in-situ. All other elements of floor and roof structures, and internal studwork walls (whether load-bearing or not) shown on this drawing have been removed.

Masonry walls appear to generally have not been altered during the recent works, except where noted.

Not for construction					
Scale	Date	Ву	Checked		
1:50 @ A1	28/11/2024	ВК			
Project		•			
9 The N London	lount NW3 6SZ				
Title					
Layout and condition of structure prior to recently undertaken works: Roof Plan					
Drawing No.			Rev.		

Issued for comments/coordination and submission 03/12/24 BK to the Council

studio strukt

PRELIMINARY

06/12/24 BK

Date By

Α

Updated where clouded

lev Description

studiostrukt.co.uk 078 508 75 271 bart@studiostrukt.co.uk


24-034/03




<u>Appendix B</u>

Drawings 11-15

Layout and condition of structure as seen in November 2024

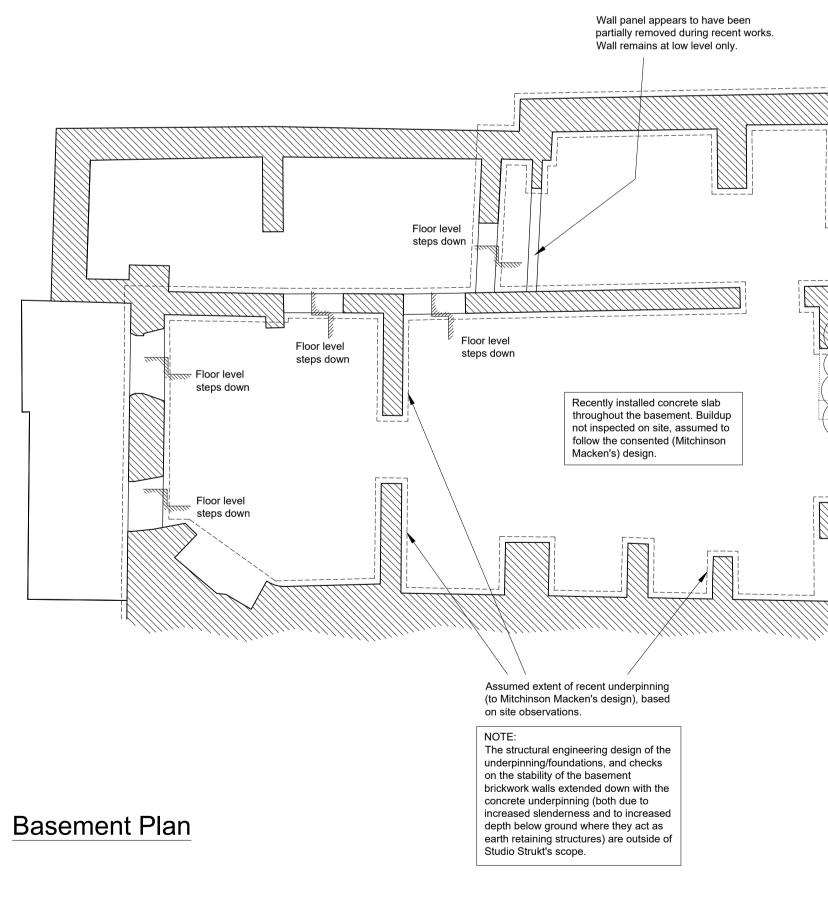

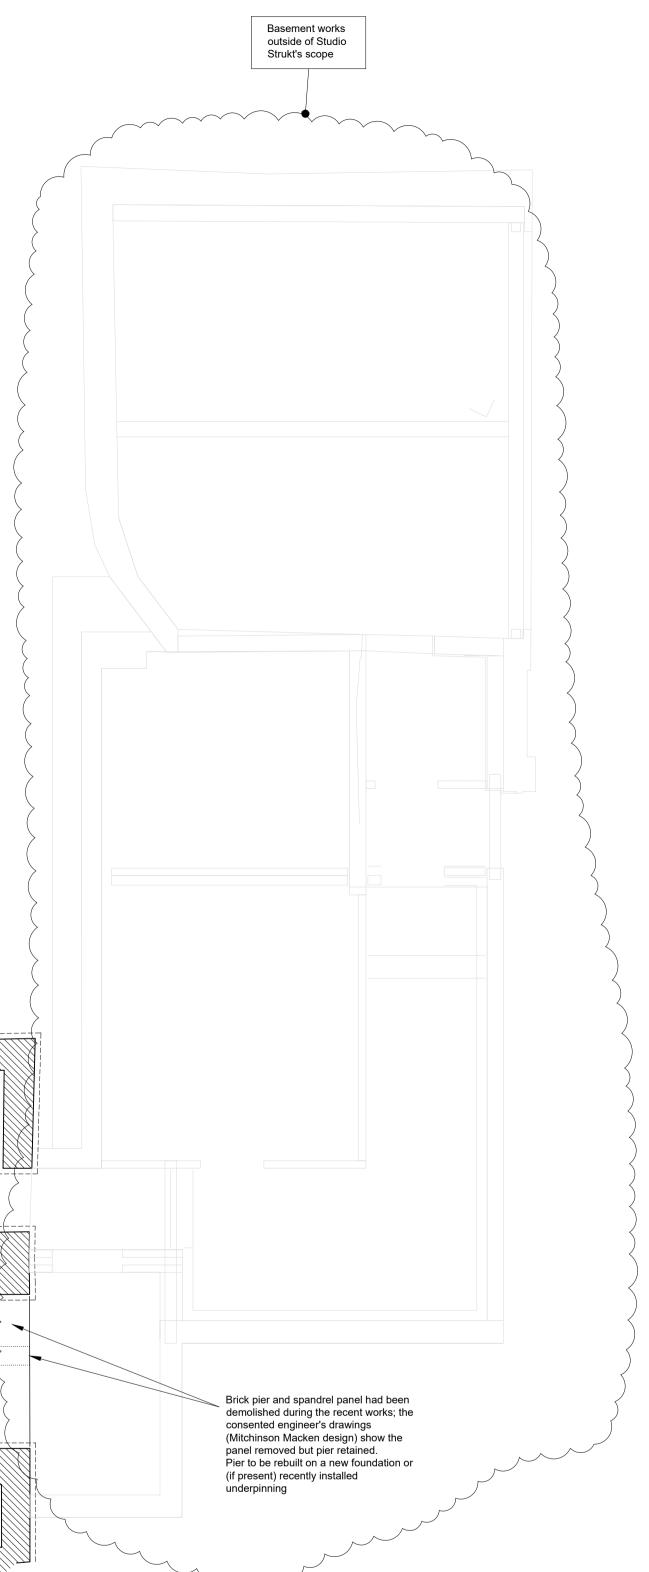

DRAWING NOTE:

This drawing represents a record of our site investigations carried out in June and November 2024. It shows the as-seen structural layouts and provides commentary of condition of remaining historic and adequacy of recently installed elements.

None of the structures shown have been designed or specified by Studio Strukt.

Refer to drawings series 20 for the proposed structural interventions.

Unless noted otherwise, all existing steelwork, concrete and timber structures shown on this drawing are non-historic elements installed during the recent construction works.

All historic timber, steel, and concrete members are marked with (H).

Unless noted otherwise, all masonry structures are assumed to be historic.

All existing member sizes marked with (*) are based on previous engineer's drawings and have not been verified on site. All other existing member sizes are based on on own site measurements.

Drawing key:

Timber:

All existing joist and rafter types listed below are modern, installed during recent works:

<u> </u>	Existing 150x75 C24 joists at 400-430mm c/c
----------	---

C Existing 100x75 C24 joists at 400mm c/c

Older existing joists:

D	(H) 150x50 joists at 400mm c/c - relatively				
modern. Joists inadequate for the pro-					
	roof terrace loads, to be removed.				

Walls:

	Existing masonry		
	Structure demolished during recent works		
	Existing non-load-bearing walls (historic or recently installed, as noted)		
X	Non-load-bearing timber studwork walls installed during recent works		
	Recently installed load-bearing timber studwork wall, comprising 95x70 C24 studs at 450mm c/c approx		
0	Recently installed load-bearing timber studwork wall, comprising 42x95 C24 studs at 400mm c/c approx		

Other:

 Existing foundation under / structure under	
Existing mass concrete or precast padstone (installed during recent works)	
 Historic beams, trimmers, or lintels, retained during recent works - material/function and details as noted on plans	
 Beams, trimmers, or lintels installed during recent works - material/function and details as noted on plans	

GENERAL NOTES:

- All Studio Strukt drawings are to be read in conjunction with the relevant Architect's, Engineer's and Specialist Supplier's drawings and specifications.
- Do not scale from any Studio Strukt drawings. Use stated dimensions only. All dimensions to be verified on site by contractor.
- Fire protection, thermal and sound insulation, and waterproofing are outside of Studio Strukt's scope. Any such elements are shown indicatively only.
- 4. The Contractor is responsible for ensuring the stability of all structures within and adjacent to the site at all times during the contract, and is to design and provide all temporary works required.
- All work subject to Building Control approval, Party Wall agreement, and Listed Building consent. Formation levels of all foundations to be approved on site by Building Control inspector.
- All Studio Strukt plans are drawn 'looking down' and show structure within and immediately below the floor/level the plan refers to. For example, a 1st floor plan shows 1st floor joists, beams within and under 1st floor, and lintels above openings at ground floor level.

		1	
A	Revised as clouded, issued for submission to the Council	03/12/24	вк
-	Issued for comments/coordination	28/11/24	вк
Rev	Description	Date	Ву
		1.1.1	

studio strukt

studiostrukt.co.uk 078 508 75 271 bart@studiostrukt.co.uk

PRELIMINARY Not for construction				
ale	Date	Ву	Checked	
1:50 @ A1	15/11/2024	BK		
oject				
9 The Mount London NW3 6SZ				


Title

Layout and condition of structure as seen in November 2024: Basement Plan

Rev.

А

Drawing No. **24-034/11**

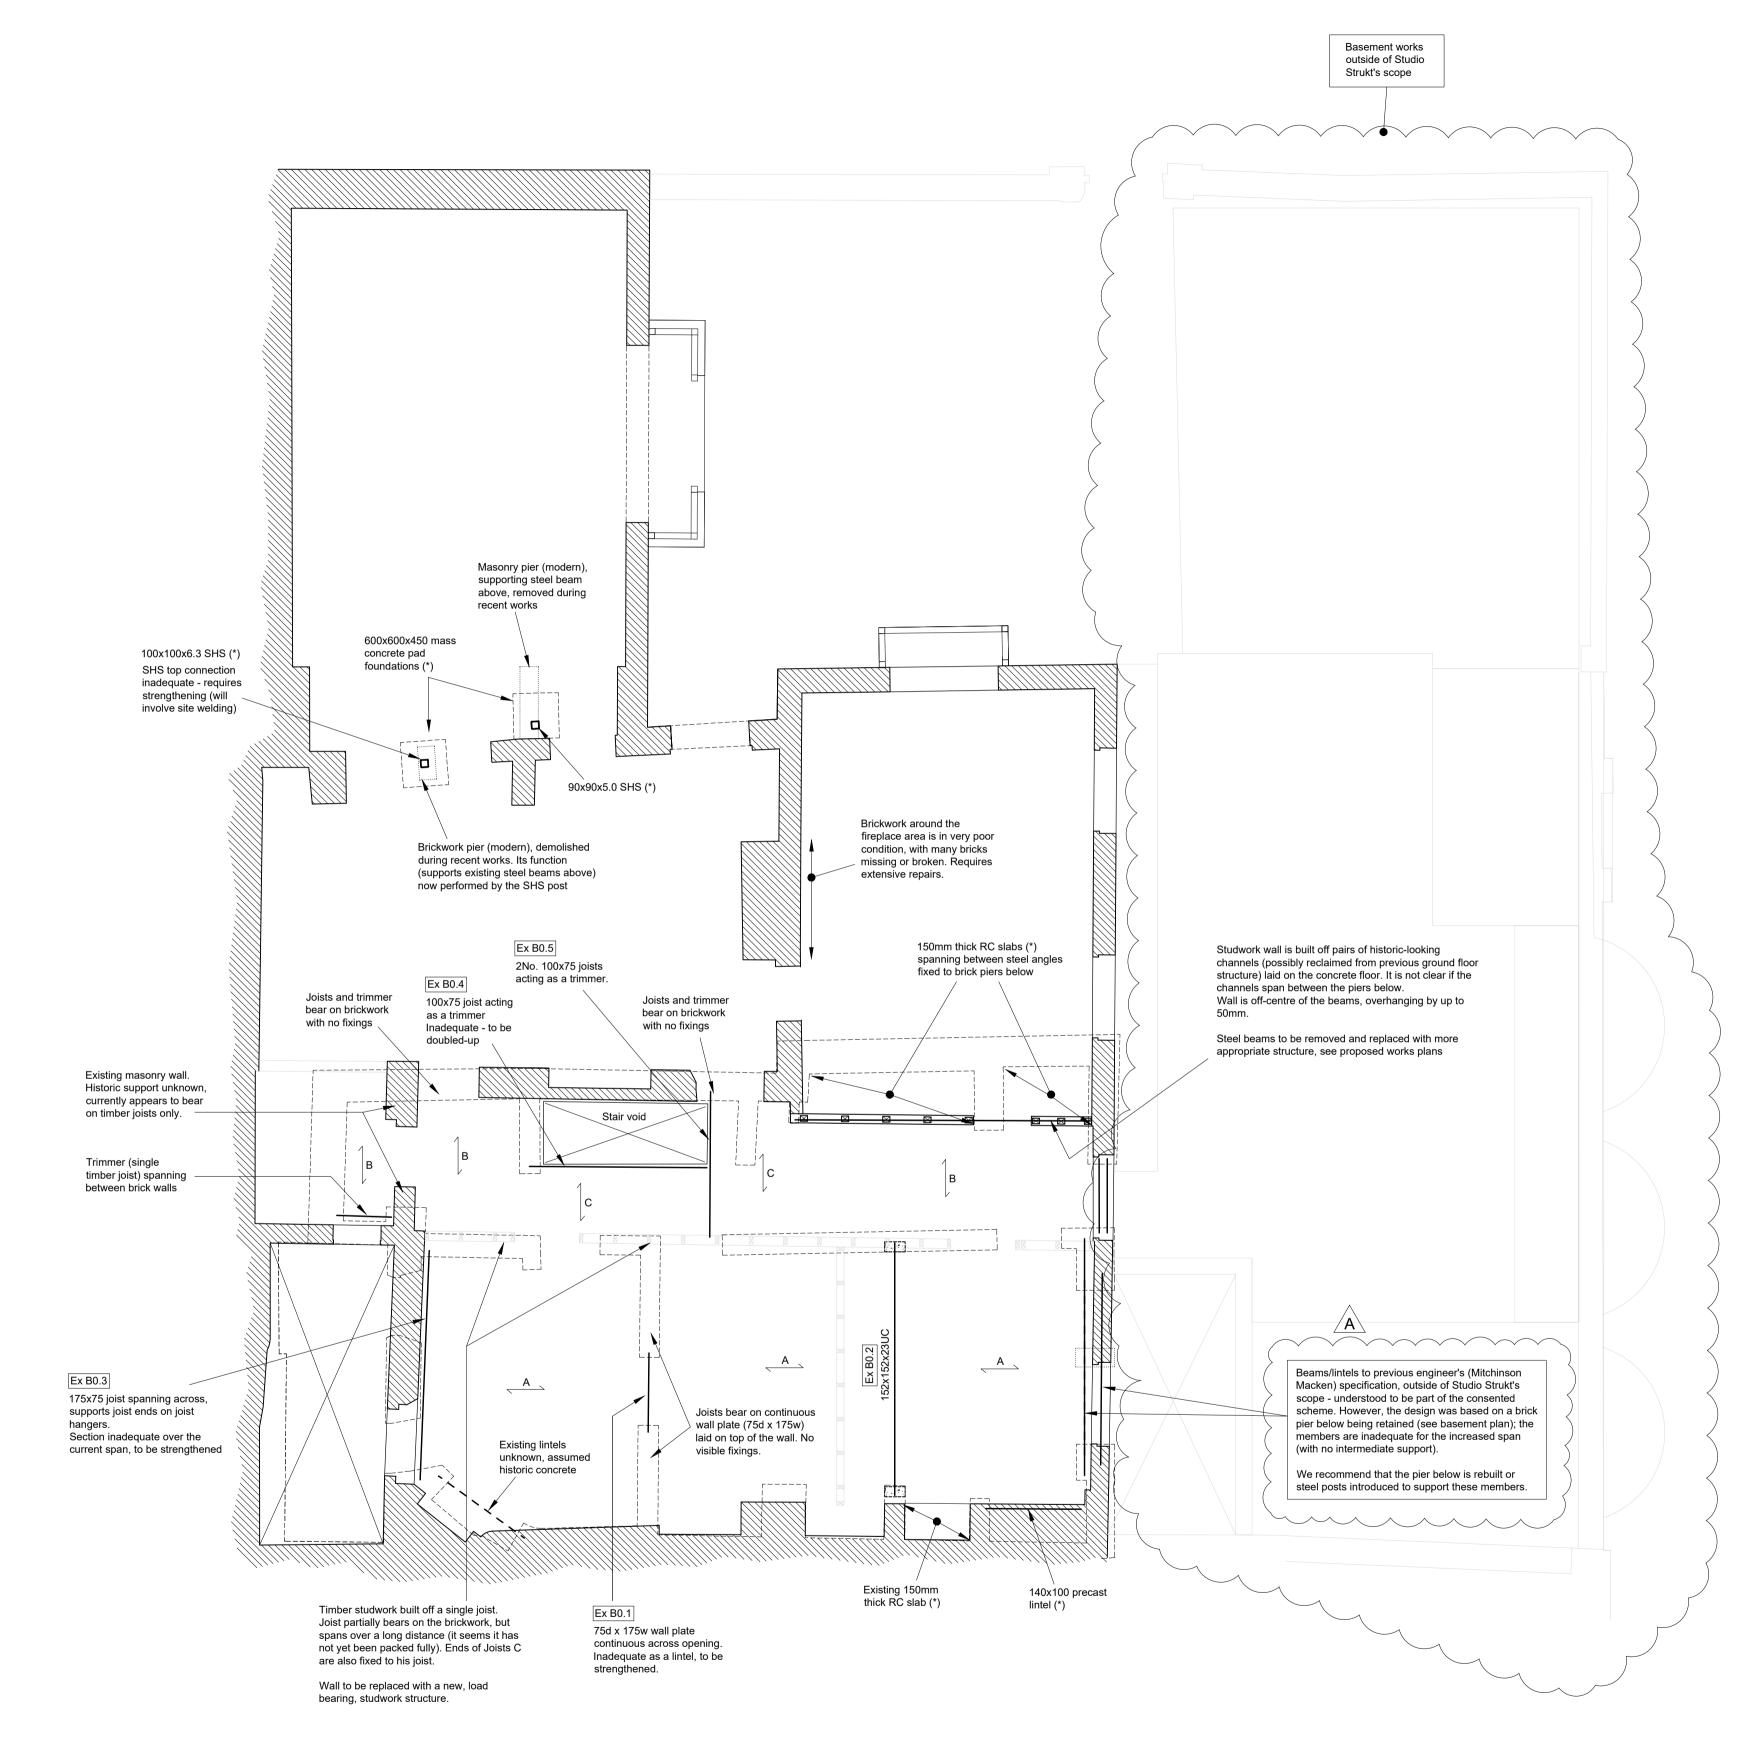

Ground Floor Plan

DRAWING NOTE:

This drawing represents a record of our site investigations carried out in June and November 2024. It shows the as-seen structural layouts and provides commentary of condition of remaining historic and adequacy of recently installed elements.

None of the structures shown have been designed or specified by Studio Strukt.

Refer to drawings series 20 for the proposed structural interventions.

Unless noted otherwise, all existing steelwork, concrete and timber structures shown on this drawing are non-historic elements installed during the recent construction works.

All historic timber, steel, and concrete members are marked with (H).

Unless noted otherwise, all masonry structures are assumed to be historic.

All existing member sizes marked with (*) are based on previous engineer's drawings and have not been verified on site. All other existing member sizes are based on on own site measurements.

Drawing key:

Timber:

All existing joist and rafter types listed below are modern, installed during recent works:

	Existing 175x75 C24 joists at 400-430mm c/c
<u></u>	Existing 150x75 C24 joists at 400-430mm c/c
<u> </u>	Existing 100x75 C24 joists at 400mm c/c

Older existing joists:

Walls:

	Existing masonry
	Structure demolished during recent works
	Existing non-load-bearing walls (historic or recently installed, as noted)
	Non-load-bearing timber studwork walls installed during recent works
	Recently installed load-bearing timber studwork wall, comprising 95x70 C24 studs at 450mm c/c approx
0	Recently installed load-bearing timber studwork wall, comprising 42x95 C24 studs at 400mm c/c approx

Other:

 Existing foundation under / structure under
Existing mass concrete or precast padstone (installed during recent works)
 Historic beams, trimmers, or lintels, retained during recent works - material/function and details as noted on plans
 Beams, trimmers, or lintels installed during recent works - material/function and details as noted on plans

GENERAL NOTES:

- . All Studio Strukt drawings are to be read in conjunction with the relevant Architect's, Engineer's and Specialist Supplier's drawings and specifications.
- 2. Do not scale from any Studio Strukt drawings. Use stated dimensions only. All dimensions to be verified on site by contractor.
- Fire protection, thermal and sound insulation, and waterproofing are outside of Studio Strukt's scope. Any such elements are shown indicatively only.
- 4. The Contractor is responsible for ensuring the stability of all structures within and adjacent to the site at all times during the contract, and is to design and provide all temporary works required.
- All work subject to Building Control approval, Party Wall agreement, and Listed Building consent.
 Formation levels of all foundations to be approved on site by Building Control inspector.
- All Studio Strukt plans are drawn 'looking down' and show structure within and immediately below the floor/level the plan refers to. For example, a 1st floor plan shows 1st floor joists, beams within and under 1st floor, and lintels above openings at ground floor level.

A	Revised as clouded, issued for submission to the Council	03/12/24	вк
-	Issued for comments/coordination	28/11/24	вк
Rev	Description	Date	Ву
		1	

studio strukt

studiostrukt.co.uk 078 508 75 271 bart@studiostrukt.co.uk PRFI IMINARY


	Not for co	nstruction	
ale	Date	Ву	Checked
1:50 @ A1	15/11/2024	BK	
roject			
9 The Mount London NW3 6SZ			

Title

Layout and condition of structure as seen in November 2024: Ground Floor Plan

А

24-034/12

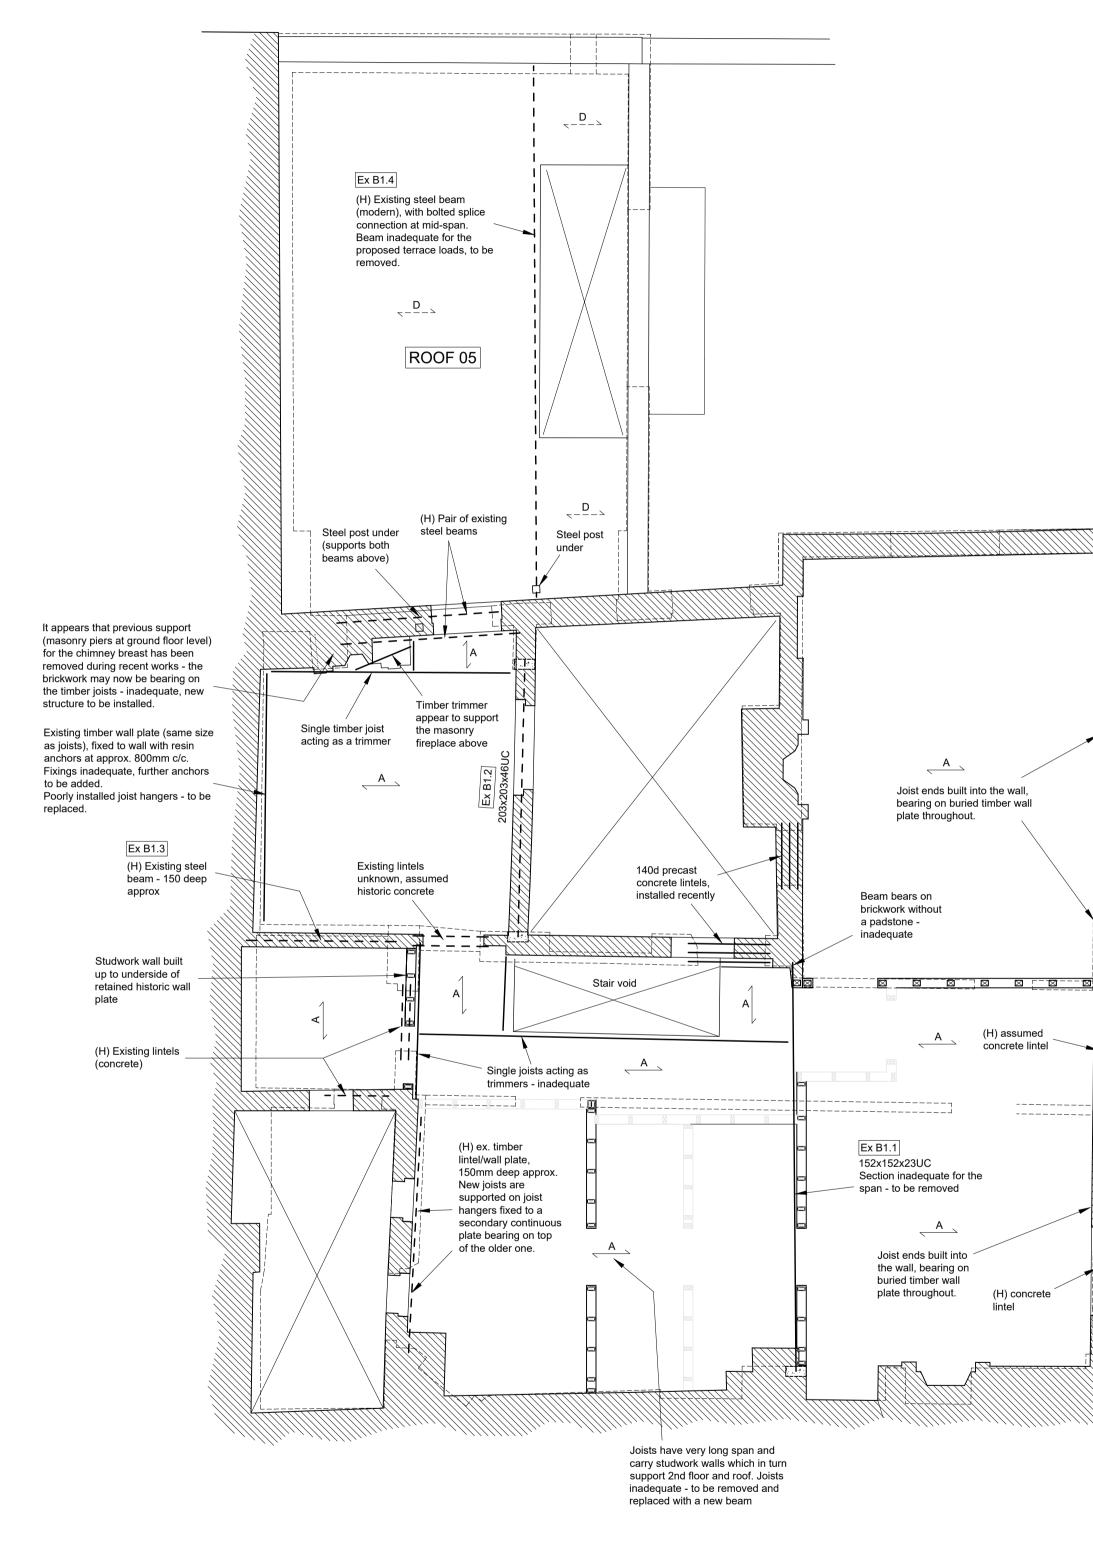

1st Floor Plan

(H) 100d concrete lintel (H) assumed concrete lintel TImber wall plate has been replaced during recent works

DRAWING NOTE:

This drawing represents a record of our site investigations carried out in June and November 2024. It shows the as-seen structural layouts and provides commentary of condition of remaining historic and adequacy of recently installed elements.

None of the structures shown have been designed or specified by Studio Strukt.

Refer to drawings series 20 for the proposed structural interventions.

Unless noted otherwise, all existing steelwork, concrete and timber structures shown on this drawing are non-historic elements installed during the recent construction works.

All historic timber, steel, and concrete members are marked with (H).

Unless noted otherwise, all masonry structures are assumed to be historic.

All existing member sizes marked with (*) are based on previous engineer's drawings and have not been verified on site. All other existing member sizes are based on on own site measurements.

Drawing key:

Timber:

All existing joist and rafter types listed below are modern, installed during recent works:

 Existing 175x75 C24 joists at 400-430mm c/c

Existi	ng 150x75 C24 joists at 400-430mm c/c
--------	---------------------------------------

C Existing 100x75 C24 joi	sts at 400mm c/c
---------------------------	------------------

Older existing joists:

D	(H) 150x50 joists at 400mm c/c - relatively
<	modern. Joists inadequate for the proposed
	roof terrace loads, to be removed.

Walls:

	Existing masonry
	Structure demolished during recent works
	Existing non-load-bearing walls (historic or recently installed, as noted)
	Non-load-bearing timber studwork walls installed during recent works
	Recently installed load-bearing timber studwork wall, comprising 95x70 C24 studs at 450mm c/c approx
0	Recently installed load-bearing timber studwork wall, comprising 42x95 C24 studs at 400mm c/c approx

Other:

 Existing foundation under / structure under
Existing mass concrete or precast padstone (installed during recent works)
 Historic beams, trimmers, or lintels, retained during recent works - material/function and details as noted on plans
 Beams, trimmers, or lintels installed during recent works - material/function and details as noted on plans

GENERAL NOTES:

- 1. All Studio Strukt drawings are to be read in conjunction with the relevant Architect's, Engineer's
- and Specialist Supplier's drawings and specifications. 2. Do not scale from any Studio Strukt drawings. Use stated dimensions only. All dimensions to be verified
- on site by contractor. 3. Fire protection, thermal and sound insulation, and
- waterproofing are outside of Studio Strukt's scope. Any such elements are shown indicatively only.
- 4. The Contractor is responsible for ensuring the stability of all structures within and adjacent to the site at all times during the contract, and is to design and provide all temporary works required.
- 5. All work subject to Building Control approval, Party Wall agreement, and Listed Building consent. Formation levels of all foundations to be approved on site by Building Control inspector.
- 6. All Studio Strukt plans are drawn 'looking down' and show structure within and immediately below the floor/level the plan refers to. For example, a 1st floor plan shows 1st floor joists, beams within and under 1st floor, and lintels above openings at ground floor level.

A	Revised as clouded, issued for submission to the Council	03/12/24	вк
-	Issued for comments/coordination	28/11/24	вк
Rev	Description	Date	Ву
studio strukt			

SLUGIO SLIUKL

studiostrukt.co.uk 078 508 75 271 bart@studiostrukt.co.uk

PRELIMINARY Not for construction				
le	Date	Ву	Checked	
:50 @ A1	15/11/2024	BK		

Rev.

А

Title


Project

9 The Mount

London NW3 6SZ

Layout and condition of structure as seen in November 2024: 1st Floor Plan

Drawing No. 24-034/13

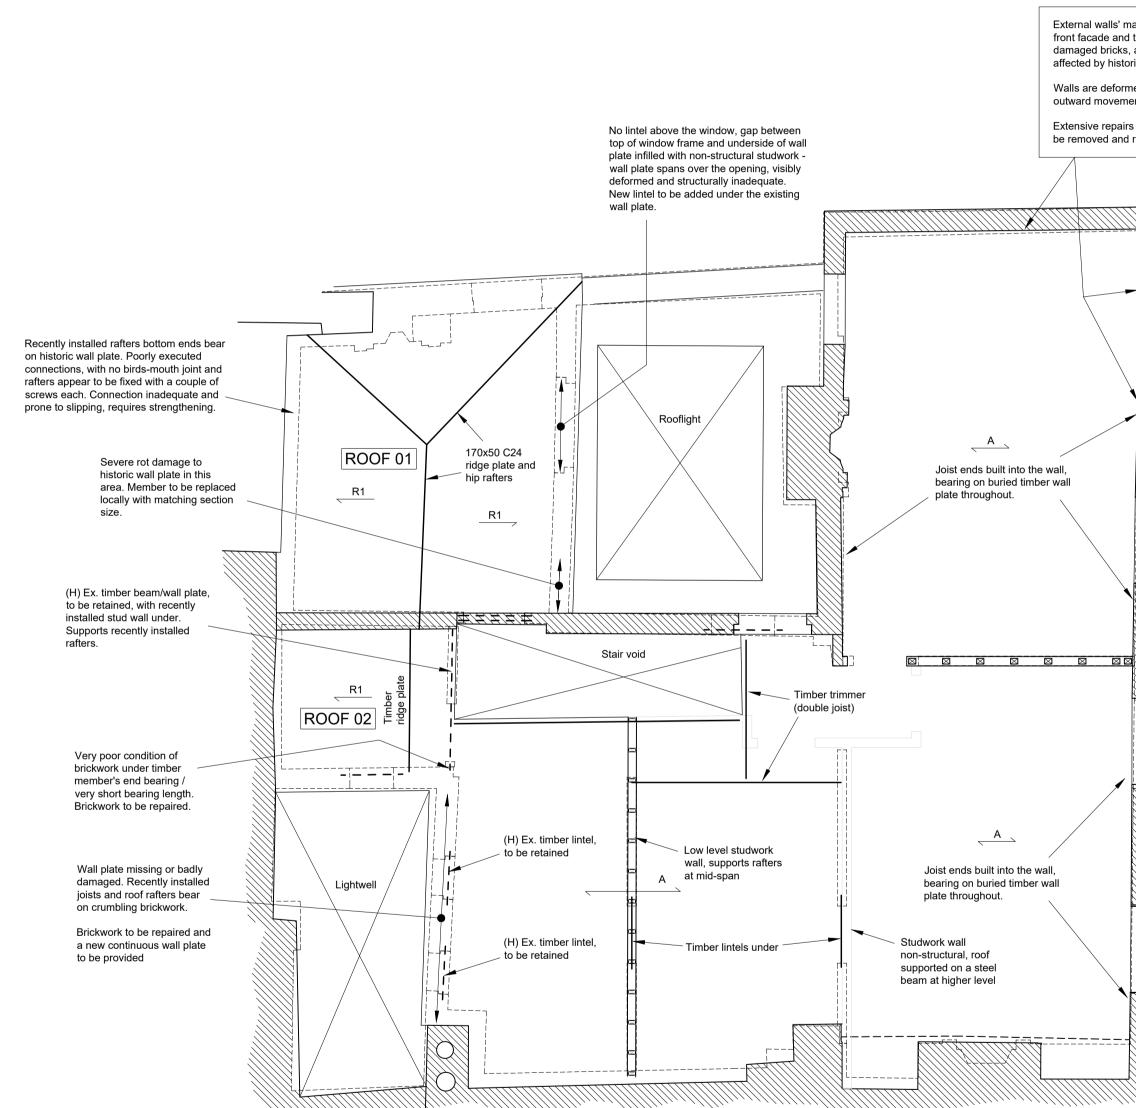

2nd Floor Plan

External walls' masonry in very poor condition throughout the front facade and the end wall, with mortar joints missing, damaged bricks, and timber plates buried in brickwork, visibly affected by historic moisture ingress and rot. Walls are deformed near this corner in particular, it appears that outward movement had occurred both to the front and end walls.

Extensive repairs will be required, and the timber plates should be removed and replaced with brickwork infills.

> No lintels above windows, across the openings. locations.

timber wall plate (H) spans across the openings.

Wall plate defective in this location, joint slipped with approx.40mm horizontal movement. Timber plate discontinuous over the opening as result, no support to the brick panel above.

No lintels above windows, timber wall plate (H) spans across the openings.

> No lintels above windows, timber wall plate (H) spans

 (H) buried timber wall plate with significant damage, most likely due to historic rot - loss of material and very poor bearing for joists in many

No lintels above windows, - timber wall plate (H) spans across the openings.

DRAWING NOTE:

This drawing represents a record of our site investigations carried out in June and November 2024. It shows the as-seen structural layouts and provides commentary of condition of remaining historic and adequacy of recently installed elements.

None of the structures shown have been designed or specified by Studio Strukt.

Refer to drawings series 20 for the proposed structural interventions.

Unless noted otherwise, all existing steelwork, concrete and timber structures shown on this drawing are non-historic elements installed during the recent construction works.

All historic timber, steel, and concrete members are marked with (H).

Unless noted otherwise, all masonry structures are assumed to be historic.

All existing member sizes marked with (*) are based on previous engineer's drawings and have not been verified on site. All other existing member sizes are based on on own site measurements.

Drawing key:

Timber:

All existing joist and rafter types listed below are modern, installed during recent works:

installed dt	anng recent works:
	Existing 175x75 C24 joists at 400-430mm c/c
<u> </u>	Existing 150x75 C24 joists at 400-430mm c/c
<u> </u>	Existing 100x75 C24 joists at 400mm c/c
R1	95x70 C24 rafters at 400mm c/c
R2	70w C24 rafters at 400mm c/c

Older existing joists:

D (H) 150x50 joists at 400mm c/c - relatively modern. Joists inadequate for the proposed roof terrace loads, to be removed.

Walls:

Existing masonry	
Structure demolished during recent works	
Existing non-load-bearing walls (historic or recently installed, as noted)	
Non-load-bearing timber studwork walls installed during recent works	
Recently installed load-bearing timber studwork wall, comprising 95x70 C24 studs at 450mm c/c approx	
Recently installed load-bearing timber studwork wall, comprising 42x95 C24 studs at 400mm c/c approx	

Other:

Existing foundation under / structure under	
	Existing mass concrete or precast padstone (installed during recent works)
	Historic beams, trimmers, or lintels, retained during recent works - material/function and details as noted on plans
	Beams, trimmers, or lintels installed during recent works - material/function and details as noted on plans

GENERAL NOTES:

- All Studio Strukt drawings are to be read in conjunction with the relevant Architect's, Engineer's and Specialist Supplier's drawings and specifications.
- 2. Do not scale from any Studio Strukt drawings. Use stated dimensions only. All dimensions to be verified on site by contractor.
- 3. Fire protection, thermal and sound insulation, and waterproofing are outside of Studio Strukt's scope. Any such elements are shown indicatively only.
- 4. The Contractor is responsible for ensuring the stability of all structures within and adjacent to the site at all times during the contract, and is to design and provide all temporary works required.
- 5. All work subject to Building Control approval, Party Wall agreement, and Listed Building consent. Formation levels of all foundations to be approved on site by Building Control inspector.
- 6. All Studio Strukt plans are drawn 'looking down' and show structure within and immediately below the floor/level the plan refers to. For example, a 1st floor plan shows 1st floor joists, beams within and under 1st floor, and lintels above openings at ground floor level.

ARevised as clouded, issued for submission to the Council03/12/24BK-Issued for comments/coordination28/11/24BKRevDescriptionDateByStudio Struckt				
the Council Issued for comments/coordination 28/11/24 BK Rev Description Date By				
the Council Issued for comments/coordination 28/11/24 BK Rev Description Date By				
the Council Issued for comments/coordination 28/11/24 BK Rev Description Date By				
the Council Issued for comments/coordination 28/11/24 BK Rev Description Date By				
Rev Description Date By	A		03/12/24	ВК
	-	Issued for comments/coordination	28/11/24	вк
studio stru <mark>k</mark> t	Rev	Description	Date	Ву
studio stru <mark>k</mark> t				
Studio Strukt		ctudio ctru	1/+	
		Studio Stru	Kι	

studiostrukt.co.uk 078 508 75 271 bart@studiostrukt.co.uk				
PRELIMINARY Not for construction				
Scale	Date	Ву	Checked	
1:50 @ A1 15/11/2024 BK				
Project				
9 The M	lount			

Title


Layout and condition of structure as seen in November 2024: 2nd Floor Plan

Rev.

А

Drawing No. 24-034/14

London NW3 6SZ

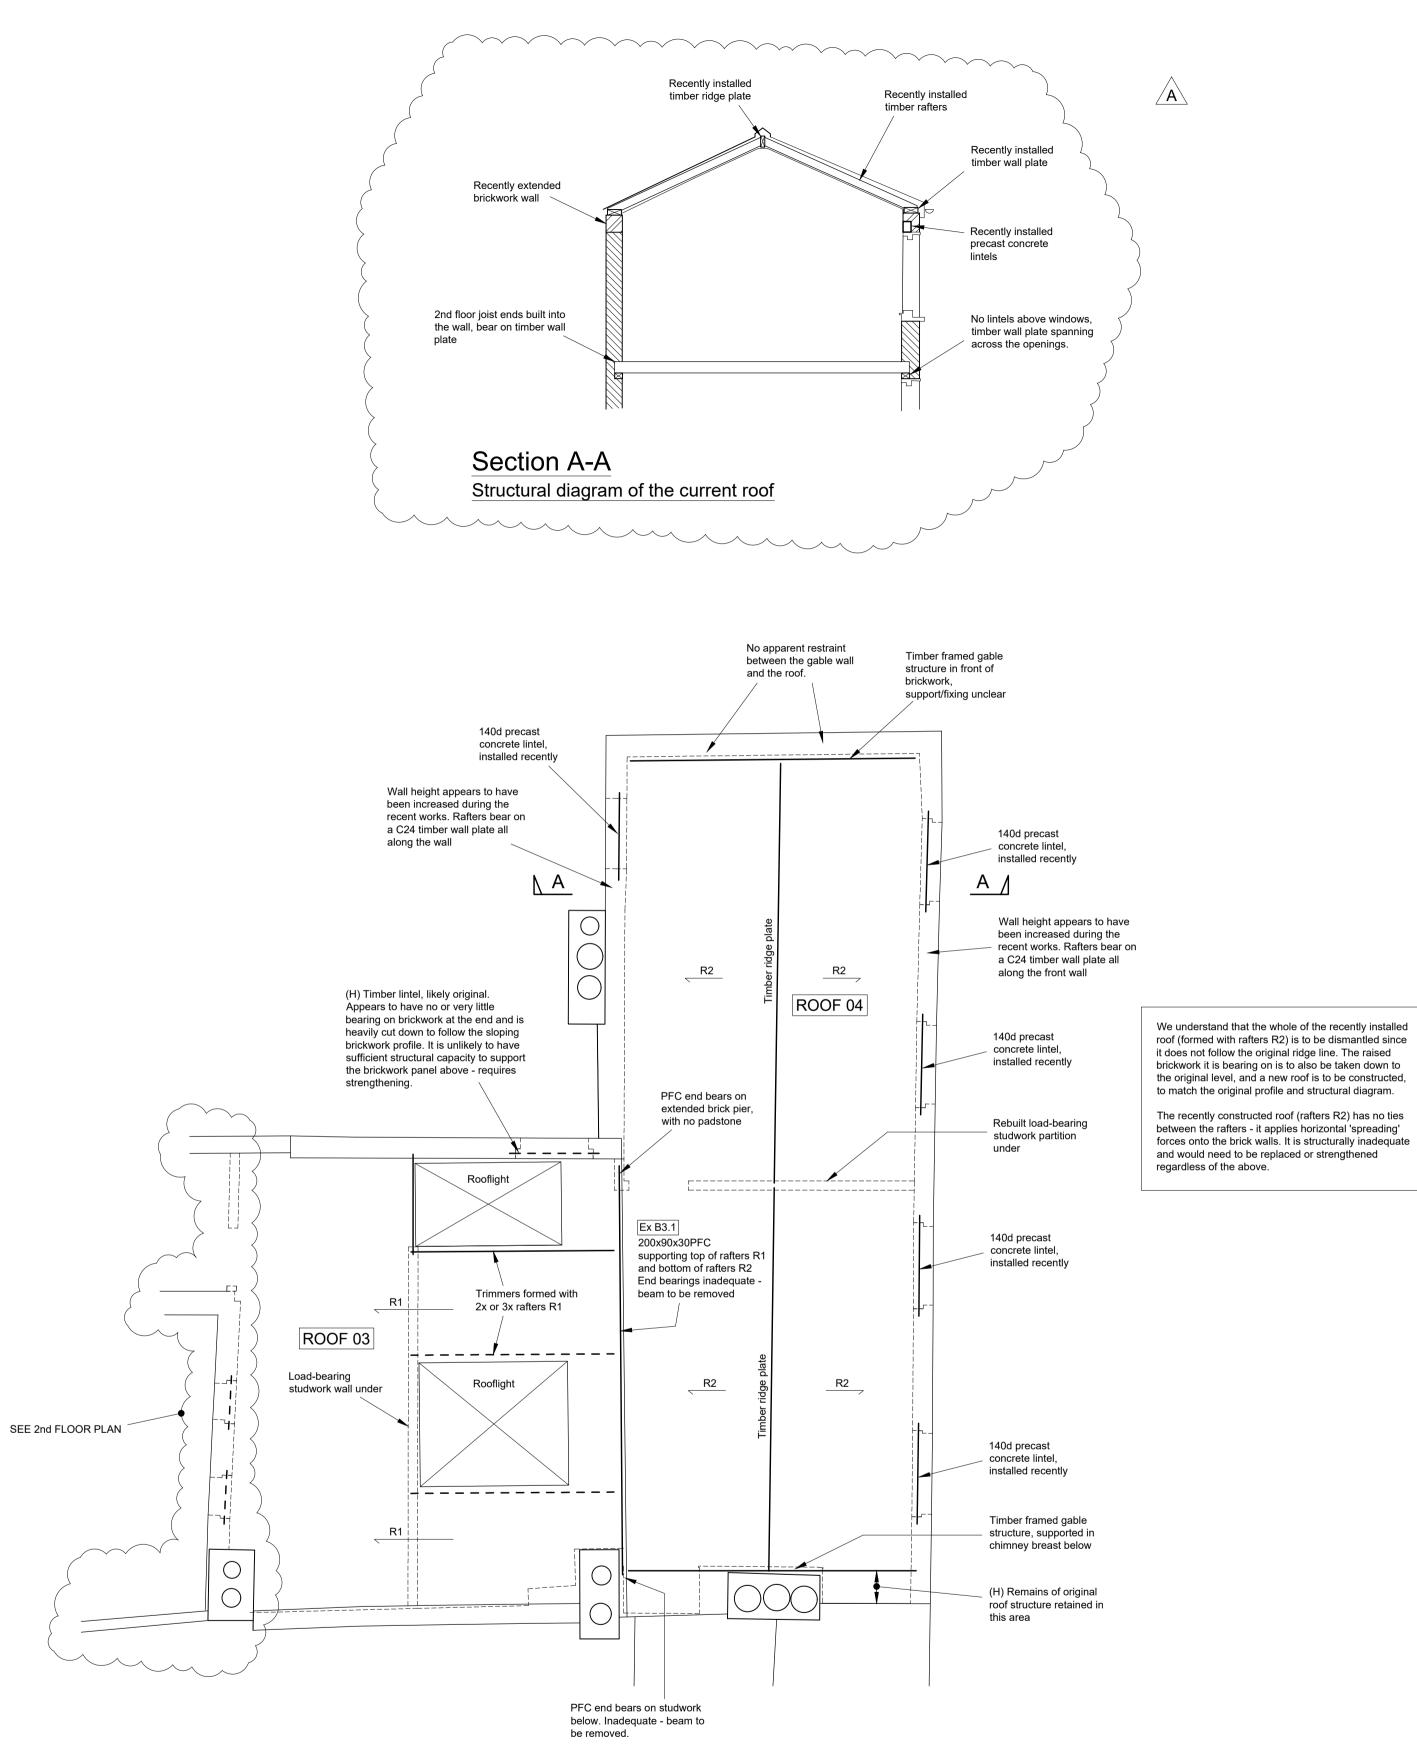

Roof Plan

DRAWING NOTE:

This drawing represents a record of our site investigations carried out in June and November 2024. It shows the as-seen structural layouts and provides commentary of condition of remaining historic and adequacy of recently installed elements.

None of the structures shown have been designed or specified by Studio Strukt.

Refer to drawings series 20 for the proposed structural interventions.

Unless noted otherwise, all existing steelwork, concrete and timber structures shown on this drawing are non-historic elements installed during the recent construction works.

All historic timber, steel, and concrete members are marked with (H).

Unless noted otherwise, all masonry structures are assumed to be historic.

All existing member sizes marked with (*) are based on previous engineer's drawings and have not been verified on site. All other existing member sizes are based on on own site measurements.

Drawing key:

Timber:

All existing joist and rafter types listed below are modern, installed during recent works:

installed dt	anng recent works:
	Existing 175x75 C24 joists at 400-430mm c/c
<u> </u>	Existing 150x75 C24 joists at 400-430mm c/c
<u> </u>	Existing 100x75 C24 joists at 400mm c/c
R1	95x70 C24 rafters at 400mm c/c
R2	70w C24 rafters at 400mm c/c

Older existing joists:

D (H) 150x50 joists at 400mm c/c - relatively modern. Joists inadequate for the proposed roof terrace loads, to be removed.

Walls:

Existing masonry	
Structure demolished during recent works	
Existing non-load-bearing walls (historic or recently installed, as noted)	
Non-load-bearing timber studwork walls installed during recent works	
Recently installed load-bearing timber studwork wall, comprising 95x70 C24 studs at 450mm c/c approx	
Recently installed load-bearing timber studwork wall, comprising 42x95 C24 studs at 400mm c/c approx	

Other:

Existing foundation under / structure under	
	Existing mass concrete or precast padstone (installed during recent works)
	Historic beams, trimmers, or lintels, retained during recent works - material/function and details as noted on plans
	Beams, trimmers, or lintels installed during recent works - material/function and details as noted on plans

GENERAL NOTES:

- All Studio Strukt drawings are to be read in conjunction with the relevant Architect's, Engineer's and Specialist Supplier's drawings and specifications.
- 2. Do not scale from any Studio Strukt drawings. Use stated dimensions only. All dimensions to be verified on site by contractor.
- 3. Fire protection, thermal and sound insulation, and waterproofing are outside of Studio Strukt's scope. Any such elements are shown indicatively only.
- 4. The Contractor is responsible for ensuring the stability of all structures within and adjacent to the site at all times during the contract, and is to design and provide all temporary works required.
- 5. All work subject to Building Control approval, Party Wall agreement, and Listed Building consent. Formation levels of all foundations to be approved on site by Building Control inspector.
- 6. All Studio Strukt plans are drawn 'looking down' and show structure within and immediately below the floor/level the plan refers to. For example, a 1st floor plan shows 1st floor joists, beams within and under 1st floor, and lintels above openings at ground floor level.

A	Revised as clouded, issued for submission to the Council	03/12/24	вк	
-	Issued for comments/coordination	28/11/24	вк	
Rev	Description	Date	Ву	
studio strukt				
Studio Strukt				

studiostrukt.co.uk 078 508 75 271 bart@studiostrukt.co.uk					
PRELIMINARY Not for construction					
Scale	Date	Ву	Checked		
1:50 @ A1	15/11/2024	ВК			
Project					
9 The Mount					

Title

Layout and condition of structure as seen in November 2024: Roof Plan

Rev.

А


Drawing No. 24-034/15

London NW3 6SZ


<u>Appendix C</u>

Drawings 21-25


Proposed structural works

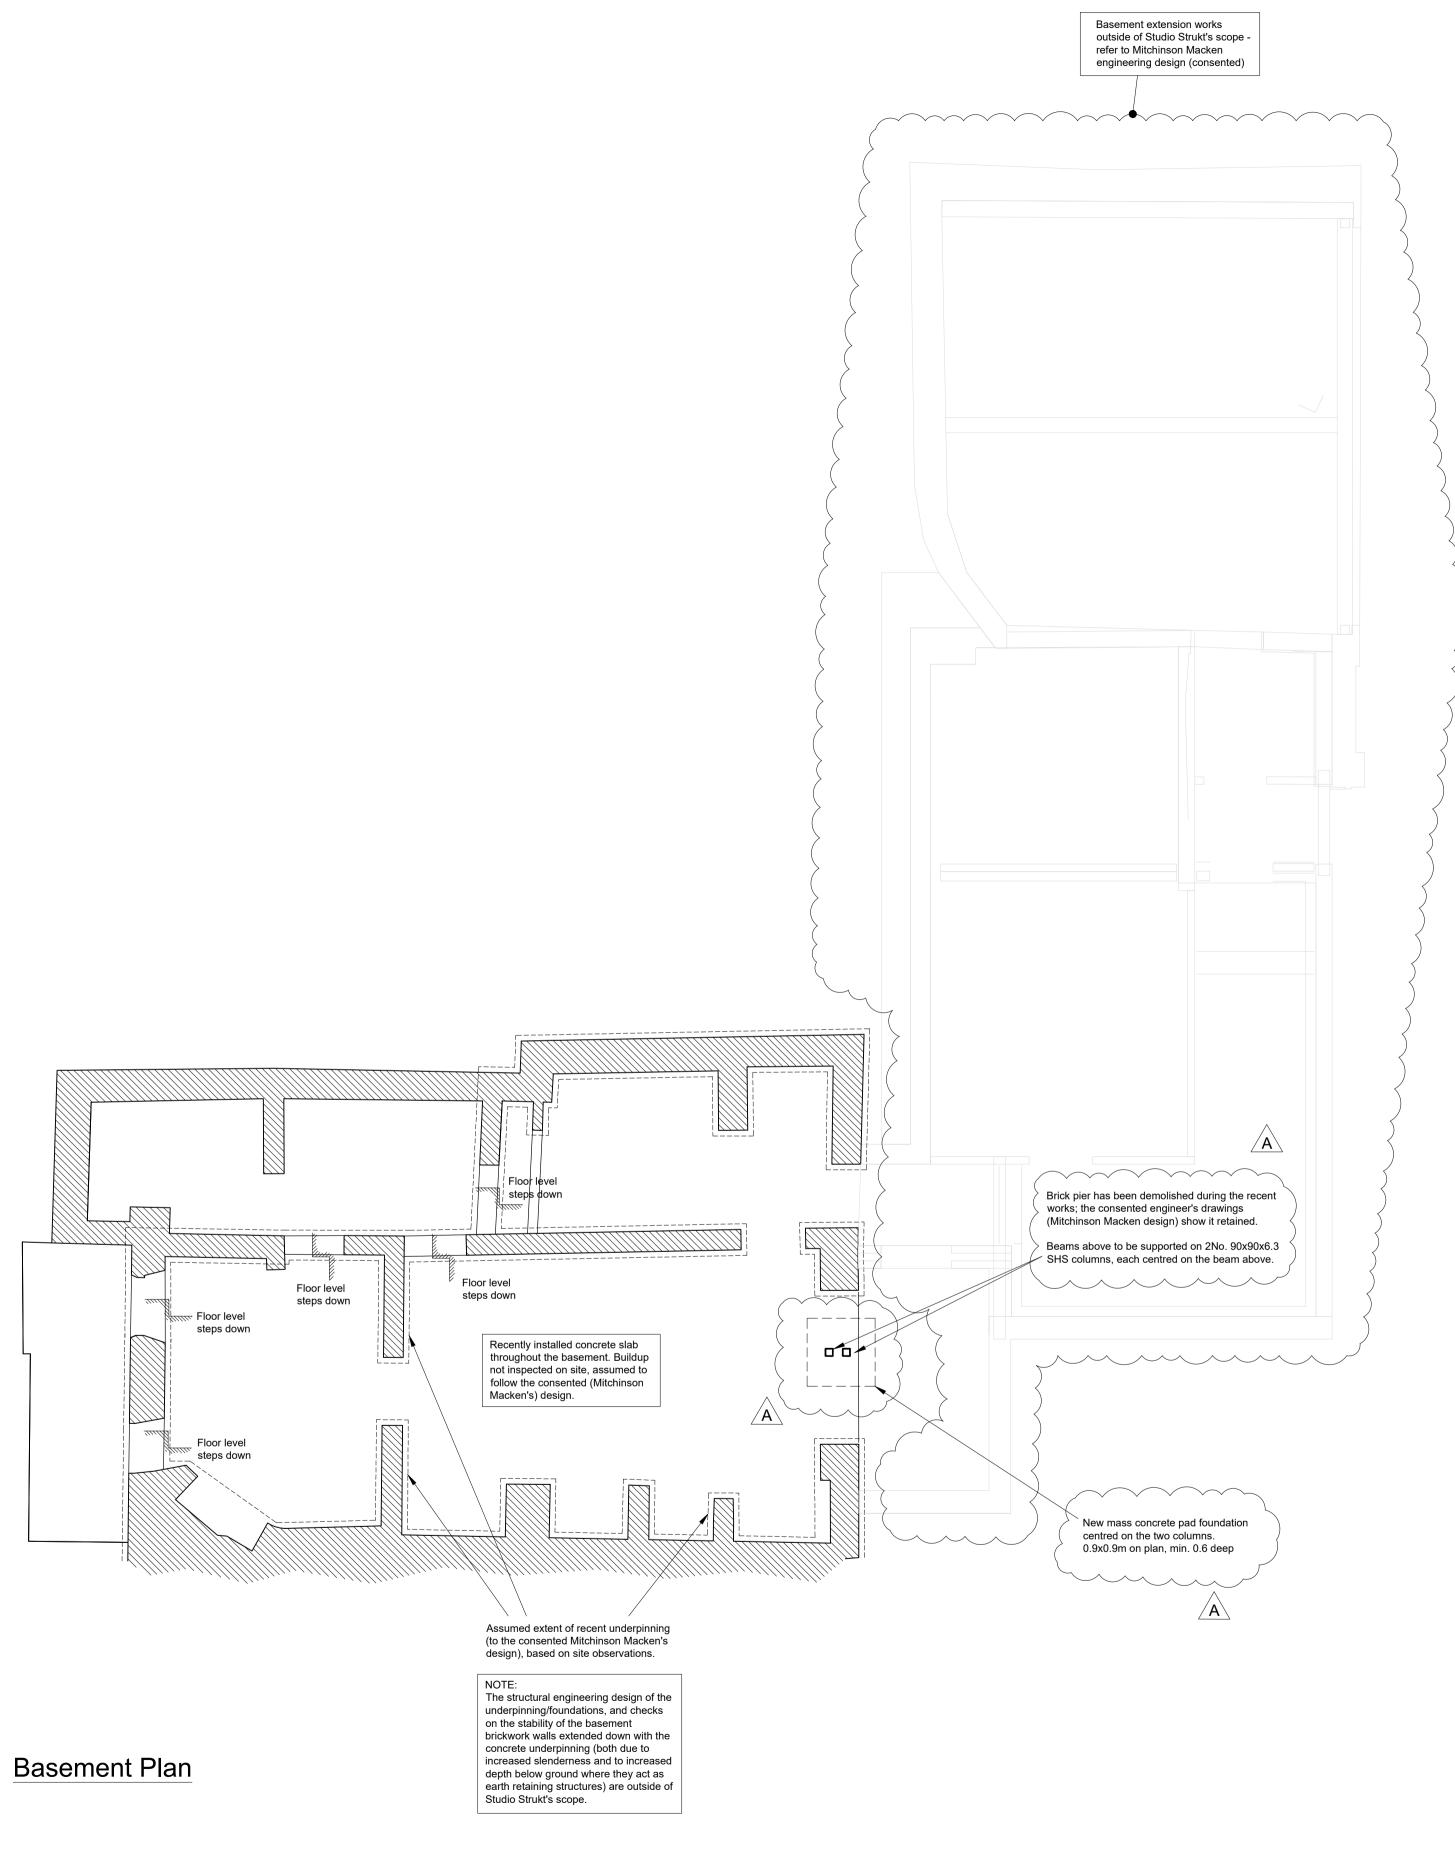

Drawing	key:	GENERAL NOTES: 1. All Studio Strukt drawings are to be read in
Timber:		conjunction with the relevant Architect's, Engineer's and Specialist Supplier's drawings and specifications.2. Do not scale from any Studio Strukt drawings. Use
All existing installed d	j joist and rafter types listed below are modern, uring recent works:	stated dimensions only. All dimensions to be verified on site by contractor.3. Fire protection, thermal and sound insulation, and
~	Existing 175x75 C24 joists at 400-430mm c/c	 Fire protection, thermal and sound insulation, and waterproofing are outside of Studio Strukt's scope. Any such elements are shown indicatively only.
~- <u>B</u> ->	Existing 150x75 C24 joists at 400-430mm c/c	 The Contractor is responsible for ensuring the stability of all structures within and adjacent to the site at all times during the contract, and is to design and
~- <u>c</u> -~	Existing 100x75 C24 joists at 400mm c/c	provide all temporary works required.5. All work subject to Building Control approval, Party Wall agreement, and Listed Building consent.
Walls:		Formation levels of all foundations to be approved on site by Building Control inspector.
	New brickwork - all brickwork infills to be fully	 All Studio Strukt plans are drawn 'looking down' and show structure within and immediately below the floor/level the plan refers to. For example, a 1st floor plan shows 1st floor joists, beams within and under
	toothed and bonded with existing brickwork Existing masonry	1st floor, and lintels above openings at ground floor level.
	Existing non-load-bearing walls (historic or recently installed, as noted)	Unless noted otherwise, all existing steelwork,
	Non-load-bearing timber studwork walls installed during recent works	concrete and timber structures shown on this drawing are non-historic elements installed during the recent construction works.
X X	Existing (recently installed) load-bearing	All historic timber, steel, and concrete members are marked with (H).
	timber studwork wall, comprising 95x70 C24 studs at 450mm c/c approx; to be retained	Unless noted otherwise, all masonry structures are assumed to be historic.
	Existing (recently installed) load-bearing timber studwork wall, comprising 42x95 C24 studs at 400mm c/c approx; to be retained	All existing member sizes marked with (*) are based on previous engineer's drawings and have not been verified on site. All other existing member sizes are based on on own site measurements.
<u> </u>	New load-bearing timber studwork wall, comprising 50x100 C24 studs at 400mm c/c max, and 100x50 bottom and top plates. Double studs to be used at all wall corners and ends. Solid timber noggins to be installed between all studs, at 900mm vertical c/c max.	
Other / g	eneral:	
	Existing foundation under / structure under	
	New foundation under / structure under Existing mass concrete or precast padstone	
	(installed during recent works)	
	Existing beams, trimmers, or lintels, to be retained retained - material/function and details as noted on plans. For further details (including whether the members are historic or installed recently) refer to drawings series 11-15	
	Proposed beams, trimmers, or lintels Structure to be demolished	
		A Revised as clouded, issued for submission to the Council 03/12/24 BK - Issued for comments/coordination 28/11/24 BK Rev Description Date By Studiostrukt.co.uk 078 508 75 271 bart@studiostrukt.co.uk PRELIMINARY Not for construction Scale Date By 1:50 @ A1 15/11/2024 BK Exceeded Project 9 The Mount London NW3 6SZ Exceeded Exceeded Title Proposed structural works: Basement Plan
		Drawing No. Rev. A

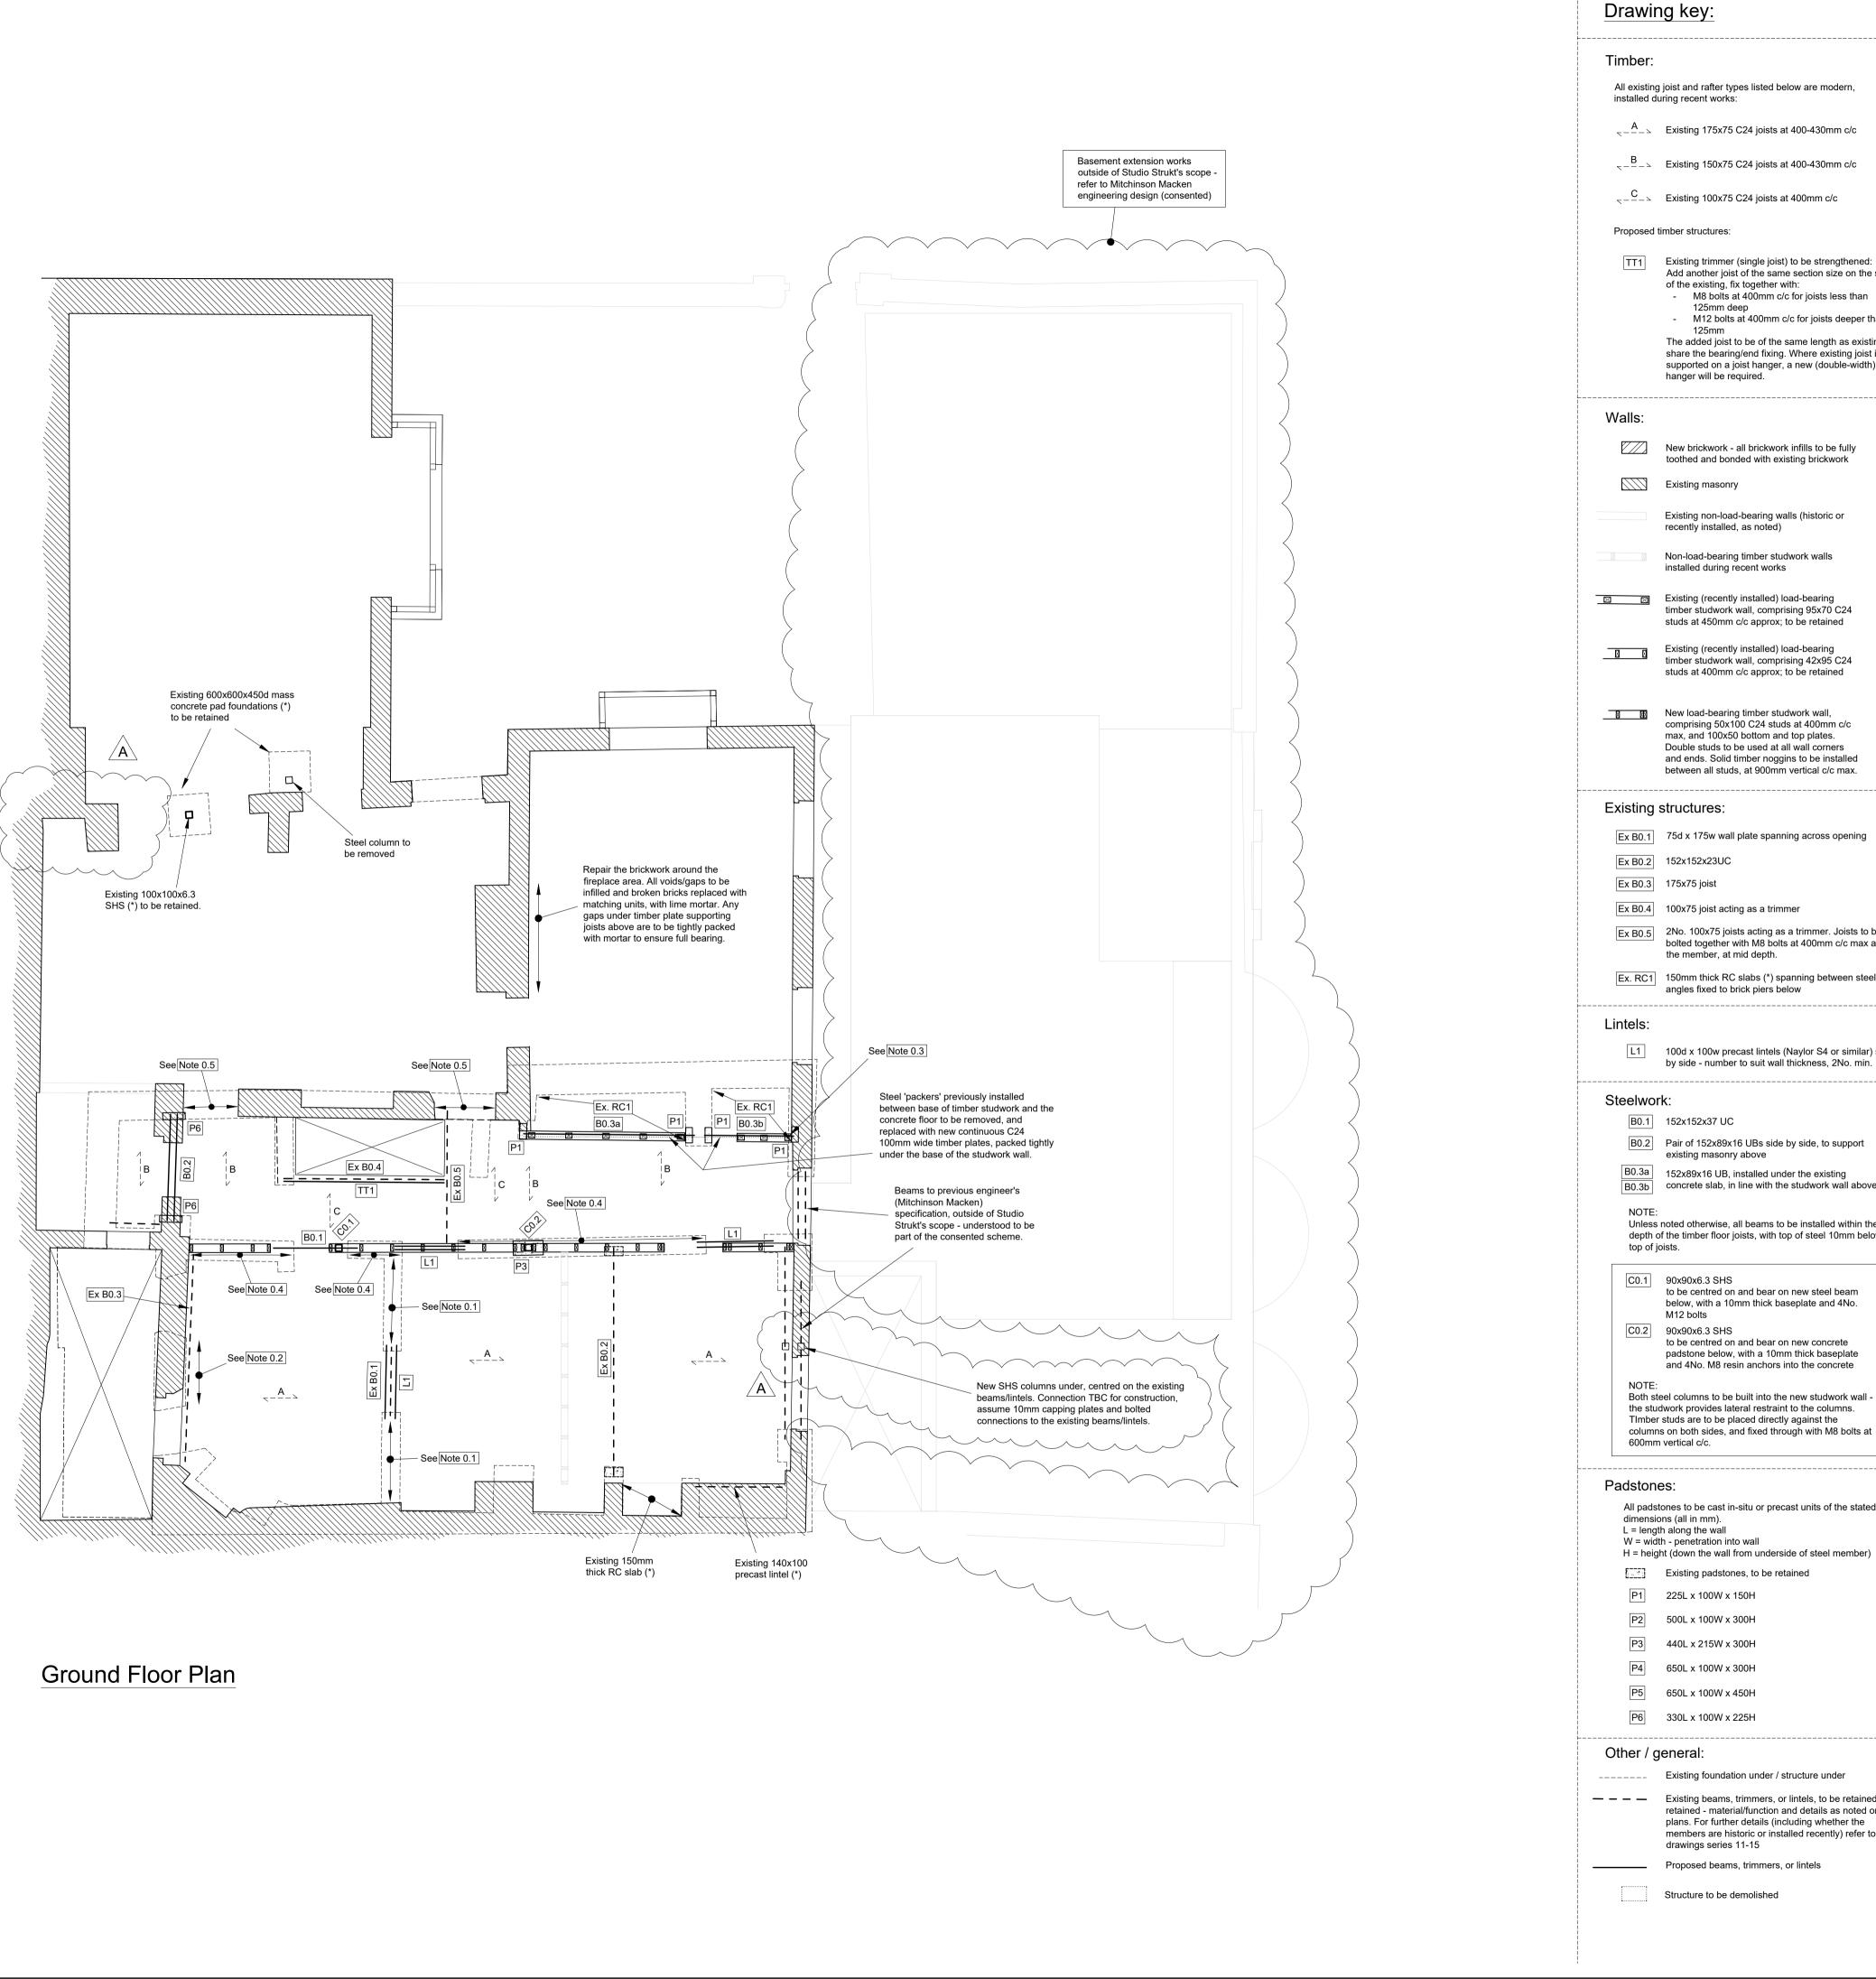


	Repair/strengtheing specification:	GENERAL NOTES:
		 All Studio Strukt drawings are to be read in conjunction with the relevant Architect's, Engineer's and Specialist Supplier's drawings and specifications.
	Note 0.1 Secure previously installed timber wall plate to brickwork and fix joists:	 Do not scale from any Studio Strukt drawings. Use stated dimensions only. All dimensions to be verified
	 Ensure any gaps between top of brickwork and underside of timber plate are tightly packed with mortar. 	on site by contractor.3. Fire protection, thermal and sound insulation, and
	 Fix the wall plate to the top of brick wall with M8 Hilti HAS-U rods and HIT-HY-170 injection mortar, at 600mm max c/c along the wall. Anchors to be positioned as clear to the control of the wall on 	waterproofing are outside of Studio Strukt's scope. Any such elements are shown indicatively only.4. The Contractor is responsible for ensuring the
	 positioned as close to the centreline of the wall as possible and penetrate min. 150mm into masonry. 3. Also provide vertical steel restraint straps at 900mm max c/c, extending min. 750mm down the wall and bent over the top of the wall plate. Fix to 	stability of all structures within and adjacent to the site at all times during the contract, and is to design and provide all temporary works required.
ed:	 wall using plug-and screw fixings and to timber using wood screws. 4. Secure joists to wall plate using proprietary steel angle brackets or truss clips (Expamet or similar) and install full depth timber blocking between joist 	 All work subject to Building Control approval, Party Wall agreement, and Listed Building consent. Formation levels of all foundations to be approved on site by Building Control inspector.
the side	ends, along their bearing on the wall plate.	 All Studio Strukt plans are drawn 'looking down' and show structure within and immediately below the floor/level the plan refers to. For example, a 1st floor plan shows 1st floor joists, beams within and under
kisting, to	Note 0.2 Provide additional support to Ex.B0.3: 1. Install minimum 6No. M12 Hilti HAS-U rods and HIT HX 170 injection matter, through the side of	1st floor, and lintels above openings at ground floor level.
dth)	HIT-HY-170 injection mortar, through the side of the joist and into brickwork behind, min. 100mm penetration into brickwork. Anchors to be spread evenly across the width of	Unless noted otherwise, all existing steelwork,
	masonry pier (as indicated by the arrow on plan),and positioned as follows:min. 150mm away from any masonry edge	concrete and timber structures shown on this drawing are non-historic elements installed during the recent construction works.
	 min. 50mm away from any edge of timber spaced min. 75mm apart in a staggered pattern 	All historic timber, steel, and concrete members are marked with (H).
	Note 0.3 Provide fixings between studwork walls and external	Unless noted otherwise, all masonry structures are assumed to be historic. All existing member sizes marked with (*) are based on
	masonry walls (the purpose is to ensure the two walls provide lateral restraint to each other):1. Ensure the last stud is placed directly against the	previous engineer's drawings and have not been verified on site. All other existing member sizes are based on on own site measurements.
	 Ended of the lact of a phased directly against the inside face of brickwork. Fix the stud to the brick wall with M8 Hilti HAS-U rods and HIT-HY-170 injection mortar, at 600mm 	
	max vertical c/c. Anchors to be centred on the stud and penetrate 80-120mm into masonry.	
	Note 0.4 Remove recently installed joist bearing on/spanning just above the top of brickwork wall, and remove the ground floor studwork partition above. Construct new load bearing studwork wall along the hallway:	
	 Ensure top of masonry wall is a level, flat surface. Replace any broken or missing bricks, and apply a layer of grout over the whole top surface of the 	
	wall. 2. Fix new wall plate to the top of brick wall with M8 Hilti HAS-U rods and HIT-HY-170 injection mortar,	
	at 600mm max c/c along the wall. Anchors to be positioned as close to the centreline of the wall as possible and penetrate min. 150mm into masonry. 3. Also provide vertical steel restraint straps at	
g	900mm max c/c, extending min. 750mm down the wall and bent over the top of the wall plate. Fix to wall using plug-and screw fixings and to timber	
	using wood screws. 4. Secure joists to wall plate using proprietary steel angle brackets or truss clips (Expamet or similar) and install full depth timber blocking between joist	
to be	ends, along their bearing on the wall plate. 5. Construct new studwork wall above.	
ax along –	Note 0.5 Install new wall plate and secure joist ends where they currently bear directly on brickwork:	
	 Remove a single course of bricks under the joists if necesssary to fit a new wall plate in. 	
ar) side	 Ensure top of masonry wall is a level, flat surface. Replce any broken or missing bricks, and apply a layer of grout over the whole top surface of the wall. 	
nin.	 Fix new wall plate to the top of brick wall with M8 Hilti HAS-U rods and HIT-HY-170 injection mortar, at 600mm max c/c along the wall. Anchors to be 	
	positioned min. 75mm away from edge of masonry and penetrate min. 150mm into masonry. 4. Also provide vertical steel restraint straps at 900mm max c/c, extending min. 750mm down the	
t	wall and bent over the top of the wall plate. Fix to wall using plug-and screw fixings and to timber using wood screws.	
oove	 Secure joists to wall plate using proprietary steel angle brackets or truss clips (Expamet or similar) and install full depth timber blocking between joist ends, along their bearing on the wall plate. 	
n the below	enus, along their bearing on the wall plate.	
all -		
at		
ated		A Revised as clouded, issued for submission to the Council 03/12/24 BK - Issued for comments/coordination 28/11/24 BK
er)		Rev Description Date By
		<u>studio strukt</u>
		studiostrukt.co.uk 078 508 75 271 bart@studiostrukt.co.uk
		PRELIMINARY
		Scale Date By Checked 1:50 @ A1 15/11/2024 BK Initial contraction
ined		Project 9 The Mount
ed on e er to		London NW3 6SZ
		Title Proposed structural works: Ground Floor Plan
		Drawing No. Rev. 24-034/22 A

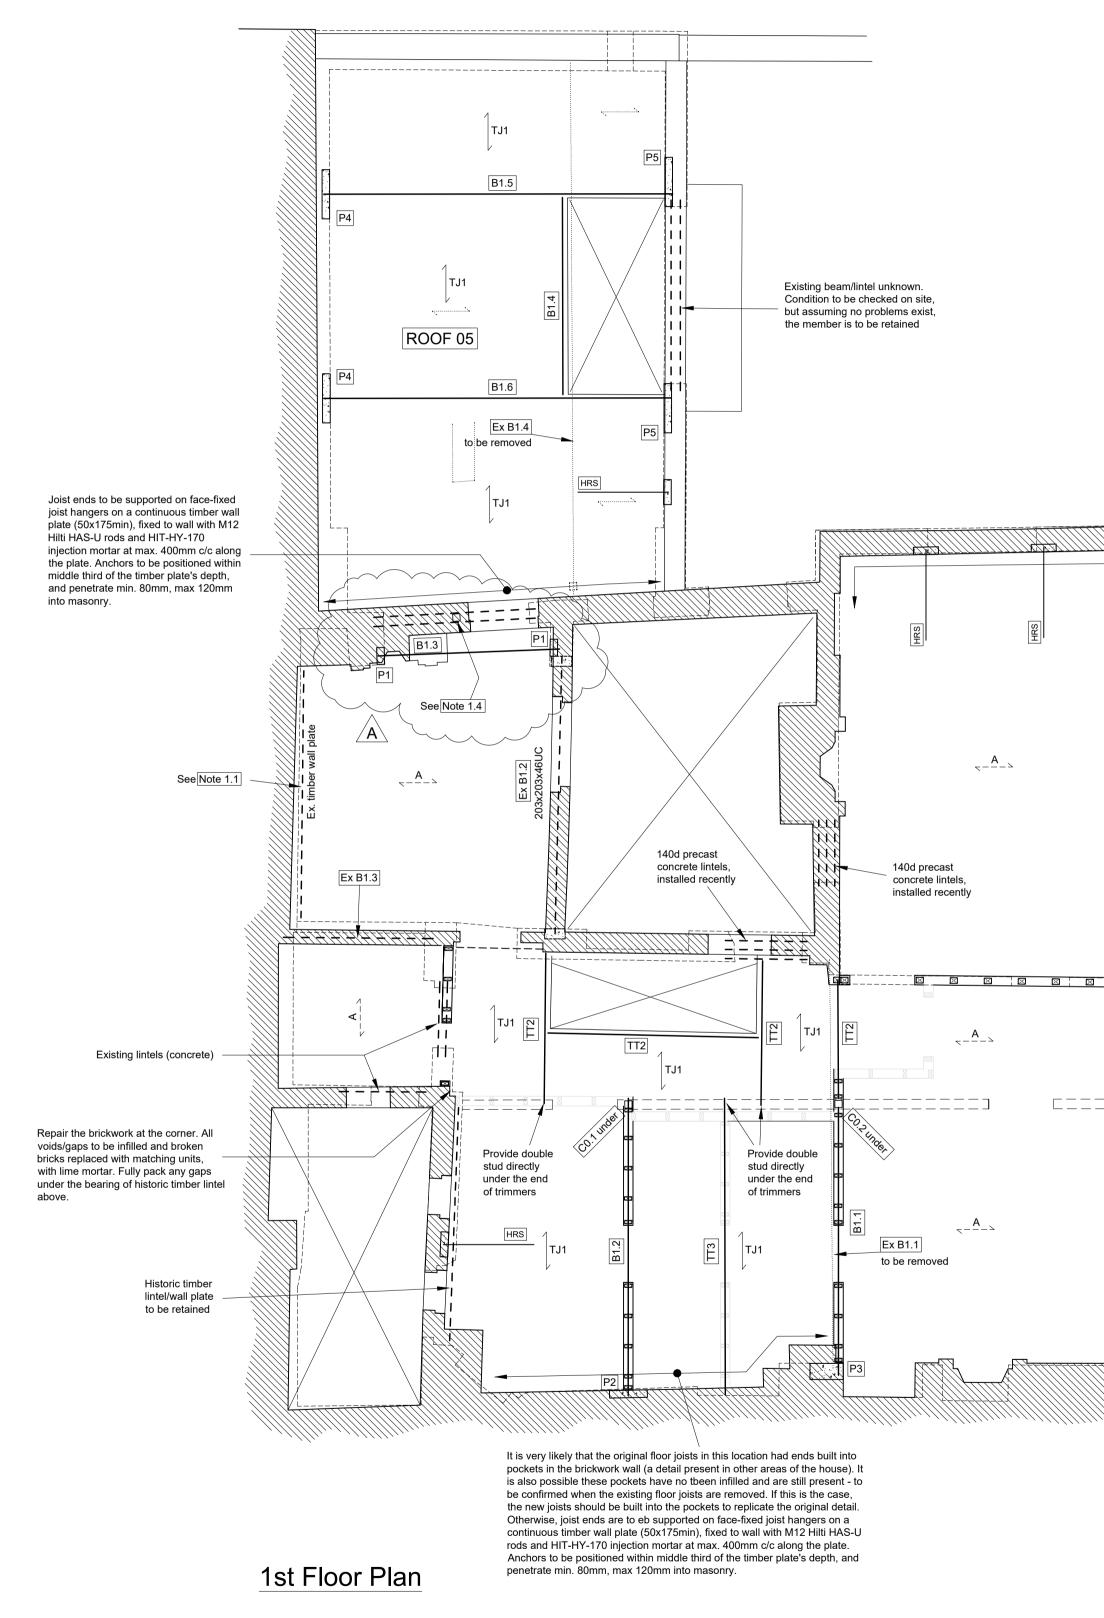


Drawir	ng key:	Repair/strengtheing specification:	GENERAL NOTES: 1. All Studio Strukt drawings are to be read in
Timber:		Note 1.1 Strengthen connection between wall plate and brickwork	conjunction with the relevant Architect's, Engineer's and Specialist Supplier's drawings and specifications.
	j joist and rafter types listed below are modern, uring recent works:	 behind, remediate poorly installed joist hangers : Install additional resin anchors between the 	 Do not scale from any Studio Strukt drawings. Use stated dimensions only. All dimensions to be verified on site by contractor.
∠_ <u>A</u> _>	Existing 175x75 C24 joists at 400-430mm c/c	existing, to ensure max 400mm spacing between anchors along the wall plate: M12 Hilti HAS-U rods and HIT-HY-170 injection mortar. Anchors to be positioned within middle third of the timber plate's	 Fire protection, thermal and sound insulation, and waterproofing are outside of Studio Strukt's scope. Any such elements are shown indicatively only.
~- <u>B</u> ->	Existing 150x75 C24 joists at 400-430mm c/c	depth, and penetrate min. 80mm, max 120mm into masonry. 2. Replace all existing joist hangers along the wall	 The Contractor is responsible for ensuring the stability of all structures within and adjacent to the site
~_ <mark>_</mark> _>	Existing 100x75 C24 joists at 400mm c/c	plate with face-fixed hangers (Expamet Maxi-speedy or similar).	at all times during the contract, and is to design and provide all temporary works required.
Proposed	timber structures:	Note 1.2 Provide fixings between studwork walls and external	 All work subject to Building Control approval, Party Wall agreement, and Listed Building consent. Formation levels of all foundations to be approved on
TT1	Existing trimmer (single joist) to be strengthened: Add another joist of the same section size on the side of the existing, fix together with:	masonry walls (the purpose is to ensure the two walls provide lateral restraint to each other):	site by Building Control inspector. 6. All Studio Strukt plans are drawn 'looking down' and
	 M8 bolts at 400mm c/c for joists less than 125mm deep M12 bolts at 400mm c/c for joists deeper than 	 Ensure the last stud is placed directly against the inside face of brickwork. Fix the stud to the brick wall with M8 Hilti HAS-U 	show structure within and immediately below the floor/level the plan refers to. For example, a 1st floor plan shows 1st floor joists, beams within and under
	125mm The added joist to be of the same length as existing, to share the bearing/end fixing. Where existing joist is	rods and HIT-HY-170 injection mortar, at 600mm max vertical c/c. Anchors to be centred on the stud and penetrate 80-120mm into masonry.	1st floor, and lintels above openings at ground floor level.
	supported on a joist hanger, a new (double-width) hanger will be required.	Note 1.3 Timber plates buried in external walls are in poor condition	Unless noted otherwise, all existing steelwork,
TT2	2No. 175x63 C24 joists bolted together with M12 bolts at 400mm c/c max.	due to historic or continued water ingress, affecting integrity of the walls, and providing inadequate bearing for joists.	concrete and timber structures shown on this drawing are non-historic elements installed during the recent construction works.
TT3	3No. 175x75 C24 joists bolted together with M12 bolts at 400mm c/c max.	Remove all timber plates embedded in external walls and infill the gaps with brickwork:	All historic timber, steel, and concrete members are marked with (H).
TJ1 TJ2	175x63 C24 joists (min. size) at 400mm c/c 150x50 C24 joists (min. size) at 400mm c/c	 Existing timber plates (supporting the joist ends and higher within the walls, whether historic or installed recently), are to be carefully cut out, in segments no 	Unless noted otherwise, all masonry structures are assumed to be historic.
`		longer than 750mm at a time. Joists bearing on the segment being worked on to be temporarily supported.Infill the void with bricks to match existing, with lime	All existing member sizes marked with (*) are based on previous engineer's drawings and have not been
Walls:		mortar joints - mortar to be packed in tightly to ensure good bond with existing masonry	verified on site. All other existing member sizes are based on on own site measurements.
	New brickwork - all brickwork infills to be fully toothed and bonded with existing brickwork	Note 1.4 Recently installed SHS post head connection does not	
	Existing masonry	provide sufficient bearing for the supported historic steel beams. Beams significantly overhang the SHS profile and capping plate.	
	Existing non-load-bearing walls (historic or recently installed, as noted)	 Site weld vertical stiffeners (ribs) between the sides of the SHS and underside of supported beams. Assume 	
	Non-load-bearing timber studwork walls installed during recent works	 150mm high plates, extending to the outer edges of both existing beams. NOTE: Full details will be provided by Studio Strukt for 	
X X	Existing (recently installed) load-bearing timber studwork wall, comprising 95x70 C24 studs at 450mm c/c approx; to be retained	construction.	
0 0	Existing (recently installed) load-bearing timber studwork wall, comprising 42x95 C24		
	studs at 400mm c/c approx; to be retained New load-bearing timber studwork wall, comprising 50x100 C24 studs at 400mm c/c		
	max, and 100x50 bottom and top plates. Double studs to be used at all wall corners and ends. Solid timber noggins to be installed		
	between all studs, at 900mm vertical c/c max.		
Existing	structures:		
Ex B1.1	to be removed 203x203x46UC		
Ex B1.3	(H) Existing steel beam - 150 deep approx		
Ex B1.4	to be removed		
Lintels:			
L1	100d x 100w precast lintels (Naylor S4 or similar) side by side - number to suit wall thickness, 2No. min.		
Steelwoi	rk:		
B1.1	152x152x37UC		
B1.2	152x152x37UC		
B1.3	152x152x23UC 152x152x23UC		
B1.5	152x152x37UC		
B1.6	152x152x37UC		
Padston	ES: tones to be cast in-situ or precast units of the stated		
dimensio L = leng	th along the wall th - penetration into wall		
	ht (down the wall from underside of steel member) Existing padstones, to be retained		
P1	225L x 100W x 150H		
P2 P3	500L x 100W x 300H 440L x 215W x 300H		
P4	650L x 100W x 300H		A Revised as clouded, issued for submission to the Council 03/12/24 BK - Issued for comments/coordination 28/11/24 BK
P5 P6	650L x 100W x 450H 330L x 100W x 225H		Rev Description Date By
Other / g			studio strukt
	Existing foundation under / structure under		
	Existing beams, trimmers, or lintels, to be retained retained - material/function and details as noted on plans. For further details (including whether the		studiostrukt.co.uk 078 508 75 271 bart@studiostrukt.co.uk
	members are historic or installed recently) refer to drawings series 11-15		PRELIMINARY
	Proposed beams, trimmers, or lintels Structure to be demolished		Not for construction
	Restraint strap to the external well to fleere where this to		Scale Date By Checked 1:50 @ A1 15/11/2024 BK Project
HRS	Restraint strap to tie external wall to floors where joists run parallel to wall. 1.2m long 'heavy duty' proprietary galvanised steel		Project 9 The Mount
	1.2m long 'heavy duty' proprietary galvanised steel restraint strap (4mm thick, 28mm wide) fixed across 3No. joists with noggins in between. Can be fixed to top or the underside of joists, and joists can be noteched locally).		London NW3 6SZ
	End of strap to be bent and cast into a type P6 padstone, cast in-situ into a pocket cut on the inside of the wall.		Title Proposed structural works:
			1st Floor Plan
			Drawing No.
			24-034/23 A

		7
())	/////	
$\overline{)}\overline{)}$	<u>111</u> []	
		1
	1	4
		(H) existing concrete lintel
		under, to be retained
	1	
		See Note 1.3
(
		(H) existing concrete lintel
		under, to be retained
		1
		See Note 1.2
	- <u>P</u>	
	1-2	
	l II l	(H) existing concrete lintel
	I	under, to be retained
	- !	
T		
		(H) existing
		concrete lintel
		under, to be
1		
		retained

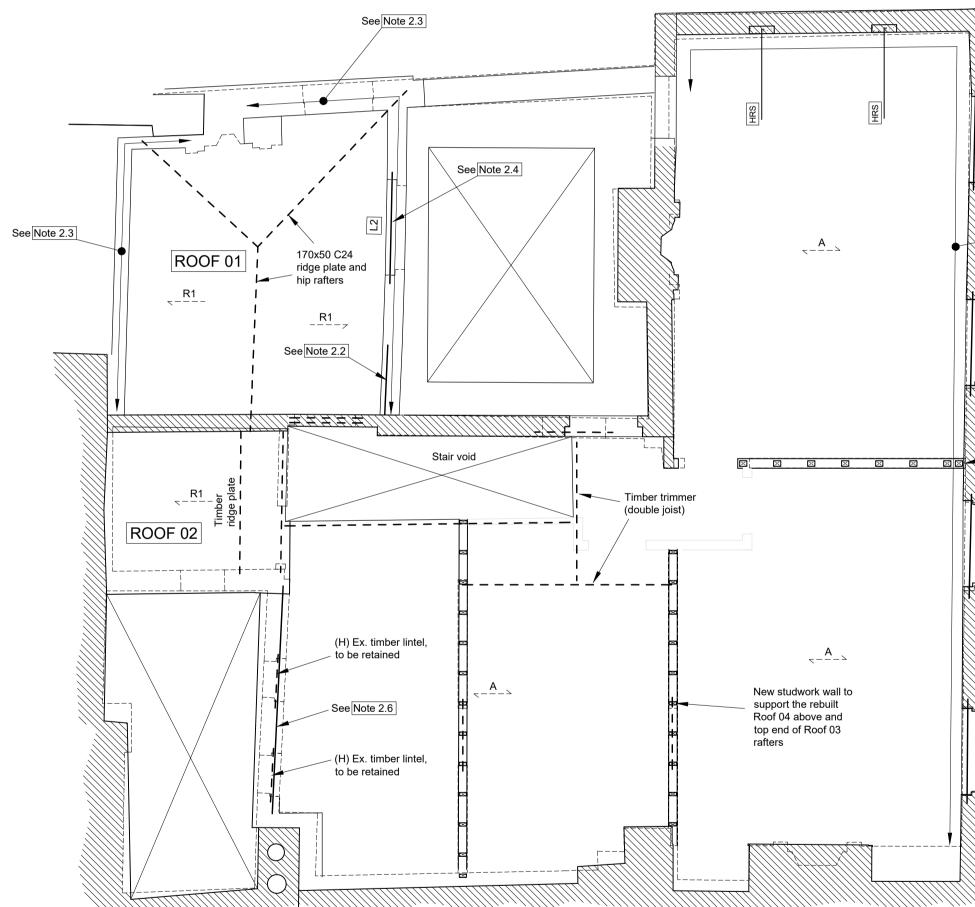


2nd Floor Plan

Drawing key: Timber: All existing joist and rafter types listed below are modern, installed during recent works: A_{---} Existing 175x75 C24 joists at 400-430mm c/c $-B_{--}$ Existing 150x75 C24 joists at 400-430mm c/c $c_{-}C_{-}$ Existing 100x75 C24 joists at 400mm c/c $_{-}$ = $\frac{R1}{--}$ 95x70 C24 rafters at 400mm c/c $-\frac{R^2}{2}$ 70w C24 rafters at 400mm c/c Walls: New brickwork - all brickwork infills to be fully toothed and bonded with existing brickwork Existing masonry Existing non-load-bearing walls (historic or recently installed, as noted) Non-load-bearing timber studwork walls installed during recent works Existing (recently installed) load-bearing timber studwork wall, comprising 95x70 C24 studs at 450mm c/c approx; to be retained Existing (recently installed) load-bearing timber studwork wall, comprising 42x95 C24 studs at 400mm c/c approx; to be retained New load-bearing timber studwork wall, comprising 50x100 C24 studs at 400mm c/c max, and 100x50 bottom and top plates. Double studs to be used at all wall corners and ends. Solid timber noggins to be installed between all studs, at 900mm vertical c/c max. Padstones: All padstones to be cast in-situ or precast units of the state dimensions (all in mm). L = length along the wall W = width - penetration into wall H = height (down the wall from underside of steel member) Existing padstones, to be retained P1 225L x 100W x 150H P2 500L x 100W x 300H P3 440L x 215W x 300H P4 650L x 100W x 300H P5 650L x 100W x 450H P6 330L x 100W x 225H Lintels: L1 100d x 100w precast lintels (Naylor S4 or similar) by side - number to suit wall thickness, 2No. min. L2 100d x 100w precast lintel (Naylor S4 or similar) the inner half of the existing wall's thickness, to re existing timber lintel/wall plate. Existing brick arch retained on the outer part of the wal NOTE: condition of the existing arch to be inspec site - since significant movement has historically occurred in the external walls, the arches may be dislocated and damaged and require repairs. Other / general: ----- Existing foundation under / structure under — — — — Existing beams, trimmers, or lintels, to be retained retained - material/function and details as noted o plans. For further details (including whether the members are historic or installed recently) refer to drawings series 11-15 _____ Proposed beams, trimmers, or lintels Structure to be demolished HRS ____ Restraint strap to tie external wall to floors where run parallel to wall. 1.2m long 'heavy duty' proprietary galvanised stee restraint strap (4mm thick, 28mm wide) fixed acro joists with noggins in between. Can be fixed to to underside of joists, and joists can be noteched lo End of strap to be bent and cast into a type P6 pa cast in-situ into a pocket cut on the inside of the

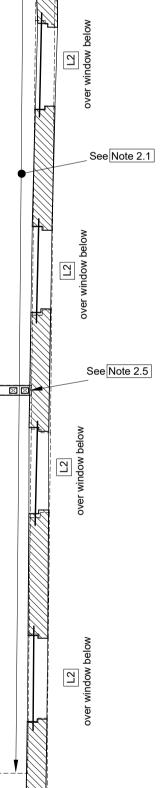

	Repa	ir/strengtheing specification:	GE 1.	NERAL NOTES: All Studio Strukt drawings are to be read in conjunction with the relevant Architect's, Engineer's and Specialist Supplier's drawings and specifications.
	Note 2.1	Timber plates buried in external walls are in poor condition due to historic or continued water ingress, affecting integrity	2.	Do not scale from any Studio Strukt drawings. Use
		of the walls, and providing inadequate bearing for joists. Remove all timber plates embedded in external walls and infill		stated dimensions only. All dimensions to be verified on site by contractor.
		 Existing timber plates (supporting the joist ends and higher within the walls, whether historic or installed 	3.	Fire protection, thermal and sound insulation, and waterproofing are outside of Studio Strukt's scope. Any such elements are shown indicatively only.
		recently), are to be carefully cut out, in segments no longer than 750mm at a time. Joists bearing on the segment being worked on to be temporarily supported.	4.	stability of all structures within and adjacent to the site at all times during the contract, and is to design and
		 Infill the void with bricks to match existing, with lime mortar joints - mortar to be packed in tightly to ensure good bond with existing masonry 	5.	Wall agreement, and Listed Building consent. Formation levels of all foundations to be approved on
	Note 2.2	Approx. 750mm of existing timber wall plate to be replaced with new C24 timber wall plate of matching dimensions.	6.	site by Building Control inspector. All Studio Strukt plans are drawn 'looking down' and show structure within and immediately below the
		 Fix new wall plate to the top of brick wall with M8 Hilti HAS-U rods and HIT-HY-170 injection mortar, at 600mm max c/c. Anchors to be positioned as close to the centreline of the wall as possible and penetrate min. 150mm into masonry. 		floor/level the plan refers to. For example, a 1st floor plan shows 1st floor joists, beams within and under 1st floor, and lintels above openings at ground floor level.
		 Also provide 2No. vertical steel restraint straps, placed max 150mm from ends of the new segment, extending min. 750mm down the wall and bent over the top of the wall plate. Fix to wall using plug-and screw fixings and to timber using wood screws. This is similar to the 		Unless noted otherwise, all existing steelwork, concrete and timber structures shown on this drawing are non-historic elements installed during the recent
		existing wall plate fixings. 3. Connect the new segment with existing wall plate with nail plates		construction works. All historic timber, steel, and concrete members are marked with (H). Unless noted otherwise, all masonry structures are
	Note 2.3	Strengthening to connections between recently installed roof rafters and historic wall plate:		assumed to be historic. All existing member sizes marked with (*) are based on
		 Install proprietary steel brackets or truss clips (Expamet or similar) between each rafter and the wall plate (the existing connection is inadequate with no birds-mouth and the rafters fixed with only a couple of screws each through the top of rafter). Ensure that each of the existing steel restraint straps 		previous engineer's drawings and have not been verified on site. All other existing member sizes are based on on own site measurements.
		has positive fixings into the existing wall plate. Add nails or wood screws where missing.		
ed	Note 2.4	New lintel L2 to be installed directly above the existing window head, and gap between top of lintel and underside of existing timber wall plate to be infilled with brickwork (to match existing), replacing the current studwork infill.		
·)	Note 2.5	Provide fixings between studwork walls and external masonry walls (the purpose is to ensure the two walls		
		 provide lateral restraint to each other): 1. Ensure the last stud is placed directly against the 		
		 inside face of brickwork. Fix the stud to the brick wall with M8 Hilti HAS-U rods and HIT-HY-170 injection mortar, at 600mm max vertical c/c. Anchors to be centred on the stud and penetrate 80-120mm into masonry. 		
	Note 2.6	Install new wall plate and secure joist ends where they currently bear on very poor condition brickwork or loose and badly damaged remains of historic wall plate:		
		 Remove a single course of bricks under the joists if necesssary to fit a new wall plate in. Ensure top of masonry wall is a level, flat surface. 		
r) side		 Replace any broken or missing bricks, and apply a layer of grout over the whole top surface of the wall. Fix new wall plate to the top of brick wall with M8 Hilti HAS-U rods and HIT-HY-170 injection mortar, at 		
n.) within replace		600mm max c/c along the wall. Anchors to be positioned min. 75mm away from edge of masonry and penetrate min. 150mm into masonry. Where the wall plate bears directly on top of existing lintels, fix with wood screws		
ch to be ected on /		through the top surface.Also provide vertical steel restraint straps at 900mm max c/c, extending min. 750mm down the wall and bent		
		 over the top of the wall plate. Fix to wall using plug-and screw fixings and to timber using wood screws. 5. Secure joists to wall plate using proprietary steel angle brackets or truss clips (Expamet or similar) and install full depth timber blocking between joist ends, along their bearing on the wall plate. 		
ed				
on to				
e joists eel				
ross 3No. op or the ocally).				
oadstone, wall.				
			А	Revised as clouded, issued for submission to 03/12/24 BK the Council
			- Rev	Issued for comments/coordination 28/11/24 BK Description Date By
				studio strukt
			078	diostrukt.co.uk 3 508 75 271 t@studiostrukt.co.uk
				PRELIMINARY
			Scale	Not for construction e Date By Checked 50 @ A1 15/11/2024 BK
			Proje C	
				Proposed structural works: 2nd Floor Plan
				ving No. Rev. 24-034/24 A

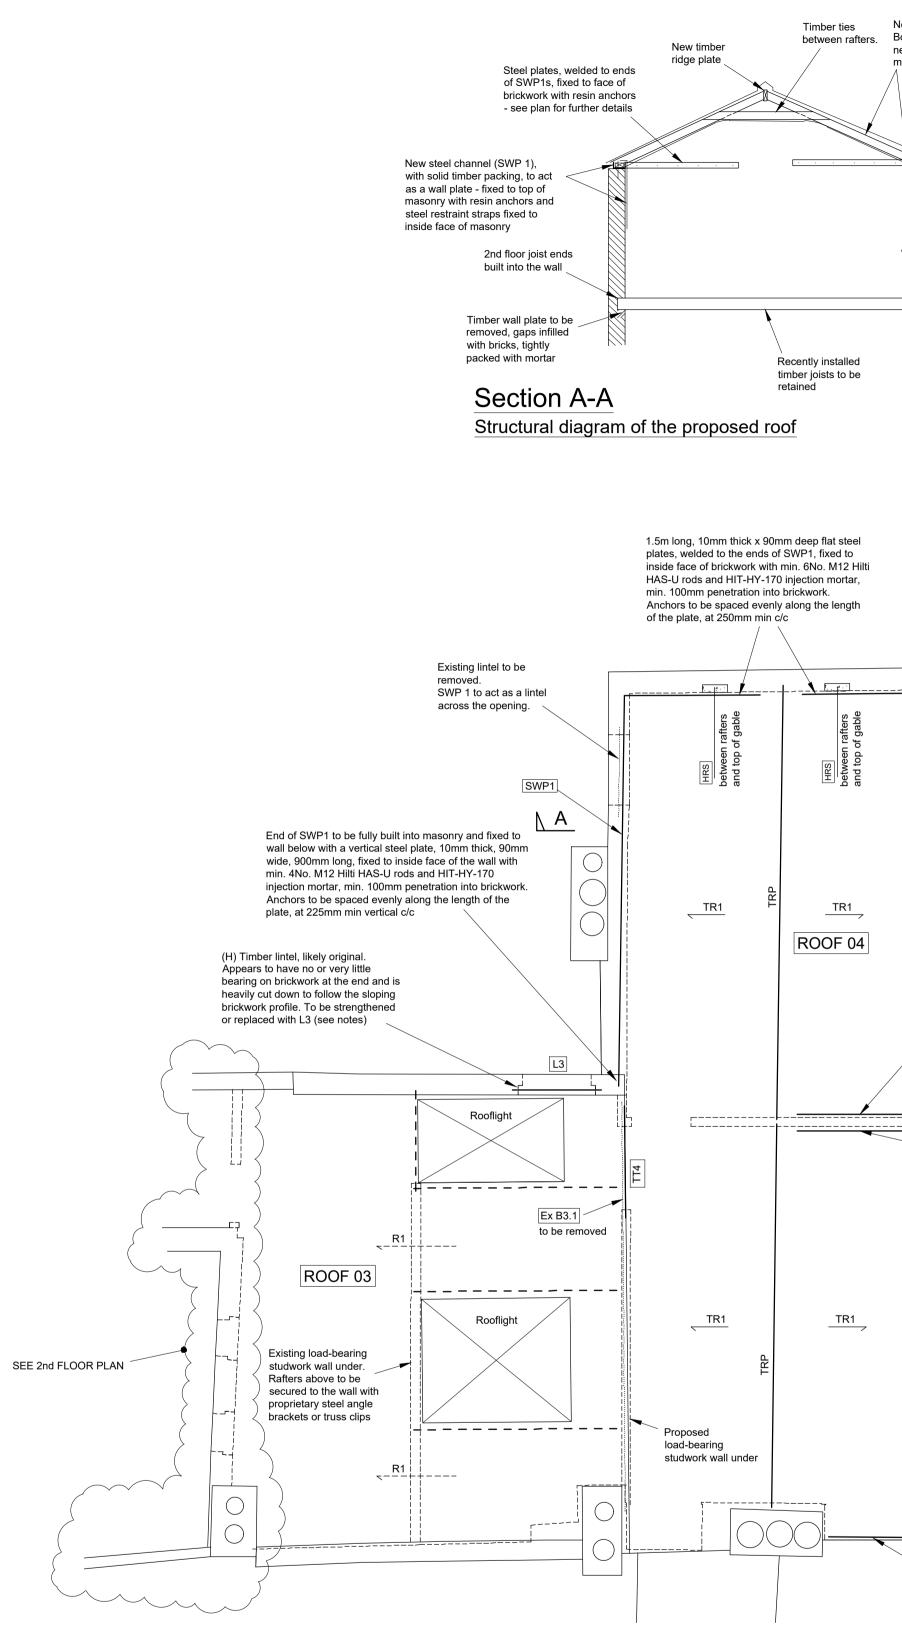

Roof Plan

	Drawing key:	Repair/strengtheing specification:	GENERAL NOTES: 1. All Studio Strukt drawings are to be read in
	Timber: All existing joist and rafter types listed below are modern,	Note 2.1 Timber plates buried in external walls are in poor condition due to historic or continued water ingress, affecting integrity of the walls, and providing inadequate bearing for joists.	 conjunction with the relevant Architect's, Engineer's and Specialist Supplier's drawings and specifications. 2. Do not scale from any Studio Strukt drawings. Use stated dimensions only. All dimensions to be verified
	installed during recent works:	Remove all timber plates embedded in external walls and infill the gaps with brickwork:	on site by contractor. 3. Fire protection, thermal and sound insulation, and
New timber rafters. Bottom ends to be fixed to	$\sim -\frac{A}{2} \sim$ Existing 175x75 C24 joists at 400-430mm c/c	 Existing timber plates (supporting the joist ends and higher within the walls, whether historic or installed 	waterproofing are outside of Studio Strukt's scope. Any such elements are shown indicatively only.
new wall plate with a birds mouth detail. \bigwedge	$ \sum_{n=1}^{n} = \sum_{n=1}^{n} Existing 150x75 C24 joists at 400-430mm c/c$	recently), are to be carefully cut out, in segments no longer than 750mm at a time. Joists bearing on the segment being worked on to be temporarily supported.	 The Contractor is responsible for ensuring the stability of all structures within and adjacent to the site at all times during the contract, and is to design and
New steel channel (SWP 1) - spans across openings	$\sim -\frac{C}{2} \sim$ Existing 100x75 C24 joists at 400mm c/c	 Infill the void with bricks to match existing, with lime mortar joints - mortar to be packed in tightly to ensure good bond with existing masonry 	 All work subject to Building Control approval, Party
	$-\frac{R1}{}$ 95x70 C24 rafters at 400mm c/c	good bond with existing masonry	Wall agreement, and Listed Building consent. Formation levels of all foundations to be approved on
Wall to be brought back to original level, recently installed precast lintels to be	$\sim -\frac{R2}{}$ 70w C24 rafters at 400mm c/c		site by Building Control inspector.6. All Studio Strukt plans are drawn 'looking down' and
removed. New steel wall plate level to match the original wall plate.	TRP 150x50 C24 ridge plate		show structure within and immediately below the floor/level the plan refers to. For example, a 1st floor plan shows 1st floor joists, beams within and under
Defective timber wall plate to	TR1125x50 C24 rafters at 400mm c/cTT42No. 150x50 C24 joists bolted together with M12 bolts		1st floor, and lintels above openings at ground floor level.
be replaced with precast lintels over the openings	at 400mm c/c max.		
	Steel:		Unless noted otherwise, all existing steelwork, concrete and timber structures shown on this drawing are non-historic elements installed during the recent
	SWP1 150x90x24 PFC (galvanised) laid 'on its back', acting as a wall plate to support roof rafters, preventing		Construction works. All historic timber, steel, and concrete members are
	spread of the timber roof A-frames, and tying the poor condition brickwork together. PFC fixed to top of masonry wall with M8 Hilti	B	marked with (H). Unless noted otherwise, all masonry structures are
	HAS-U rods and HIT-HY-170 injection mortar, at 600mm max c/c. Anchors to be positioned as close to the centreline of the wall as possible and penetrate		assumed to be historic. All existing member sizes marked with (*) are based on
	min. 150mm into masonry. PFC must be a single, continuous element over the	Ś	previous engineer's drawings and have not been verified on site. All other existing member sizes are based on on own site measurements.
We understand that the whole of the recently installed	whole length of each room, between the end restraints as noted on plan.		
roof (formed with rafters R2) is to be dismantled since it does not follow the original ridge line. The raised	Walls:		
brickwork it is bearing on is to also be taken down to the original level, and a new roof is to be constructed, to match the original profile and structural diagram.	New brickwork - all brickwork infills to be fully		
The recently constructed roof (rafters R2) has no ties between the rafters - it applies horizontal 'spreading'	toothed and bonded with existing brickwork Existing masonry		
forces onto the brick walls. It is structurally inadequate and would need to be replaced or strengthened regardless of the above.	Existing non-load-bearing walls (historic or		
	recently installed, as noted) Non-load-bearing timber studwork walls		
	installed during recent works Image: Second state Image: Second state		
Existing lintel to be removed.	timber studwork wall, comprising 95x70 C24 studs at 450mm c/c approx; to be retained		
SWP 1 to act as a lintel across the opening.	Existing (recently installed) load-bearing timber studwork wall, comprising 42x95 C24 studs at 400mm c/c approx; to be retained		
	New load-bearing timber studwork wall,		
	comprising 50x100 C24 studs at 400mm c/c max, and 100x50 bottom and top plates. Double studs to be used at all wall corners		
SWP1	and ends. Solid timber noggins to be installed between all studs, at 900mm vertical c/c max.		
	Padstones:		
Existing lintel to be	All padstones to be cast in-situ or precast units of the stated dimensions (all in mm).		
SWP 1 to act as a lintel across the opening.	L = length along the wall W = width - penetration into wall H = height (down the wall from underside of steel member)		
1.5m long min, 10mm thick x 90mm deep flat steel plates, welded to the ends of SWP1, fixed	Existing padstones, to be retained		
to recently constructed studwork wall with min. 6No. M12 bolts spaced evenly along the plate. Solid timber noggins, min. 150mm deep, to be	P1 225L x 100W x 150H P2 500L x 100W x 300H		
installed between all studs along the steel plates.Bolts to be fixed through the studs or noggins.	P3 440L x 215W x 300H		
	P4 650L x 100W x 300H		
Existing lintel to be removed. SWP 1 to act as a lintel	P5 650L x 100W x 450H P6 330L x 100W x 225H		
across the opening.			
	Lintels:		
SWP1	L3 Pair of 100w x 65d x 8.0 galvanised steel angles (65mm leg pointing up) to be added under the existing timber lintel, and outer skin of masonry (assumed flat		
	arch) with min. 150mm bearing on the brickwork at each end.		
Existing lintel to be	Alternatively, the existing lintel is to be replaced with IG L9 lintel (58mm high), supporting the full thickness of the brickwork panel above.		
removed. SWP 1 to act as a lintel across the opening.	Other / general:		
	Other / general:		
	— — — Existing beams, trimmers, or lintels, to be retained retained - material/function and details as noted on		
	plans. For further details (including whether the members are historic or installed recently) refer to drawings series 11-15		B SWP1 note added 09/12/24 BK
	Proposed beams, trimmers, or lintels		A Revised as clouded, issued for submission to the Council 03/12/24 BK - Issued for comments/coordination 28/11/24 BK
1.25m long min, 10mm thick x 90mm deep flat steel plate, welded to the end of SWP1, fixed to	Structure to be demolished		Rev Description Date By
inside face of brickwork with min. 6No. M12 Hilti HAS-U rods and HIT-HY-170 injection mortar, min. 100mm penetration into brickwork.	HRS Restraint strap to tie external wall to floors where joists run parallel to wall.		studio strukt
Anchors to be spaced evenly along the length of the plate, at 200mm min c/c	1.2m long 'heavy duty' proprietary galvanised steel restraint strap (4mm thick, 28mm wide) fixed across 3No.		
	joists with noggins in between. Can be fixed to top or the underside of joists, and joists can be noteched locally).		studiostrukt.co.uk 078 508 75 271 bart@studiostrukt.co.uk
	End of strap to be bent and cast into a type P6 padstone, cast in-situ into a pocket cut on the inside of the wall.		
			PRELIMINARY Not for construction
			Scale Date By Checked 1:50 @ A1 15/11/2024 BK
			Project
			9 The Mount London NW3 6SZ
			Title
			Proposed structural works:
			Roof Plan
			Drawing No. Rev. 24-034/25 B