


SITE LOCATION PLAN

SCALE: 1:1250 0 50m



GENERAL NOTES:

KEY:

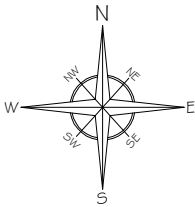

No	Revision / Issue	Date
-	-	-


Site :
2 Swan's Lane
London
N6 6QS

Project Title :
Section 73 minor alterations

Drawing :
Site Location Plan

Do not alter or amend the scale from this drawing. The information may be suitable for discussion purposes and for obtaining Planning Approval Only. This drawing is NOT for construction purposes and should not be relied upon for any other works. This drawing should not be copied or altered in any way except by way of written permission from the designers. Discrepancies may occur from onsite dimensions to this drawing issued. ABP Architectural Services will not be held liable for any discrepancies raised from this drawing and onsite dimensions.

Project Ref No : ABP-25LH-01	Sheet No : P-001
Date : December 2024	Drawn By : DS
Scale : 1:1250 @ A-3	

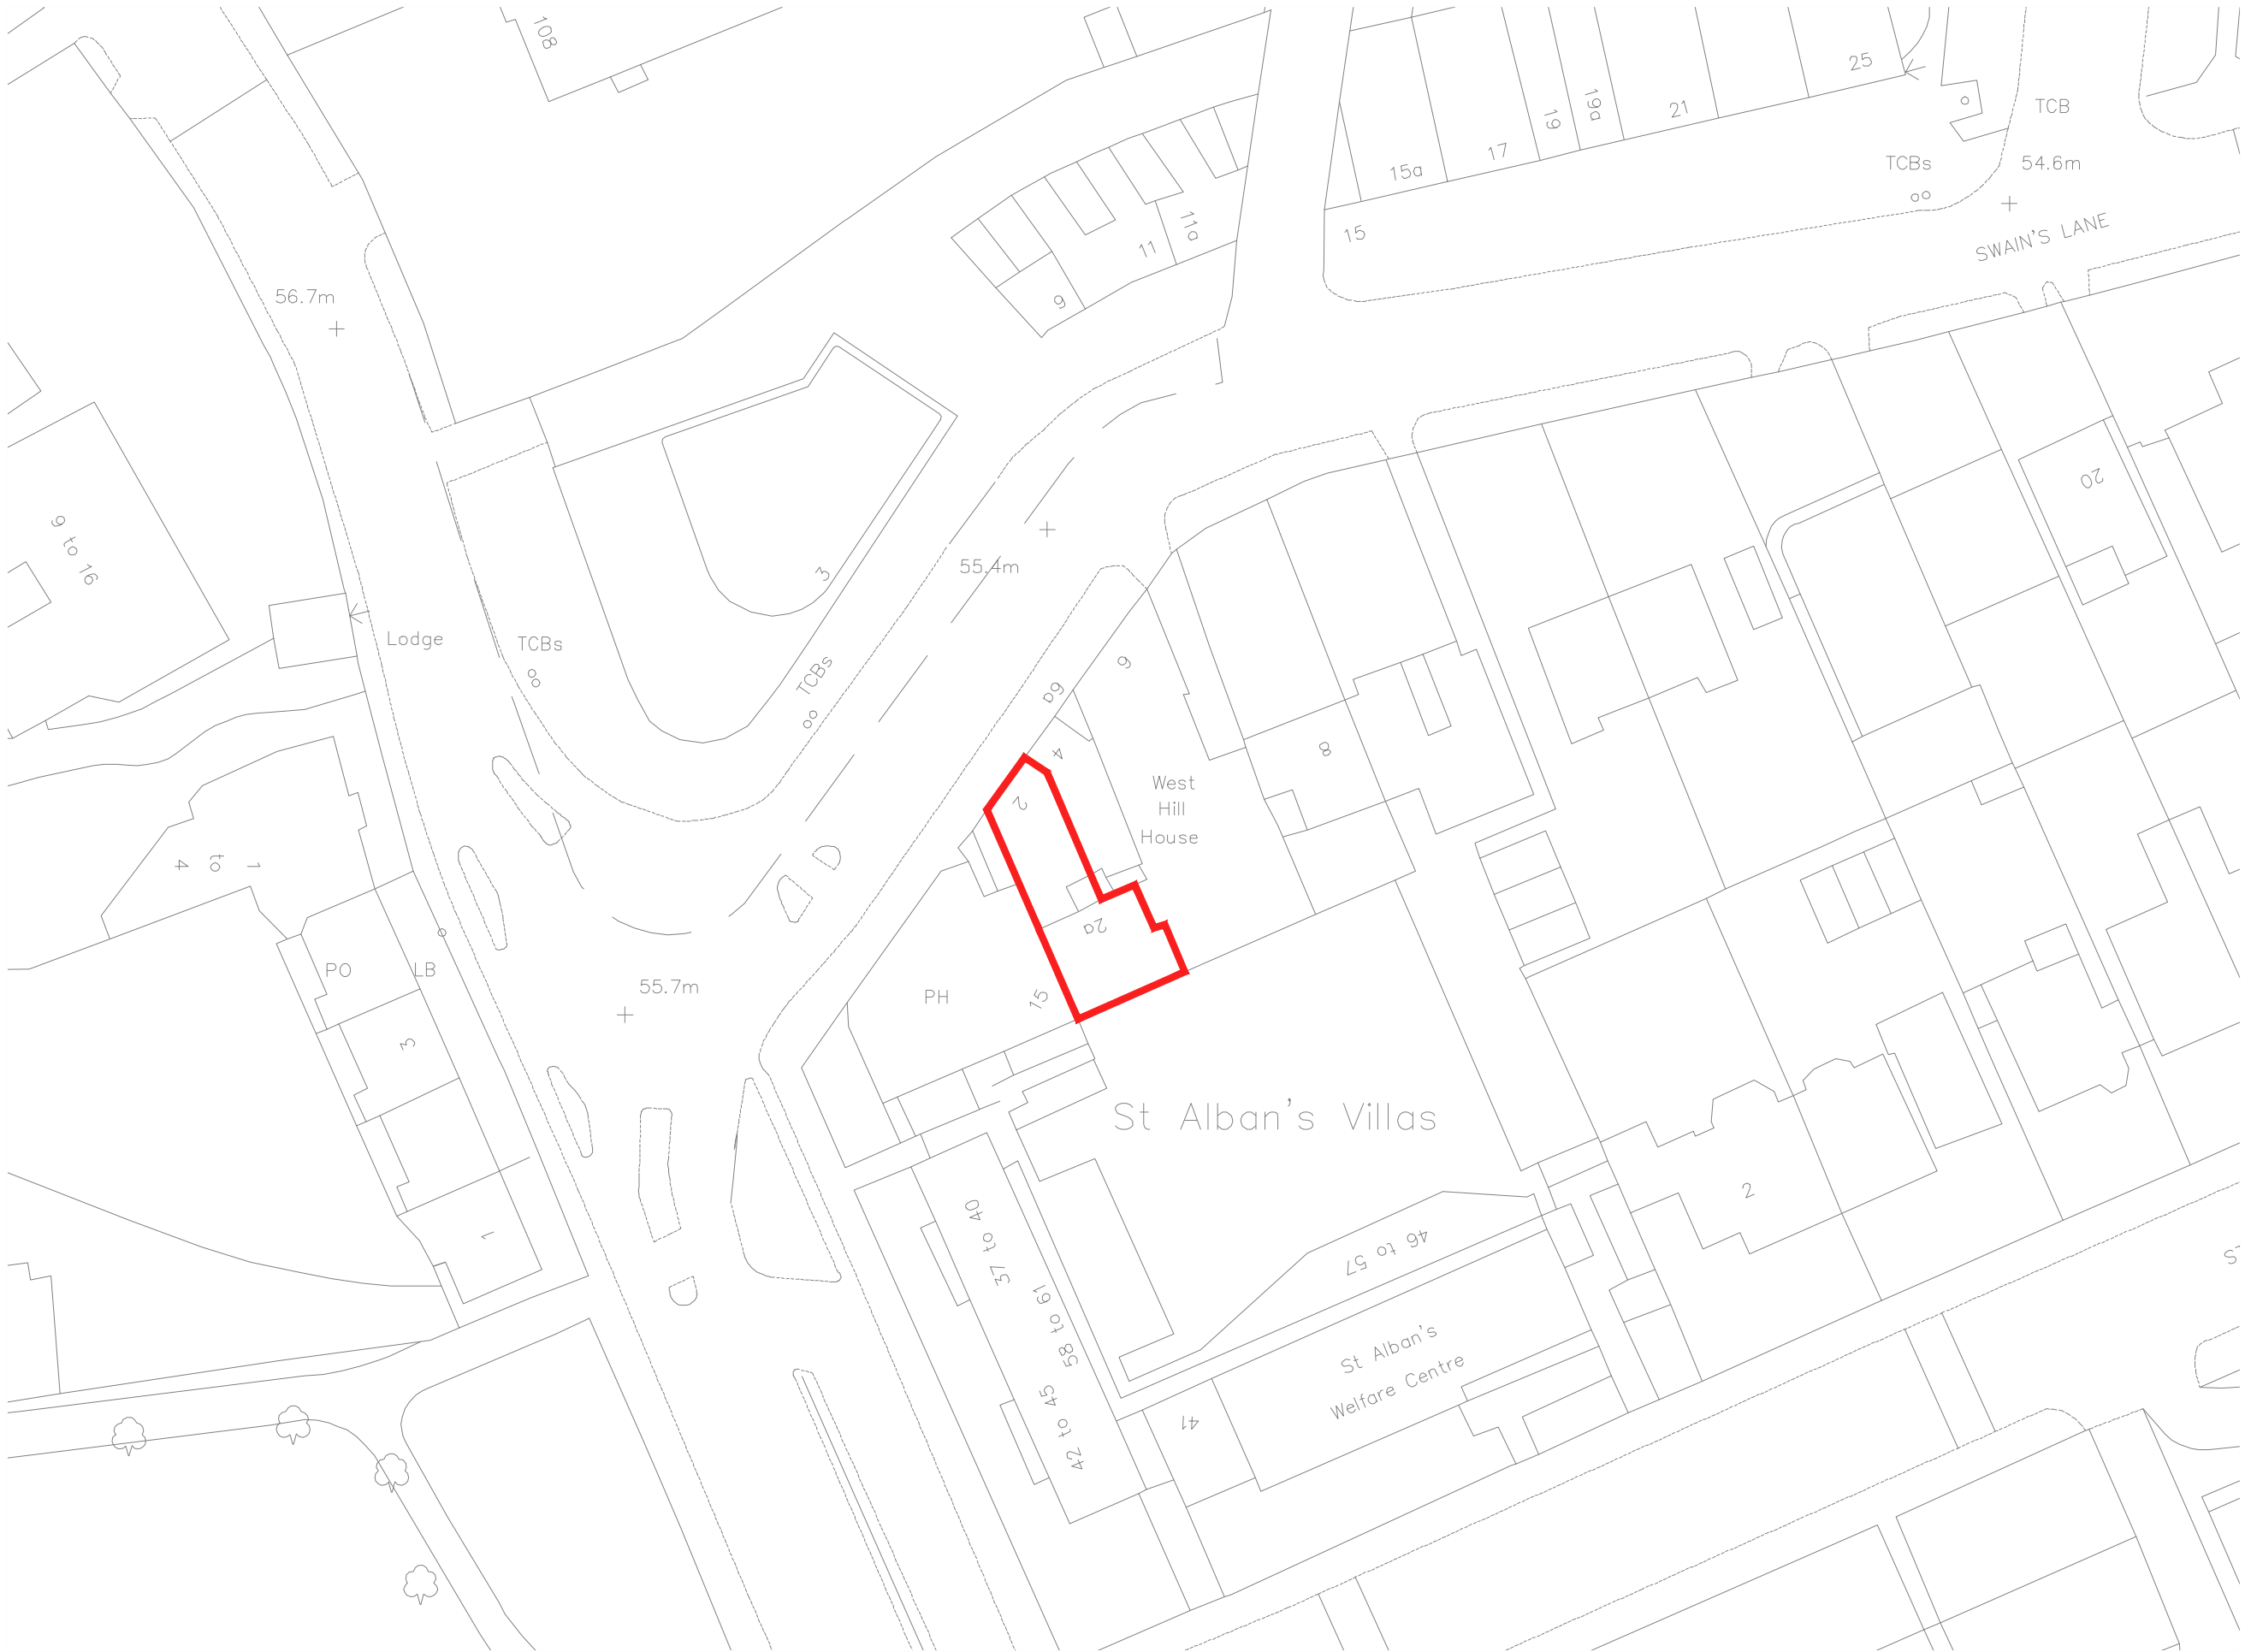


BLOCK PLAN
SCALE: 1:500



GENERAL NOTES:

KEY:

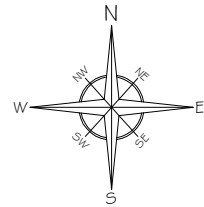

No	Revision / Issue	Date
-	-	-


Site :
2 Swan's Lane
London
N6 6QS

Project Title :
Section 73 minor alterations


Drawing :
Block Plan

Do not alter or amend the scale from this drawing. The information may be suitable for discussion purposes and for obtaining Planning Approval Only. This drawing is NOT for construction purposes and should not be relied upon for any other works. This drawing should not be copied or altered in any way except by way of written permission from the designers. Discrepancies may occur from onsite dimensions to this drawing issued. ABP Architectural Services will not be held liable for any discrepancies raised from this drawing and onsite dimensions.

Project Ref No : ABP-25LH-01	Sheet No : P-002
Date : December 2024	Drawn By : DS
Scale : 1:500 @ A-3	

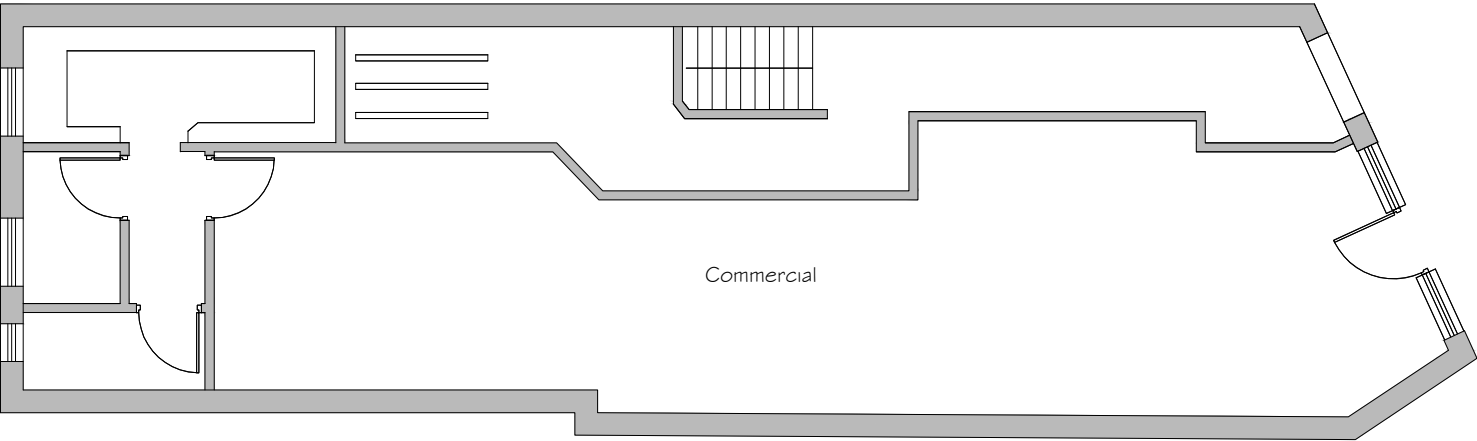

GROUND FLOOR PLAN

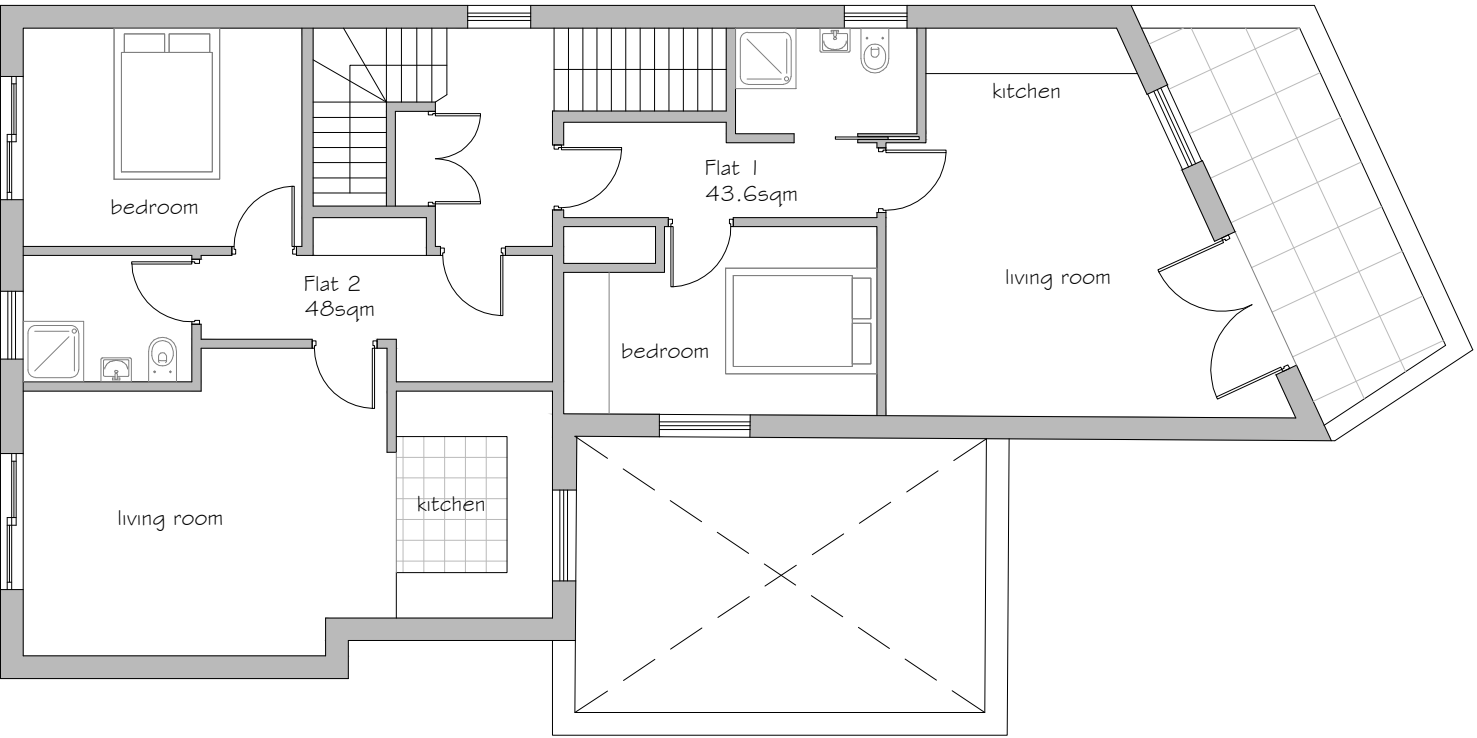


FIRST FLOOR PLAN

SCALE: 1:100 0 5m



GENERAL NOTES:

KEY:

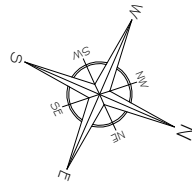

-	-	-
No	Revision / Issue	Date


Site :
2 Swan's Lane
London
N6 6QS

Project Title :
Section 73 minor alterations


Drawing :
As-Built
Ground & First Floor Plans

Do not alter or amend the scale from this drawing. The information may be suitable for discussion purposes and for obtaining Planning Approval Only. This drawing is NOT for construction purposes and should not be relied upon for any other works. This drawing should not be copied or altered in any way except by way of written permission from the designers. Discrepancies may occur from onsite dimensions to this drawing issued. ABP Architectural Services will not be held liable for any discrepancies raised from this drawing and onsite dimensions.

Project Ref No : ABP-25LH-01	Sheet No : P-100
Date : December 2024	Drawn By : DS
Scale : 1:100 @ A-3	

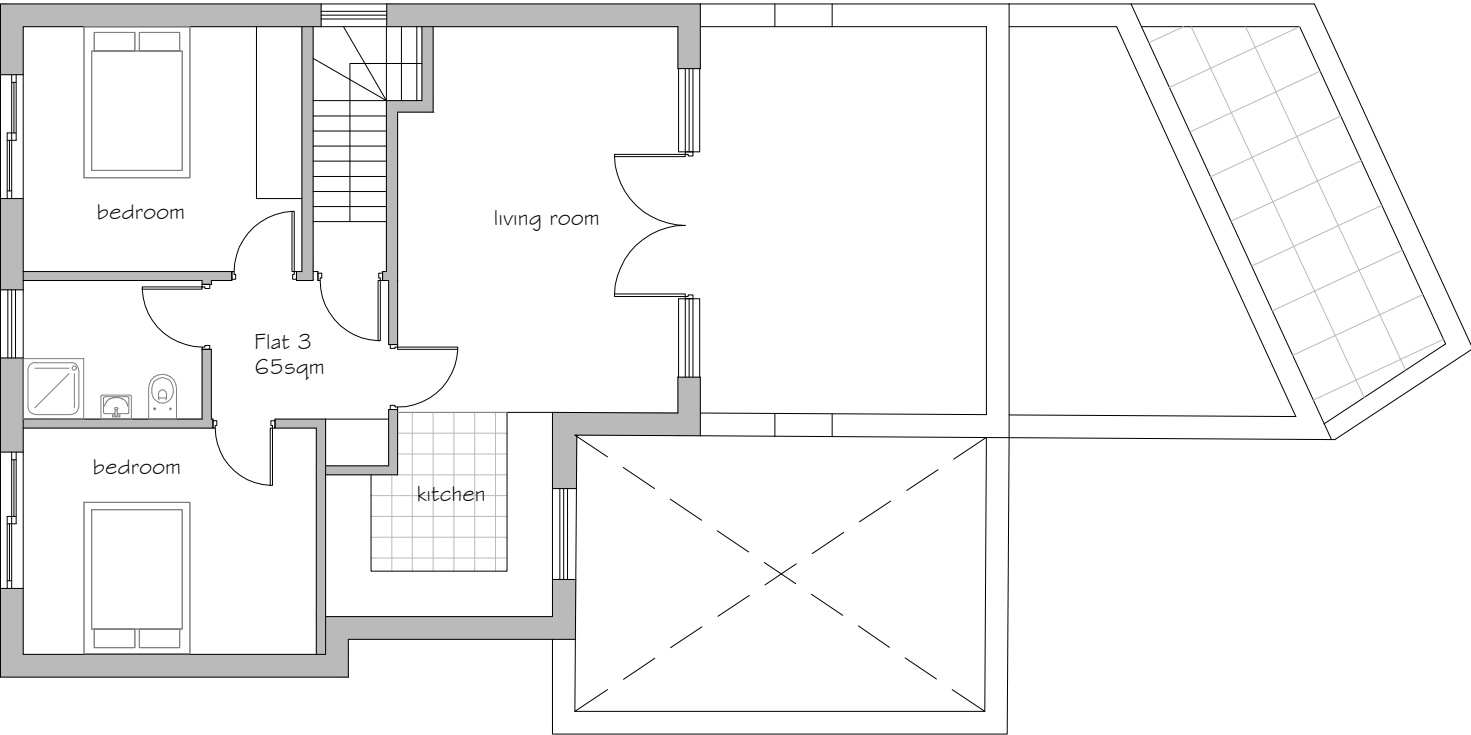

SECOND FLOOR PLAN

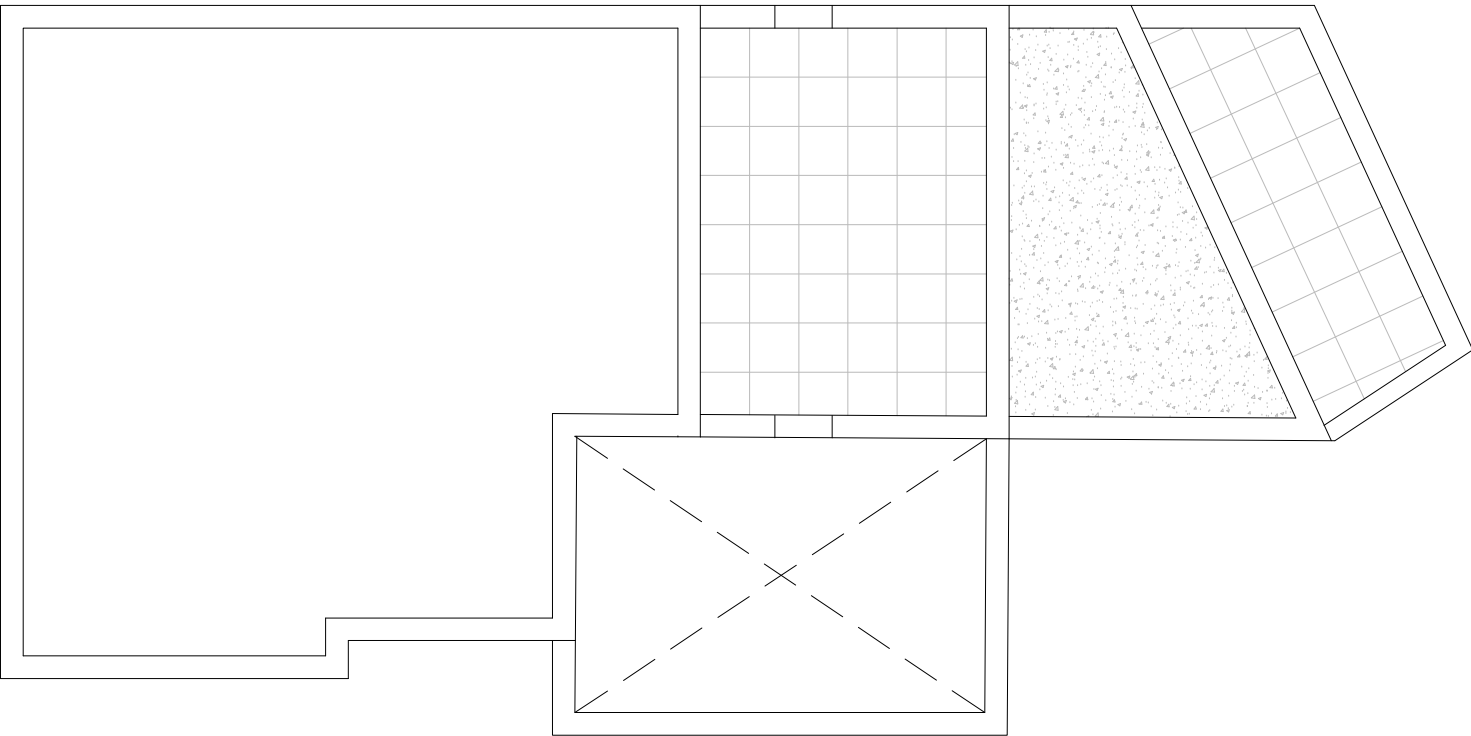


ROOF PLAN

SCALE: 1:100 0 5m



GENERAL NOTES:

KEY:

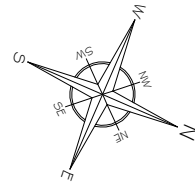

No	Revision / Issue	Date
----	------------------	------

Site :
2 Swan's Lane
London
N6 6QS

Project Title :
Section 73 minor alterations

Drawing :
As-Built
Second Floor &
Roof Plans

Do not alter or amend the scale from this drawing. The information may be suitable for discussion purposes and for obtaining Planning Approval Only. This drawing is NOT for construction purposes and should not be relied upon for any other works. This drawing should not be copied or altered in any way except by way of written permission from the designers. Discrepancies may occur from onsite dimensions to this drawing issued. ABP Architectural Services will not be held liable for any discrepancies raised from this drawing and onsite dimensions.

Project Ref No : ABP-25LH-01	Sheet No : P-101
Date : December 2024	Drawn By : DS
Scale : 1:100 @ A-3	

-	-	-
No	Revision / Issue	Date


Site :
2 Swan's Lane
London
N6 6QS

Project Title :
Section 73 minor alterations


Drawing :
As-Built
Elevations

Do not alter or amend the scale from this drawing. The information may be suitable for discussion purposes and for obtaining Planning Approval Only. This drawing is NOT for construction purposes and should not be relied upon for any other works. This drawing should not be copied or altered in any way except by way of written permission from the designers. Discrepancies may occur from onsite dimensions to this drawing issued. ABP Architectural Services will not be held liable for any discrepancies raised from this drawing and onsite dimensions.

Project Ref No : ABP-25LH-01	Sheet No : P-200
Date : December 2024	Drawn By : DS
Scale : 1:100 @ A-3	

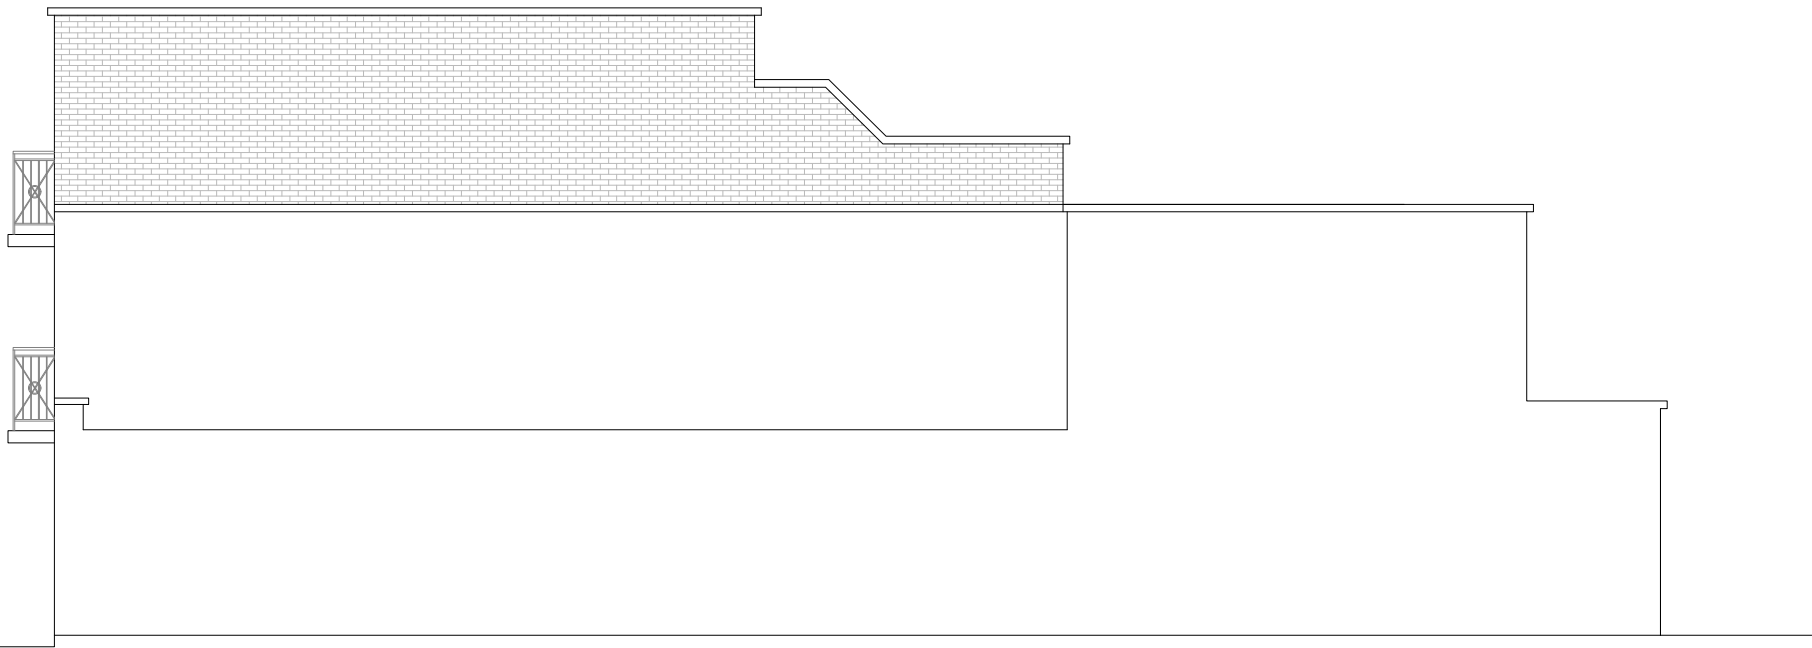

EAST ELEVATION

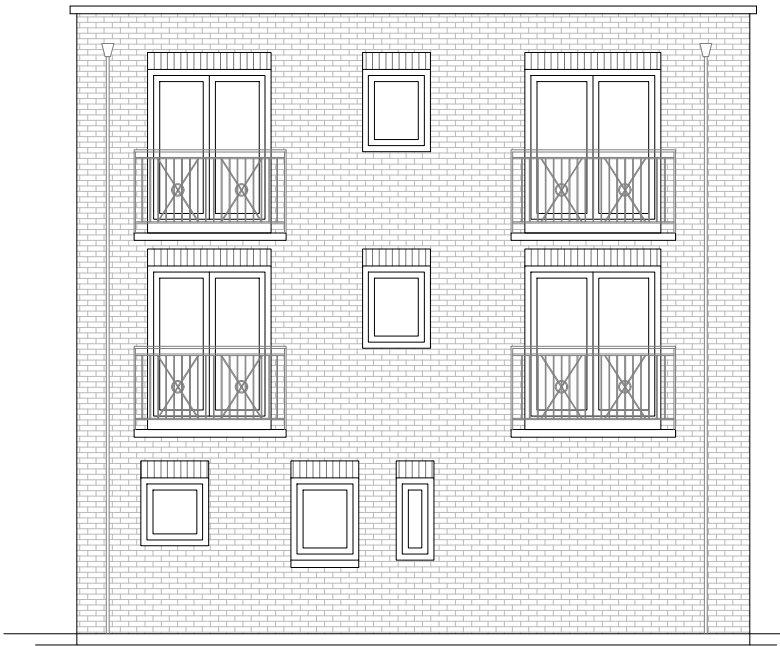

SOUTH ELEVATION



as approved (not yet built)


NORTH ELEVATION

GENERAL NOTES:

KEY:



WEST ELEVATION

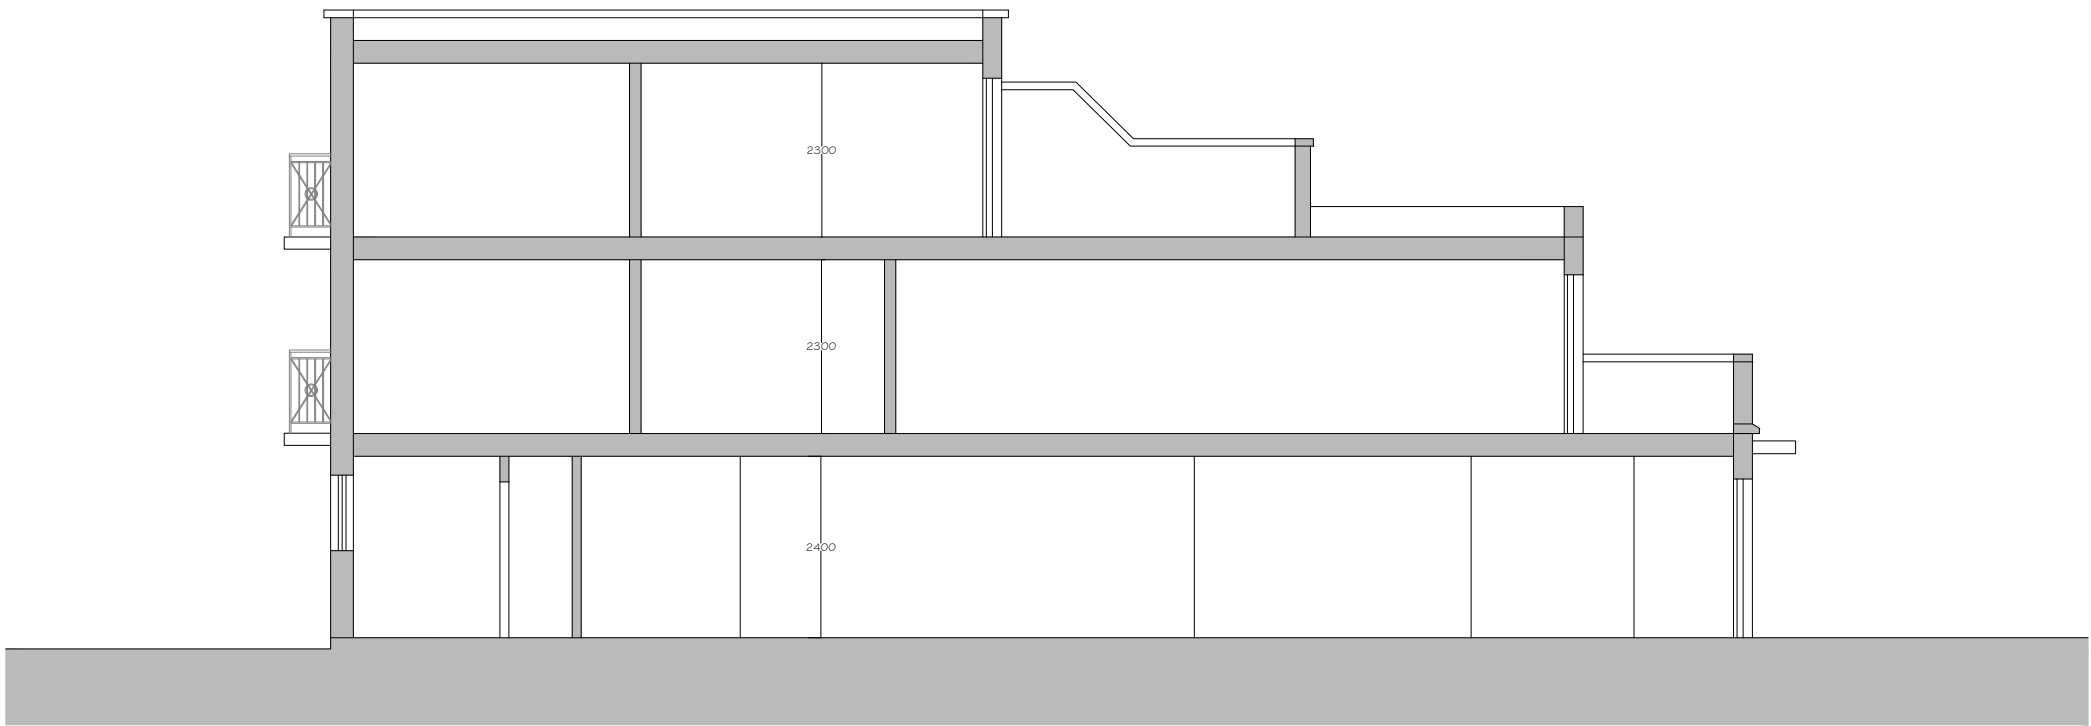

LONG SECTION

SCALE: 1:100 0 5m

-	-	-
No	Revision / Issue	Date


Site :
2 Swan's Lane
London
N6 6QS

Project Title :
Section 73 minor alterations


Drawing :
As-Built
West Elevation &
Long Section

Do not alter or amend the scale from this drawing. The information may be suitable for discussion purposes and for obtaining Planning Approval Only. This drawing is NOT for construction purposes and should not be relied upon for any other works. This drawing should not be copied or altered in any way except by way of written permission from the designers. Discrepancies may occur from onsite dimensions to this drawing issued. ABP Architectural Services will not be held liable for any discrepancies raised from this drawing and onsite dimensions.

Project Ref No : ABP-25LH-01	Sheet No : P-201
Date : December 2024	Drawn By : DS
Scale : 1:100 @ A-3	

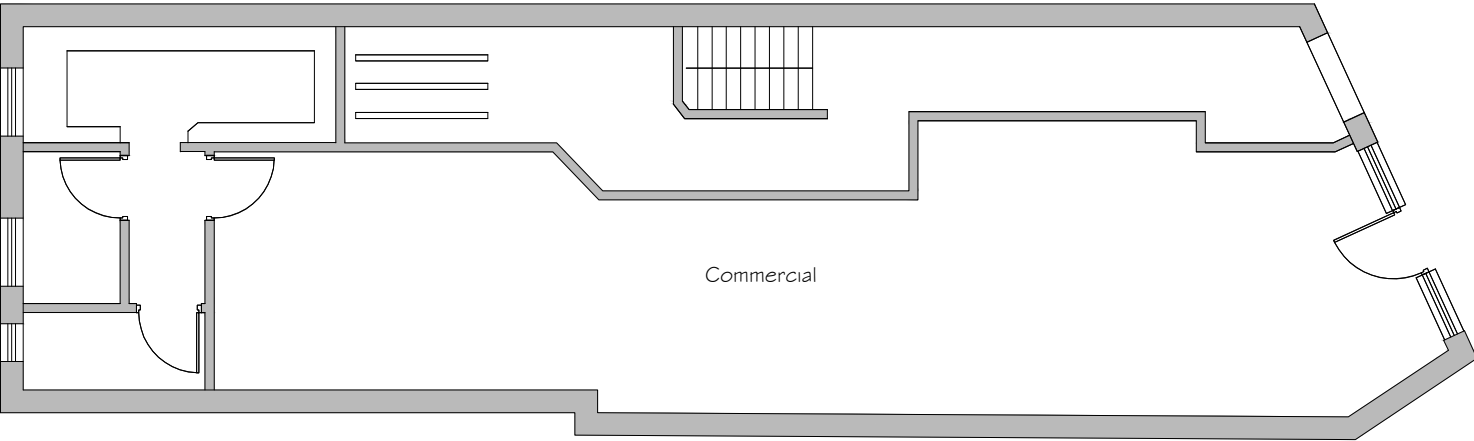

GROUND FLOOR PLAN

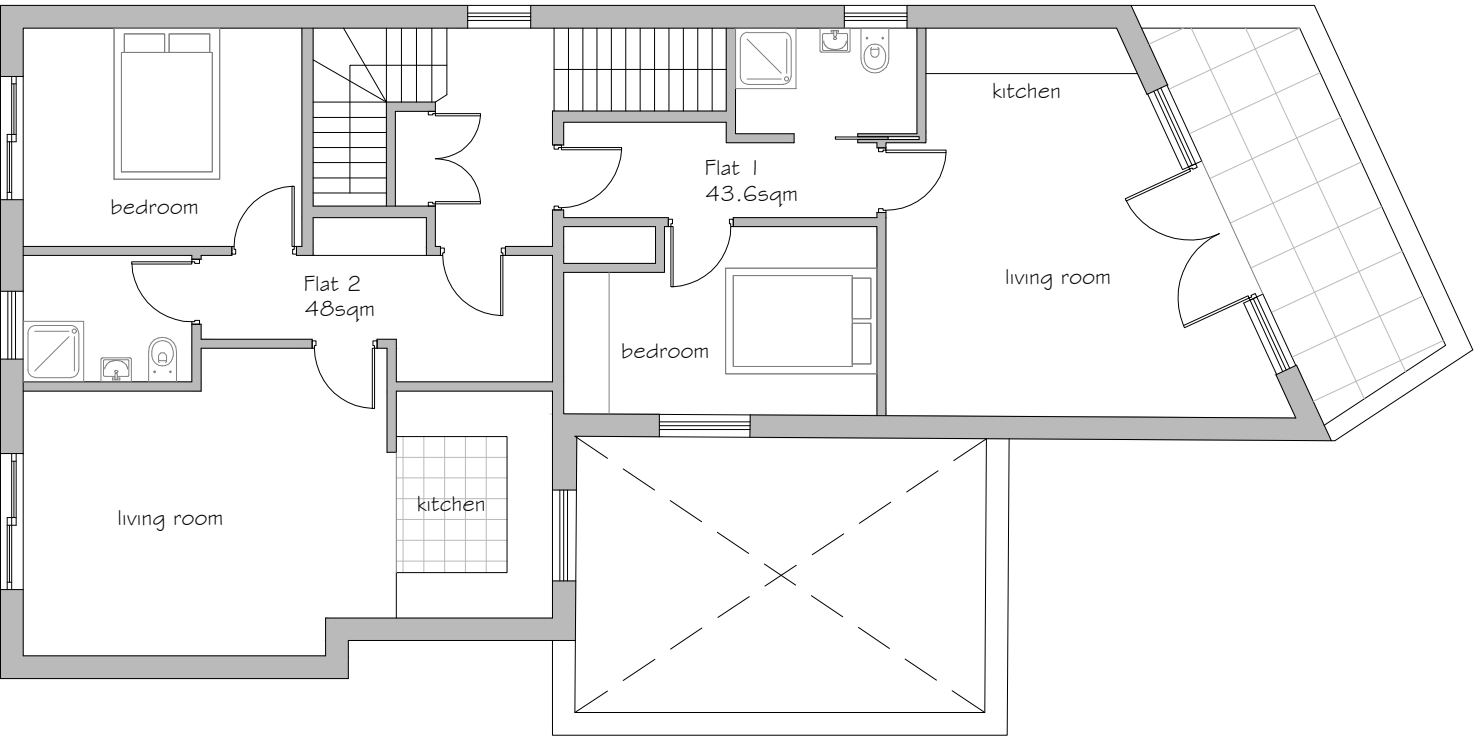


FIRST FLOOR PLAN

SCALE: 1:100 0 5m



GENERAL NOTES:

KEY:

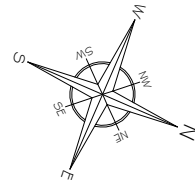

-	-	-
No	Revision / Issue	Date


Site :
2 Swan's Lane
London
N6 6QS

Project Title :
Section 73 minor alterations


Drawing :
Proposed
Ground & First Floor Plans

Do not alter or amend the scale from this drawing. The information may be suitable for discussion purposes and for obtaining Planning Approval Only. This drawing is NOT for construction purposes and should not be relied upon for any other works. This drawing should not be copied or altered in any way except by way of written permission from the designers. Discrepancies may occur from onsite dimensions to this drawing issued. ABP Architectural Services will not be held liable for any discrepancies raised from this drawing and onsite dimensions.

Project Ref No : ABP-25LH-01	Sheet No : P-500
Date : December 2024	Drawn By : DS
Scale : 1:100 @ A-3	

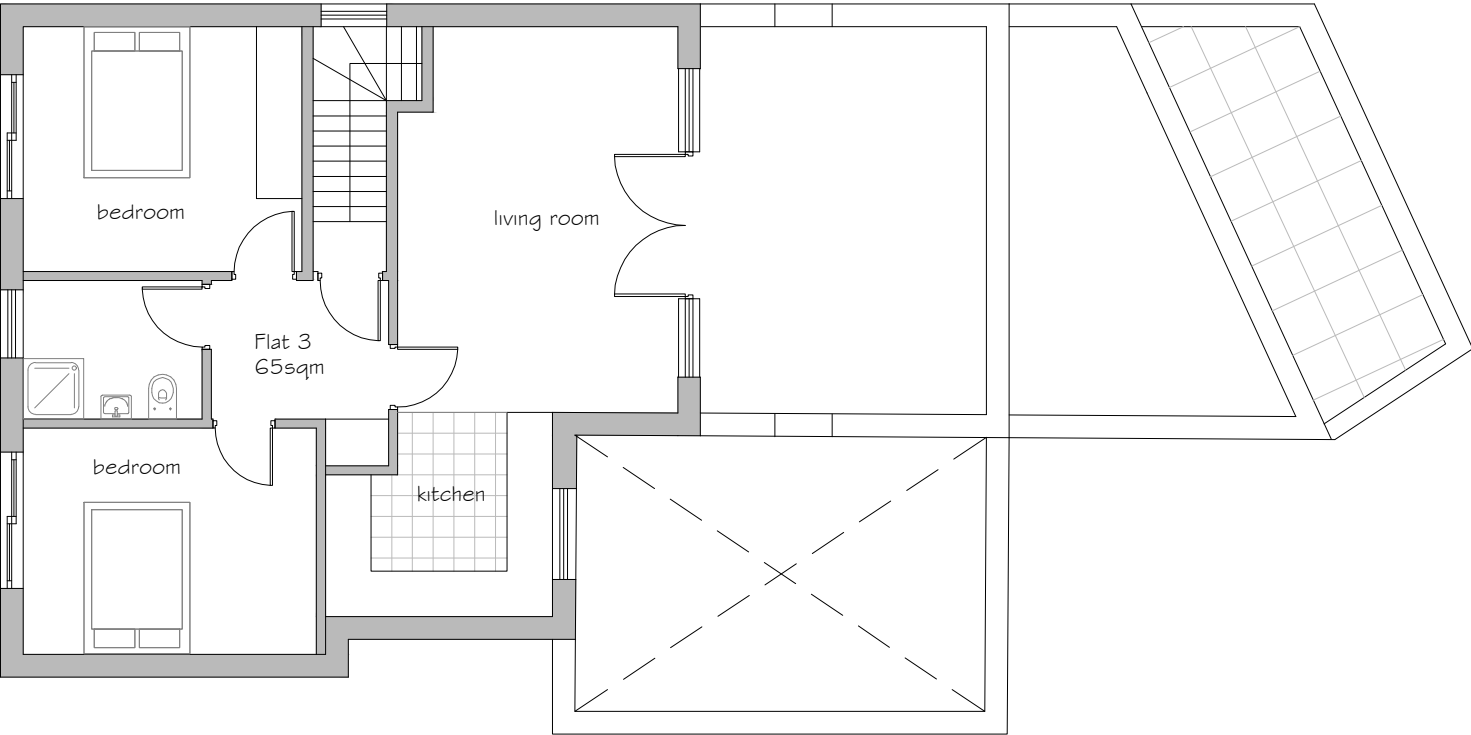

SECOND FLOOR PLAN

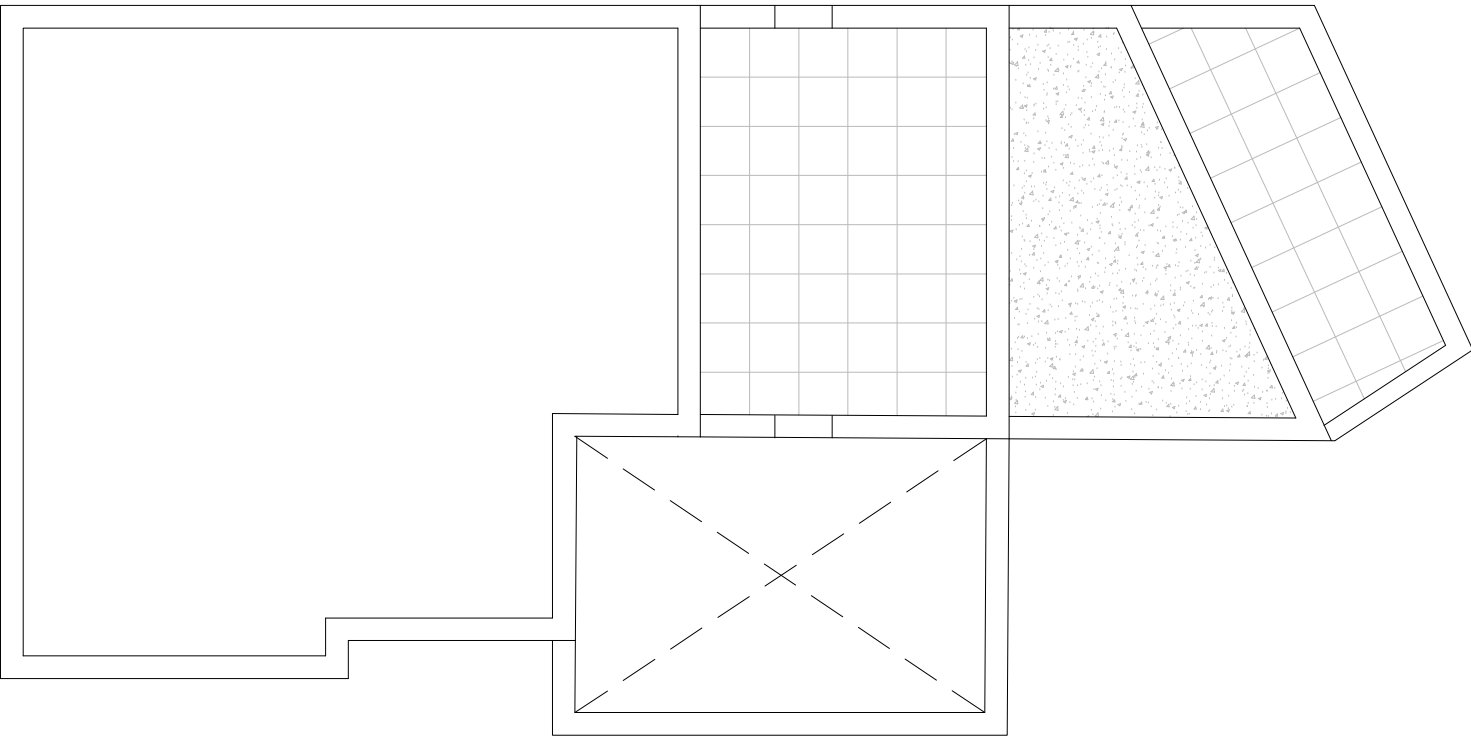


ROOF PLAN

SCALE: 1:100 0 5m



GENERAL NOTES:

KEY:

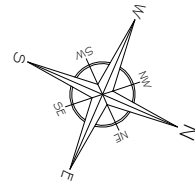

No	Revision / Issue	Date
-	-	-

Site :
2 Swan's Lane
London
N6 6QS

Project Title :
Section 73 minor alterations

Drawing :
Proposed
Second Floor &
Roof Plans

Do not alter or amend the scale from this drawing. The information may be suitable for discussion purposes and for obtaining Planning Approval Only. This drawing is NOT for construction purposes and should not be relied upon for any other works. This drawing should not be copied or altered in any way except by way of written permission from the designers. Discrepancies may occur from onsite dimensions to this drawing issued. ABP Architectural Services will not be held liable for any discrepancies raised from this drawing and onsite dimensions.

Project Ref No : ABP-25LH-01	Sheet No : P-501
Date : December 2024	Drawn By : DS
Scale : 1:100 @ A-3	

GENERAL NOTES:

KEY:

-	-	-
No	Revision / Issue	Date


Site :
2 Swan's Lane
London
N6 6QS

Project Title :
Section 73 minor alterations


Drawing :
Proposed
Elevations

Do not alter or amend the scale from this drawing. The information may be suitable for discussion purposes and for obtaining Planning Approval Only. This drawing is NOT for construction purposes and should not be relied upon for any other works. This drawing should not be copied or altered in any way except by way of written permission from the designers. Discrepancies may occur from onsite dimensions to this drawing issued. ABP Architectural Services will not be held liable for any discrepancies raised from this drawing and onsite dimensions.

Project Ref No : ABP-25LH-01	Sheet No : P-600
Date : December 2024	Drawn By : DS
Scale : 1:100 @ A-3	

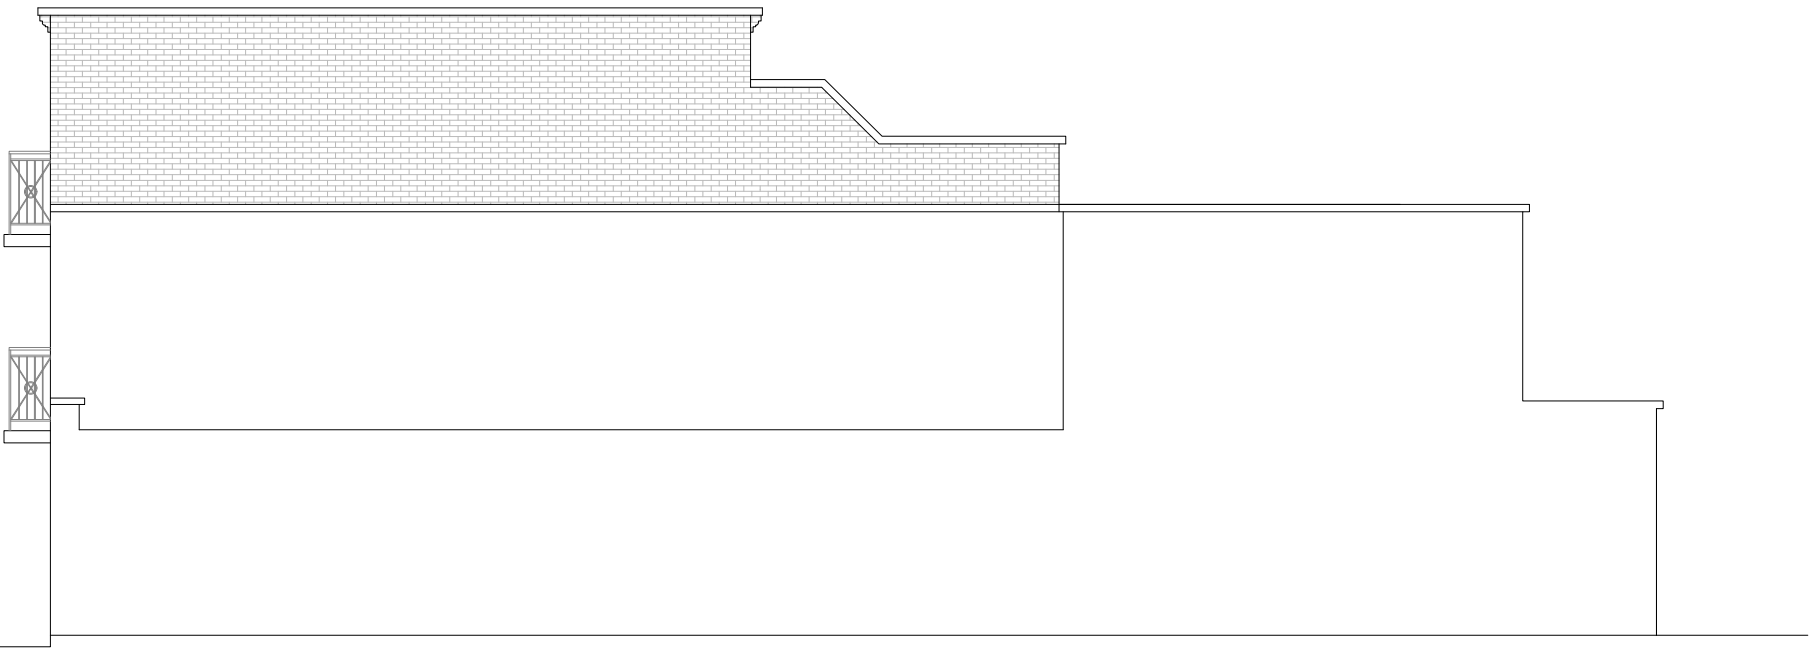

EAST ELEVATION

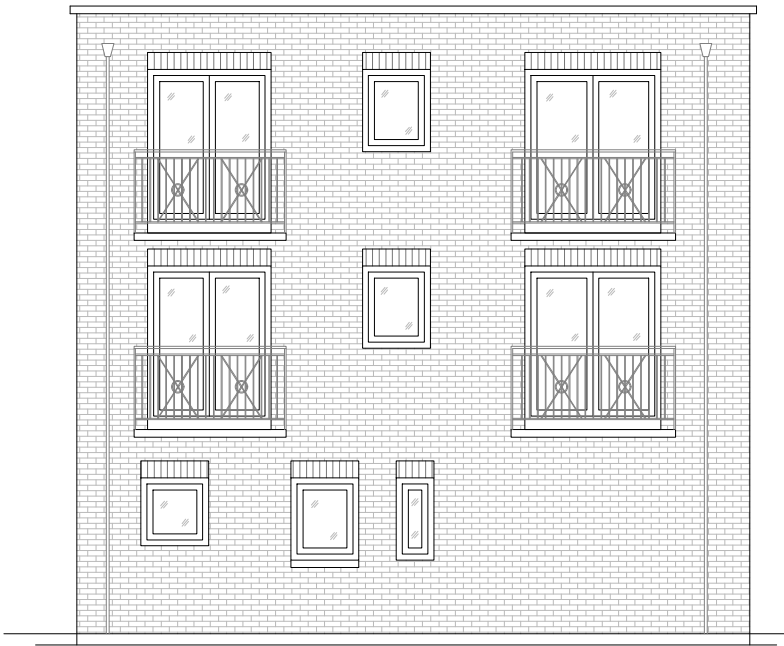


SOUTH ELEVATION




NORTH ELEVATION

GENERAL NOTES:

KEY:

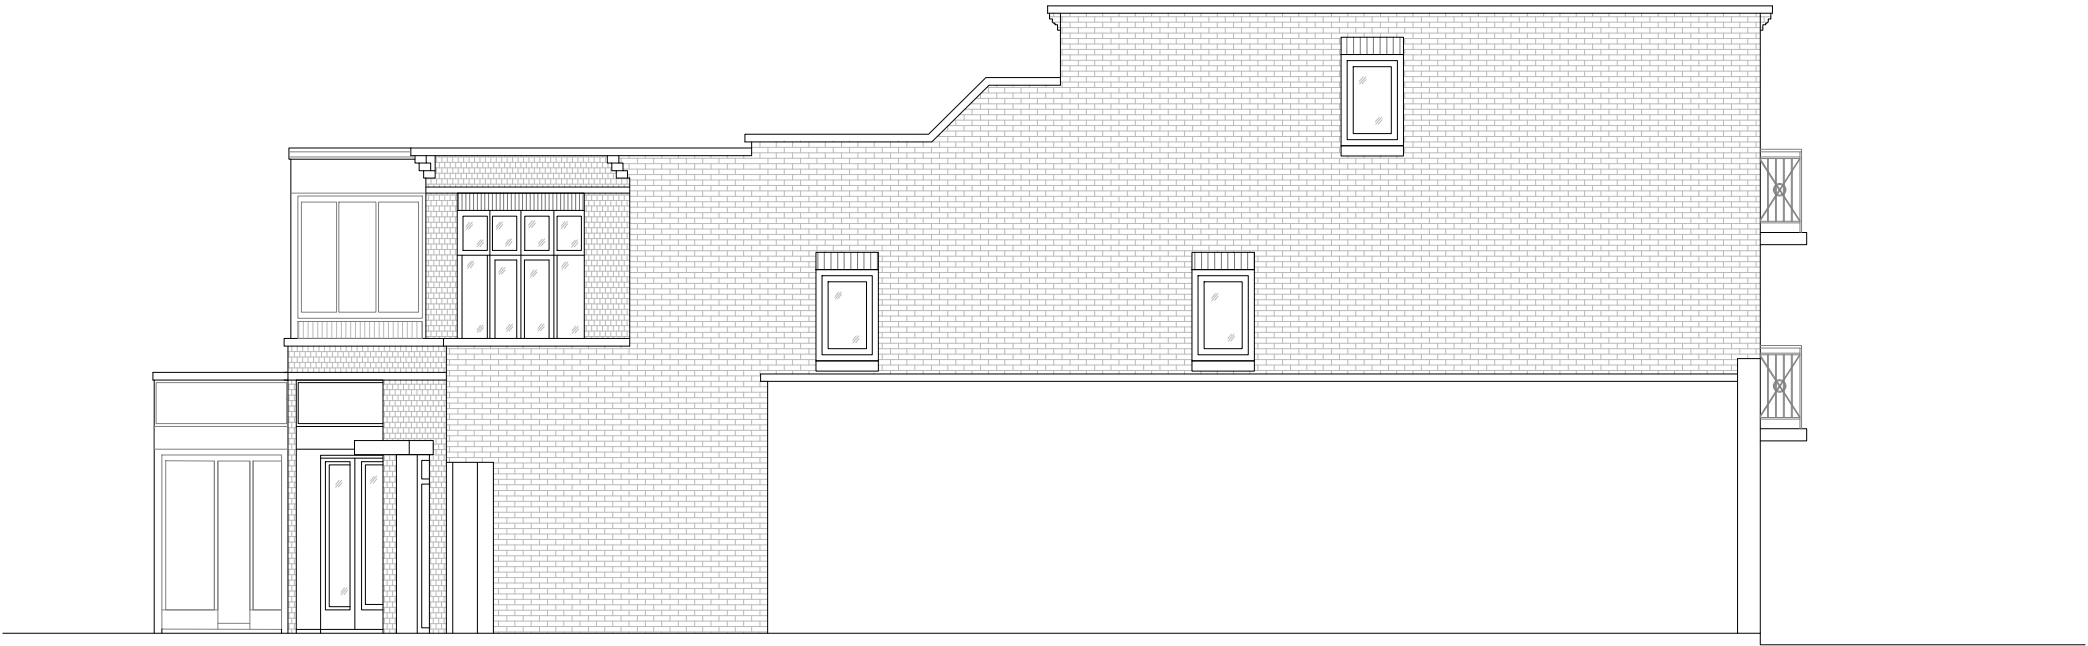

WEST ELEVATION

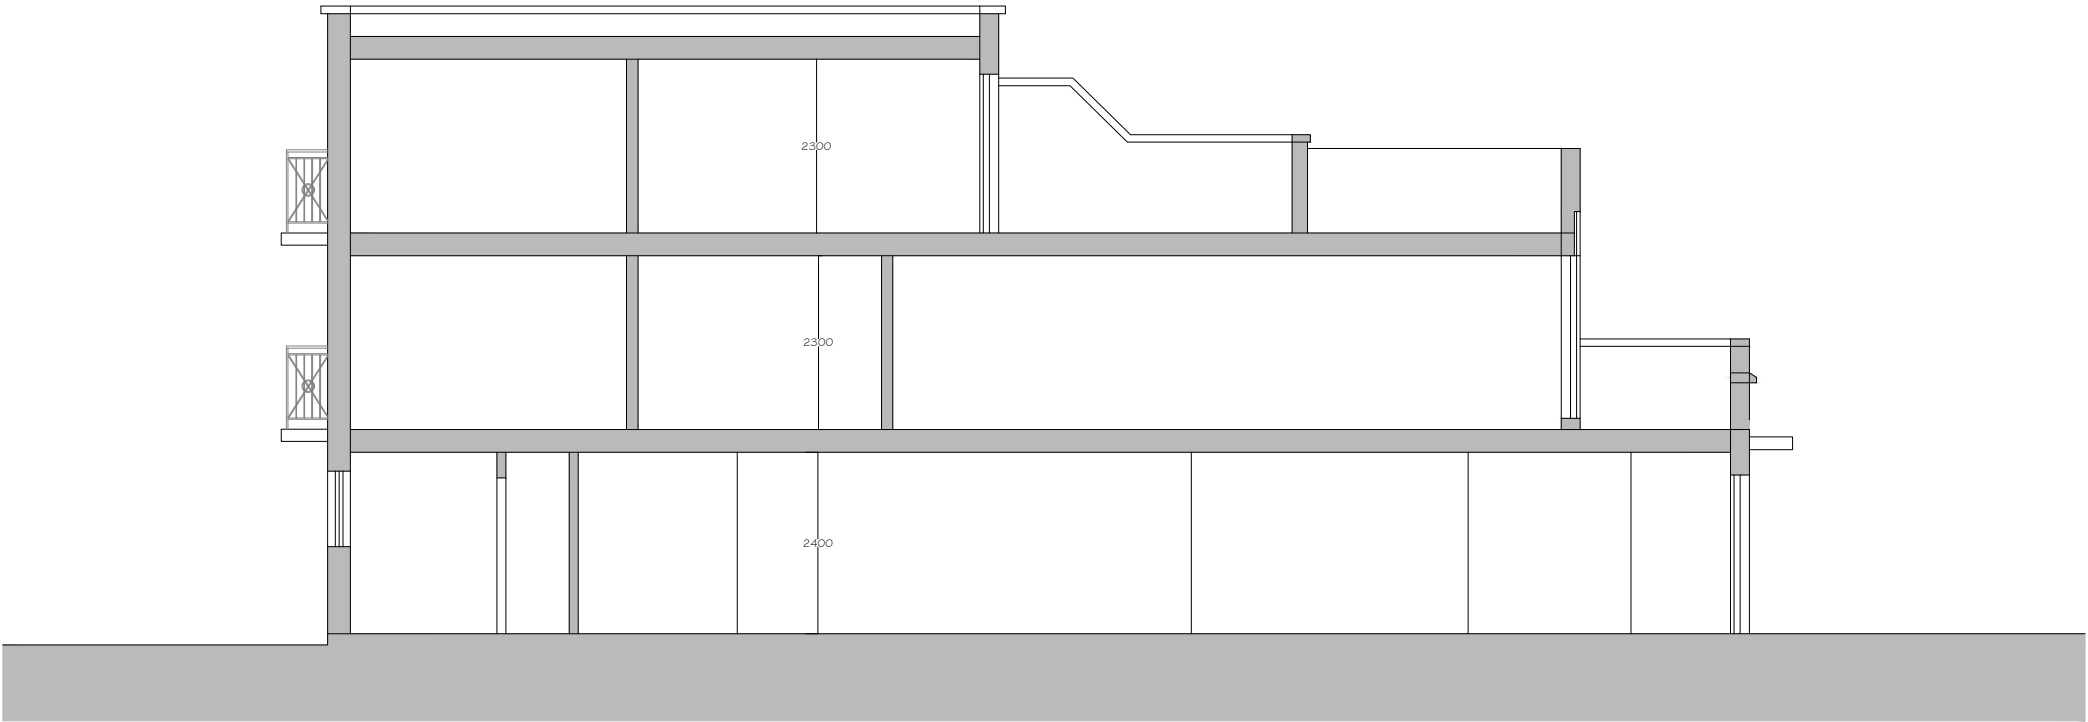

LONG SECTION

SCALE: 1:100 0 5m

-	-	-
No	Revision / Issue	Date

Site :
2 Swan's Lane
London
N6 6QS

Project Title :
Section 73 minor alterations

Drawing :
Proposed
West Elevation &
Long Section

Do not alter or amend the scale from this drawing. The information may be suitable for discussion purposes and for obtaining Planning Approval Only. This drawing is NOT for construction purposes and should not be relied upon for any other works. This drawing should not be copied or altered in any way except by way of written permission from the designers. Discrepancies may occur from onsite dimensions to this drawing issued. ABP Architectural Services will not be held liable for any discrepancies raised from this drawing and onsite dimensions.

Project Ref No : ABP-25LH-01	Sheet No : P-601
Date : December 2024	Drawn By : DS
Scale : 1:100 @ A-3	