


All dimensions in millimeters....DO NOT SCALE

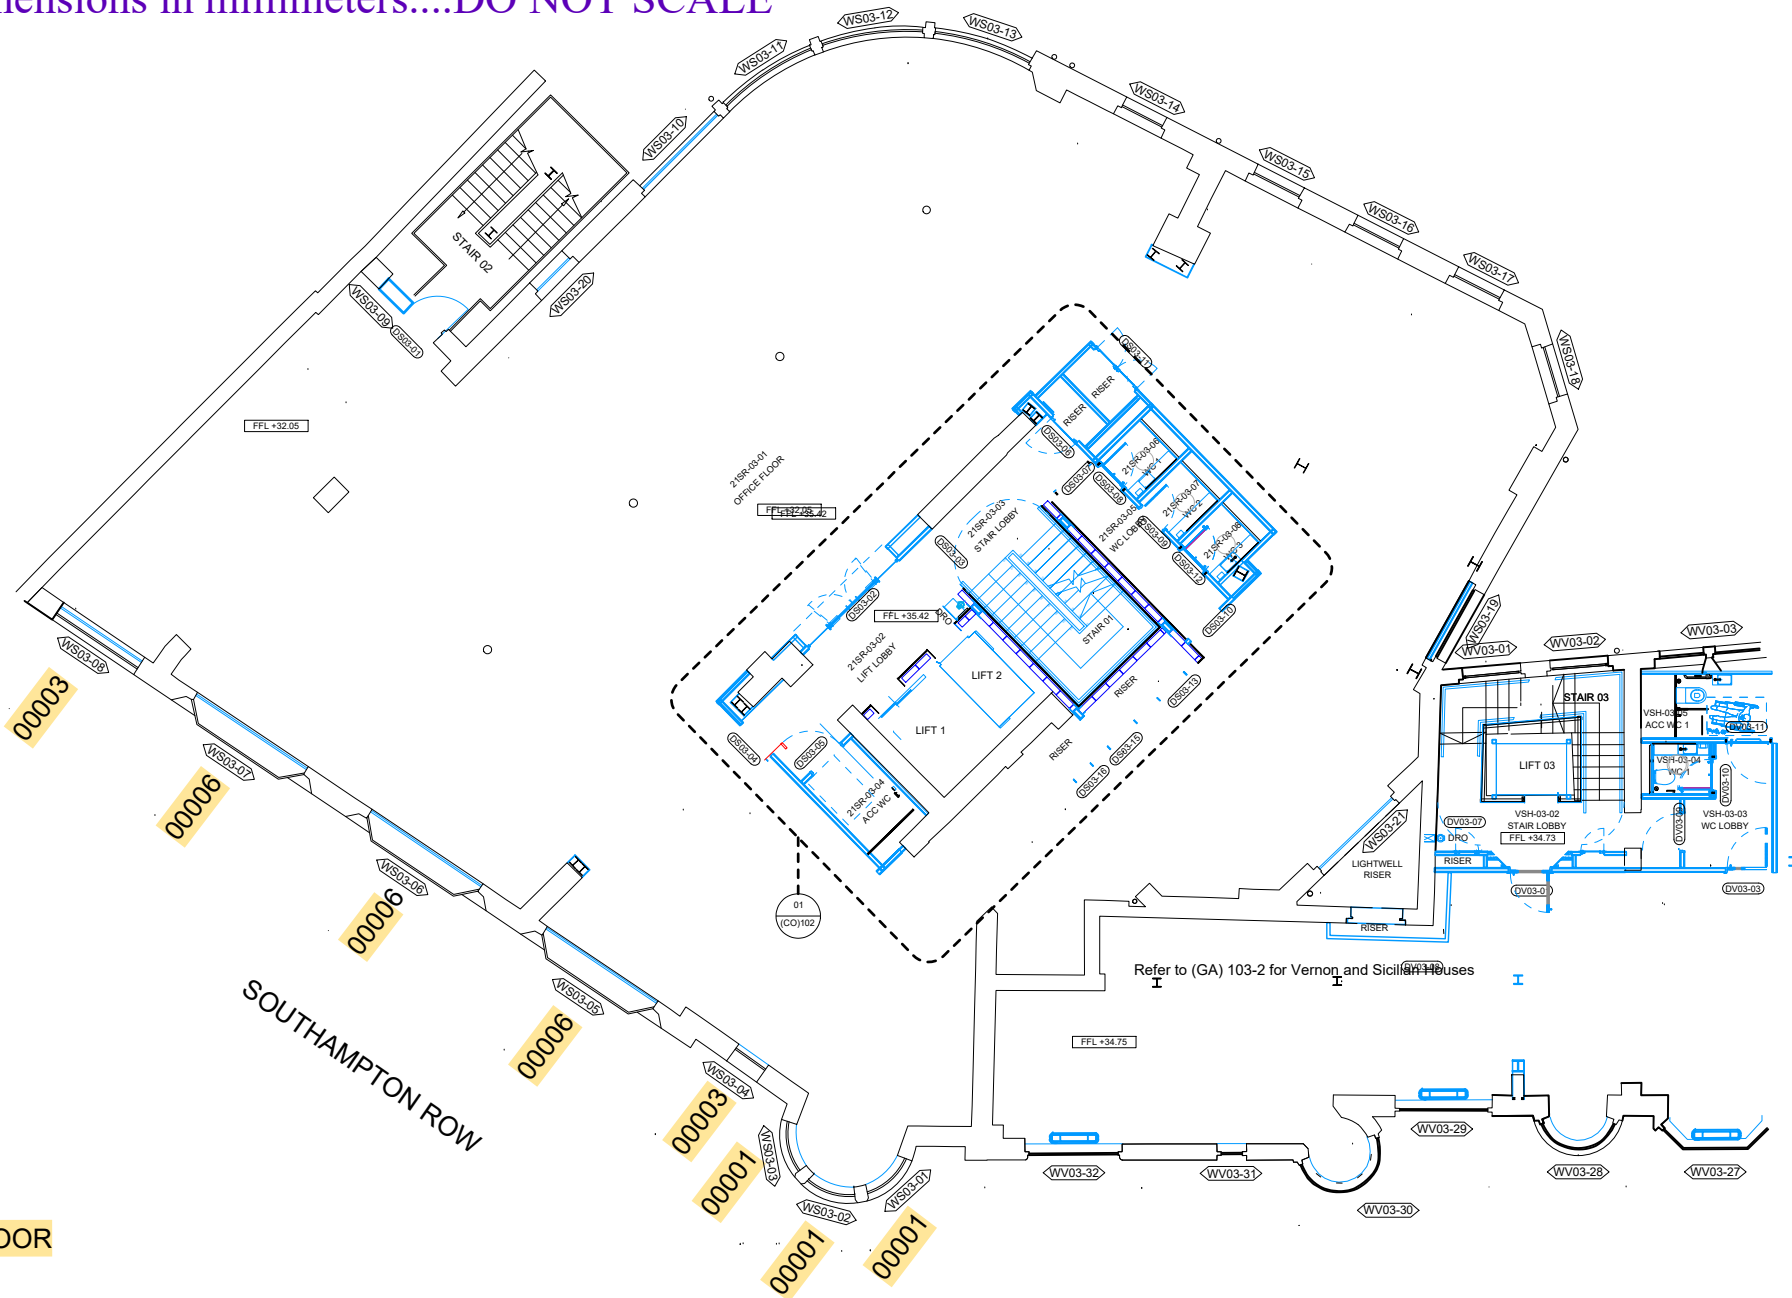

3RD FLOOR

Secondary Glazing Types (Marked Up)

DATE
28/11/24

SCALE
NTS

Client: Structure Tone Site: Bloomsbury Quartar Project 1

DRAWING No.
BQ-3520-WB-ML-DR-X-00011

seledaglaze
ALBAN PARK, HATFIELD ROAD
ST. ALBANS HERTS AL4 0JJ
TEL: 01727 837271
FAX: 01727 844053