


All dimensions in millimeters....DO NOT SCALE

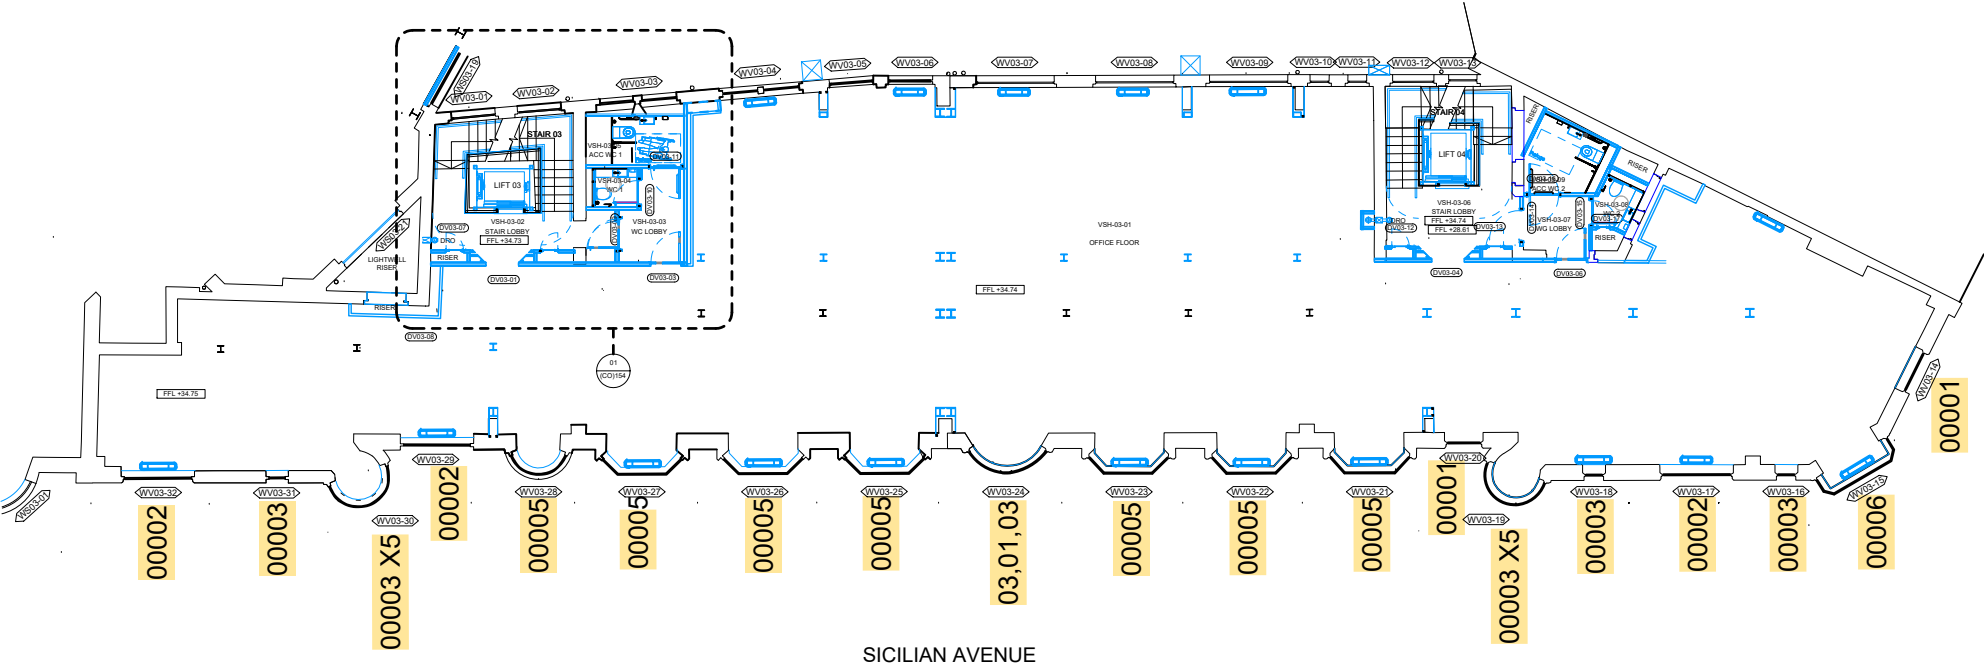

3RD FLOOR

Secondary Glazing Types (Marked Up)		DATE 28/11/24	SCALE NTS
Client: Structure Tone Site: Bloomsbury Quartar Project 1		DRAWING No. BQ-3520-WB-ML-DR-X-00012	
		seleclaglaze ALBAN PARK, HATFIELD ROAD ST. ALBANS HERTS AL4 0JJ TEL: 01727 837271 FAX: 01727 844053	