
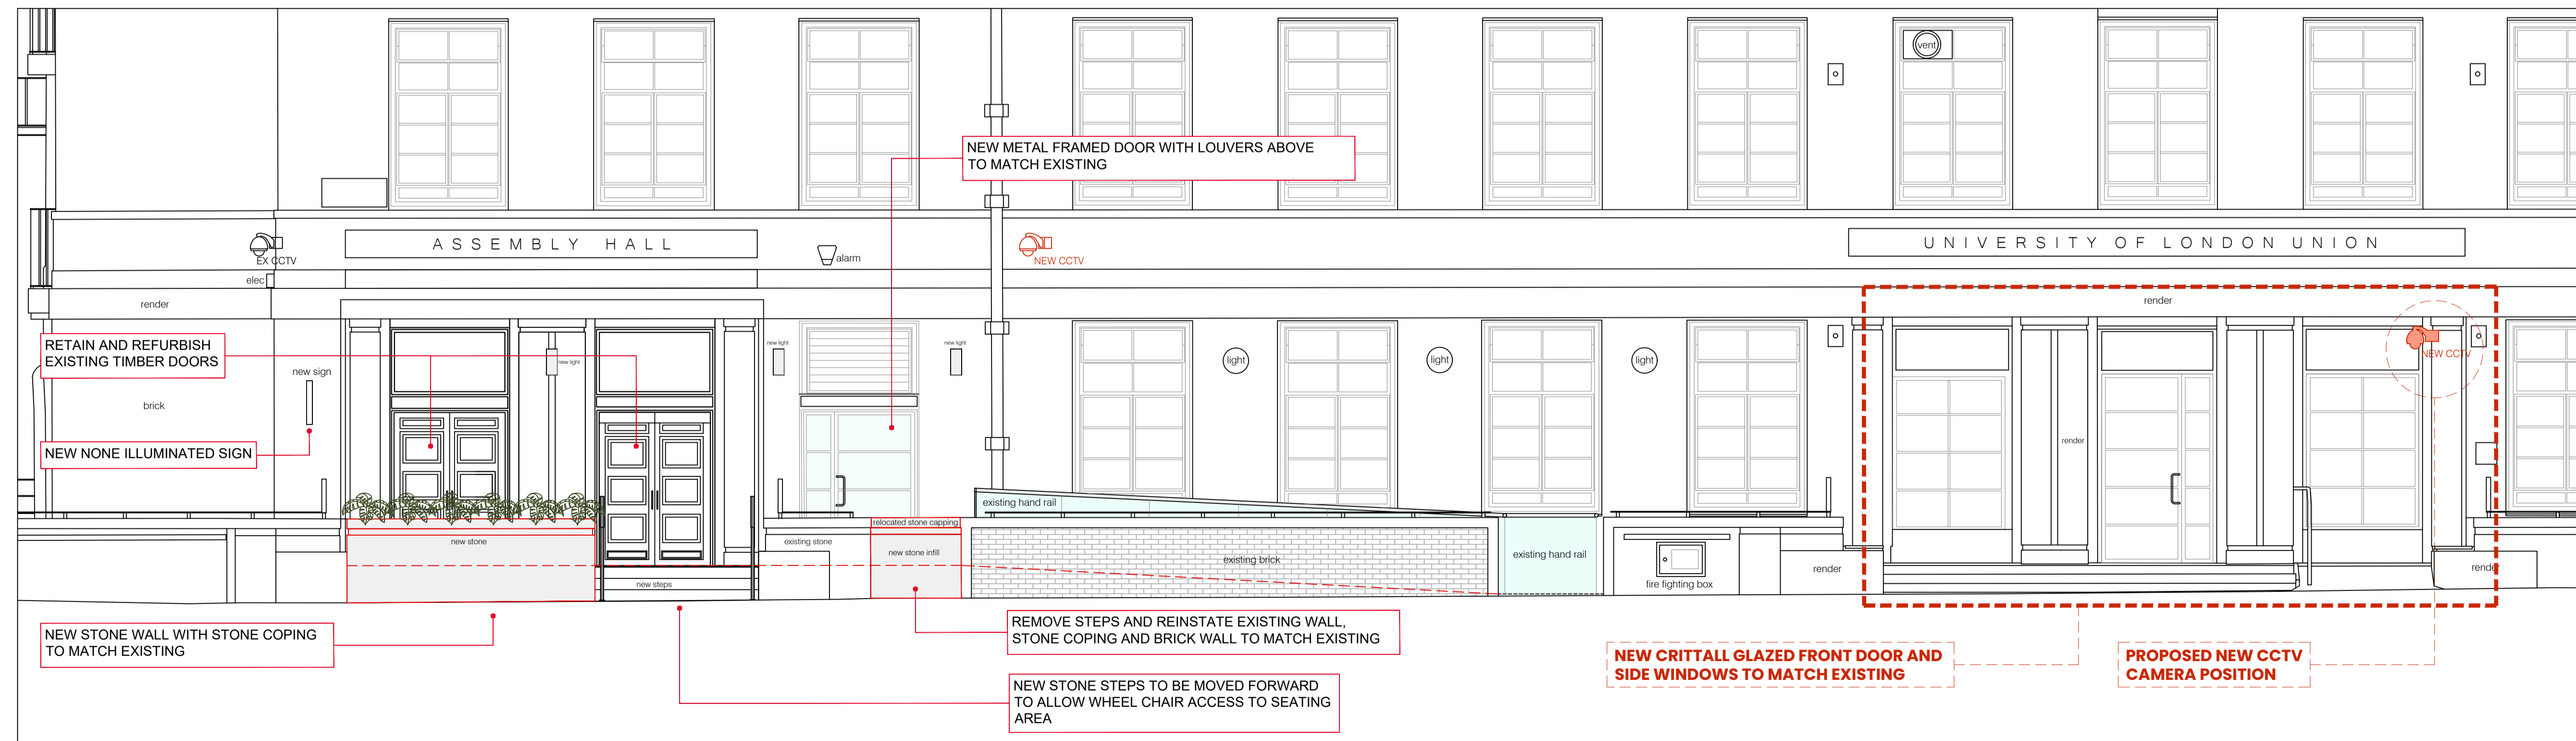


Birkbeck Central Cafe

Ground Floor

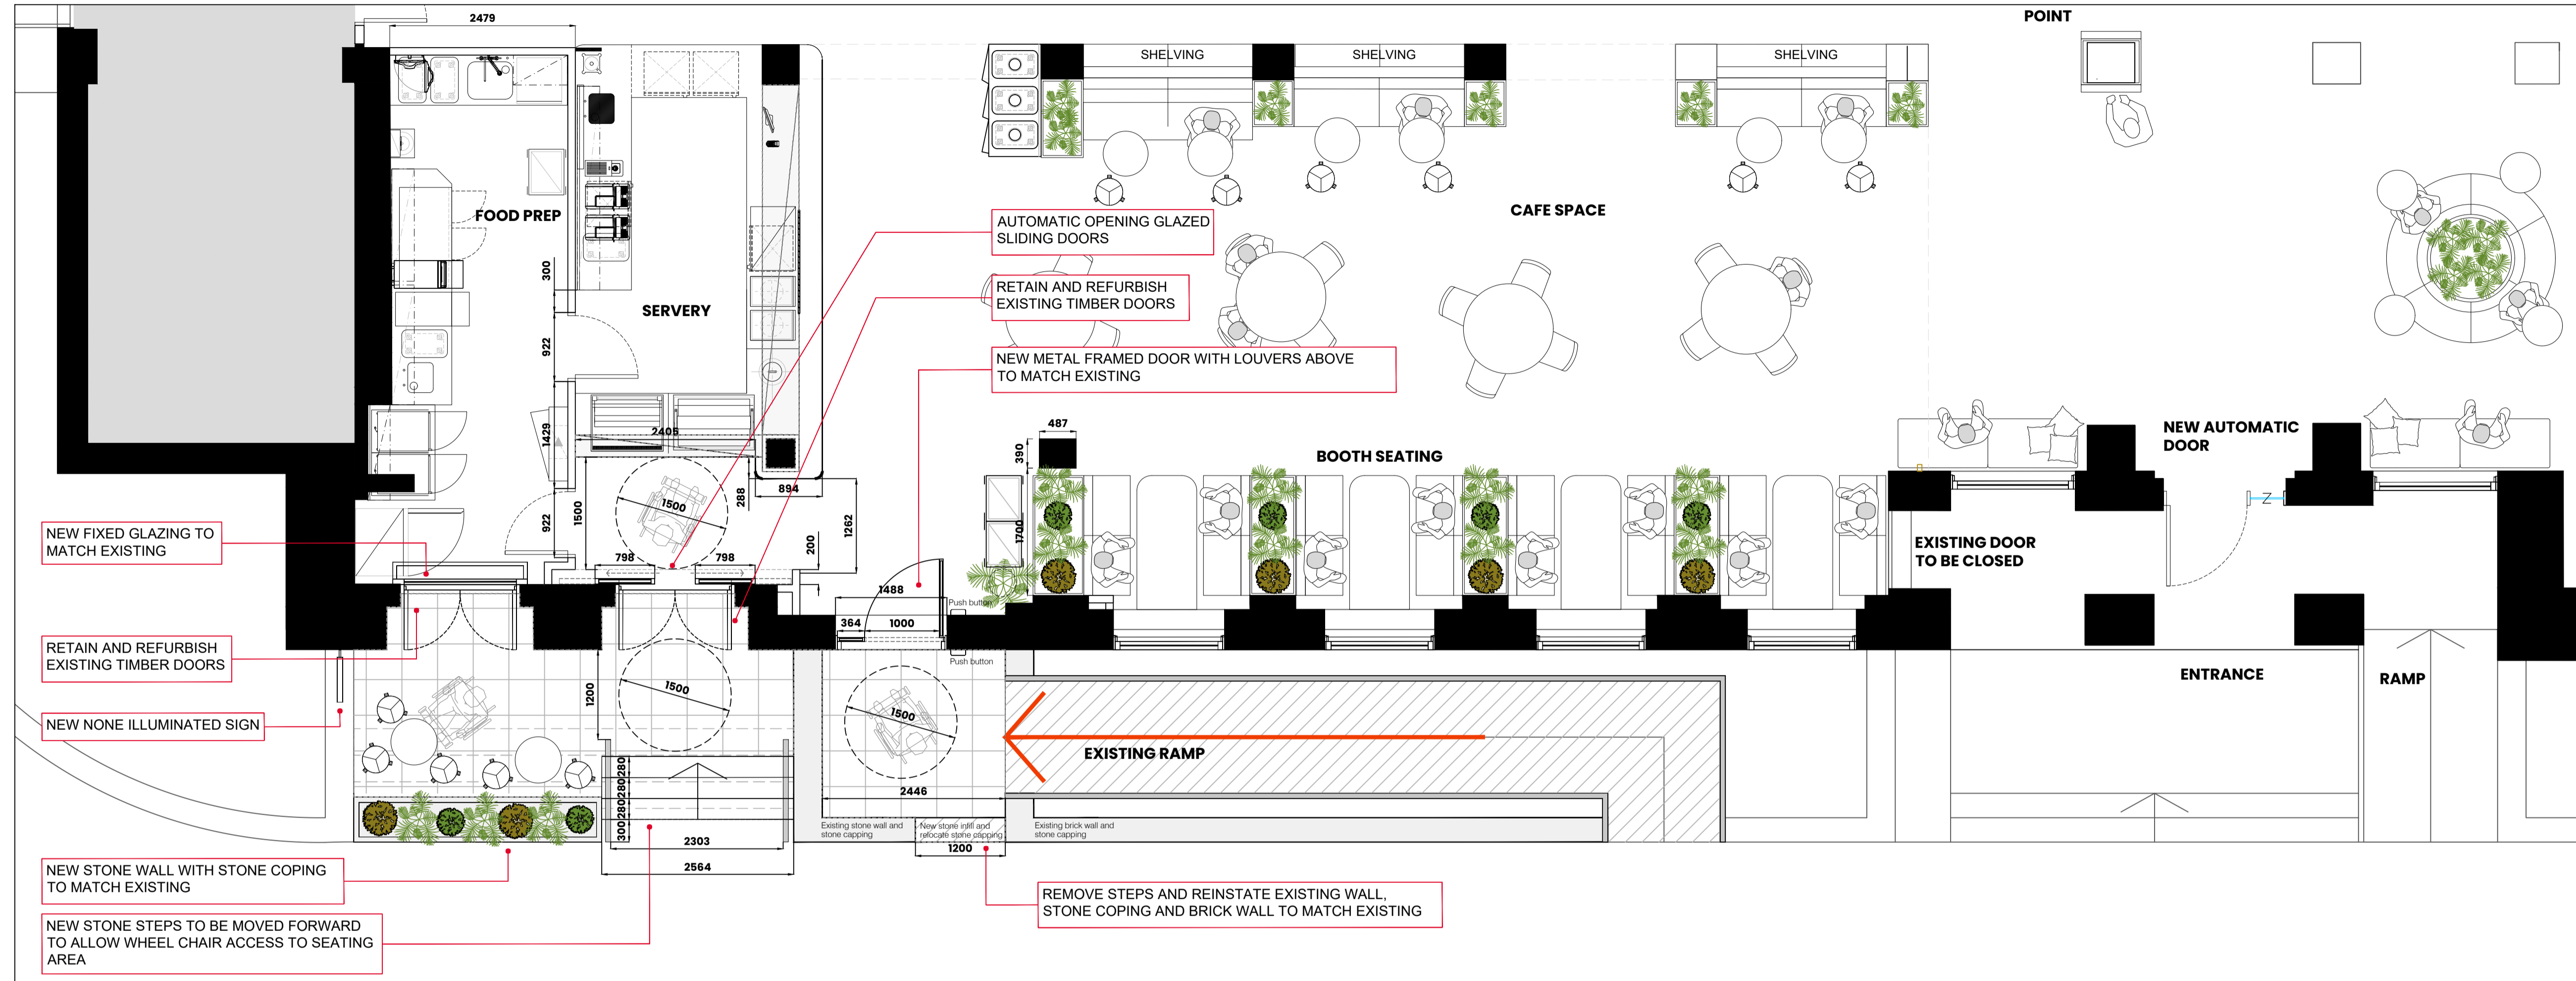

REV	DESCRIPTION	BY	DATE
C	Design Update	AJH	05/01/2025
B	Design Update	AJH	06/12/2024
A	Design Update	CH	03/04/2024
-	Drawing first produced	CH	03/04/2024

DRAWING STATUS
FOR CONSTRUCTION

Birkbeck College BCB Wellness - Birkbeck Cnt

Address
Birkbeck Central Building
Malet Street
London WC1E 7HX

Project Number	Ref	Floor	Detail	Rev
32939	01	00	GA	C

Drawing Title
Gnd Floor Cafe Exterior Plan and Exterior Elevation

Produced by: CH Scale: 1:100@A1 Date Created: 03/04/2024

MARIS INTERIORS
The Marquis Building
45 Southwark Street
London SE1 0HR

T: 020 7802 1888
E: hello@maris.co.uk
W: maris.co.uk

© MARIS INTERIORS LLP Property & Copyright
Use of drawings is not permitted nor can they be copied, duplicated or distributed without the consent of the LLP.
All designs are the sole property of MARIS INTERIORS LLP, and may not be used, transferred, or disclosed to a third party without the express permission of MARIS INTERIORS LLP. Electronic copies of this drawing are supplied for convenience only. No dimensions or other information should be used from the electronic copy. Do not scale from this drawing. Figured dimensions only are to be used 'For Construction' and any scaling of the drawing will be at the Contractor's risk. Contractor to verify all dimensions, levels, and components on-site. Any discrepancies shall be addressed in writing to this office for clarification prior to the commencement of the work, otherwise the Contractor shall bear full responsibility for any associated cost. Any claims for variations or extras shall be submitted to this office for assessment prior to approval of any such variation or extra. This drawing is to be used in conjunction with all other Contract documentation. This drawing must be signed otherwise it will be invalid. Building parameters taken from as built drawings provided. Check survey undertaken only, subject to statutory approval. All dimensions shown are in millimetres unless otherwise shown.