



Existing Roof Plan

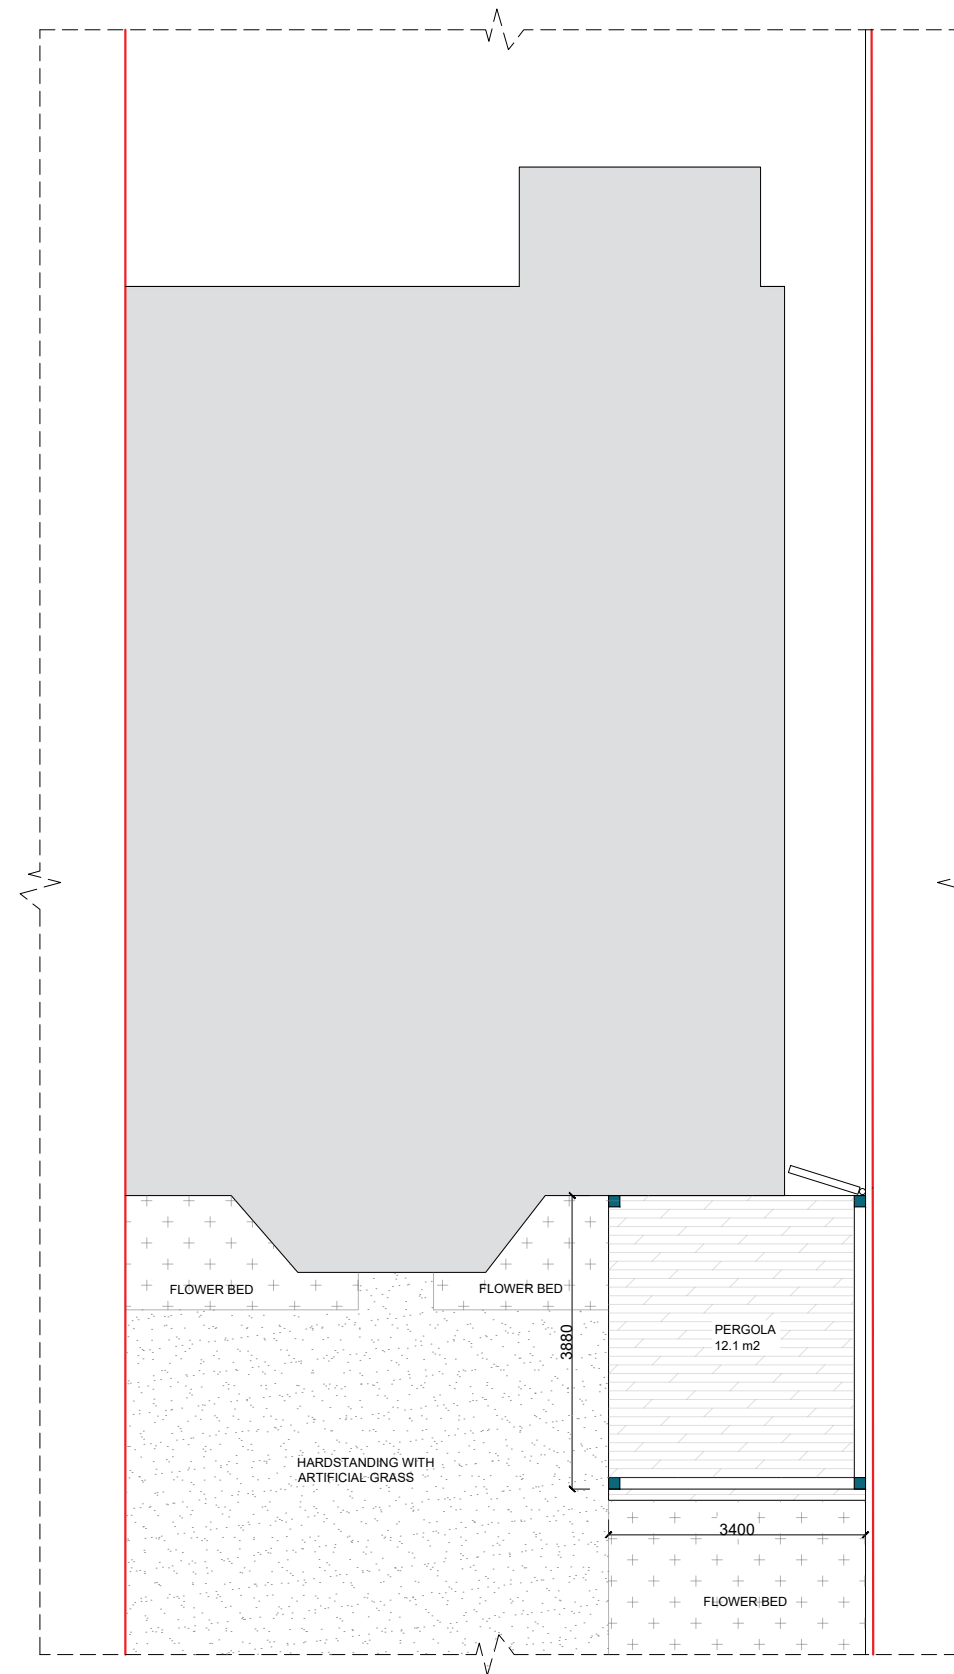

Existing Ground Floor Plan

Any dimensions shown should be checked on site and discrepancies reported to the Architect prior to construction. Designs are not coordinated with engineer projects. Do not scale for construction purposes.

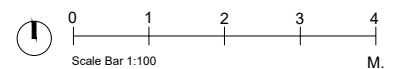

Existing As-Built

Drawing Name  
**Existing Plans**

Project Address  
**17A Arkwright Road London NW3 6AA**

Drawing No.  
**17A Arkwright Road\_ ExistingPlans\_V1**

Scale <b>1/100 at A3</b>	Drawing No. <b>05</b>
Designer <b>EC</b>	Revision <b>V1</b>
Date <b>08.01.2025</b>	



Planning By Design Ltd  
www.planning-by-design.co.uk  
hello@planning-by-design.co.uk