


NOTES

Copyright Carbogno Architects.


No implied license exists. This drawing should not be used to calculate areas for the purposes of valuation. All dimensions to be checked on site by the contractor and such dimensions to be their responsibility.

This drawing is to be read in conjunction with all other contract documents and specifications and all other consultants drawings. All levels and dimensions should be checked on site.


All work must comply with relevant British Standards and Building Regulations requirements. Drawing errors and omissions to be reported to the architect.

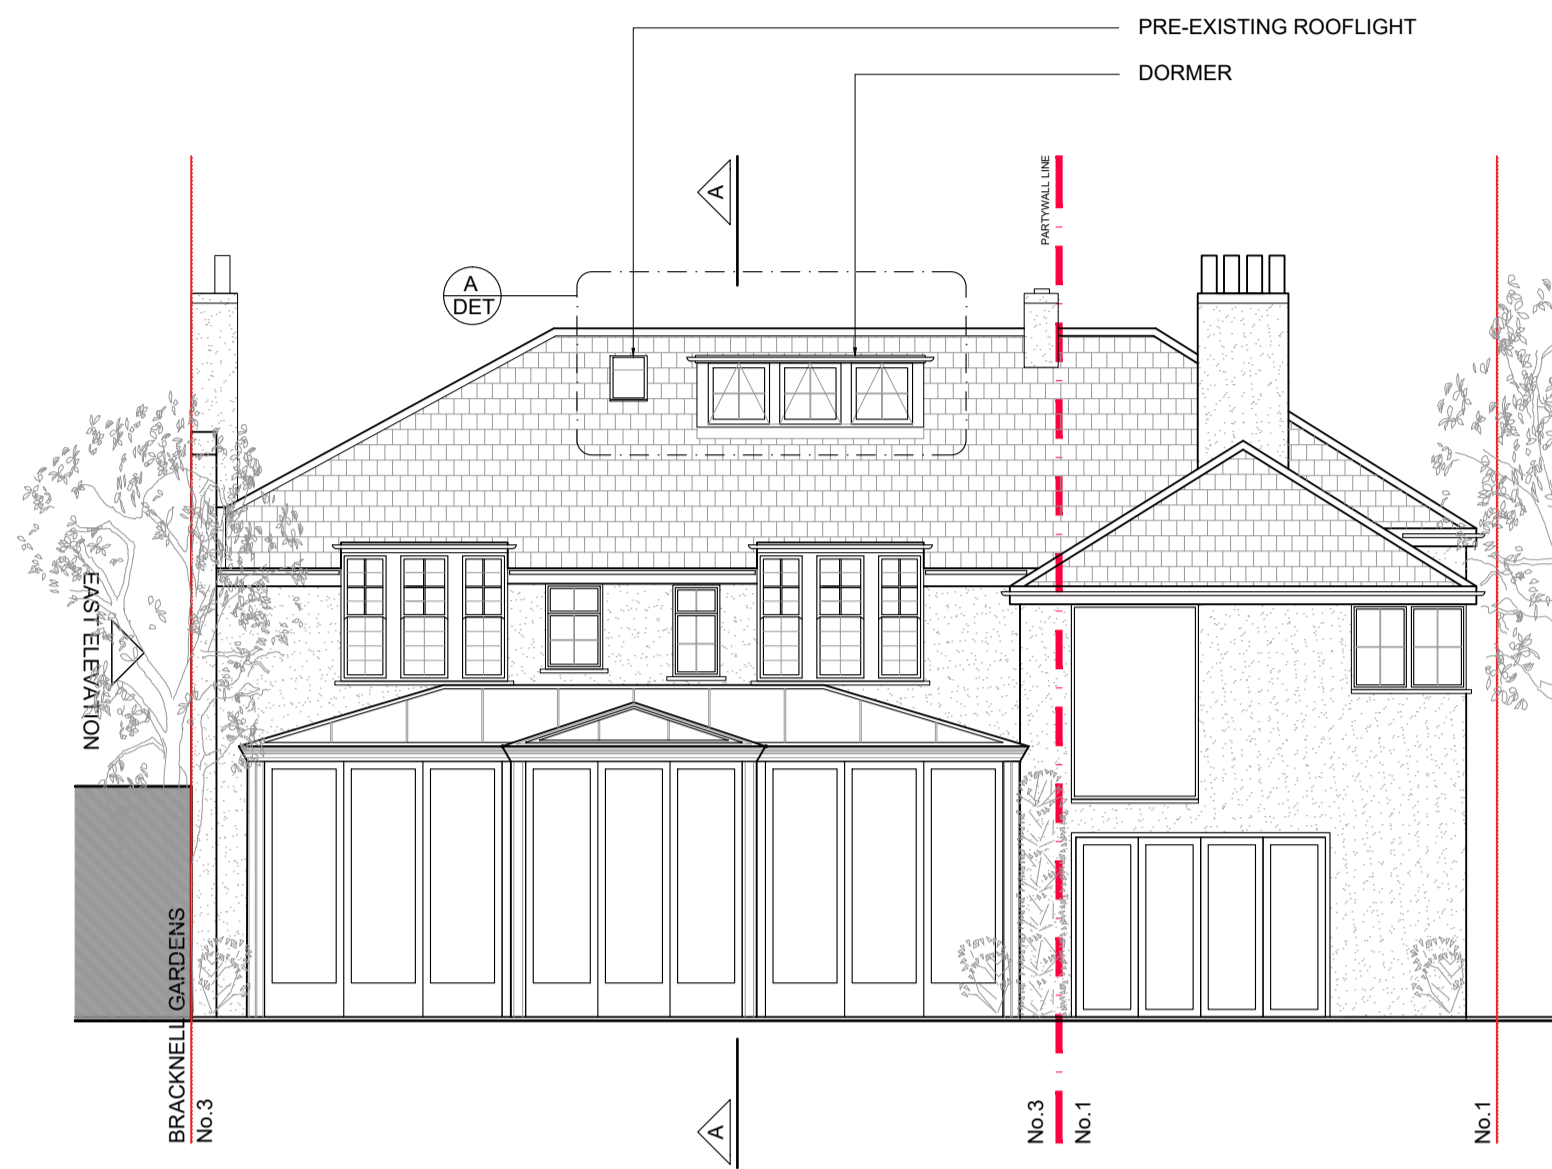


01 AS BUILT REAR ELEVATION
SCALE 1:100 @ A1

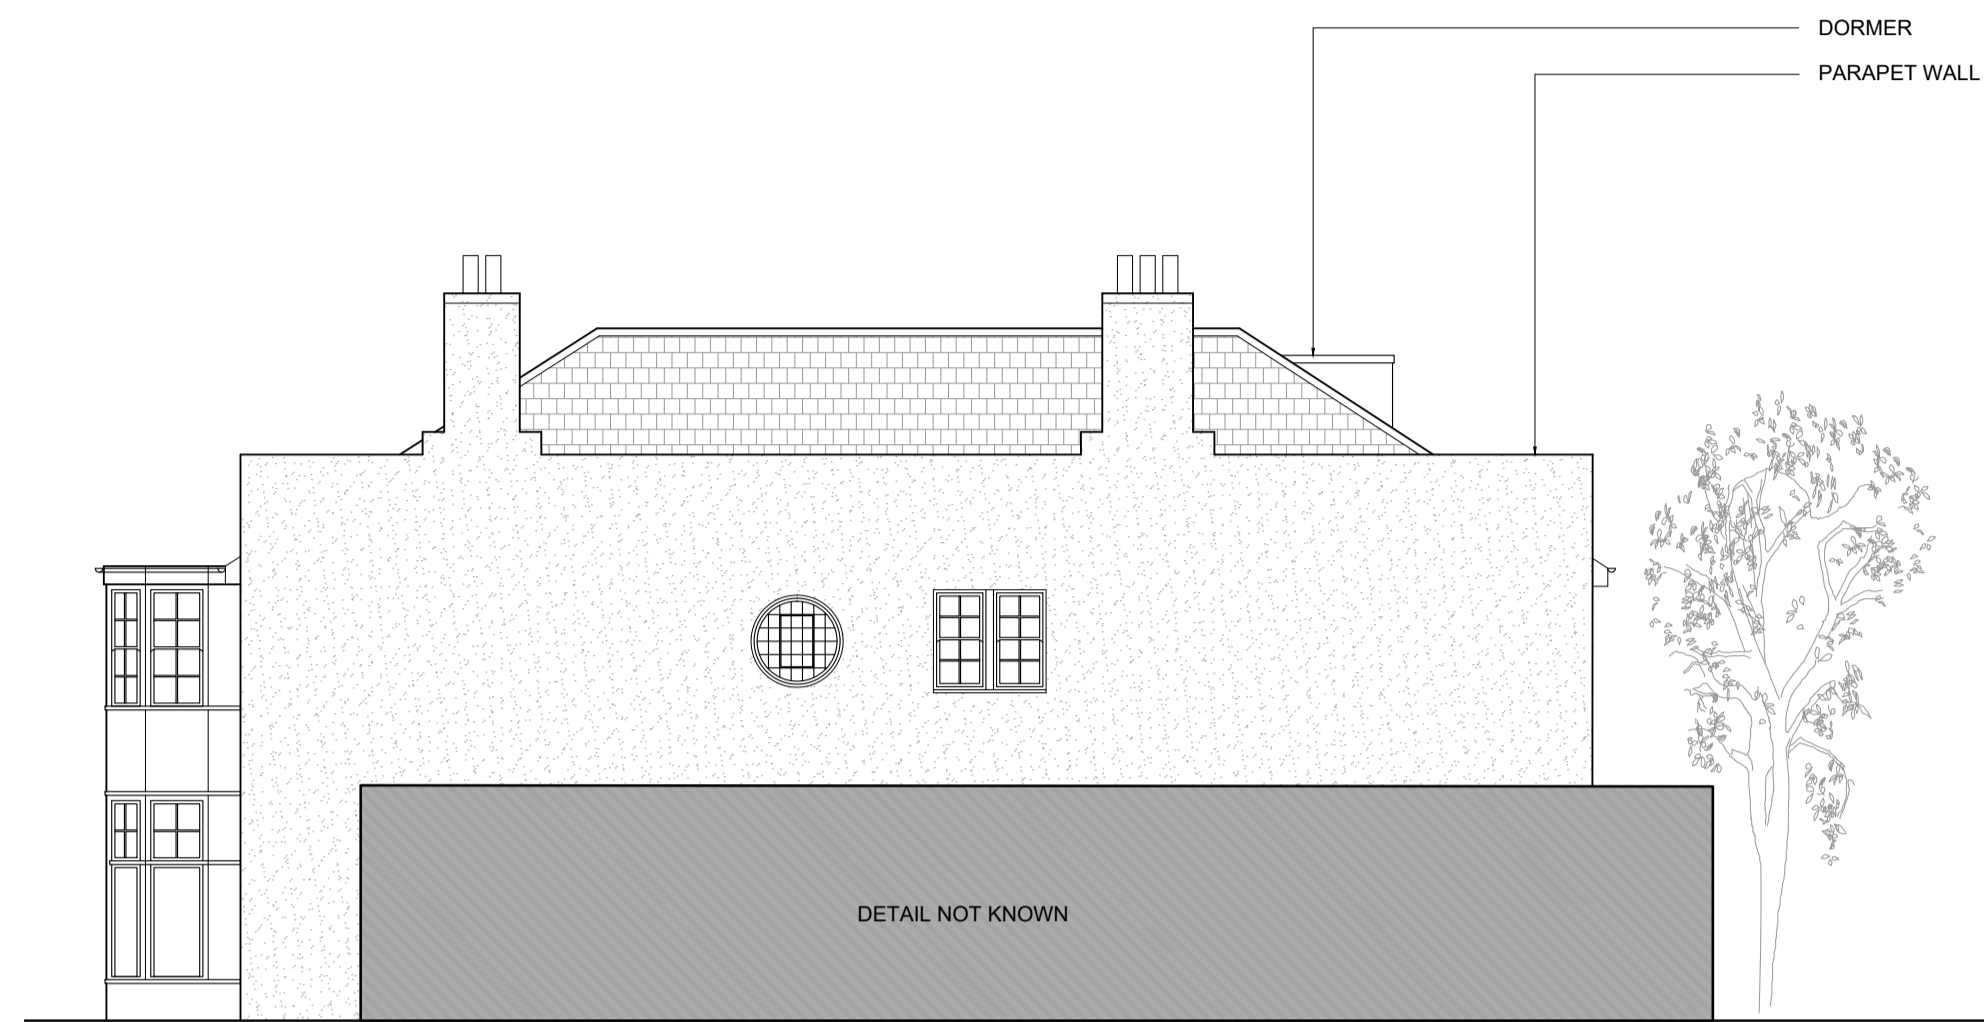


02 AS BUILT SIDE (EAST) ELEVATION
SCALE 1:100 @ A1

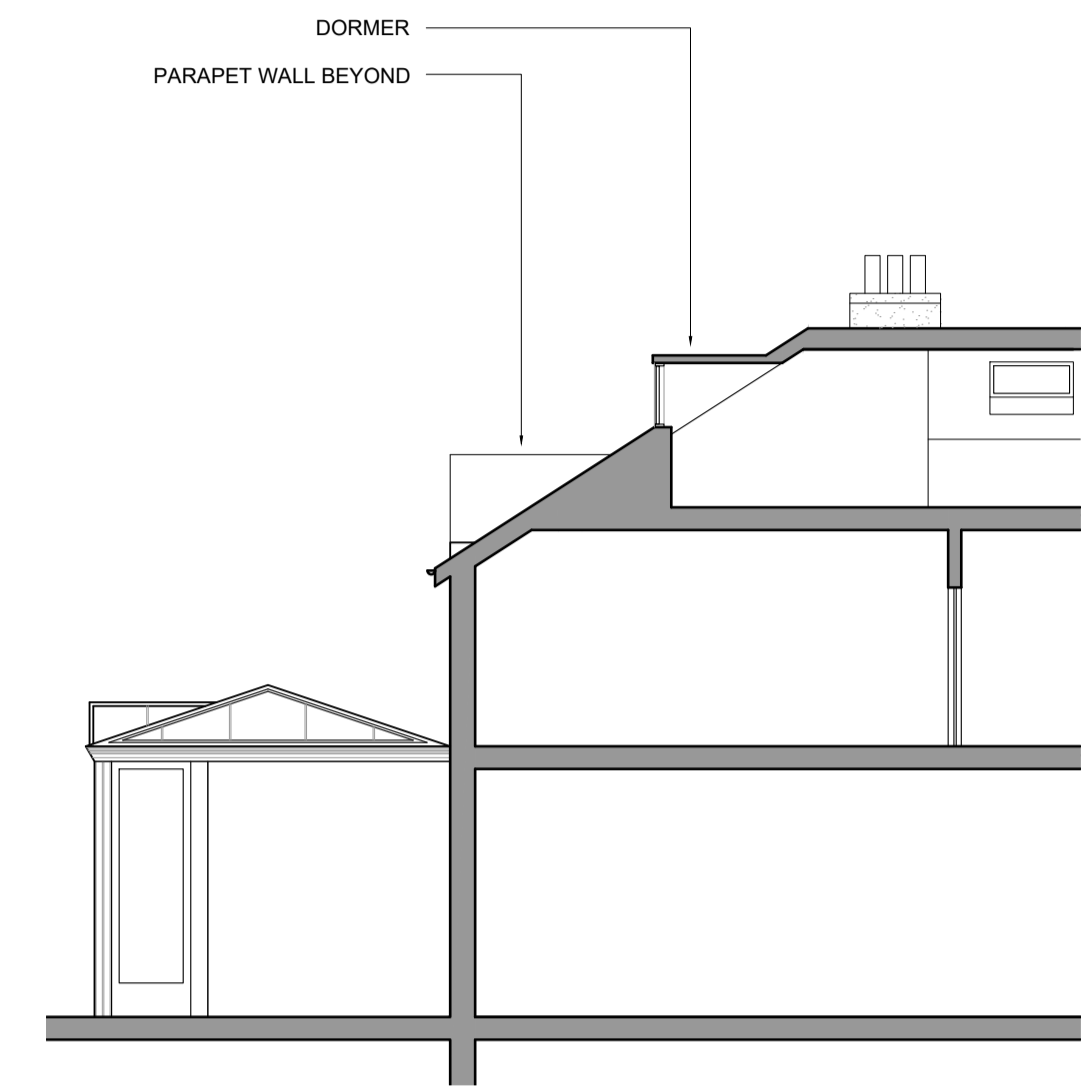

03 EXISTING PART-SECTION
SCALE 1:100 @ A1

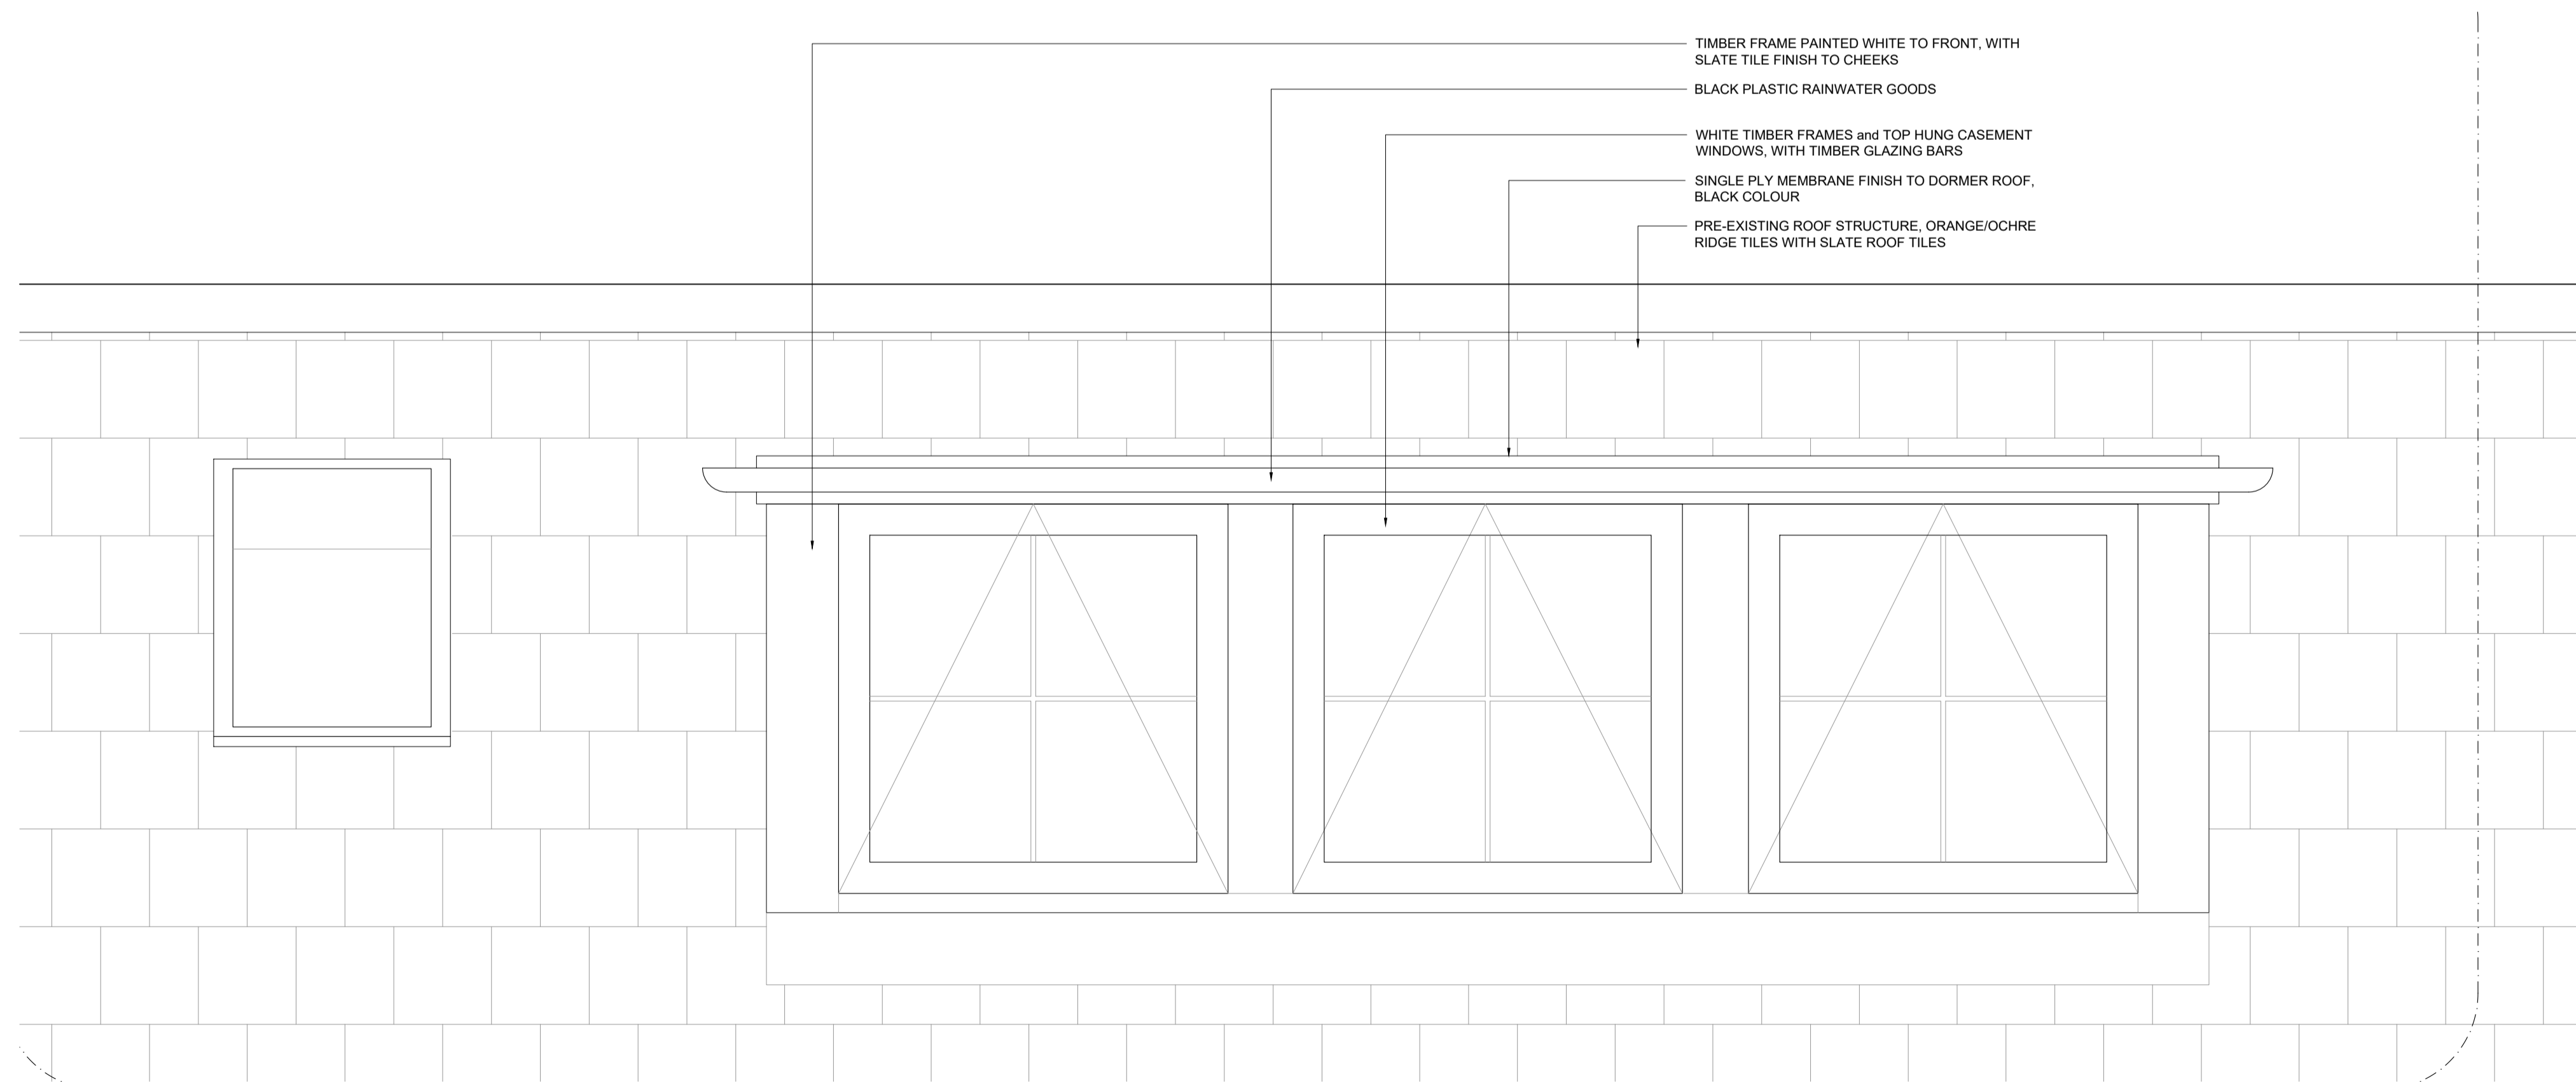

04 AS BUILT DORMER
SCALE 1:10 @ A1

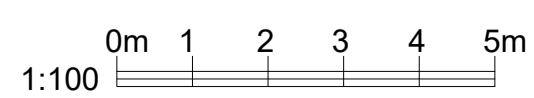

REV P1_02.02.25_PLANNING SUBMISSION

Project Ref. No. **2406**
 Client **FLORIAN LEONHARD**
 Date **FEBRUARY 2025**
 Scale **1:100 @ A1**
 Project **3 FROGNAL LANE LONDON NW3 7DY**

Drawing Name **PROPOSED ELEVATIONS & PART-SECTION**

Drawing No. **P211** Rev. **P1**
 Drawn **BR** Approved **AC** Signed

CARBOGNO ARCHITECTS
 48A ANTELL ROAD, LONDON N15 4BA TEL: +44 (0) 7860 586 884
 INFO@CARBOGNO.COM

© COPYRIGHT NOT TO BE REPRODUCED OR USED WITHOUT PERMISSION