



NOTES:

- UNLESS STATED OTHERWISE, ALL DIMENSIONS ARE IN MILLIMETERS.
- DO NOT SCALE FROM THIS DRAWING
- ALL SERVICE ROUTES AND EQUIPMENT LOCATIONS ARE INDICATIVE. ACTUAL LOCATIONS SHALL BE DETERMINED BY SITE DIMENSIONS.
- WHERE APPLICABLE, ALL DIMENSIONS SHALL BE CHECKED BY THE CONTRACTOR ON-SITE, PRIOR TO COMMENCEMENT OF ANY WORKS.
- THIS IS NOT A WORKING OR INSTALLATION DRAWING
- REQUIREMENTS OF THE HEALTH & SAFETY AT WORK ACT 1974 & SUBSEQUENT AMENDMENTS THERETO ARE BROUGHT TO THE ATTENTION OF ALL THOSE WHO DESIGN, INSTALL OR MAINTAIN PLANT AND EQUIPMENT SHOWN ON THESE DRAWINGS OR ARE REQUIRED TO ENTER AREAS SHOWN ON THESE DRAWINGS.
- ALL WORKS SHALL BE DESIGNED & INSTALLED IN FULL COMPLIANCE WITH THE APPROPRIATE EUROPEAN STANDARDS (BS EN) OR ALTERNATIVELY BRITISH STANDARDS (BS) IF A BS EN STANDARD DOES NOT EXIST FOR A SPECIFIC SYSTEM.
- THIS DRAWING IS PROVIDED TO INDICATE DESIGN INTENT FOR THE MECHANICAL SERVICES ARRANGEMENTS AND IS NOT TO BE USED AS A WORKING DRAWING. THE MECHANICAL CONTRACTOR SHALL BE RESPONSIBLE FOR THE DETAILED DESIGN & INSTALLATION OF THE COMPLETE MECHANICAL SERVICES & ANCILLARY SERVICES INSTALLATIONS AND SHALL INCORPORATE THE LATEST ARCHITECTURAL AND STRUCTURAL DESIGN INFORMATION. FOR INDIVIDUAL SYSTEM REQUIREMENTS, REFER TO THE MECHANICAL SERVICES SPECIFICATION.
- THIS DRAWING IS TO BE READ IN CONJUNCTION WITH ALL RELEVANT ARCHITECTS, CONSULTANTS AND PROJECT MANAGERS DRAWINGS, SPECIFICATIONS AND SCHEDULES. THIS SHALL INCLUDE, BUT NOT BE LIMITED TO, THE FOLLOWING:
 - MECHANICAL, ELECTRICAL & PUBLIC HEALTH SERVICES DRAWINGS
 - ENGINEERING SPECIFICATIONS
 - ARCHITECTURAL DRAWINGS & SPECIFICATIONS
 - STRUCTURAL ENGINEERING DRAWINGS & DOCUMENTATION
 - FIRE CONSULTANTS DRAWINGS & SPECIFICATIONS
 - MAIN CONTRACT PRELIMINARIES
 - PROJECT SPECIFIC DESIGNERS RISK ASSESSMENTS
 - ANY QUERIES RELATING TO SETTING OUT SHALL BE RAISED WITH THE PROJECT MANAGER.
- ANY AS INSTALLED INFORMATION AND FLOOR PLANS ISSUED TO THE CONTRACTOR MAY NOT BE FULLY UP TO DATE AND ACCURATE AND SHALL BE USED AS GUIDANCE ONLY.
- THE EXISTING INFORMATION CONTAINED ON THIS DRAWING HAS BEEN PRODUCED FROM A NON-DESTRUCTIVE VISUAL SURVEY AND RECORD DOCUMENTATION ONLY. IT IS THE CONTRACTOR'S RESPONSIBILITY TO VERIFY ALL INFORMATION PRIOR TO ANY SERVICES BEING ISOLATED AND STRIPPED OUT.
- THE CONTRACTOR IS TO MAKE REASONABLE ALLOWANCE TO ENSURE MECHANICAL SERVICES IN ALL AREAS OUTSIDE THE CONTRACTED AREA REMAIN LIVE AND FULLY OPERATIONAL DURING THE WORKS.
- THE MECHANICAL CONTRACTOR SHALL TAKE REASONABLE STEPS TO ENSURE THAT THE MECHANICAL INSTALLATION IS FULLY CO-ORDINATED WITH ELECTRICAL, PUBLIC HEALTH AND FIRE PROTECTION SERVICES INSTALLATION, WITH ALL OTHER CONTRACTOR SPECIALIST AND ALL OTHER TRADES.
- THE MECHANICAL CONTRACTOR WILL INCLUDE FOR THE PHASED WORKING ARRANGEMENTS AS DETAILED IN THE SPECIFICATION, ENSURING WHERE NECESSARY THE EXISTING AND NEW SYSTEMS OPERATE IN TANDEM UNTIL THE WORKS ARE COMPLETED. INCLUDE FOR RETURN VISITS TO PREVIOUSLY COMPLETED AREAS TO STRIP OUT ANY EXISTING SYSTEMS WHICH FINALLY BECOME REDUNDANT ON COMPLETION OF THE WORKS AND FOR ALL ASSOCIATED MAKING GOOD OF THE WORKS.
- FIRE PROTECTION TO BE PROVIDED WHEREVER A FIRE COMPARTMENT IS BROKEN AND SHALL BE SUITABLY FIRE STOPPED TO THE SAME STANDARD AS THE BARRIER/FLOOR/WALL BEING PENETRATED AND TO COMPLY WITH THE APPOINTED FIRE CONSULTANTS REQUIREMENTS.
- HOT WORKS PERMITS TO BE ARRANGED FOR SOLDERING ETC. WHERE REQUIRED.
- THE CONTRACTOR SHALL VALIDATE THE OPERATIONAL STATUS AND PERFORMANCE OF THE VENTILATION, HEATING, COOLING AND REFRIGERATION SYSTEMS WHICH WILL BE WORKED UPON.
- VALIDATE AIR VOLUMES DELIVERED TO THE ROOMS AT THE ENTRY TO THE ROOM AND ALL TERMINALS. VALIDATE THE AHU & FLOOR BRANCH DUCT AIR VOLUMES AND FAN PRESSURES WHERE ACCESSIBLE.
- TRACE THE CONTROLS WIRING AND VALIDATE THE PERFORMANCE OF ALL WALL & CEILING MOUNTED CONTROLLERS AND SENSORS DURING THE VALIDATION WORKS. CONFIRM WHAT EACH CONTROLLER AND SENSOR SERVES FOR SYSTEMS TO BE RETAINED AND THOSE FOR TO REMOVAL. PROVIDE MARKED UP DRAWINGS AND REPORT WITH FINDINGS.
- PROVIDE PHOTOGRAPHIC RECORD WHERE EXISTING SERVICES ARE IDENTIFIED TO HAVE DEFECTS WHICH REQUIRE RECTIFICATION.
- PROVIDE A PHOTOGRAPHIC RECORD AND REPORT OF THE ASSET NUMBERS / DETAILS FOR ALL ITEMS WHICH ARE DETAILED FOR REMOVAL AND ISSUE REPORT TO UCL.
- ALLOW FOR LTHW & CHW SYSTEM WATER SAMPLING AND CHEMICAL TESTING AND ISSUE OF REPORTS WITH 2ND SAMPLE POT ISSUED TO UCL FOR ALL SYSTEMS WHICH REQUIRE A DRAIN DOWN.
- MAIN CONTRACTOR TO PROVIDE ACCESS EQUIPMENT FOR HIGH LEVEL SERVICES ABOVE 3.0M.
- THE CONTRACTOR SHALL PROVIDE THE CLIENT WITH AN ELECTRONIC COPY OF THE OPERATIONAL AND MAINTENANCE MANUAL.

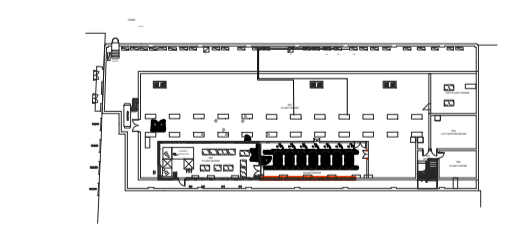

KEY PLAN - Not to Scale

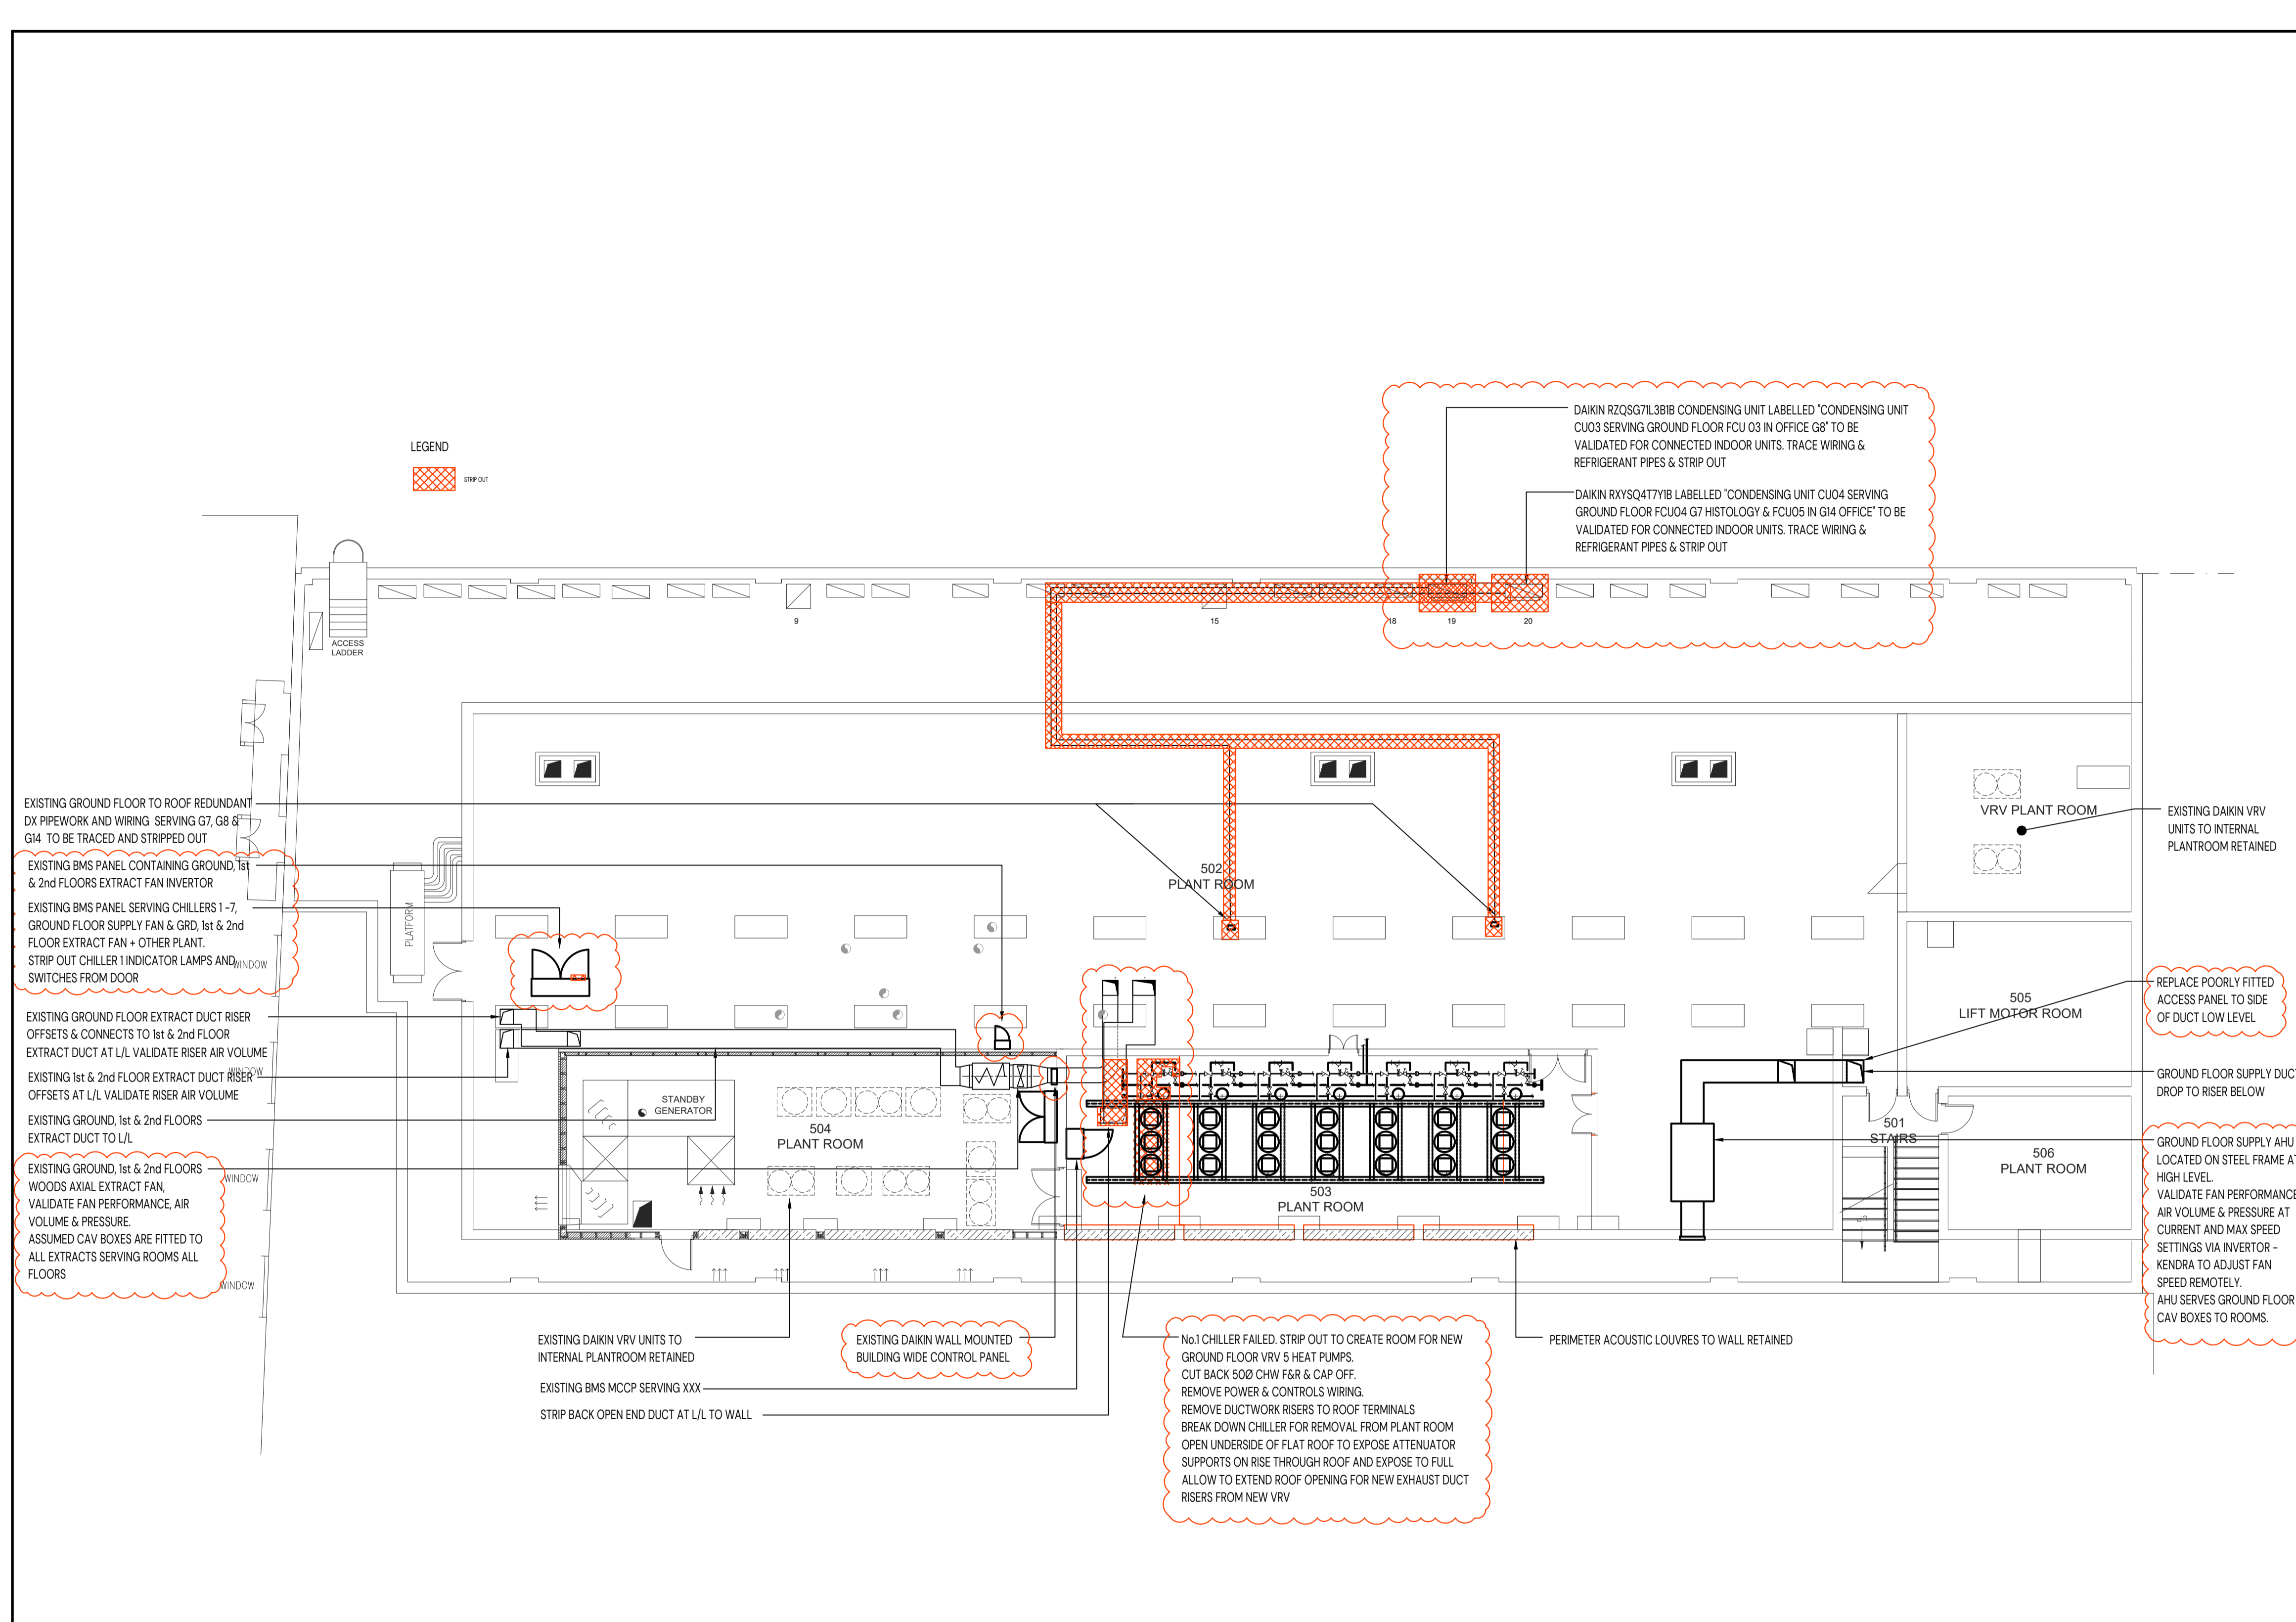

Suite 3, Sandford House,
1b Claremont Rd, Teddington, TW11 8DH

+44 (0)20 8943 5300
www.kendallkingscott.co.uk

Do not scale this drawing

Project	Life & Medical Sciences		
Client	UCL University College London		
Date	11/09/24	Success/Status	CONSTRUCTION
Scale	1:100	Drawn	KM
Checked	FM	Paper Size	ISO A1
Filename	240665 8046 C02		

Rev	Date	By	Ap	Note
C02	16/01/25	KM	FM	Construction Issue - Updated as clouded
C01	15/01/24	KM	FM	Construction Issue
P03	15/01/24	KM	FM	Contract Issue
P02	01/10/24	KM	FM	Tender Addendum Revised as clouded
P01	12/09/24	KM	FM	Tender Issue

Drawing Title
SW01 Raynes Institute Roof - Existing Mechanical Services

Project Number/Drawing Number
240665 8046

Revision
C02

© Copyright

Only to be used on the site for which designed. The electronic transmission of design information contained in this drawing is carried out entirely at the User's risk and Kendall Kingscott Ltd. will have no liability for any errors or inaccuracies arising therefrom. The production of amended or updated information from the said design information by the User is entirely the responsibility of the User and Kendall Kingscott Ltd. shall have no responsibility in respect thereof whatsoever.