



© Longlane Architects Ltd
 No part of this drawing may be reproduced without written consent.
 All contractors must visit site and be responsible for taking and checking all dimensions relating to this work.
 Do not scale from this drawing.


Rev	Description	Date
-----	-------------	------

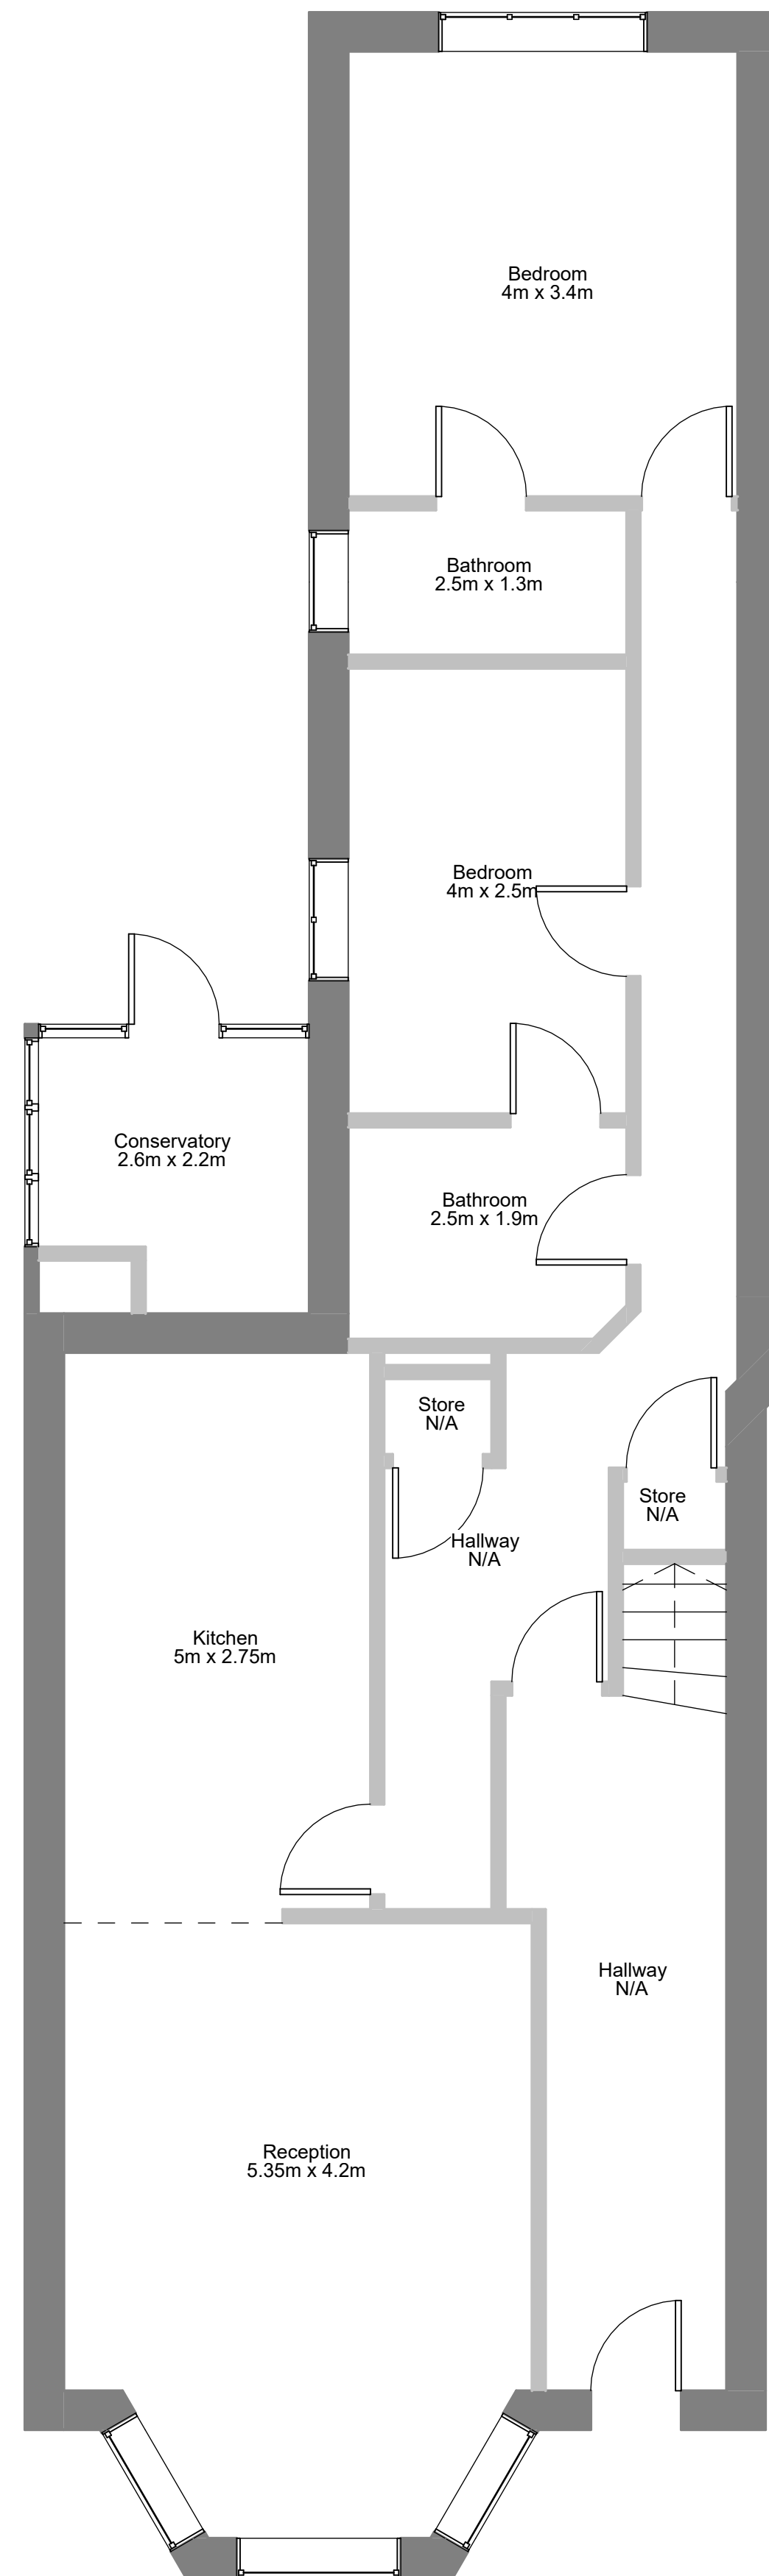

1 Ground Floor
1 : 50

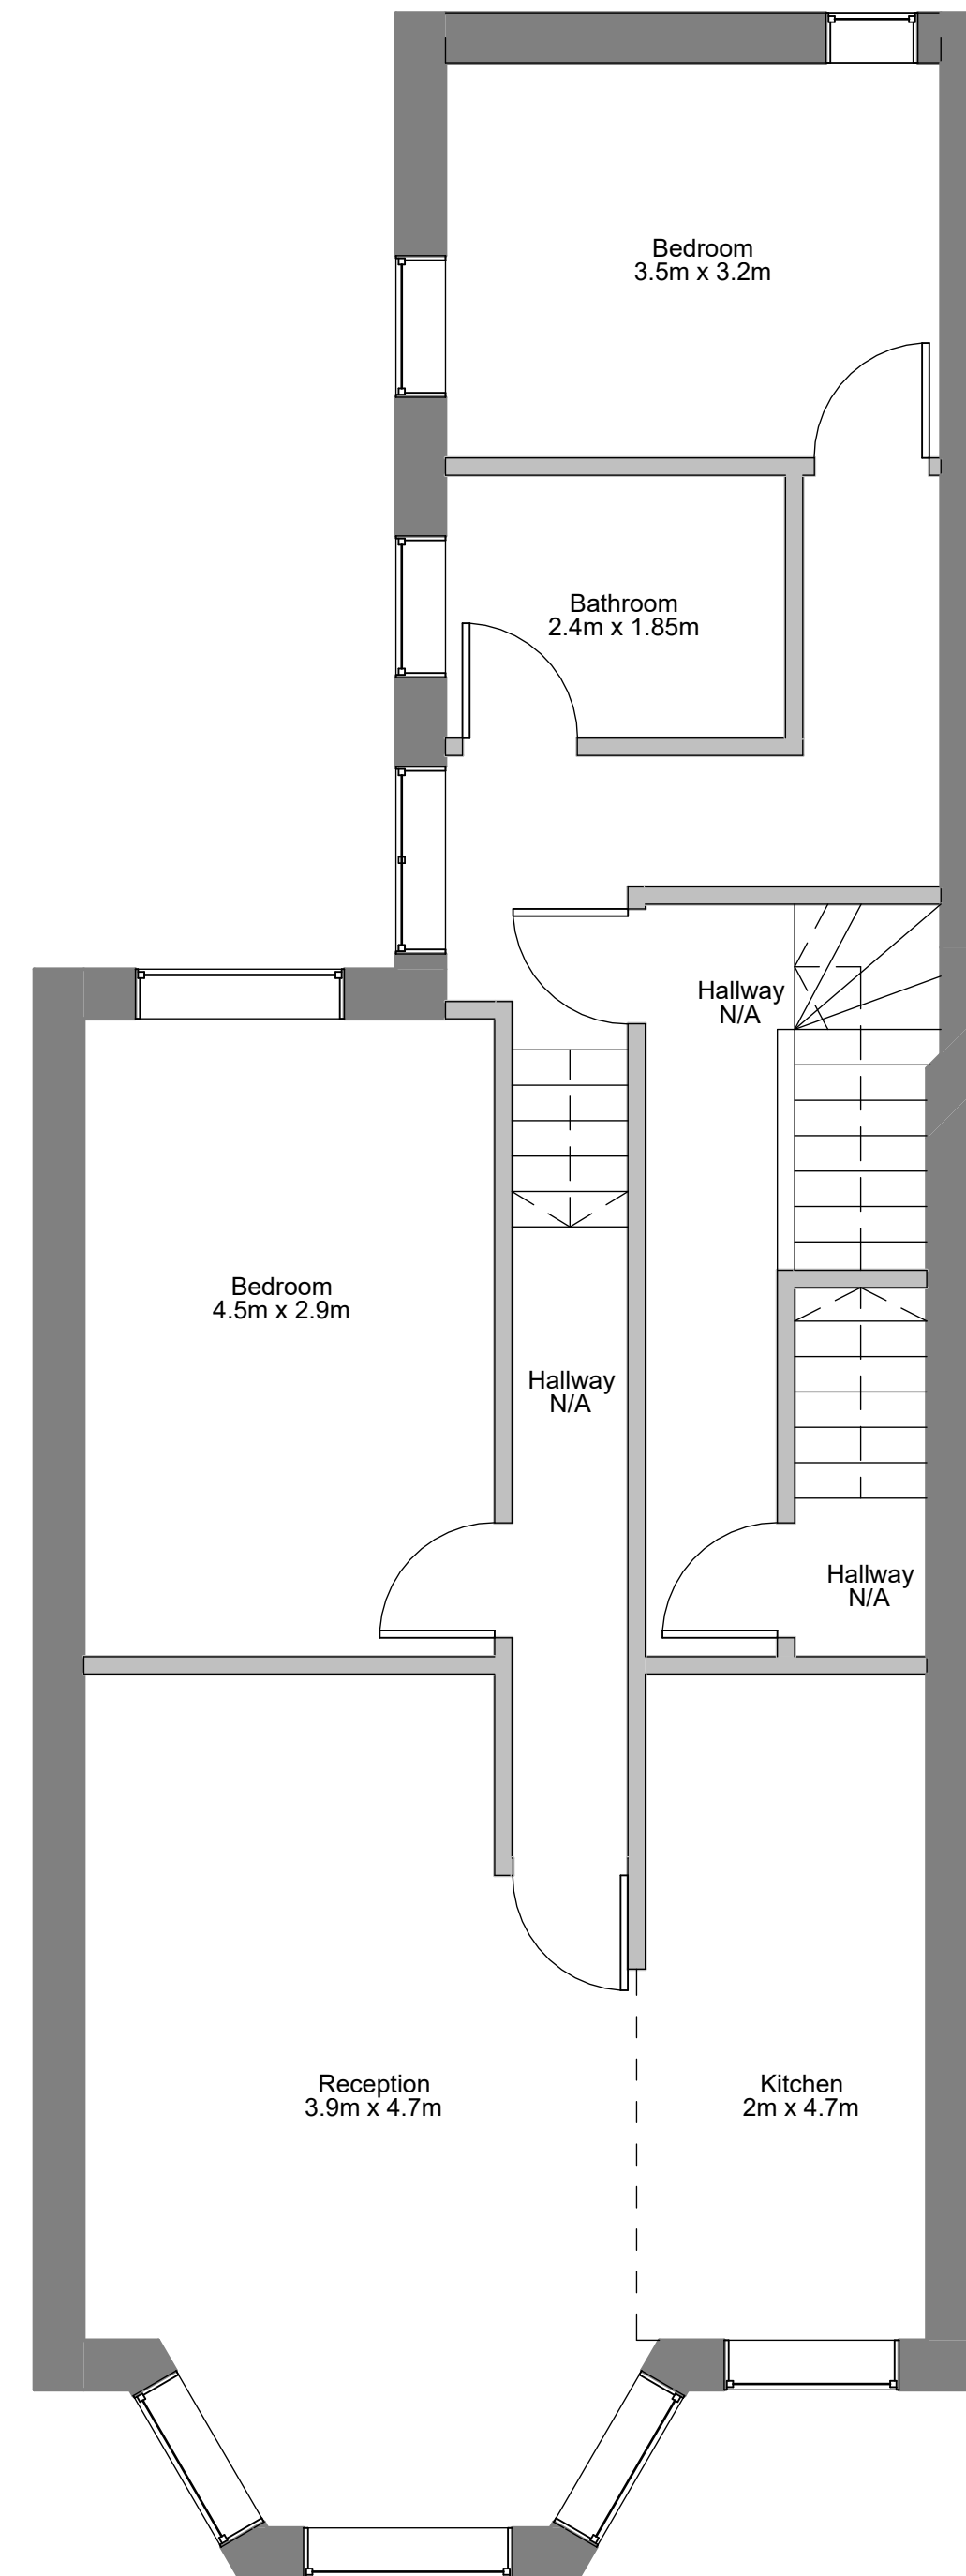

2 First Floor
1 : 50

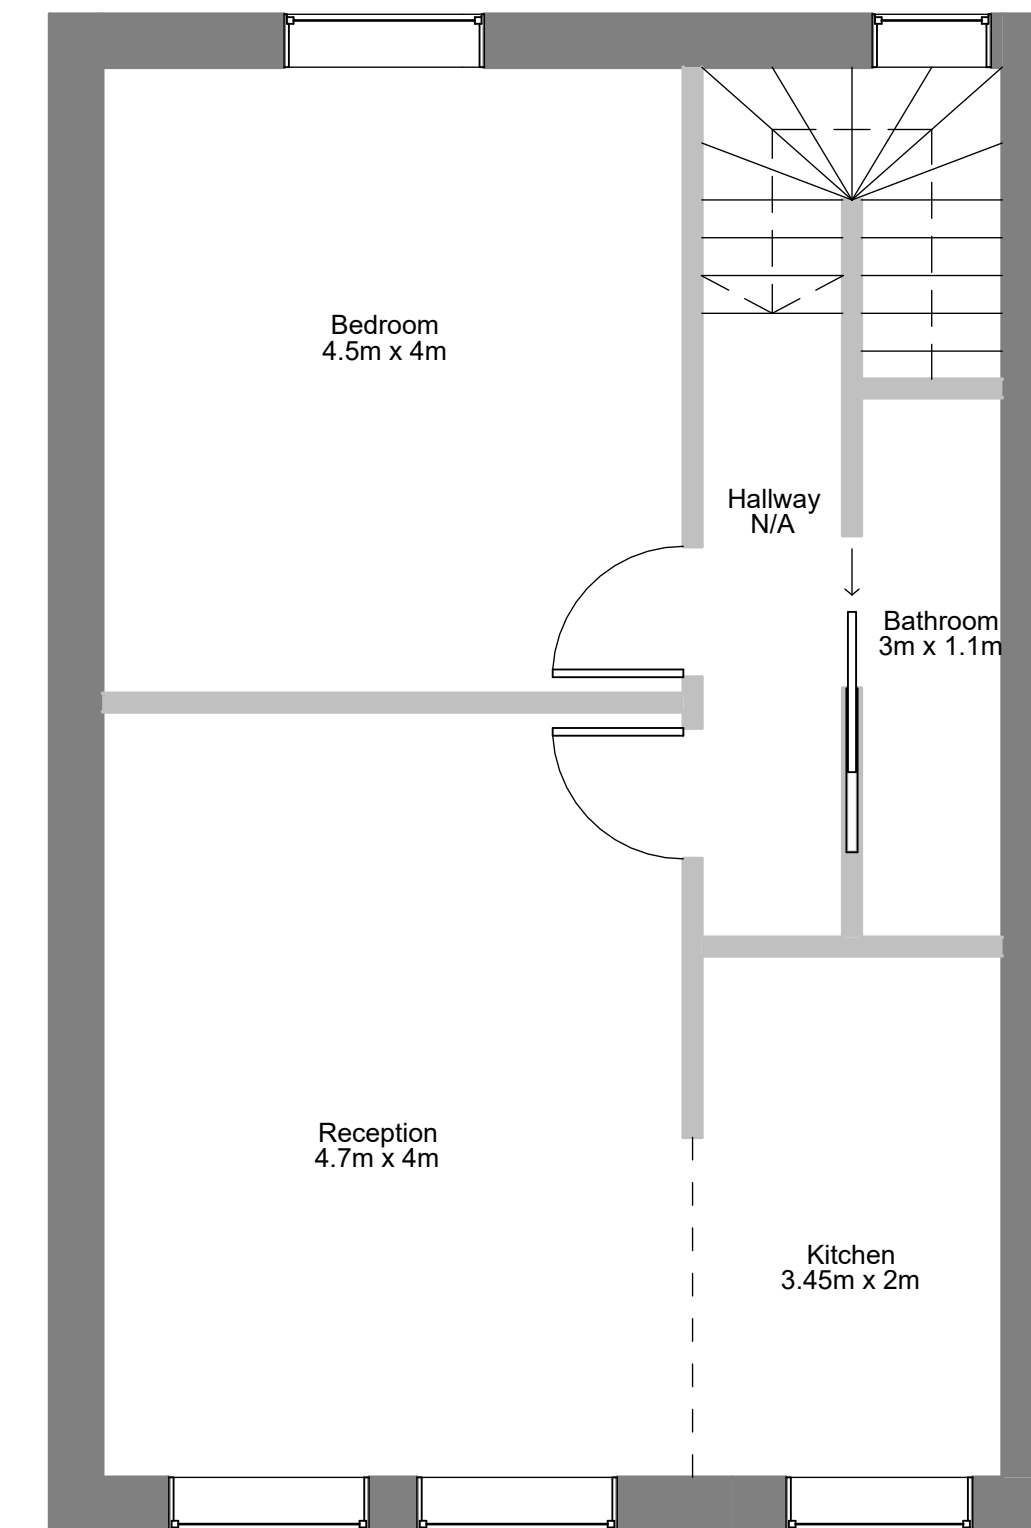

3 Second Floor
1 : 50

Longlane Architects Ltd
 Longlane Architects Ltd
 224 Long Lane
 London SE14 0GB
 info@longlanearchitects.co.uk

As Built			
PROJECT 23 Fordwych Road			
DRAWING TITLE As Built Floor Plans			
SCALE 1 : 50	DATE	BY WB	REVISION
DRAWING NUMBER 0000 - LLA - A - 03 - 1000			