



1 LOWER GROUND FLOOR LAYOUT
1:100 @ A2 IG

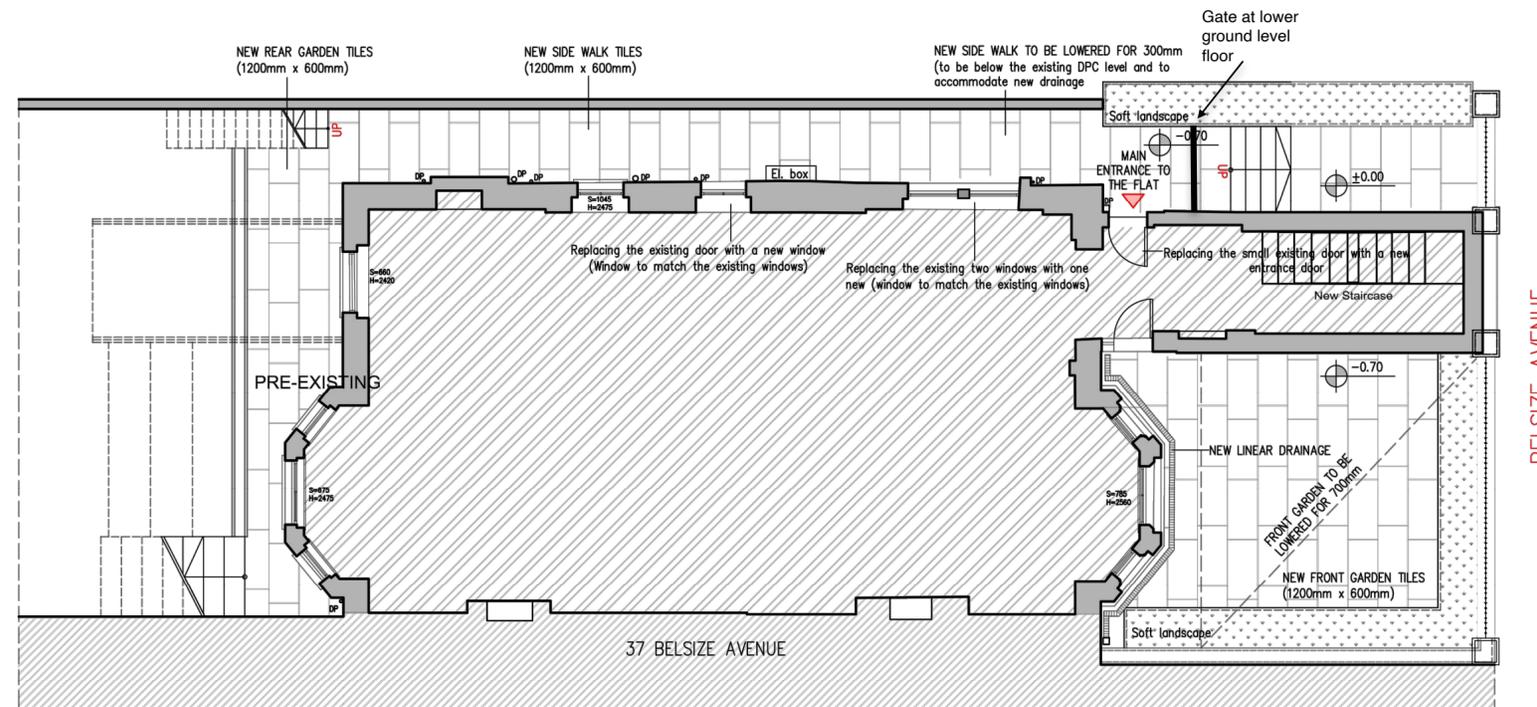

2 LOWER GROUND FLOOR LAYOUT
1:100 @ A2

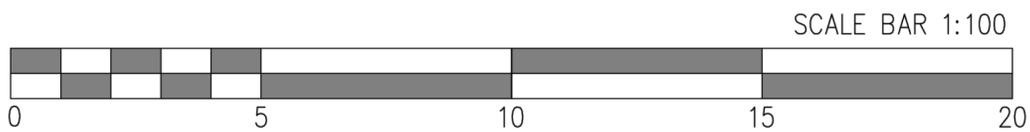

PROJECT:
Belsize Avenue, NW3 5AS London

DRAWING TITLE:
Lower Ground Floor Layout
Pre-Existing & As Built

DATE CREATED: 05/02/2025
SCALE: 1:100; A2