

King Henrys Road

97

raise existing party wall by 600mm

line of front wall of the permitted side glazed vestibule

side vestibule glazed roof extended rearwards to replace a permitted rooflight here

permitted rooflight shown dotted red

700

99

101

Site Plan

- Existing Walls
- Proposed/New Walls
- Existing Walls to be removed

Items different from the permitted drawings for Planning Application 2023/2649/P dated 29th May 2024 are clouded and noted in red

BROD WIGHT
Architects
8a Baynes Mews --- London --- NW3 5BH

Flat 1, 99 King Henry's Road
London NW3 3QX


www.brodwight.co.uk office@brodwight.co.uk
Tel 020 7722 0810 This drawing is copyright

Drawing Title:

Proposed Site Plan

Drawing Ref:
1133-AP3-01

Date February 2025 Scale 1:100@A3 / 1:50@A1

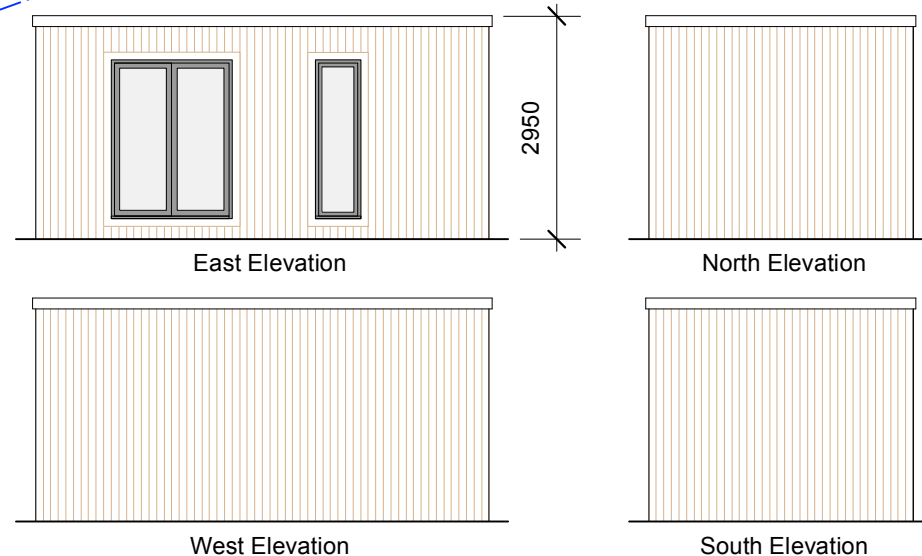

Elevations of Proposed Garden Office (NO CHANGES)

garden office on suspended galvanised steel frame base on micro-pile screw foundations- see arboricultural report ref: S1113-J1-R-1 for details relative to surrounding trees

T1 Sycamore

T3 Yew

T4 Lime

T5 Holly

remove existing timber deck here

remove holly

new trellis over existing fence to be 450mm high

trellis

trellis

lawn

patio sandstone

trellis

trellis

