
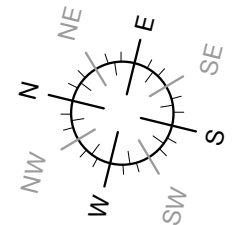


UPPER GROUND FLOOR FLAT - NOT PART OF THIS APPLICATION

101

Items different from the permitted drawings for Planning Application 2023/2649/P dated 29th May 2024 are clouded and noted in red

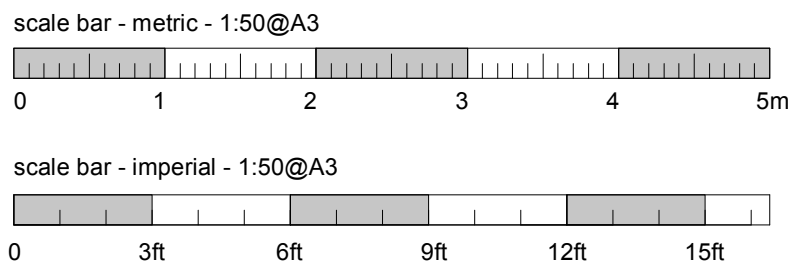

- Existing Walls
- Proposed/New Walls
- Existing Walls to be removed

BROD WIGHT
Architects
8a Baynes Mews --- London --- NW3 5BH

Flat 1, 99 King Henry's Road
London NW3 3QX

www.brodwight.co.uk office@brodwight.co.uk
Tel 020 7722 0810 This drawing is copyright

Drawing Title:
**Proposed Upper Ground Floor
Plan/Lower Ground Floor Roof**

Drawing Ref:
1133-AP3-03

Date February 2025 Scale 1:50@A3