





Proposed Front Elevation  
(NO CHANGES)

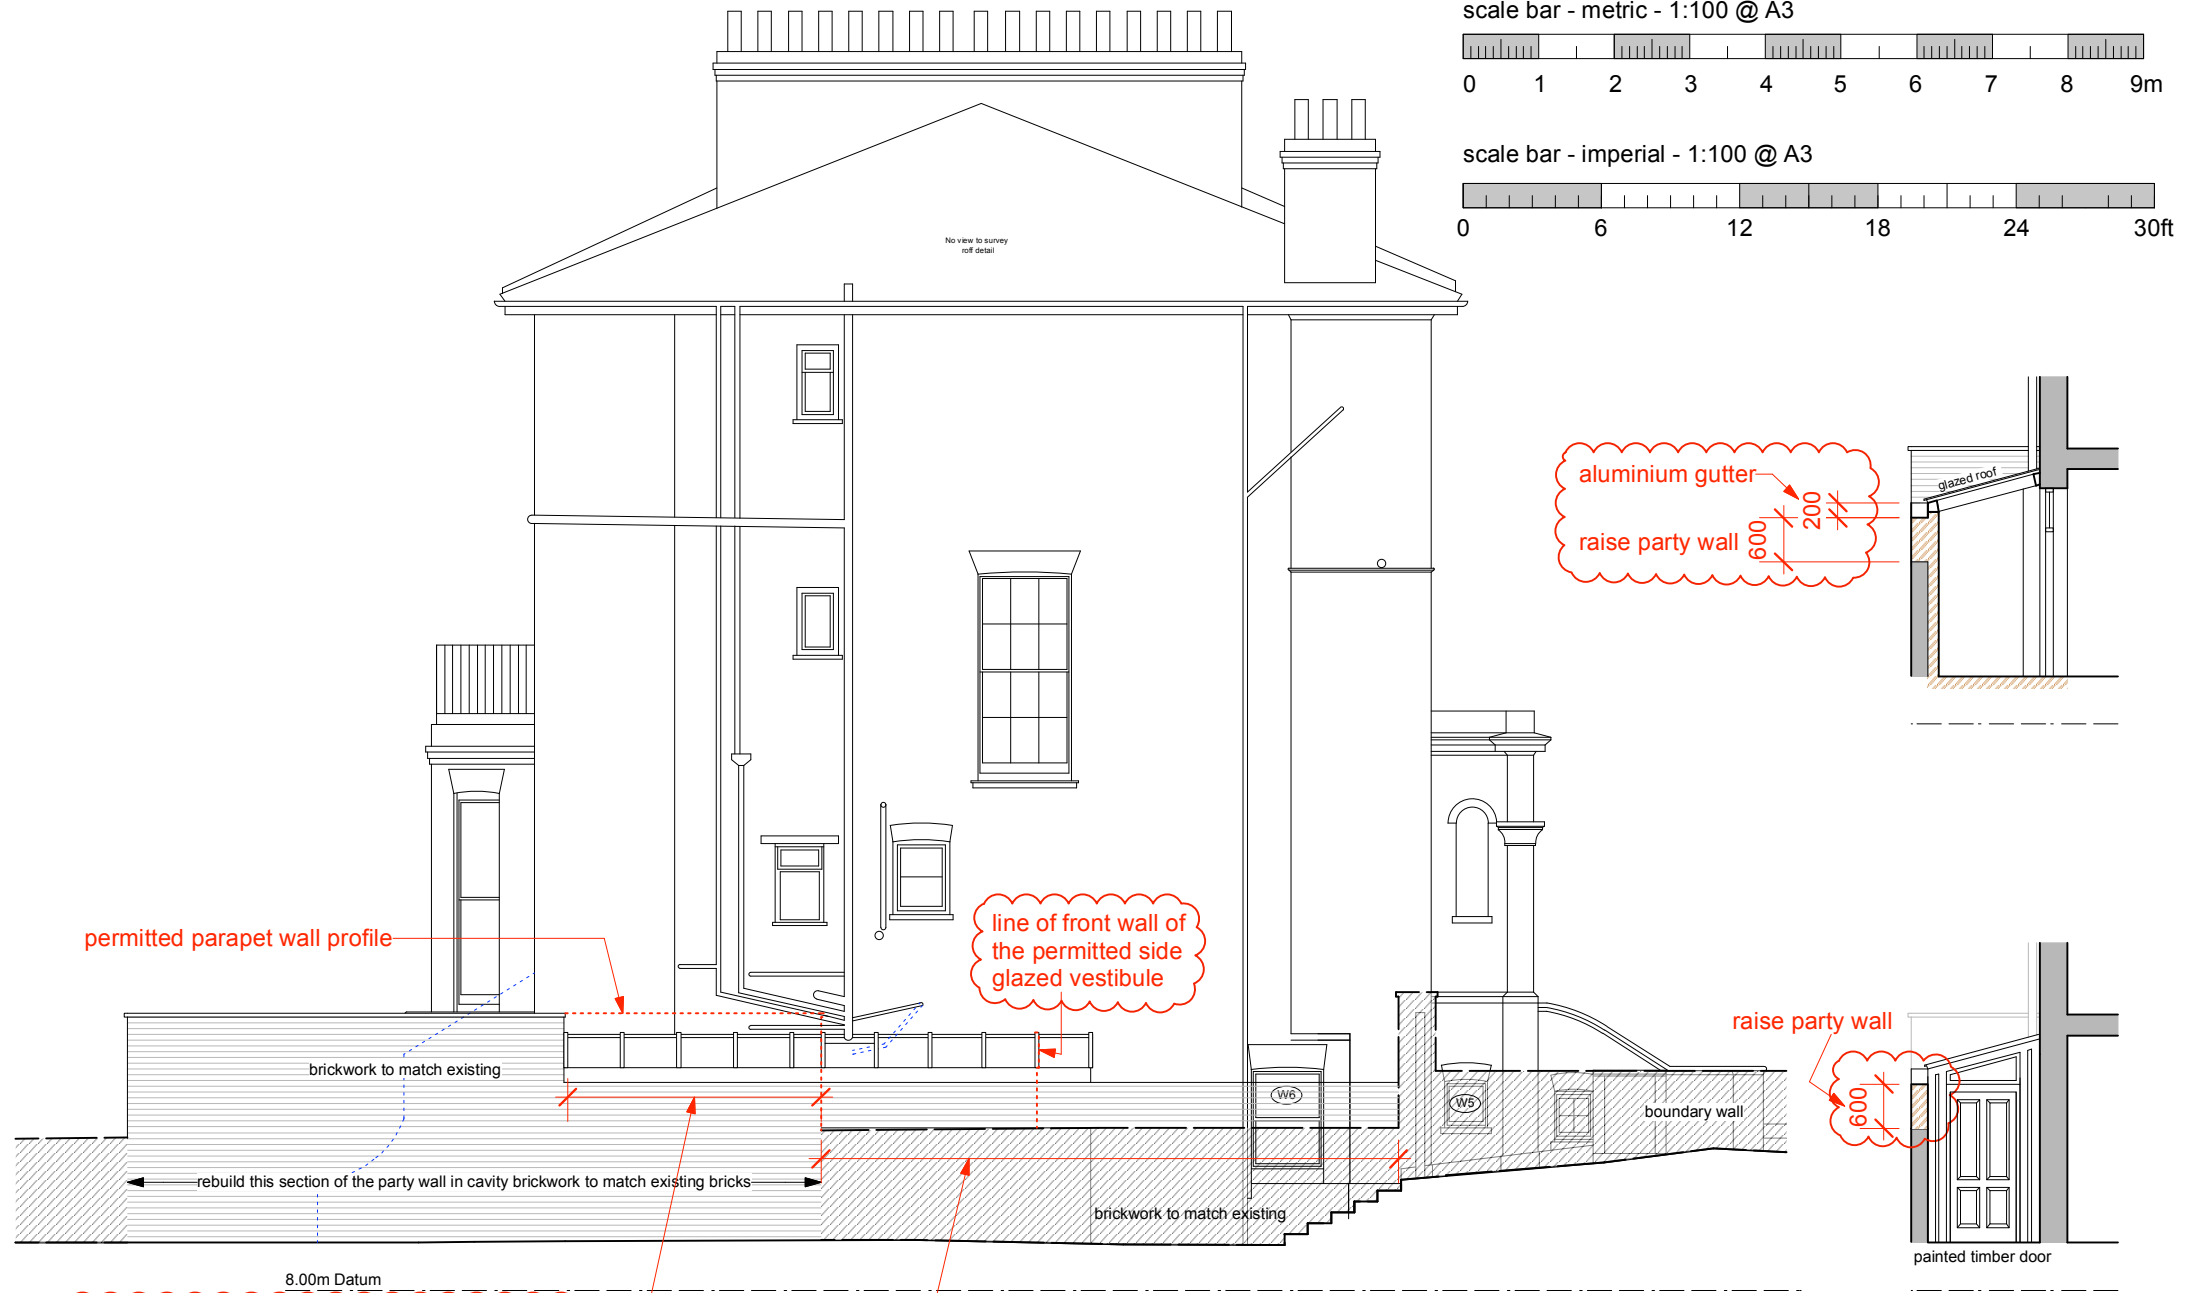

Proposed East Side Elevation

Proposed East Side Elevation

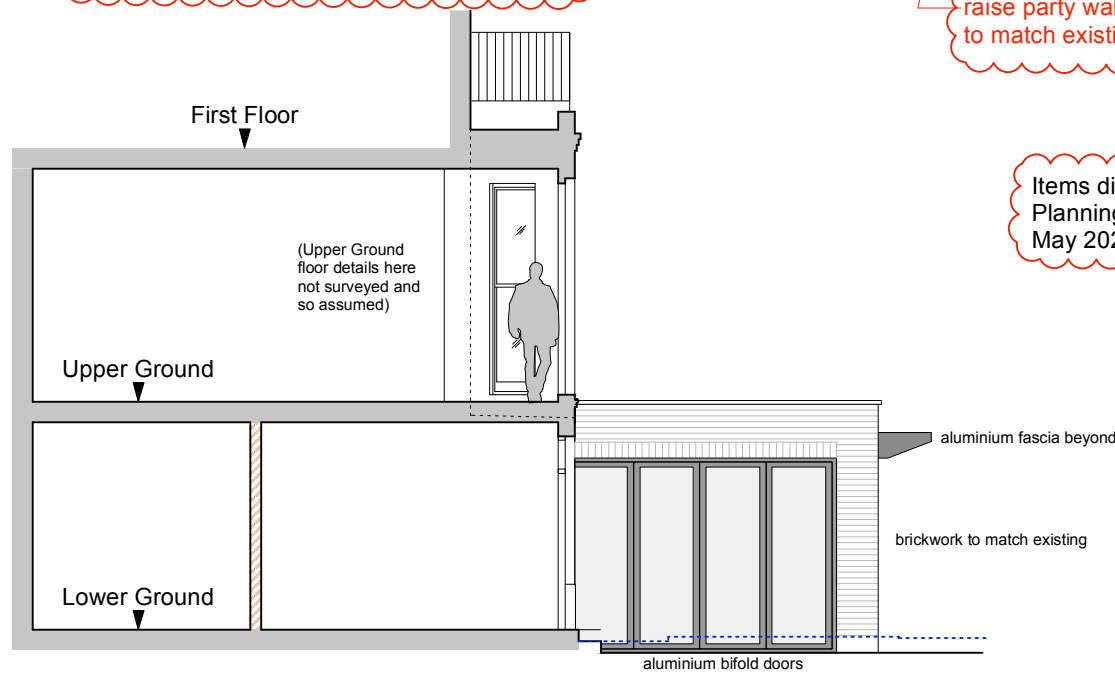

Proposed West Side Elevation  
(NO CHANGES)

Items different from the permitted drawings for  
Planning Application 2023/2649/P dated 29th  
May 2024 are clouded and noted in red

Existing Walls	
Proposed/New Walls	
Existing Walls to be removed	

**BROD WIGHT**  
**Architects**  
8a Baynes Mews --- London --- NW3 5BH

Flat 1, 99 King Henry's Road  
London NW3 3QX

www.brodwight.co.uk office@brodwight.co.uk  
Tel 020 7722 0810 This drawing is copyright

Drawing Title:  
**Proposed Front and Side  
Elevations**

Drawing Ref:  
**1133-AP3-04**

Date February 2025 Scale 1:100@A3 / 1:50@A1