



THE CONTRACTOR IS TO CHECK ALL DIMENSIONS AND NOTIFY THE ARCHITECT OF ANY DISCREPANCIES OR OMISSIONS.


© Copyright of Angus Brown Architects

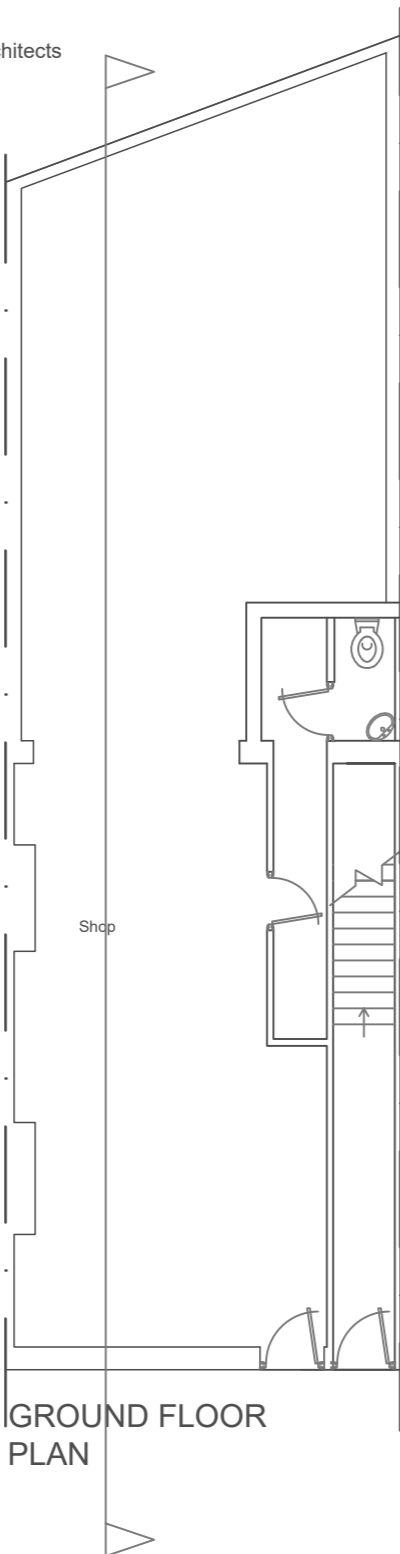


GROUND FLOOR PLAN

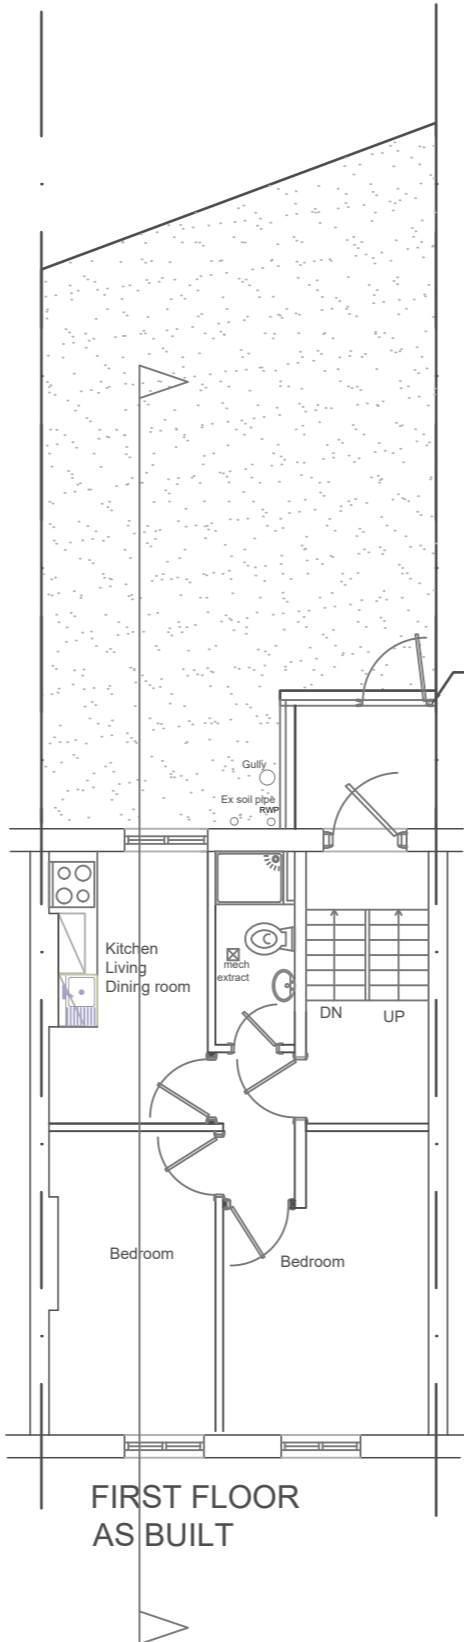


FIRST FLOOR AS BUILT

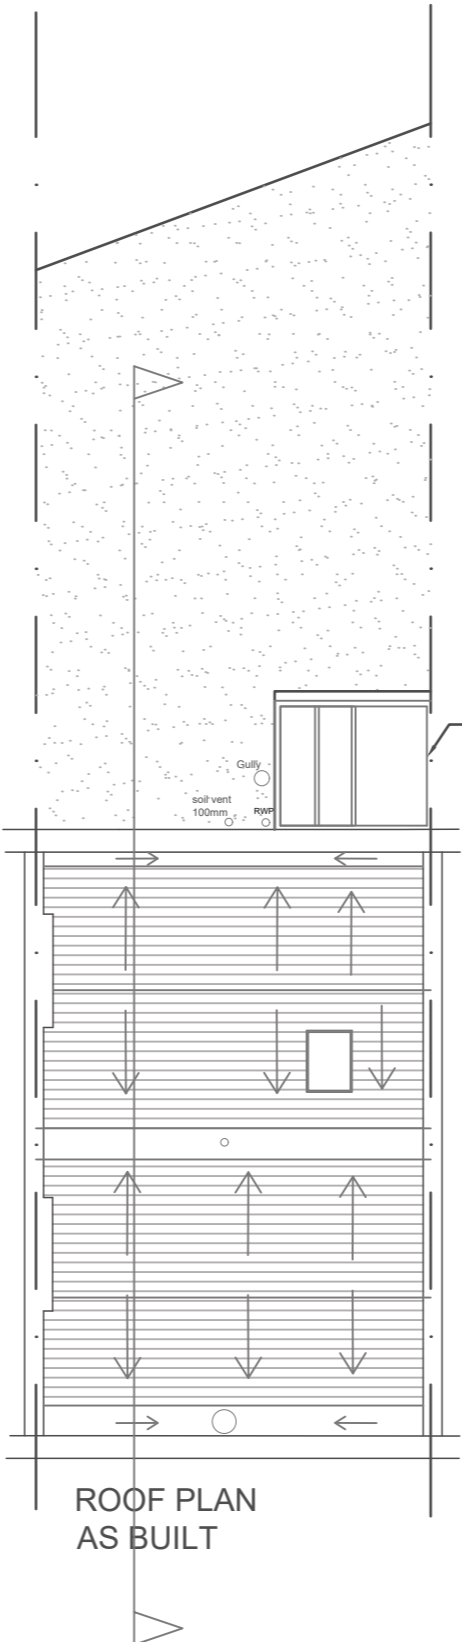

ROOF PLAN AS BUILT

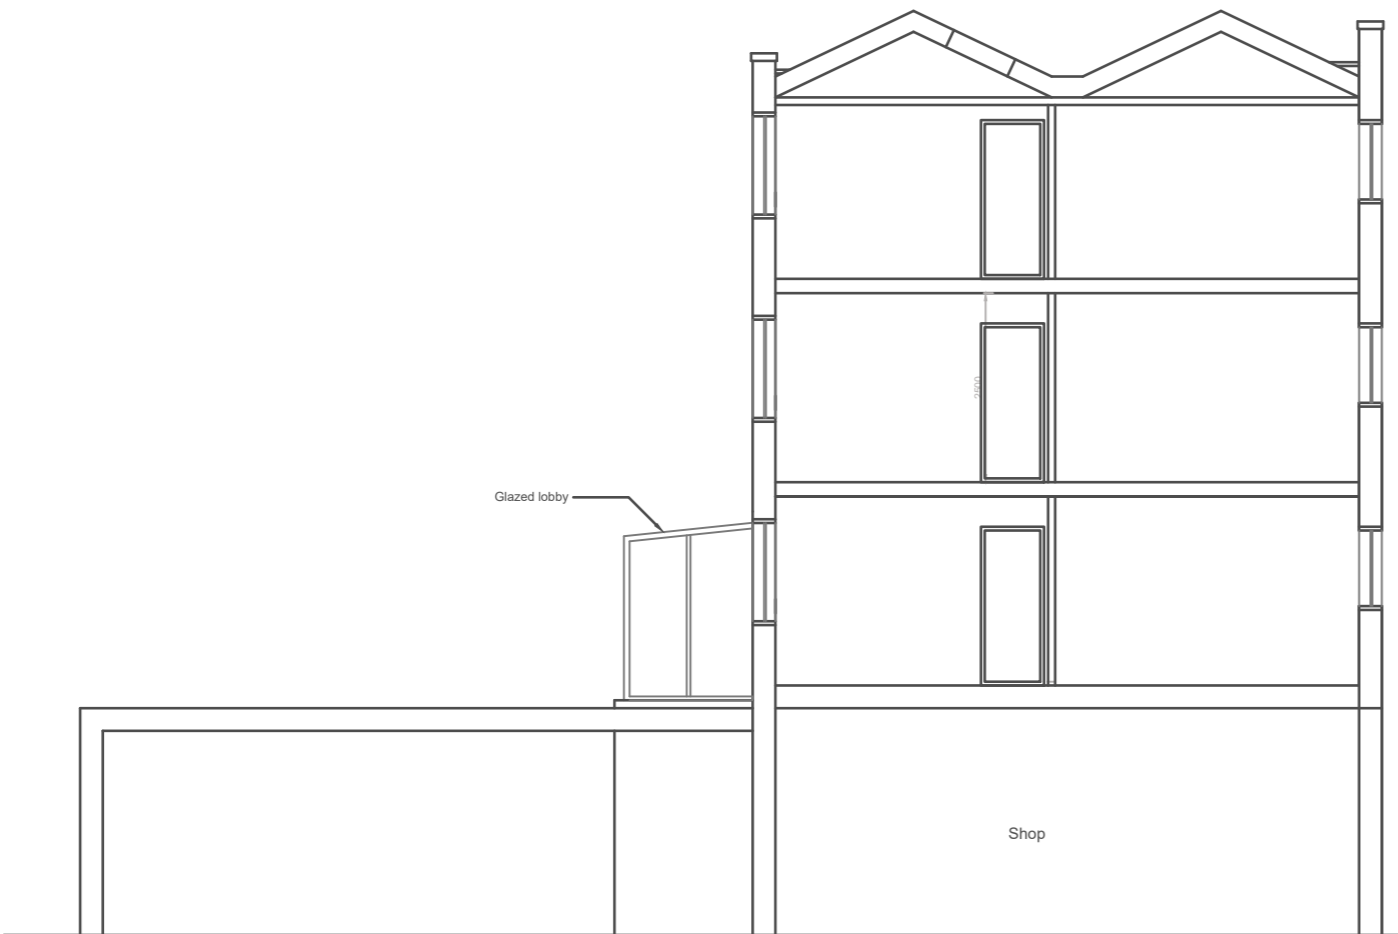

SIDE ELEVATION/SECTION AS BUILT

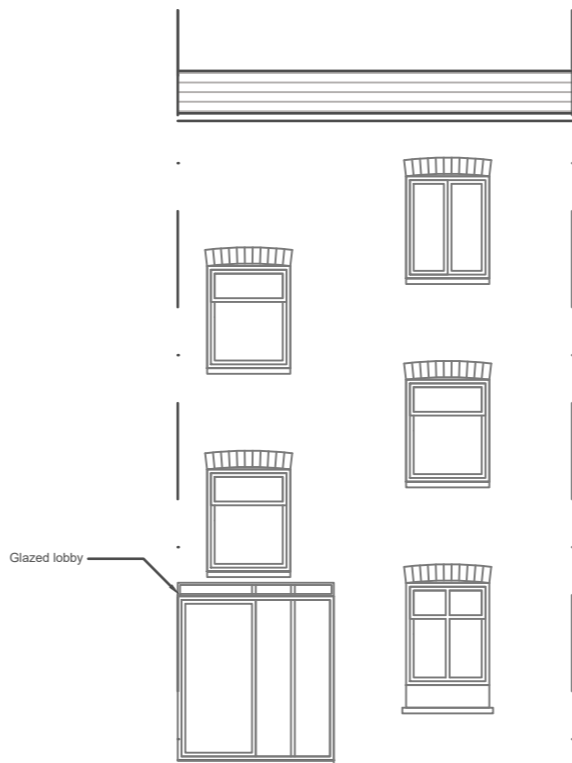

REAR ELEVATION AS BUILT

1:100 Scale



Notes

Revisions

ABA DESIGNS

59 PLAINS OF WATERLOO, RAMSGATE KENT CT11 8JE
Telephone: 07802635938
23 FIRST CROSS ROAD TWICKENHAM MIDDXX TW2 5QA
Telephone: 0208 898 6402
e-mail: enquiries@abadesigns.co.uk
Company number: 15583089

Title
PLANS, ELEVATION AND SECTION AS BUILT

Client
DURSUN

Project
PROPOSED REAR EXTENSION
160 AGAR GROVE
LONDON
NW1 9TY

Drawing Number
2504/PL/02

Scale at A2 1:100	Date FEB 2025	Revision
Drawn TK	Checked RMA	