


56

58

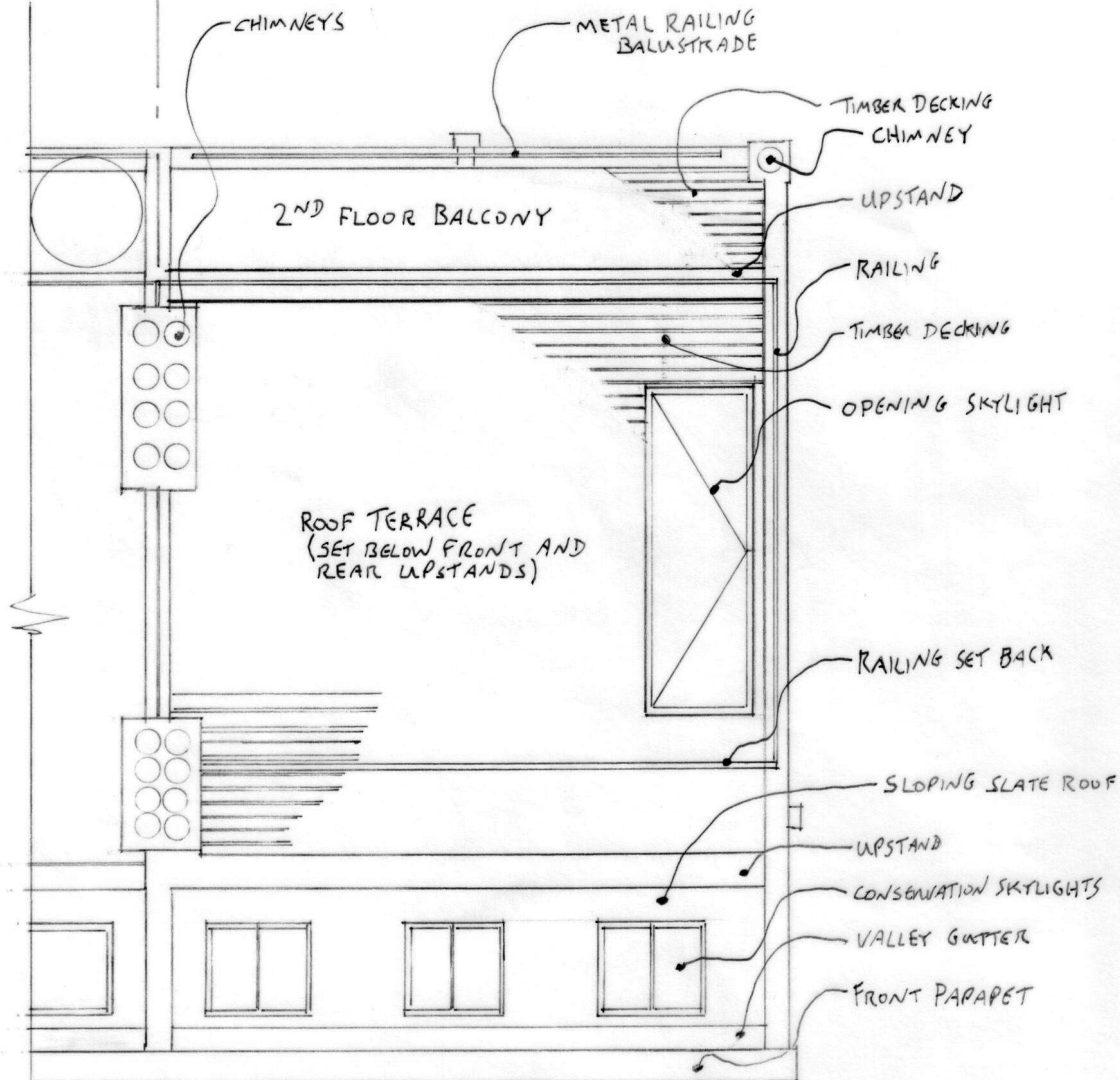


FRONT

AS BUILT ROOF PLAN

Drawing 001

58 SOUTH HILL PARK NW3 2SJ

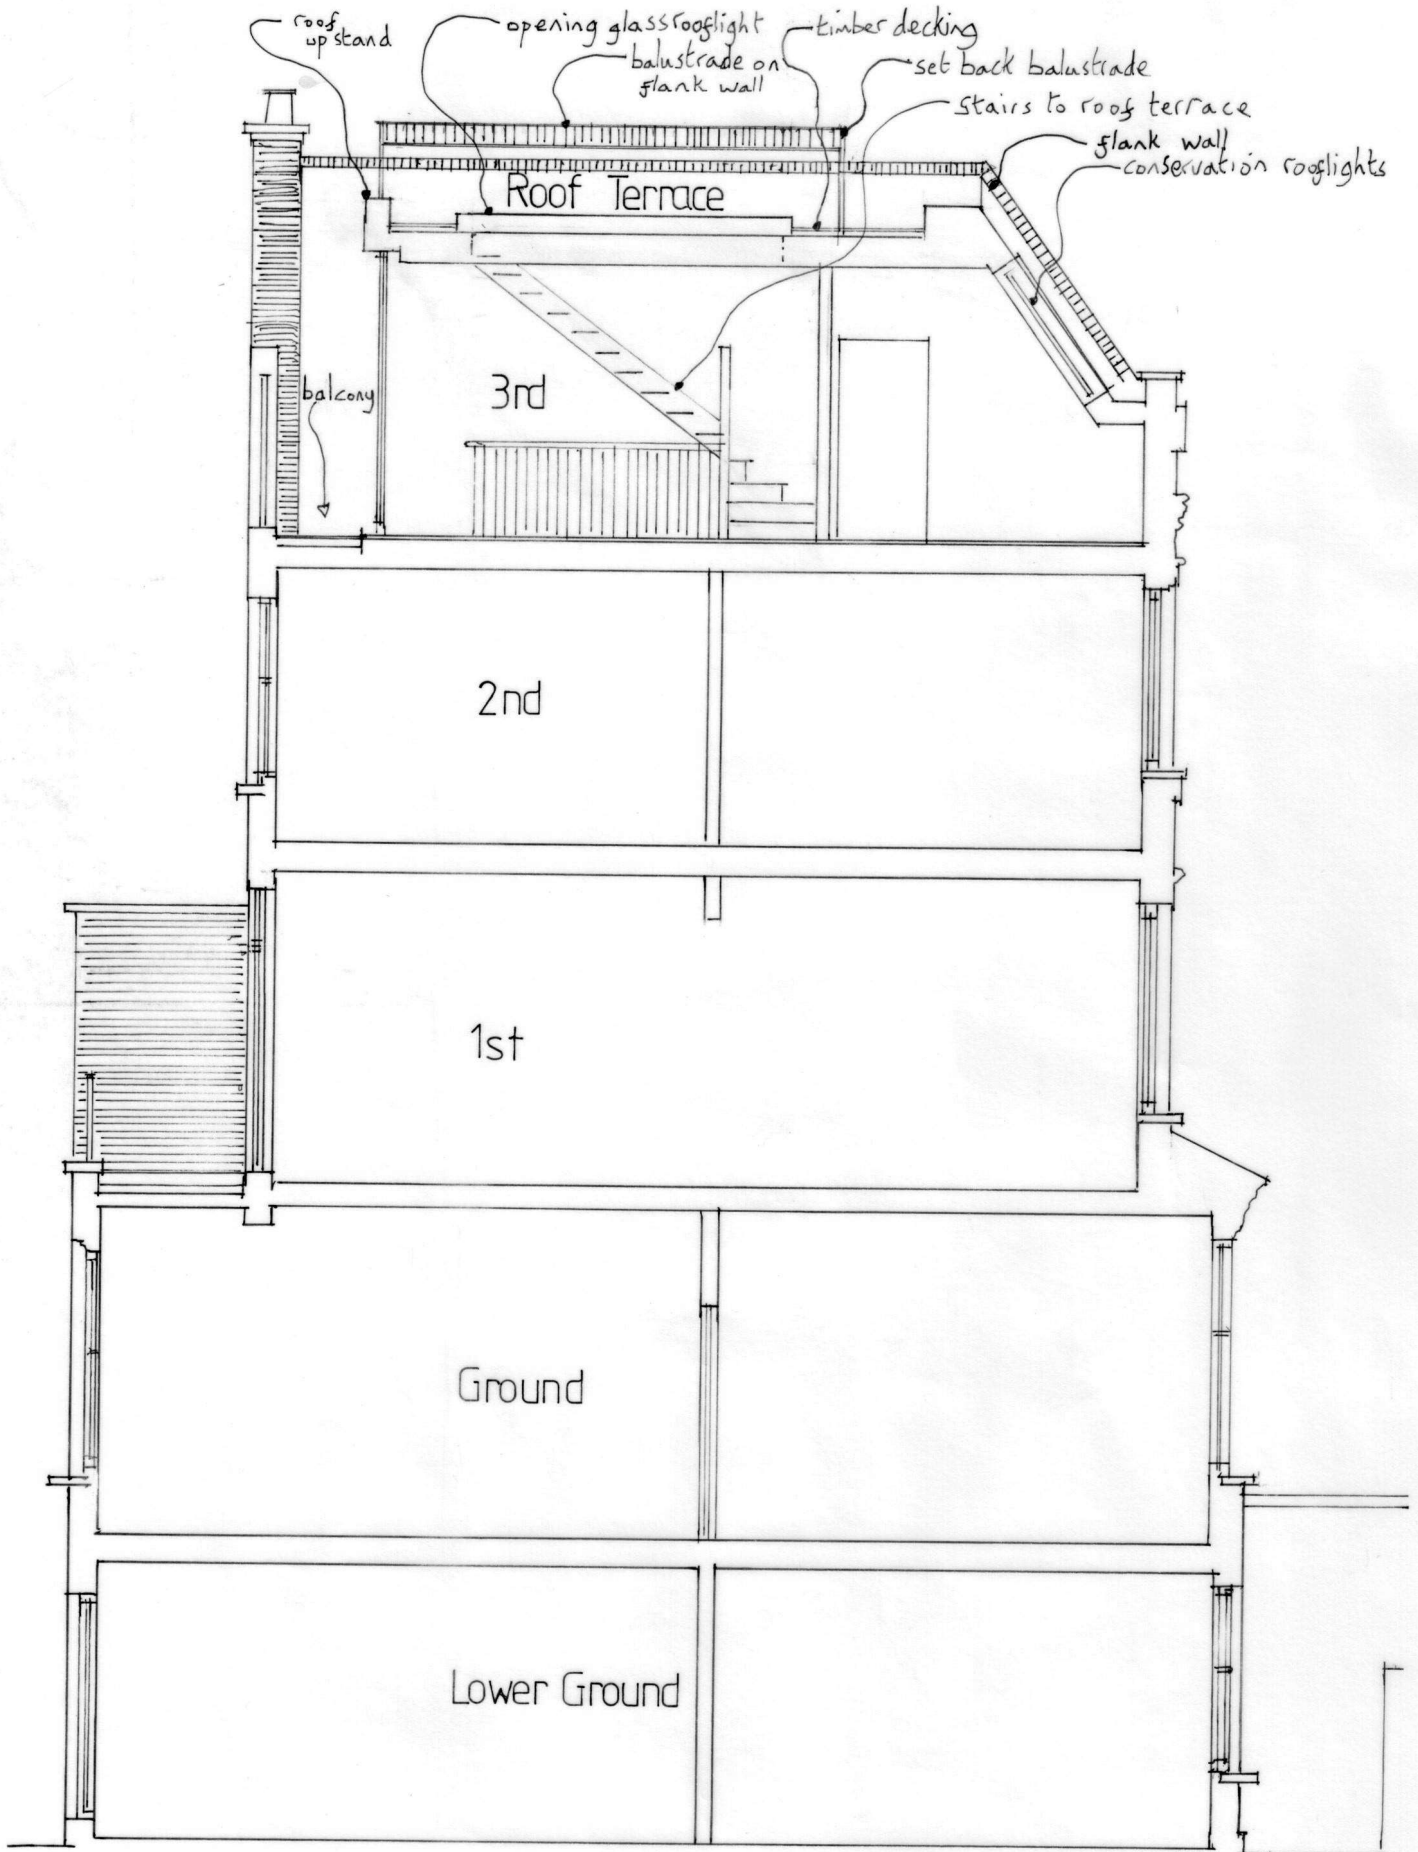

58 SOUTH HILL PARK  
LONDON NW3 2SJ

Section A-A  
Drawing 002

56

58

CONSERVATION  
ROOFLIGHTS

METAL RAILINGS  
SET BACK

METAL RAILINGS

CHIMNEY POTS

PIPE

ROOFING FELT

BRICKWORK

ROOF LIGHT

ROOF LIGHT

SLOPING  
SLATE  
ROOF

BRICKWORK

SWP

BRICKWORK

WINDOW

BRICKWORK

WINDOW

ALARM

BRICKWORK

WINDOW

RWP

RWP

LIGHT

TIMBER  
DOOR

PHONE  
POINT

BRICKWORK

BRICKWORK

WINDOW

A/C

BRICKWORK

BRICKWORK

REAR ELEVATION

FRONT ELEVATION

Drawing 003

58

METAL RAILINGS  
SET BACK

56

METAL RAILINGS

SPIRAL STAIR CASE

TIMBER

DOOR

RAILINGS

RAILINGS

DOOR

BRICKWORK

BRICKWORK

RWP

RWP

UNABLE TO VIEW

RAILINGS

DOOR

VENT

BRICKWORK

VENT

BRICKWORK

ALARM

VEGETATION

PRESUMED  
EDGE  
OF WINDOW

RWP

BRICKWORK

DOOR

RAILINGS

SWP

DOOR

LEAD ROOF

TIMBER

DOOR

DOOR

BRICK WALL

# REAR ELEVATION

Drawing 004