


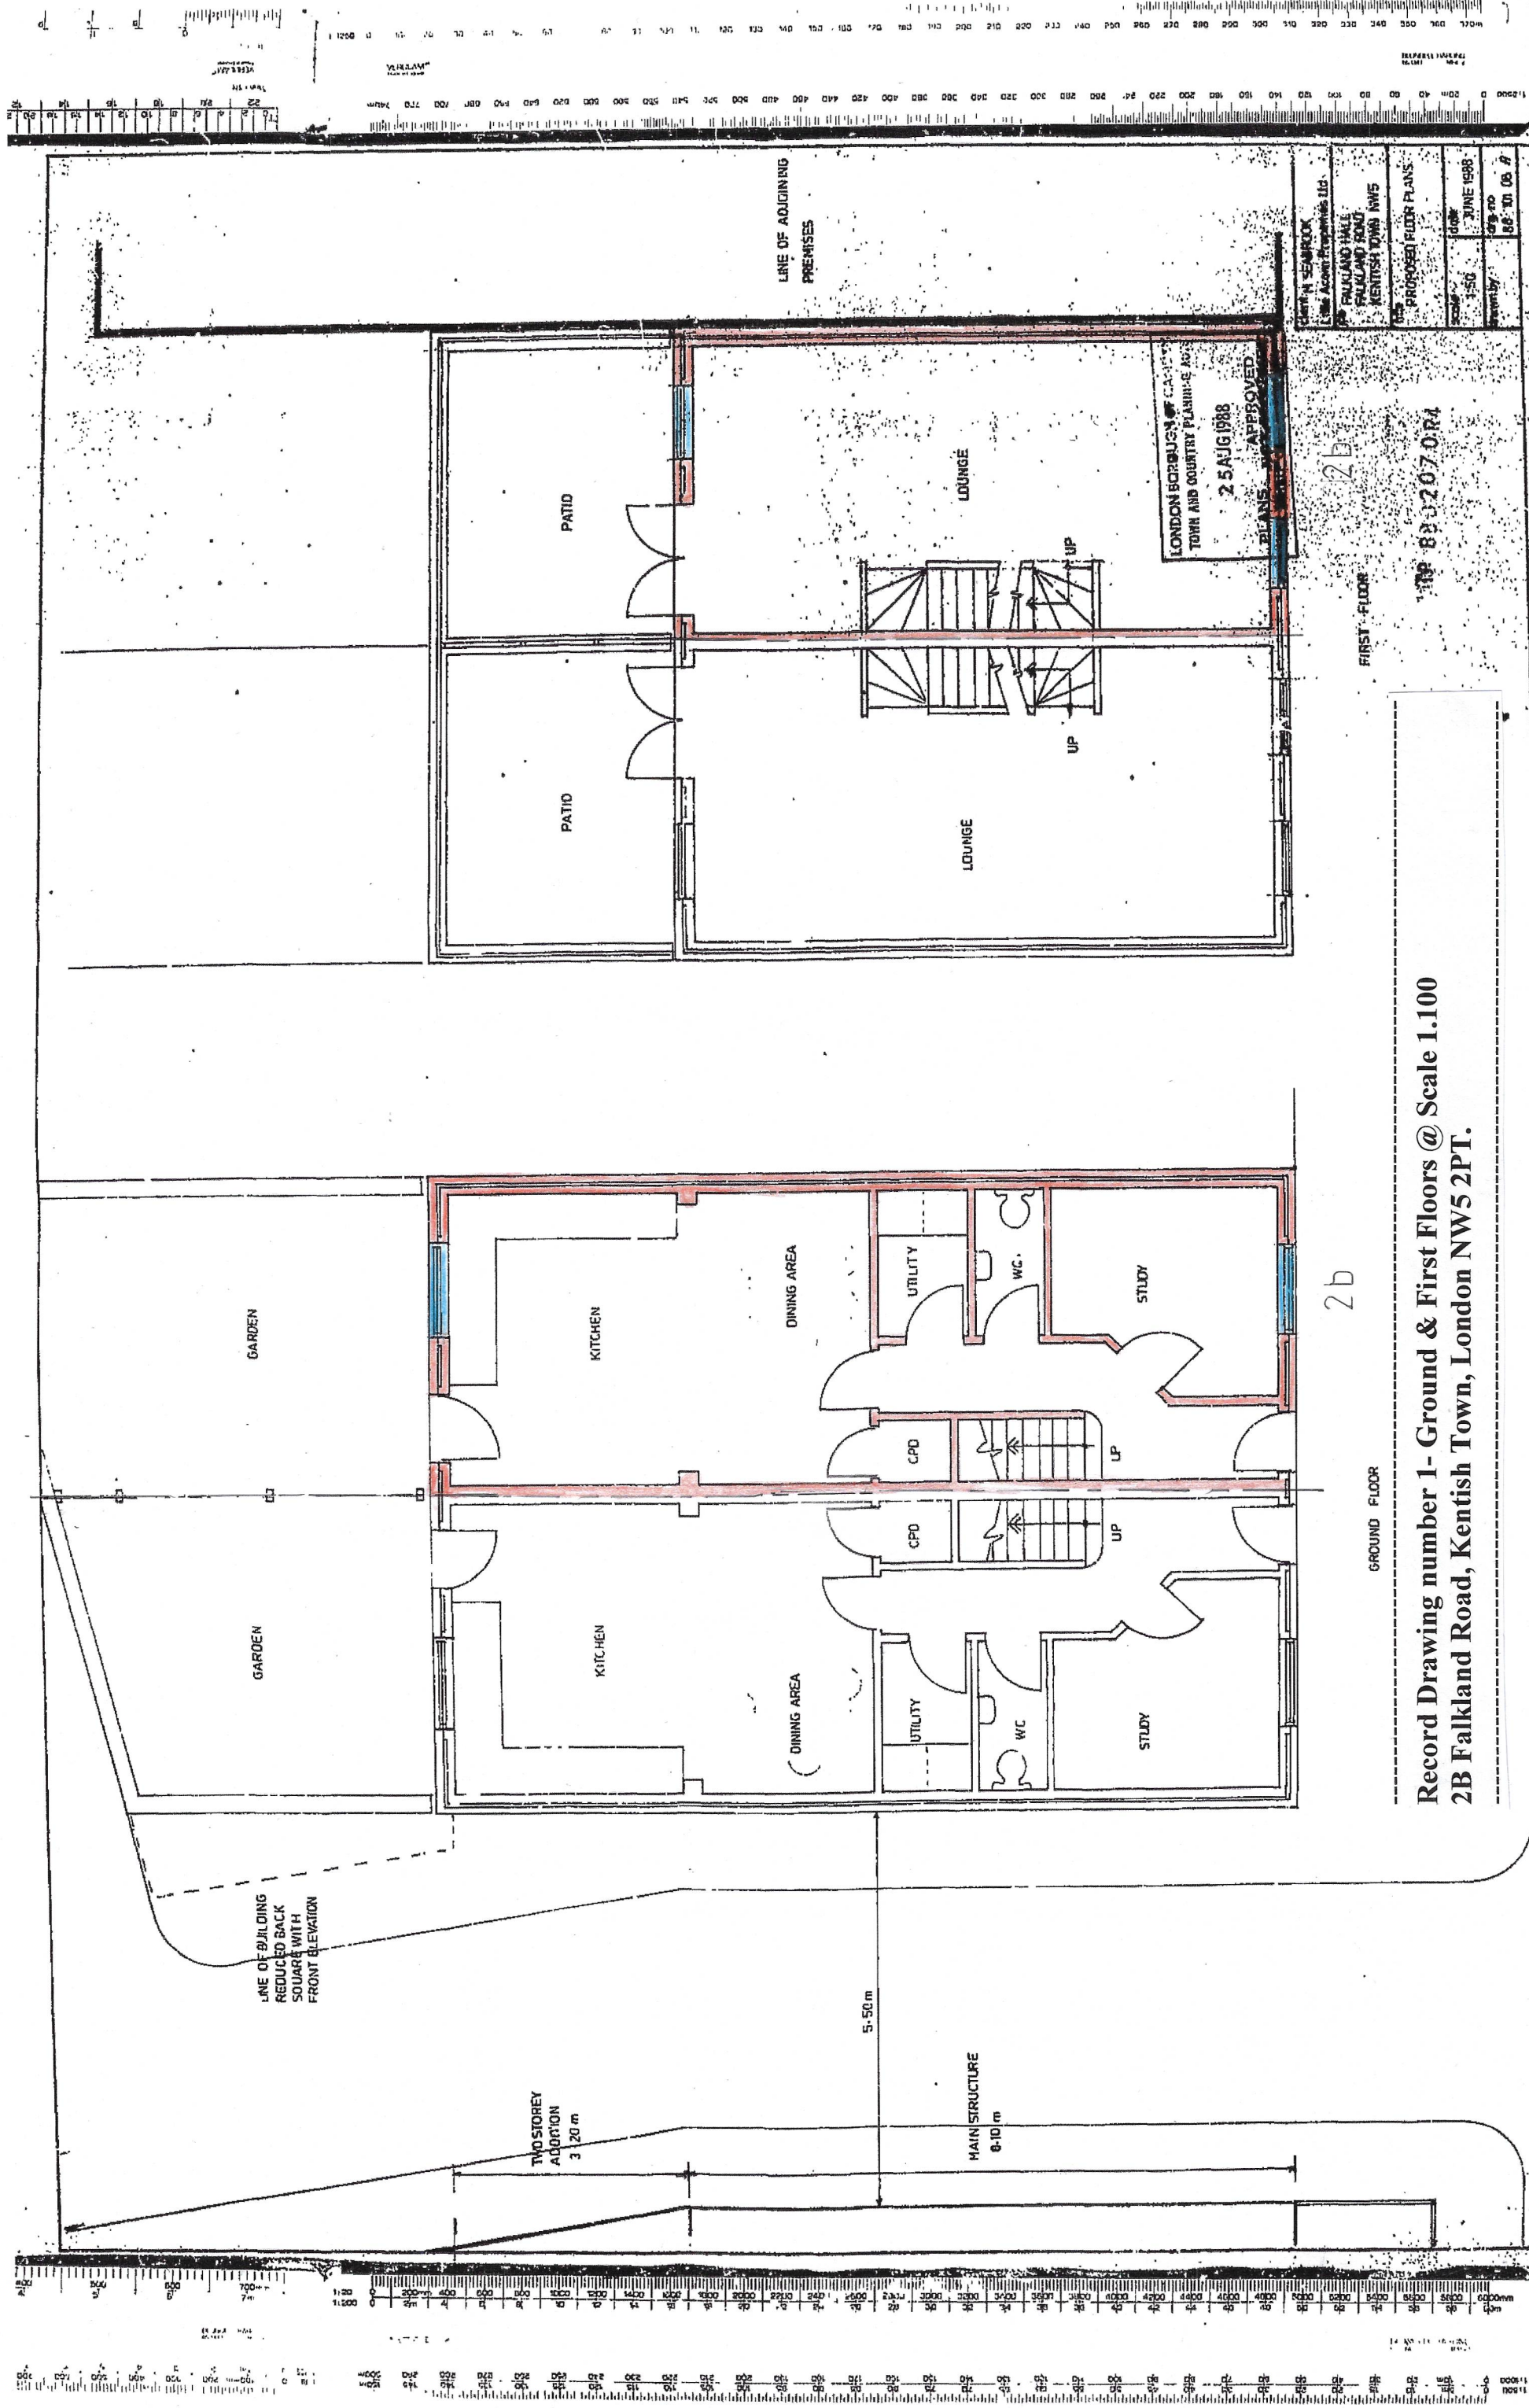

Record Drawing number 1-Ground & First Floors @ Scale 1:100
2B Falkland Road, Kentish Town, London NW5 2PT.

LONDON BOROUGH OF CROYDON TOWN AND COUNTRY PLANNING DEPARTMENT	
25 AUG 1988	PLANS APPROVED
2B	82070R4
2B Falkland Road	Kentish Town NW5
PROPOSED FLOOR PLANS	
Scale: 1:100	DATE: JUNE 1988
Property: 66-01-08-8	