


notes
Do not scale from drawing
Drawing indicates design intent only
Any subsequent approvals do not release the
trade obligations under the trade contract
The trade contractor is responsible for taking and
checking site dimensions
Report all conflicts of information to the Architect
if in doubt ask

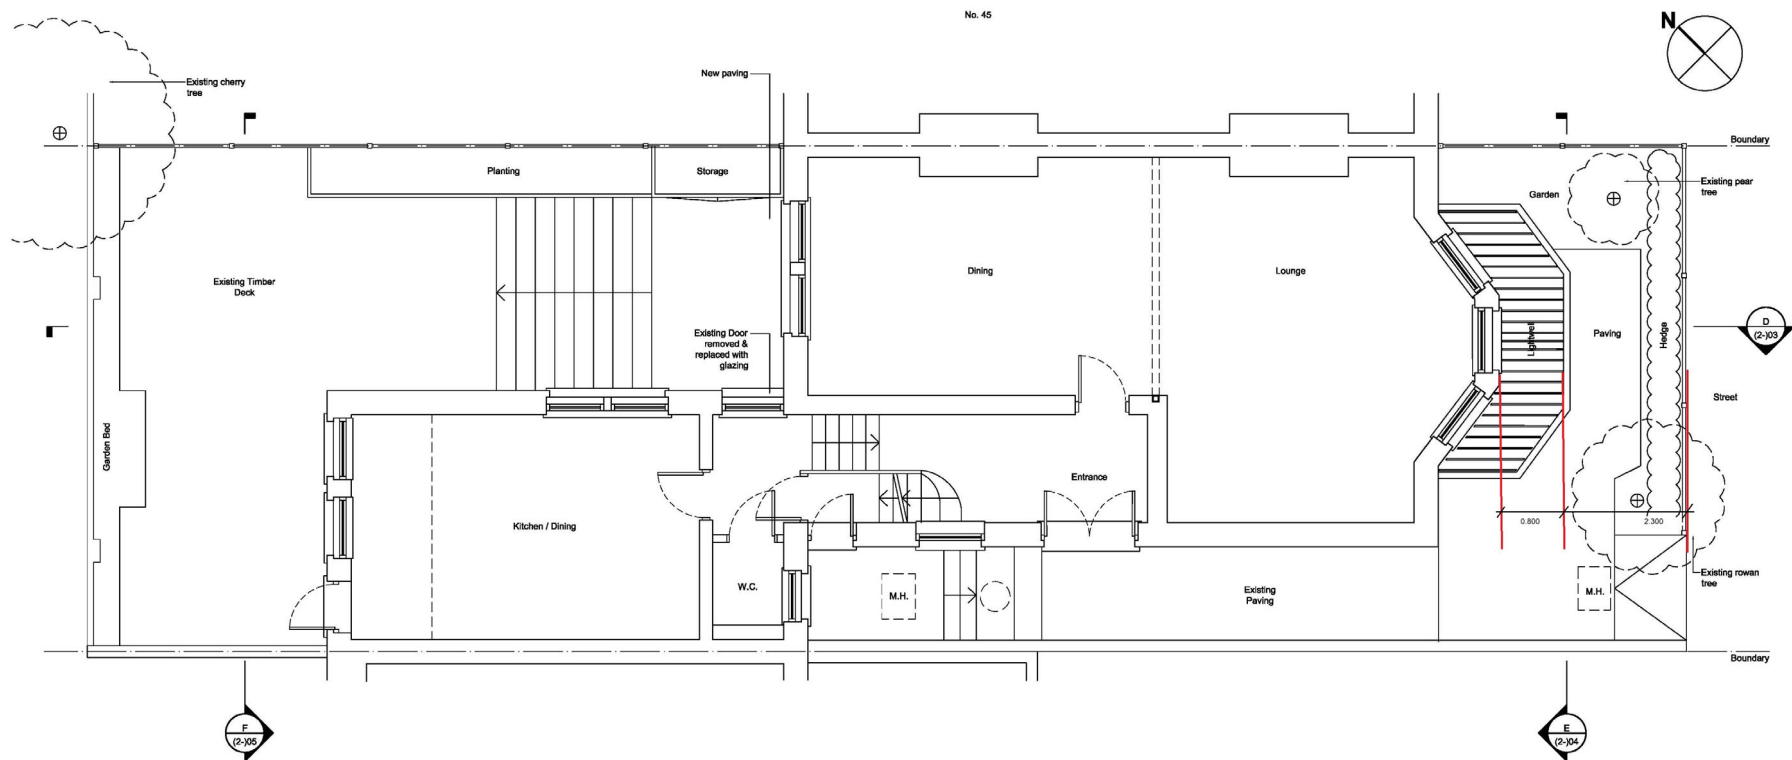

FOR PLANNING
APPLICATION ONLY

rev:	description:	date:
A	Dimensions of Front Lightwell added	23.03.2025

client

43 CROFTDOWN ROAD
LONDON
NW5 1EL



walker + martin
architecture + interior design
morelands building, 9-15 old st.
london ec1v 9hl
t 0207 253 8624 f 0207 253 8625
www.walkerandmartin.co.uk

title			
PROPOSED GROUND FLOOR PLAN			
dwg status	date	job no	
<input checked="" type="checkbox"/> information	26.11.2014	21525	
<input type="checkbox"/> tender			
<input type="checkbox"/> construction	scale	drawing no	revision
<input type="checkbox"/> as built	1: 50@A2	pl(2)-02	B