


notes
Do not scale from drawing
Drawing indicates design intent only
Any subsequent approvals do not release the
trade obligations under the trade contract
The trade contractor is responsible for taking and
checking site dimensions
Report all conflicts of information to the Architect
if in doubt ask

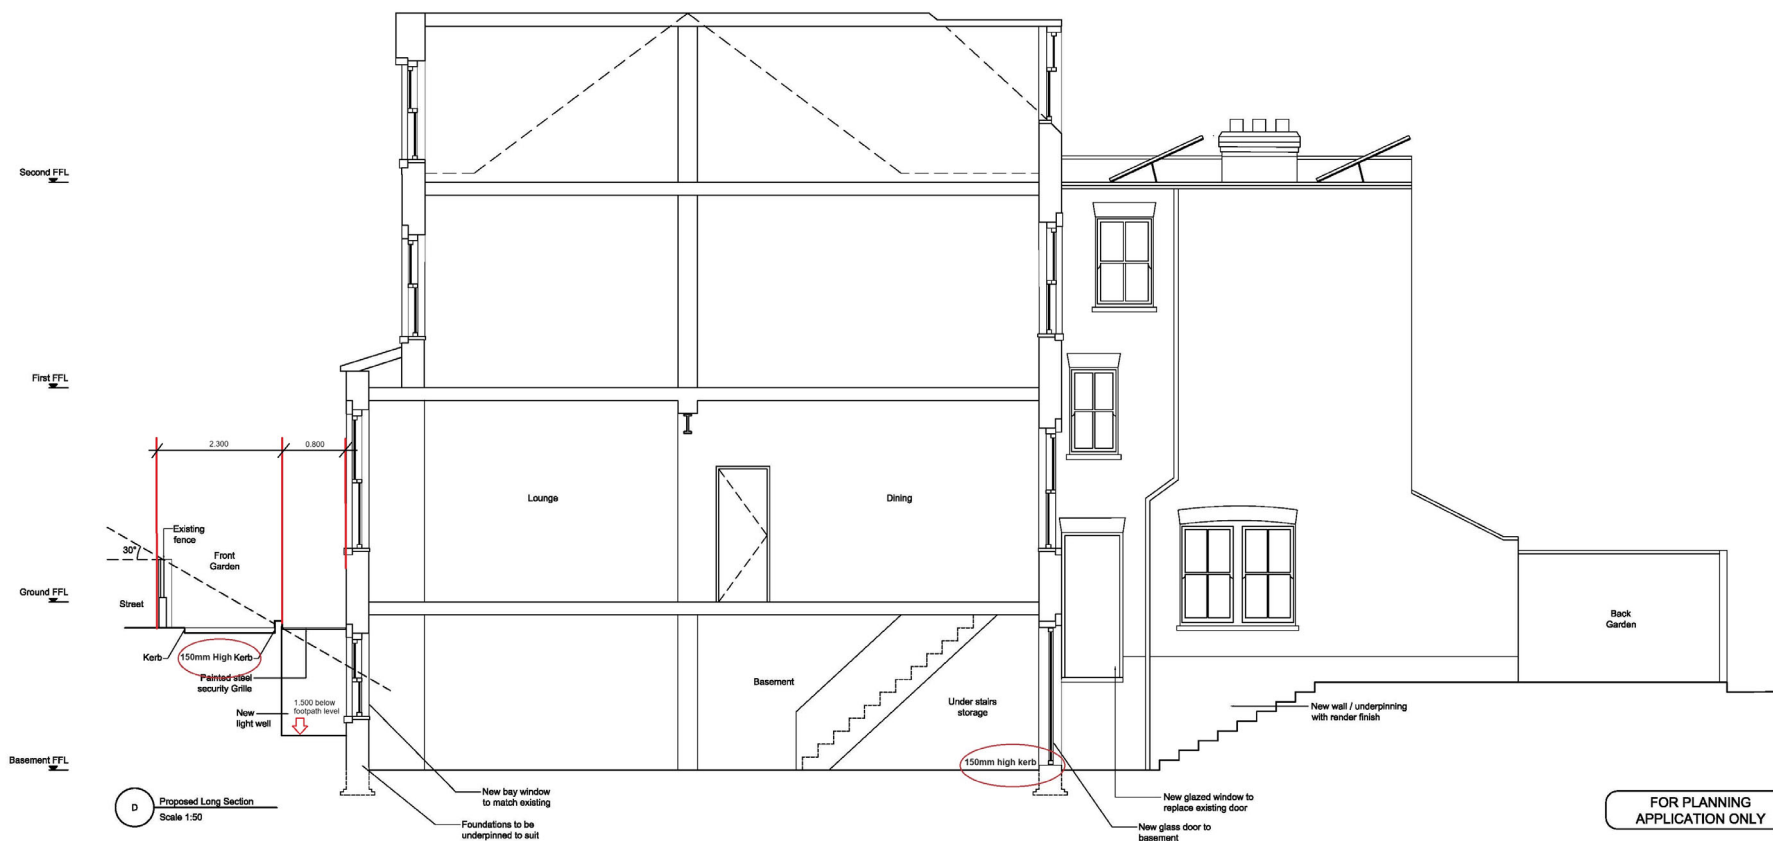

rev:	description:	date:
A	Add 150mm High Kerbs front and rear	20.08.2024
B	Dimensions added to Front Lightwell	24.03.2025

client

43 CROFTDOWN ROAD
LONDON
NW5 1EL



walker + martin
architecture + interior design
morelands building, 9-15 old st.
london ec1v 9hl
t 0207 253 8624 f 0207 253 8625
www.walkerandmartin.co.uk

title			
PROPOSED LONG SECTION			
dwg status	date	job no	
☒ information	26.11.2015	21525	
☐ tender	scale	drawing no	revision
☐ construction	1:50@A2	pl(2-)-03	B
☐ as built			