

ALL DIMENSIONS TO BE CHECKED ON SITE. ANY DISCREPANCIES MUST BE REPORTED TO THE ARCHITECT FOR VERIFICATION PRIOR TO COMMENCEMENT OF THE EFFECTED WORKS. IF IN DOUBT ASK. THIS DRAWING IS COPYRIGHT.

Rev No	Date	Revision note
P1	16.01.2012	Preliminary issue.
P2	12.05.2021	Revised front elevation as per as-built.

A


B

C

D

E

F

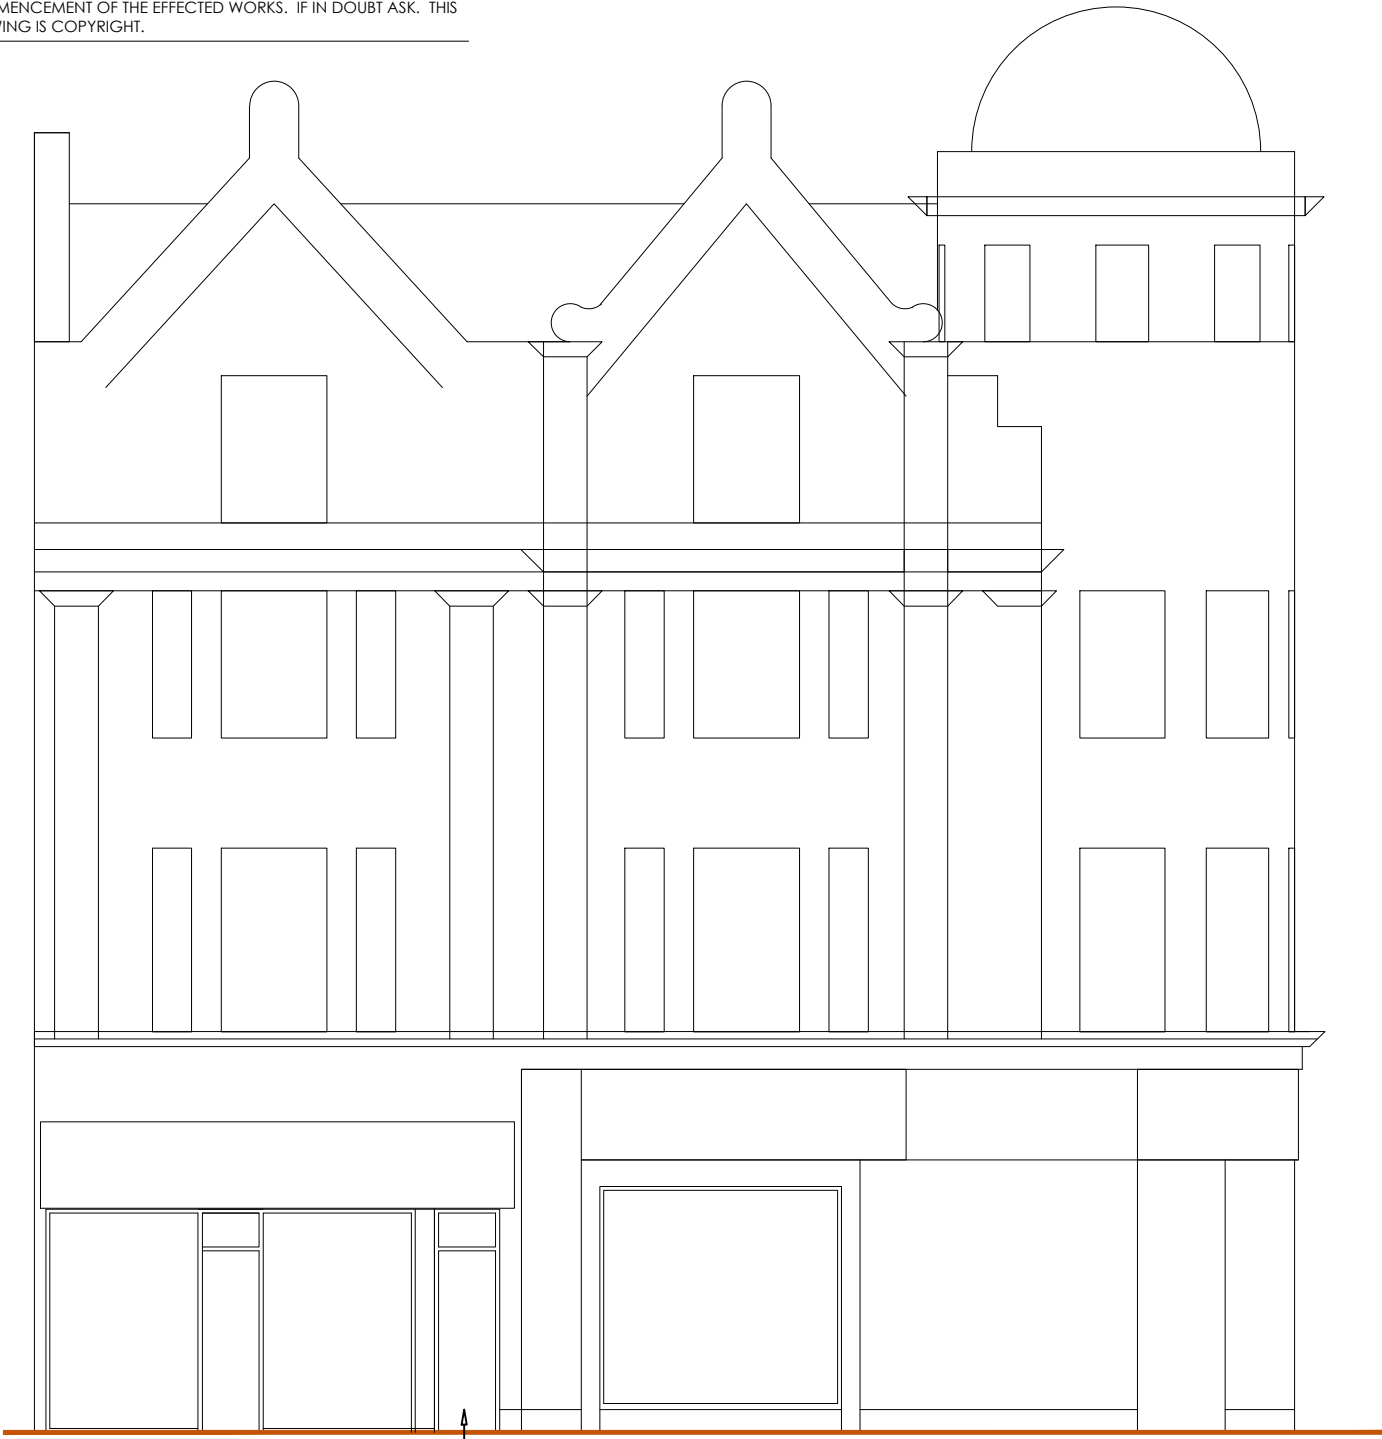

FRONT ELEVATION

EXISTING DOOR TO
ACCESS NEW FLAT AT
FIRST FLOOR



SIDE ELEVATION

A


B

C

D

E

F

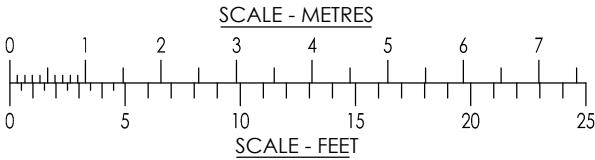

jpb
architects

BROOK HOUSE
54a COWLEY MILL ROAD
UXBRIDGE UB8 3FX
TEL: (01895) 272 446
FAX: (01895) 272 483
EMAIL: admin@jpbarchitects.co.uk

JOB TITLE
44-46 KILBURN HIGH ROAD
KILBURN
NW6 4HJ

DRG TITLE
EXISTING ELEVATIONS

SCALE
1:100@A3

JOB NO.
10065

DRG NO.
111

DATE
NOV 2010

REV
P2