



LSX0104470

RADA RECORD DRAWING FROM 2001.

This drawing is copyright (c) of All Clear Designs Limited and must not be reproduced in part or on whole without written permission.


Do not scale from drawings. All dimensions to be checked on site prior to commencement of work. Report all discrepancies to CA.

IF IN DOUBT ASK

Electrical Services

Construction

Site Plan

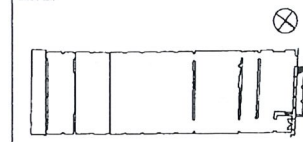


Rev Date Revisions

Project
Drill Hall Theatre
Phase I Refurbishment


Drawing Title
Existing
Front Elevation

all clear designs ltd. ©
3 Devonshire Mews London W4 2HA
Tel: 020 8400 5093 Fax: 020 8400 5094
email: allclear@easynet.co.uk


Job no.
0031
Scale
1:50 A1
1:100 A3
Date
14.04.01
Dep. no.
LO 020
Rev no.
-

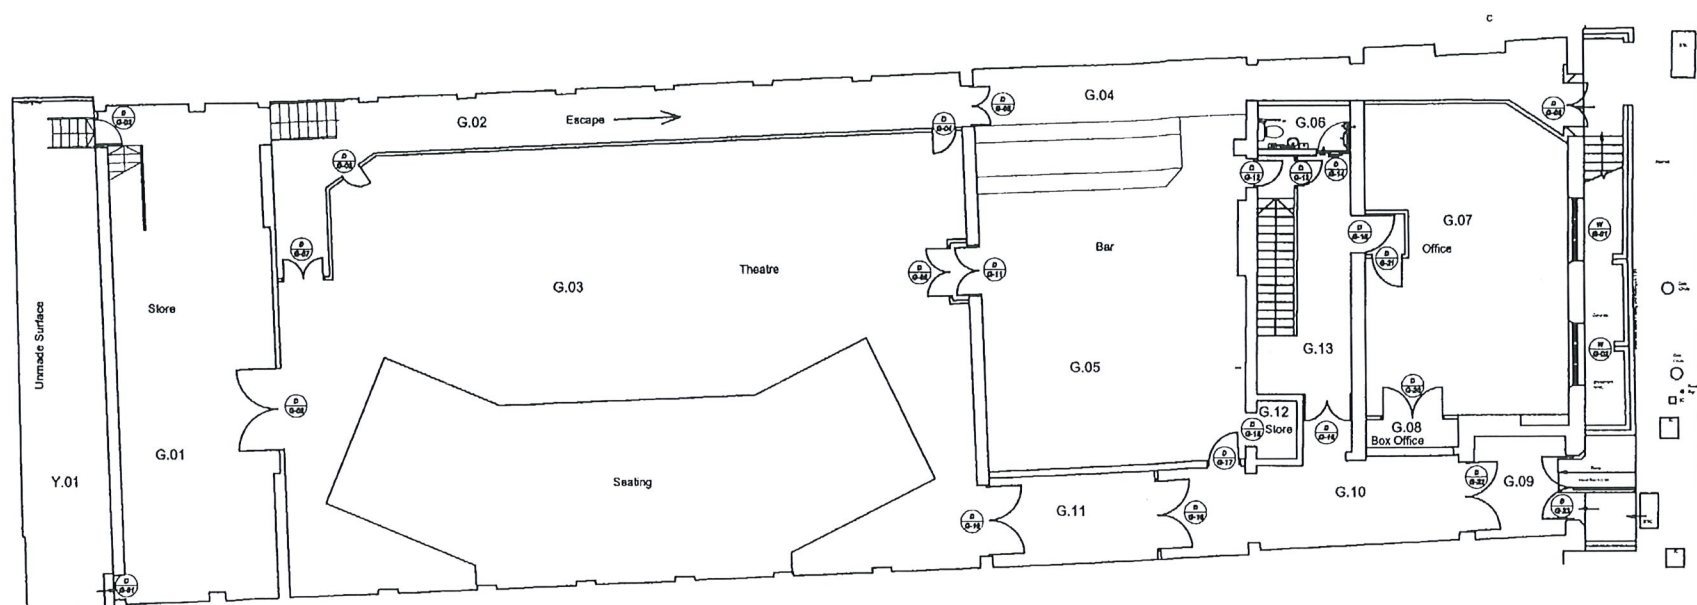

Ground Floor Plan

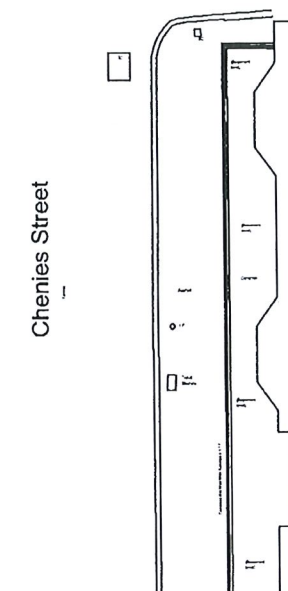

Chenies Street

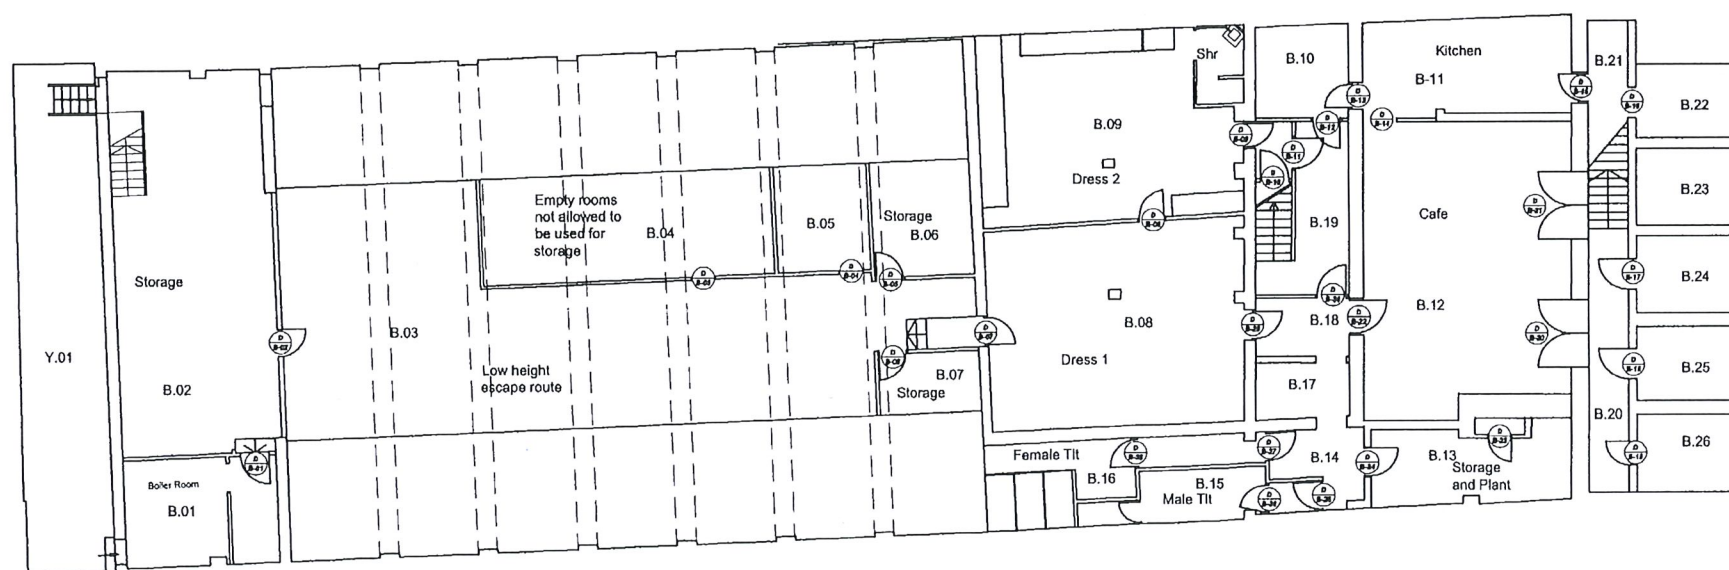

Basement Plan

LSX0104470

RADA RECORD DRAWING FROM 2001

This drawing is copyright (c) of All Clear Designs Limited and must not be reproduced in part or on whole without written permission.

Do not scale from drawings. All dimensions to be checked on site prior to commencement of work. Report all discrepancies to CA.

IF IN DOUBT ASK

Electrical Services

Construction


Site Plan




Rev Date Revisions

Project
Drill Hall Theatre
Phase I Refurbishment
Drawing Title
Existing
Basement & Ground Floor Plans
all clear designs ltd. ©
3 Devonshire Mews London W4 2HA
Tel: 020 8400 5093 Fax: 020 8400 5094
email: allclear@easynet.co.uk


Job no
0031
Scale
1:100 A1
1:200 A3
Date
14.04.01
Dwg no
LO 010
Rev no
-

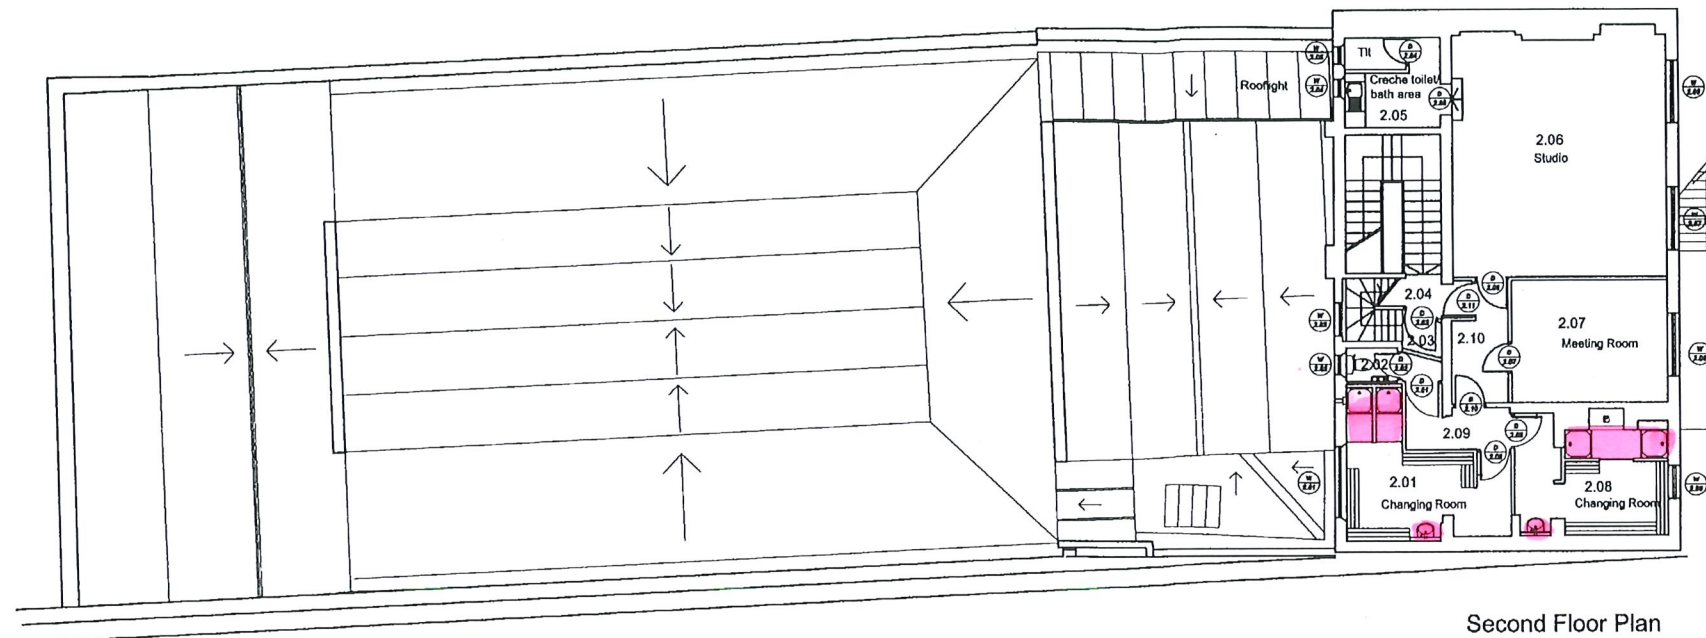


SHOWERS / WASHBASINS INSTALLED
2001. PROPOSED TO BE STRIPPED OUT
AND REMOVED 2025.

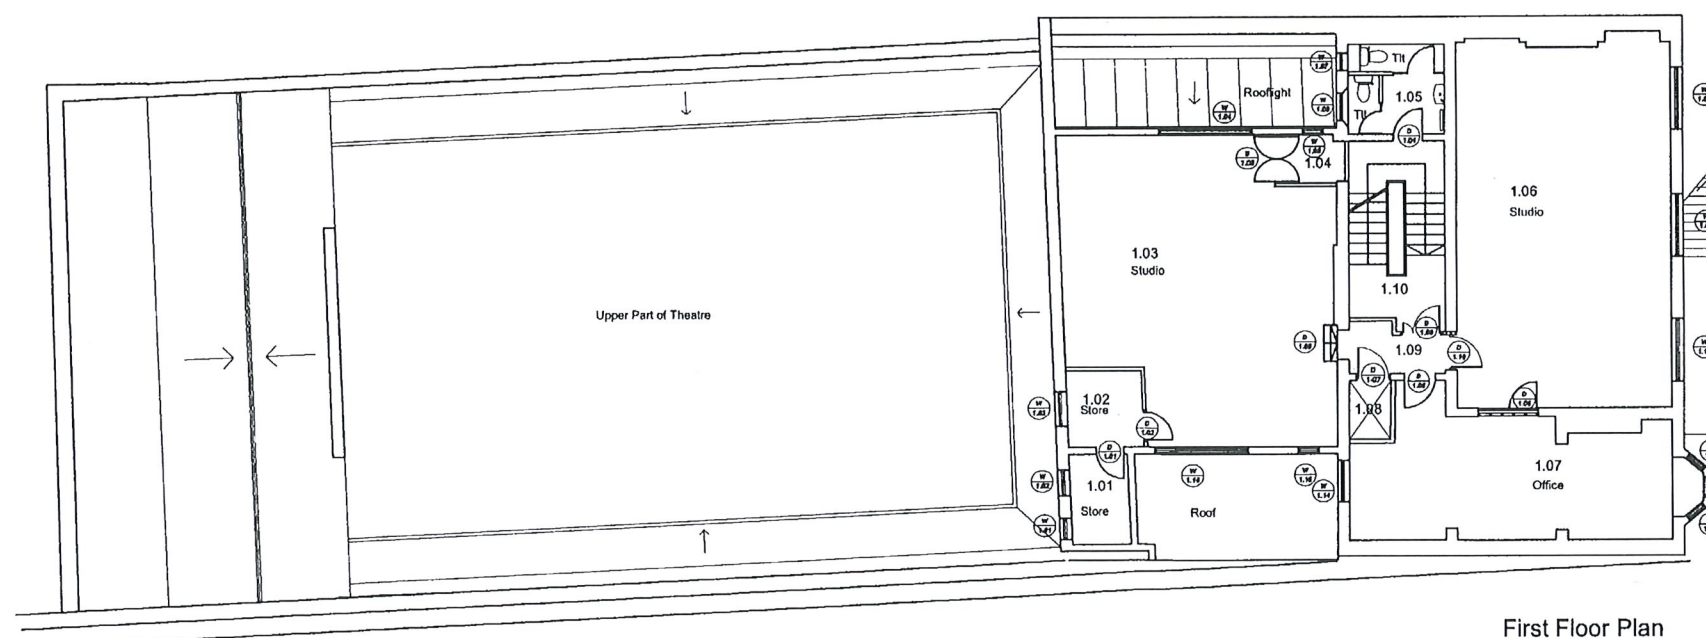


LSX0104470
RADA RECORD DRAWING FROM 2001.

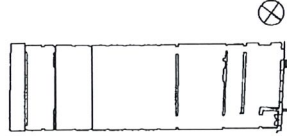This drawing is copyright (c) of All Clear Designs Limited and must not be reproduced in part or on whole without written permission. Do not scale from drawings. All dimensions to be checked on site prior to commencement of work. Report all discrepancies to CA. IF IN DOUBT ASK			Electrical Services	Construction	Site Plan 	Project Drill Hall Theatre Phase I Refurbishment Drawing Title Proposed First & Second Floor Plans all clear designs ltd. © 3 Devonshire Mews London W4 2HA Tel: 020 8400 5093 Fax: 020 8400 5094 email: allclear@easynet.co.uk	Job no. 0031 Scale 1:100 A1 1:200 A3 Date 14.04.01 Dwg no. LO 111 Rev. no.
--	--	--	----------------------------	---------------------	--	--	---

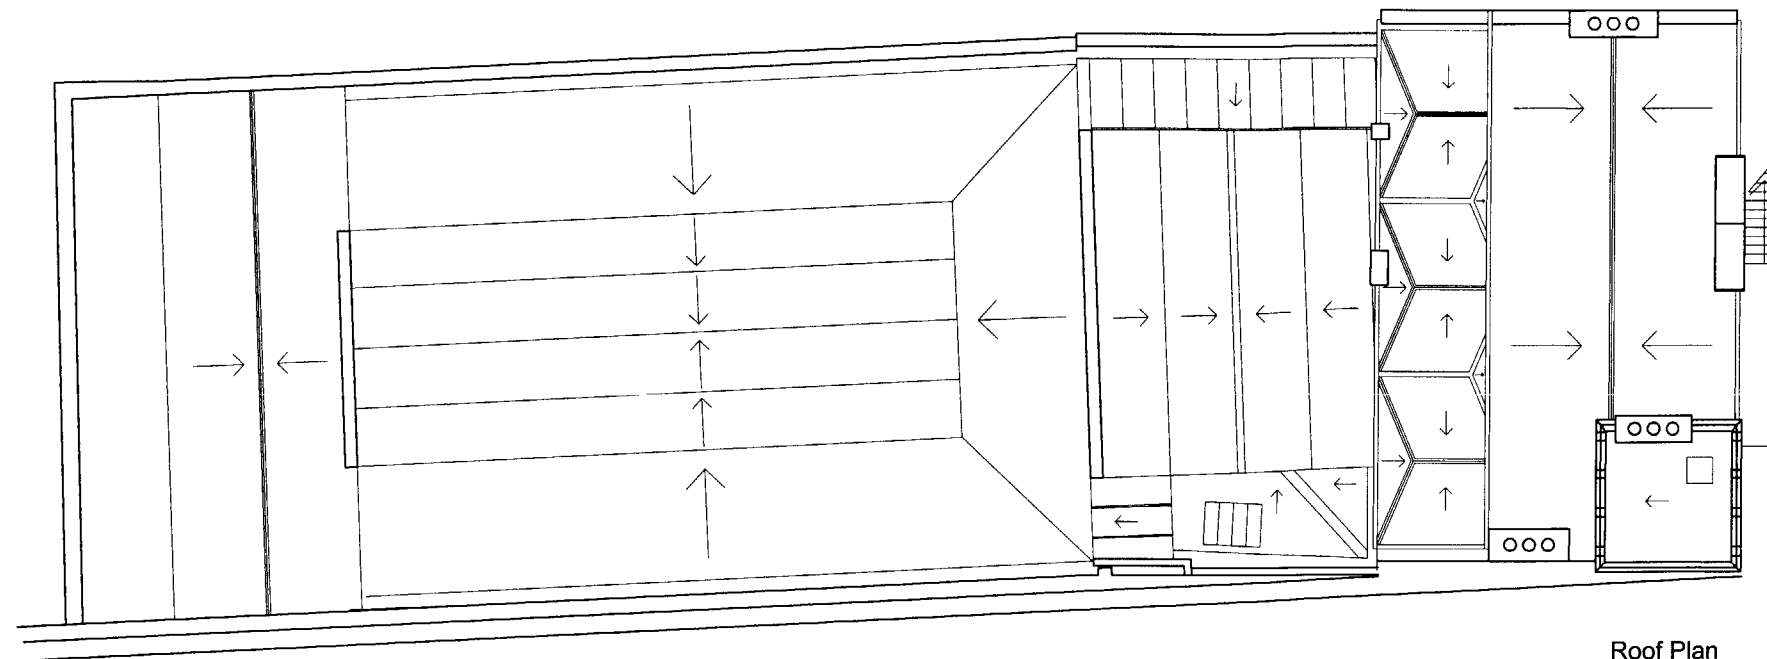

Roof Plan

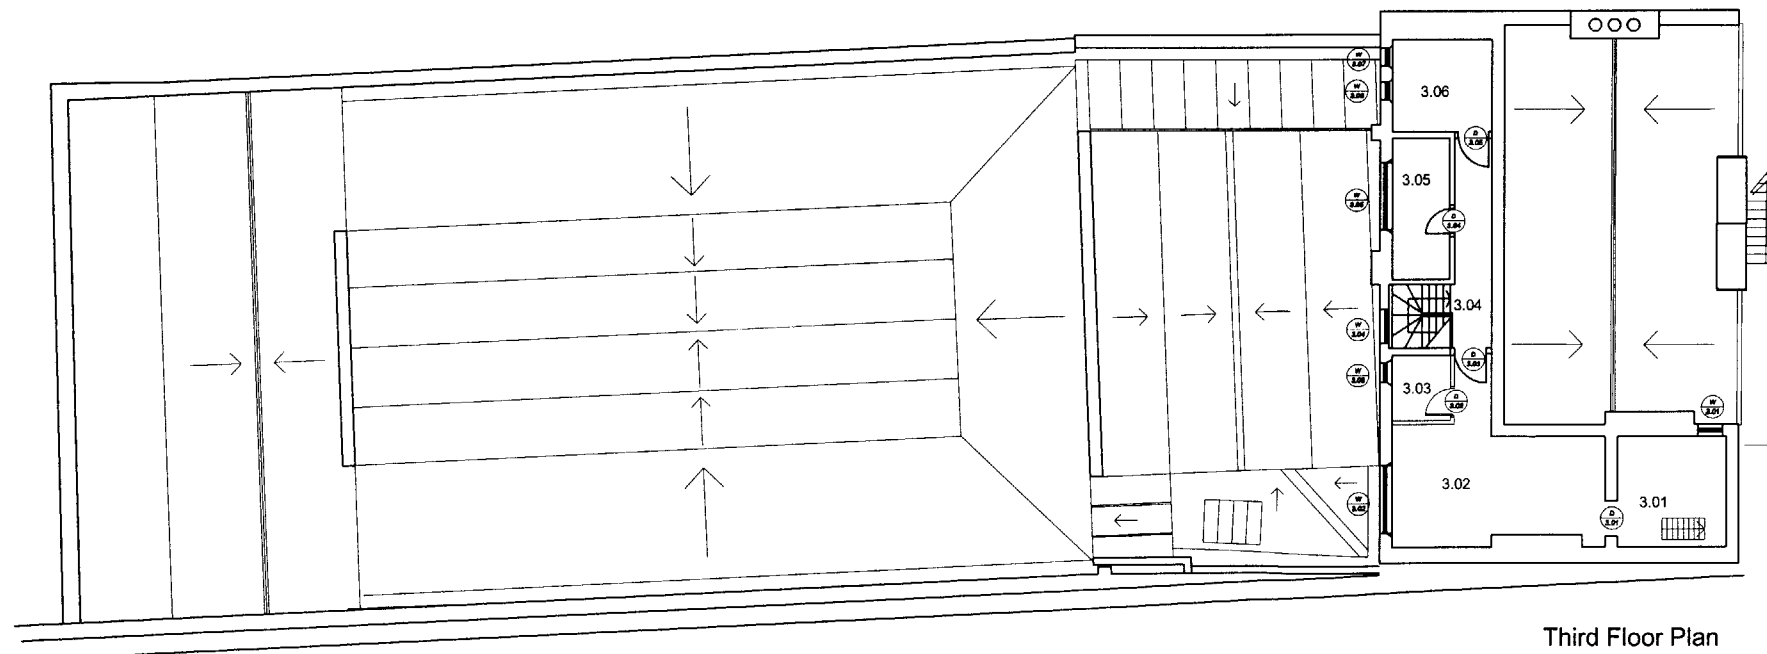

Third Floor Plan

LSX0104470

This drawing is copyright (c) of All Clear Designs Limited and must not be reproduced in part or on whole without written permission.


Do not scale from drawings. All dimensions to be checked on site prior to commencement of work. Report all discrepancies to CA.

IF IN DOUBT ASK

Electrical Services

Construction

Site Plan

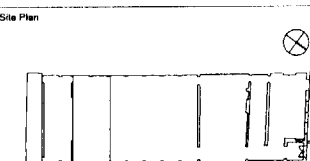

Rev. Date Revision

Project
Drill Hall Theatre
Phase I Refurbishment

Drawing Title
Existing
Third & Roof Plans

all clear designs ltd. ©
3 Devonshire Mews London W4 2HA
Tel: 020 8400 5093 Fax: 020 8400 5094
email: allclear@easynet.co.uk

Job no
0031
Scale
1:100 A1
1:200 A3
Date
14.04.01
Dwg. no
LO 012
Rev. no
-