



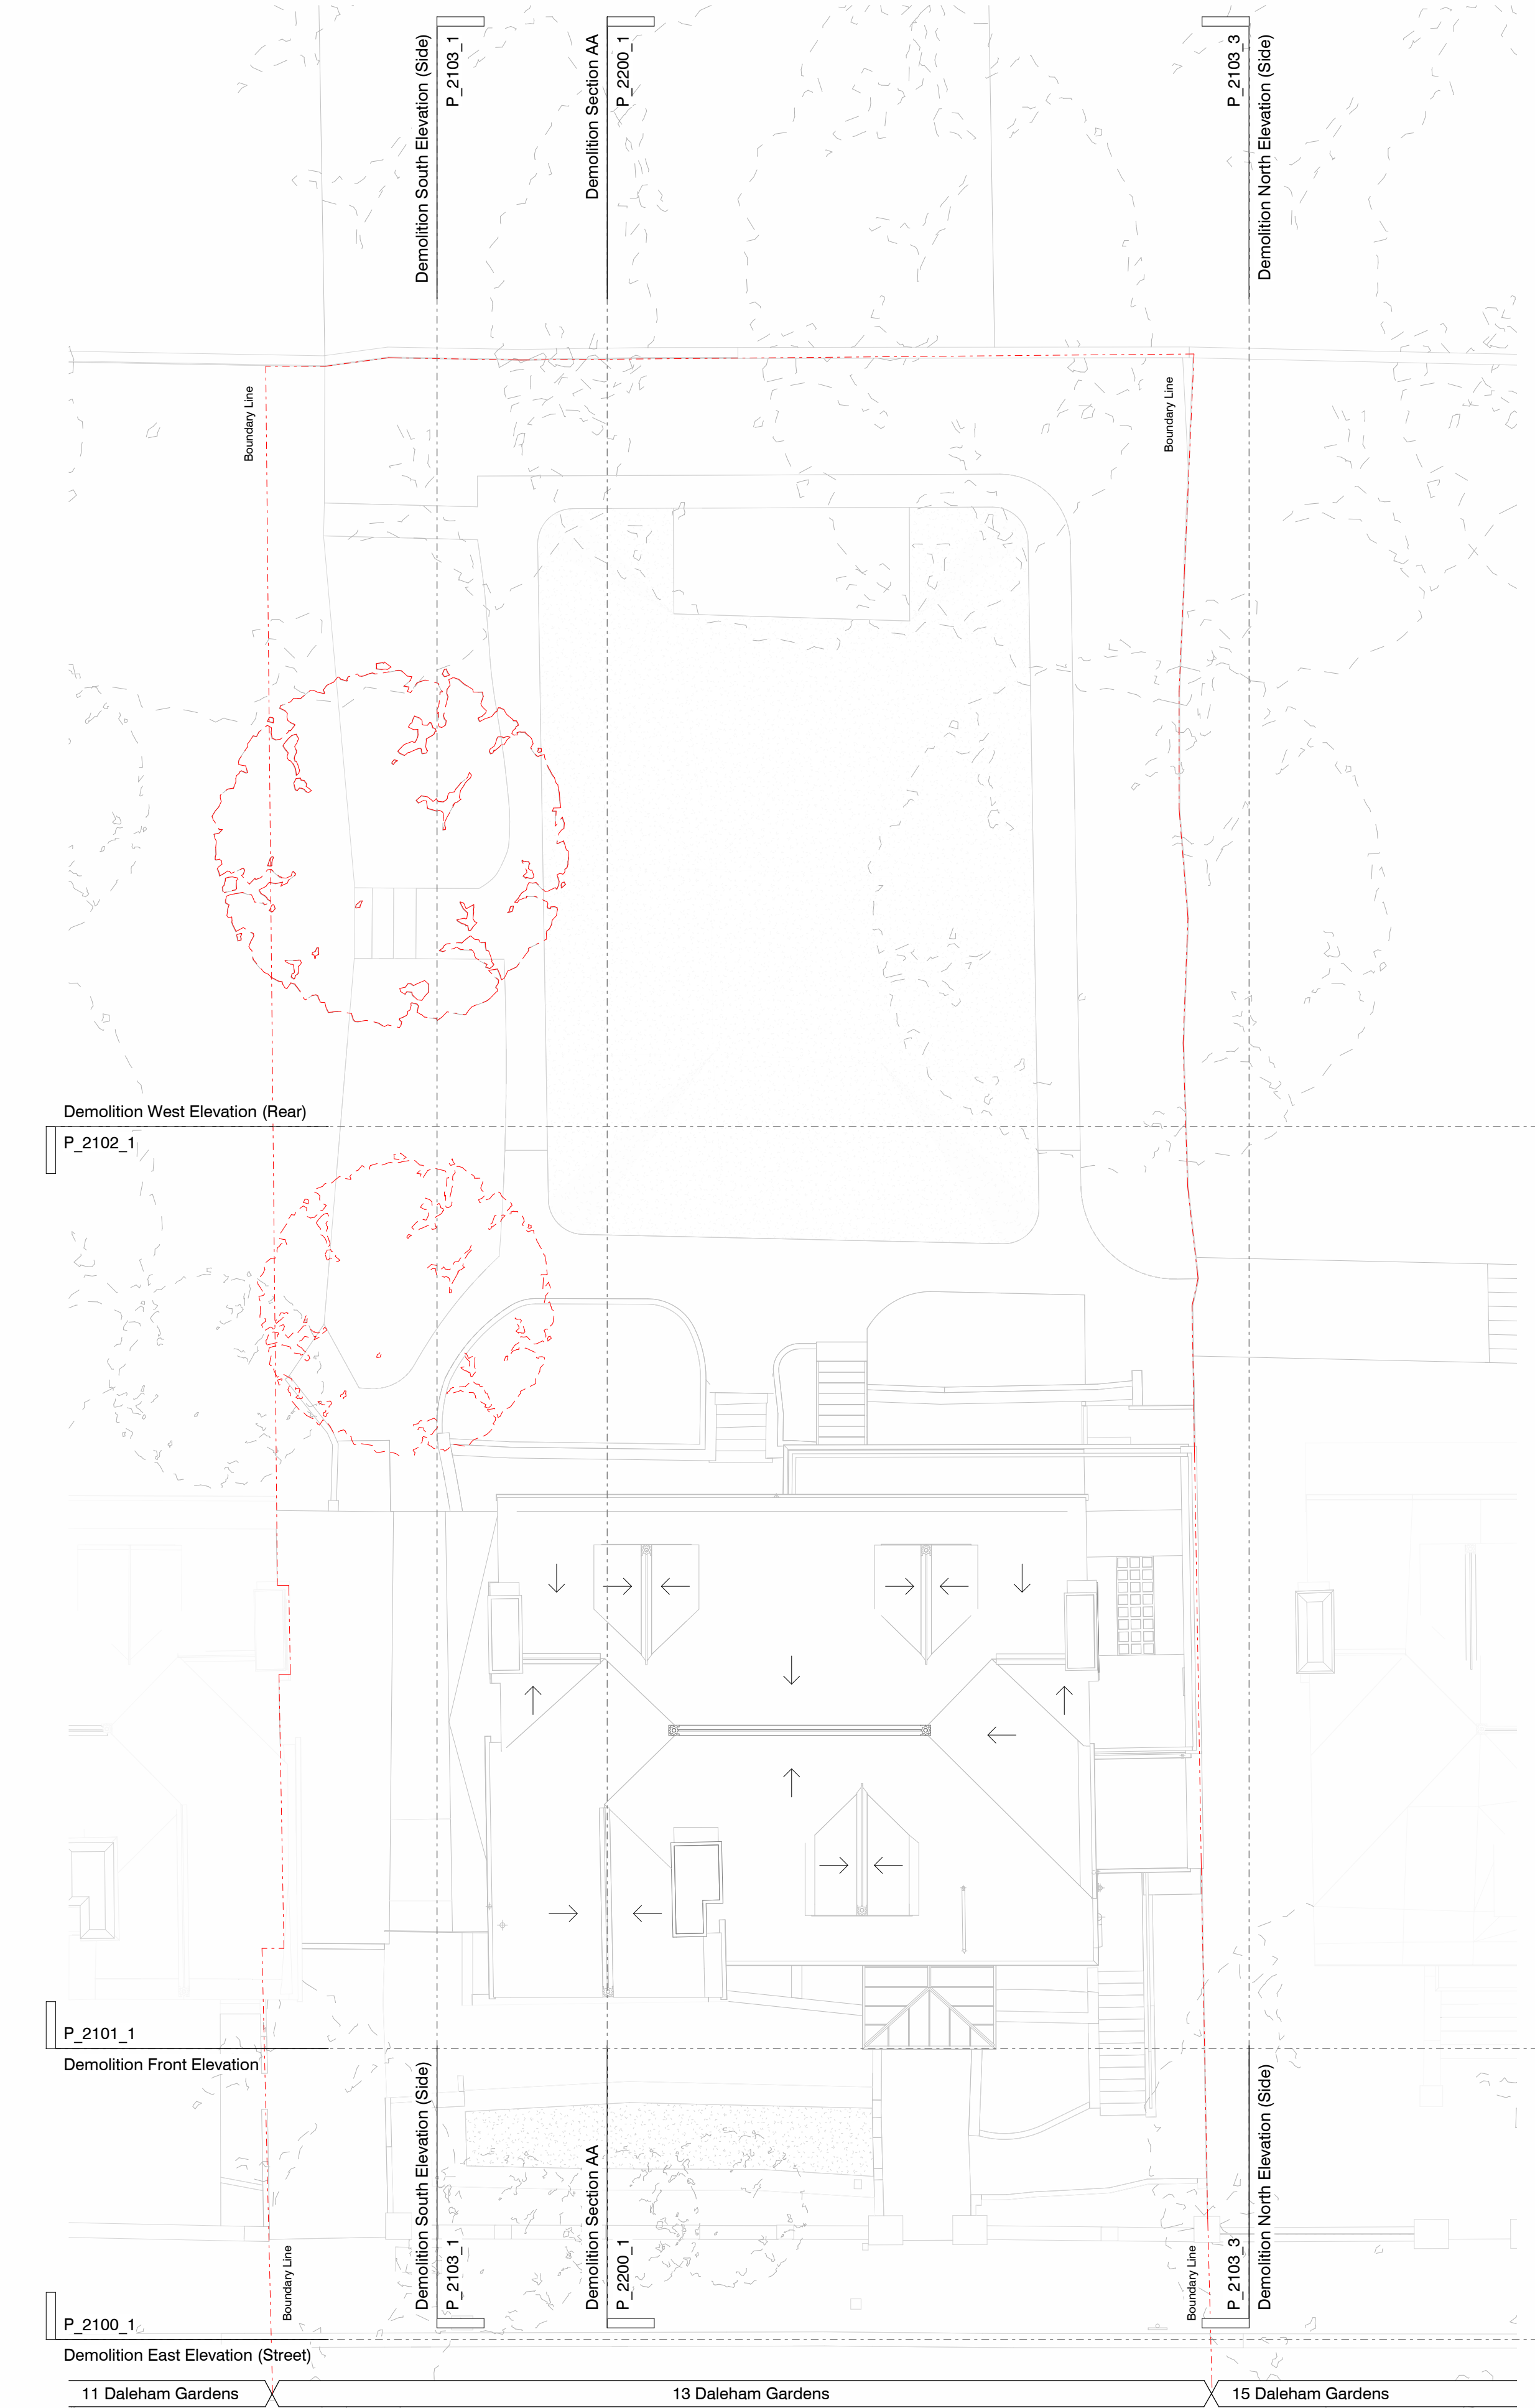

1
P_2003
Demolition Roof Plan
1 : 100

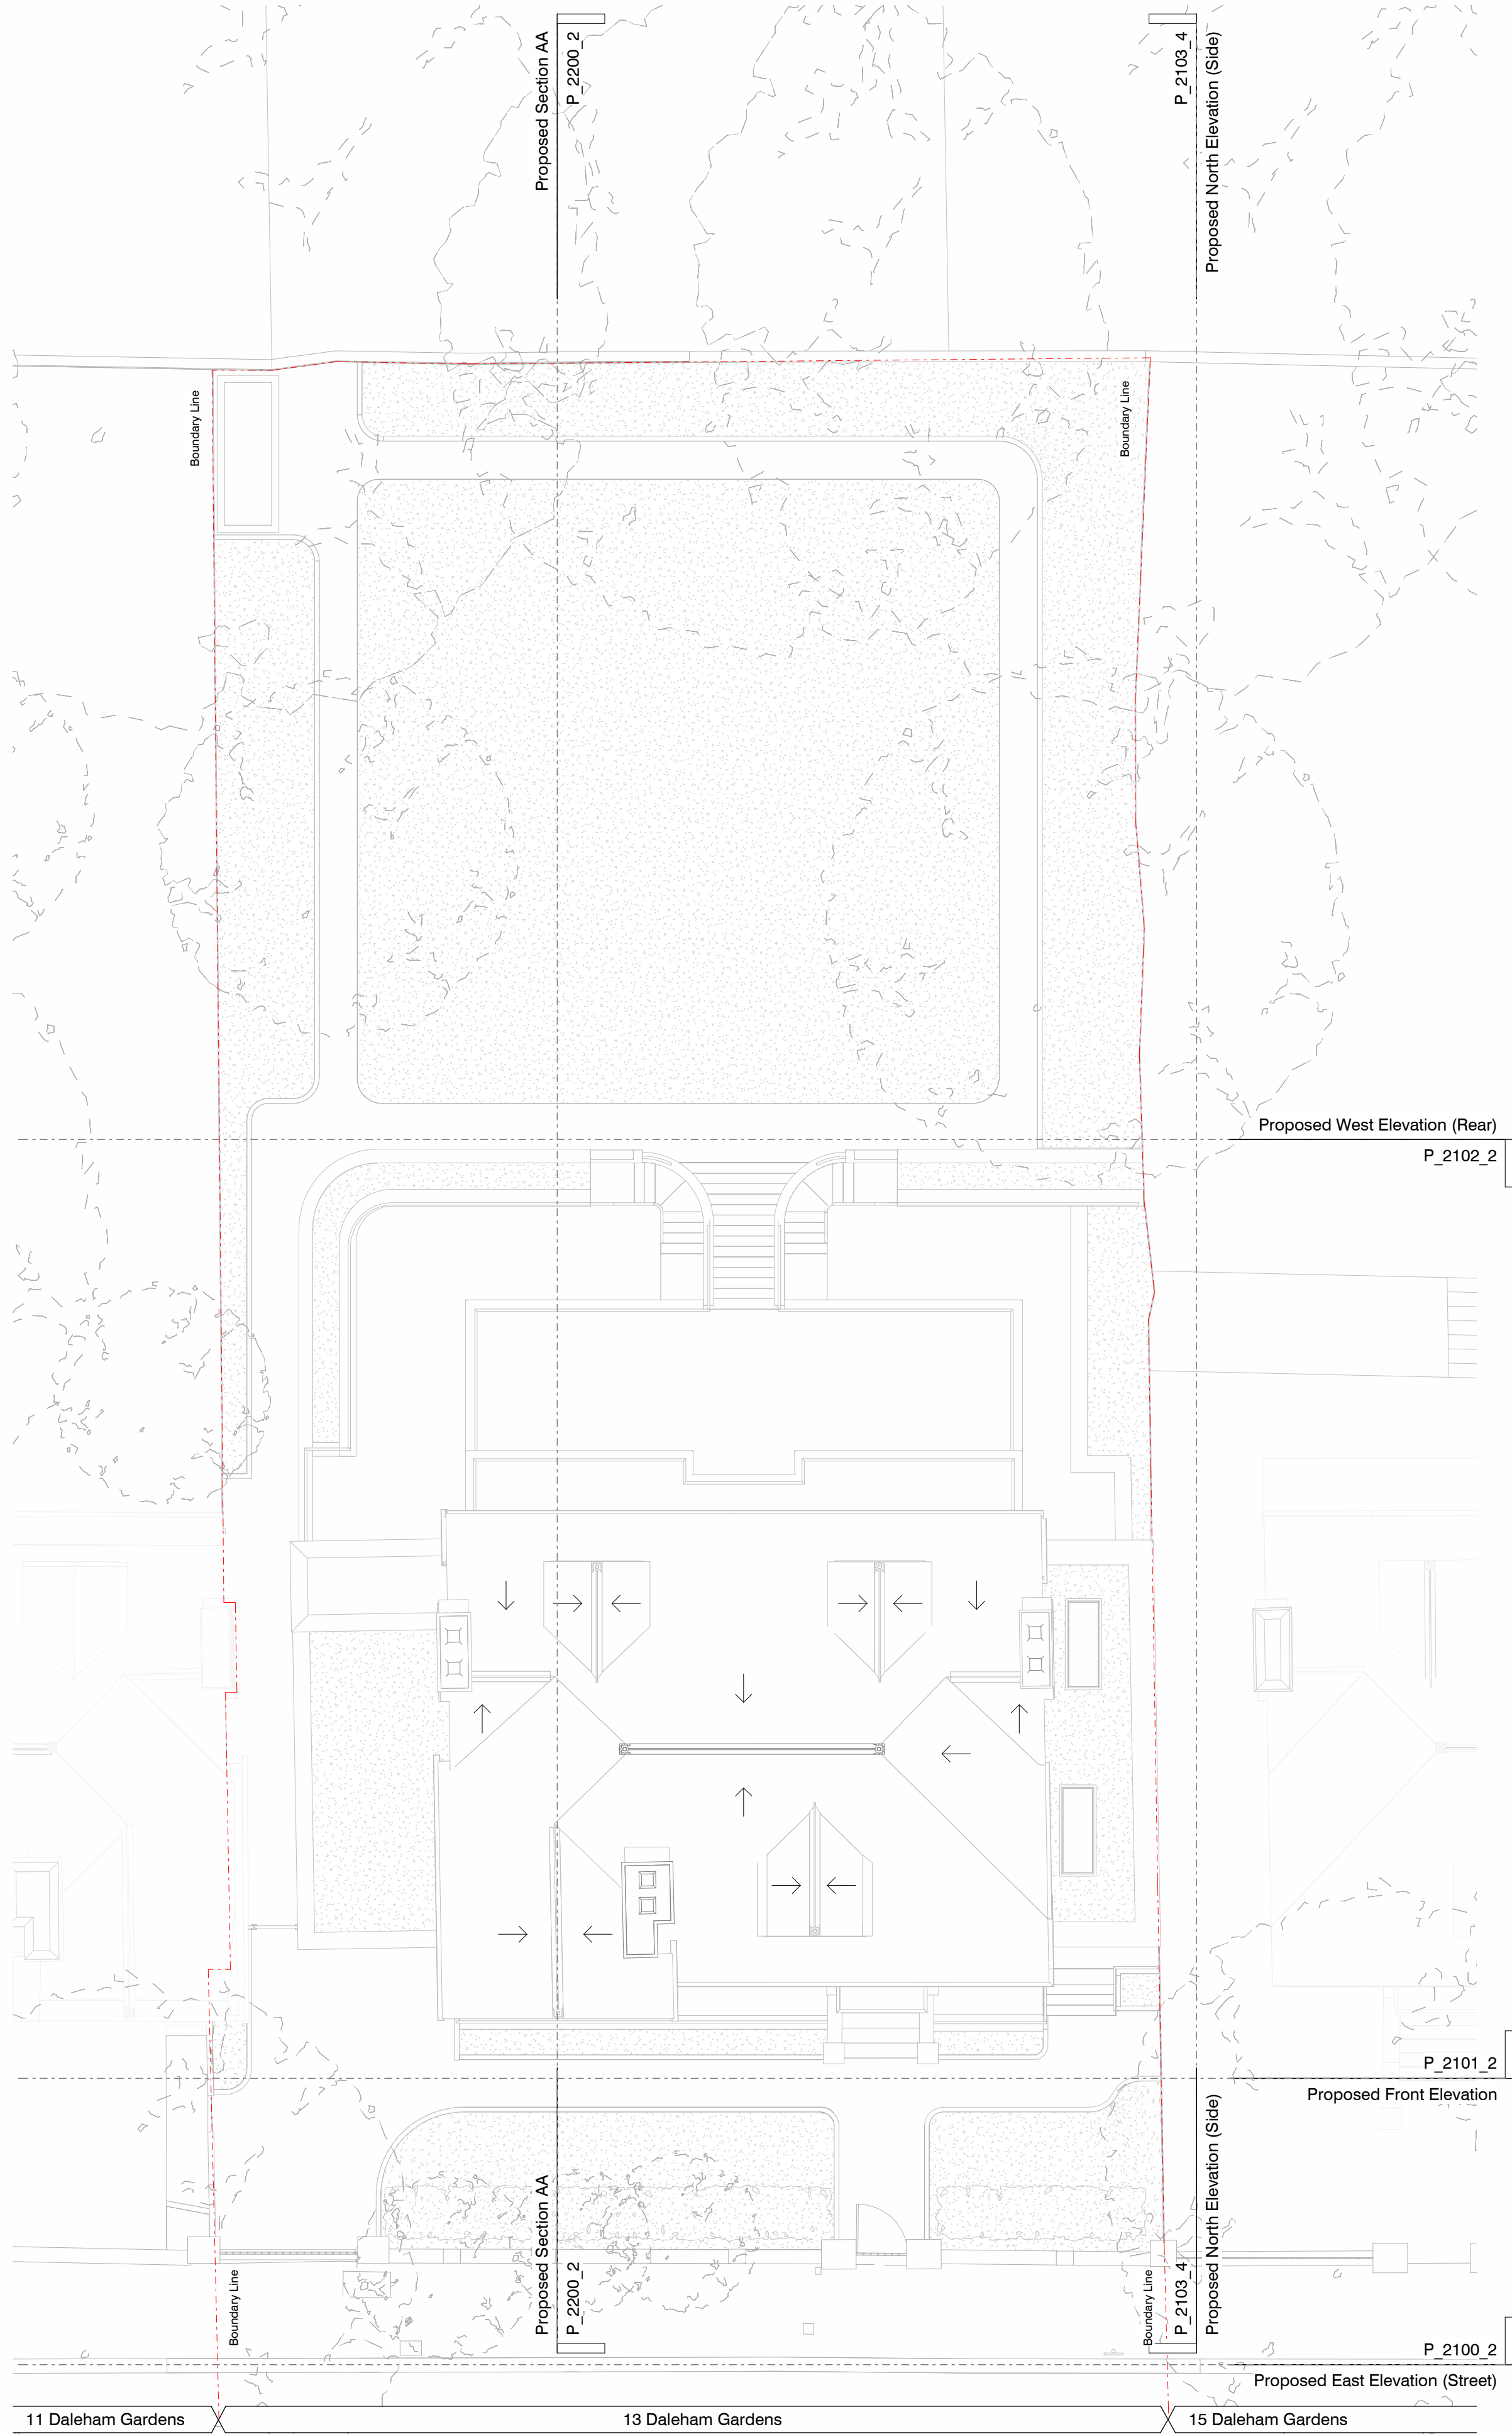

2
P_2003
Proposed Roof Plan
1 : 100

Key Section:

Scale: 1:200 @A1

Key:

- Red line: Cutting plane
- Red hatched area: Denotes Demolition
- Grey area: Denotes Existing Structure
- White area: Denotes Proposed Structure

General Notes:

1. Existing drawings based on survey from Michael Gallie issued May 2024.

PLANNING

Project Number: 24003

Client: Private Client

Date: Jul '24

Scale: 1:100@A1 / 1:200@A3

Project: 13 Daleham Gardens, London NW3

Drawing Title: Demolition & Proposed Roof Floor Plan

Drawing No: P_2003 Rev:

Drawn: CF Approved by: AMB Signed: CL

Marek Wojciechowski Architects

05-65 Margaret Street W1W 6SR T: 020 7595 9336 www.mwa.co.uk

Copyright Marek Wojciechowski Architects. No implied license exists. This drawing should not be used to calculate areas for the purposes of valuation. All dimensions to be checked on site by the contractor and such dimensions to be their responsibility. Do not scale drawings. All work must comply with relevant British Standards and Building Regulations requirements. Drawing errors and omissions to be reported to the architect.

N

0m 2m 4m 6m 8m 10m