



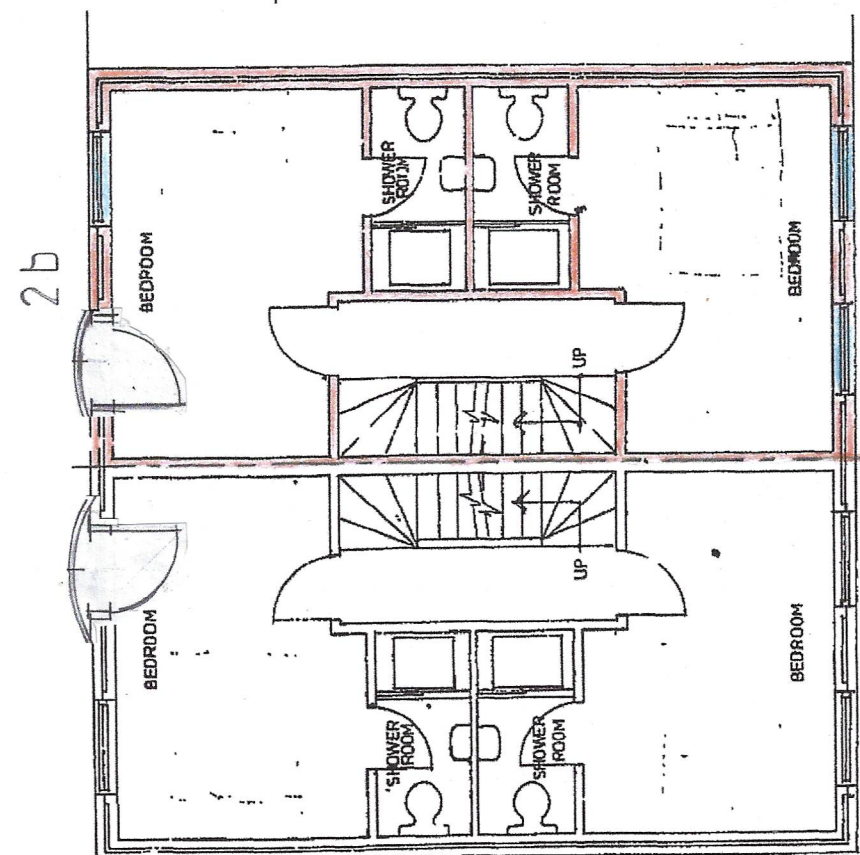

SECOND FLOOR

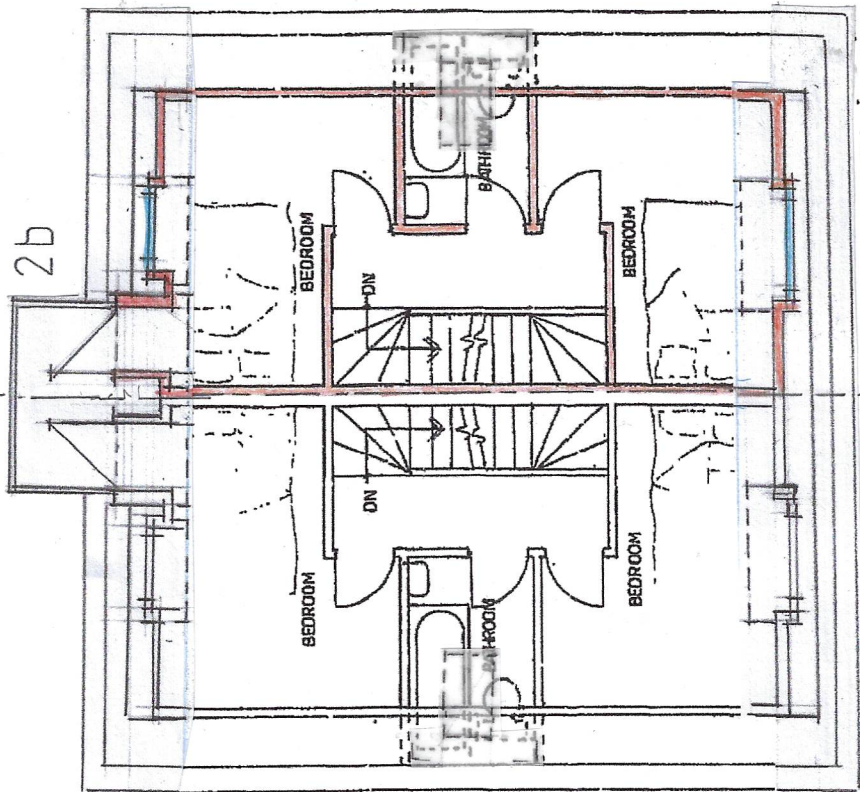

THIRD FLOOR

Record Drawing number 2 Revision B - Second & Third Floors @ Scale 1:100
2B Falkland Road, Kentish Town, London NW5 2PT.

Client	M SEABROOK
Job	Little Acorn Properties Ltd
Address	FALKLAND ROAD KENTISH TOWN NW5
Proposed Floor Plans	25 AUG 1988
Scale	1:50
Date	JUNE 1988
Drawn by	DRG 001
Checked by	DRG 001

APPROVED
PLANS
ON BEHALF OF THE COUNCIL
P 8807070 R4