

### Waste Water Services

**Please provide a copy extract from the public sewer map.**

Enclosed is a map showing the approximate lines of our sewers. Our plans do not show sewer connections from individual properties or any sewers not owned by Thames Water unless specifically annotated otherwise. Records such as "private" pipework are in some cases available from the Building Control Department of the relevant Local Authority. Where the Local Authority does not hold such plans it might be advisable to consult the property deeds for the site or contact neighbouring landowners. The public sewer map relates only to sewerage apparatus of Thames Water Utilities Ltd, it does not disclose details of cables and or communications equipment that may be running through or around such apparatus. The sewer level information contained in this response represents all of the level data available in our existing records. Should you require any further Information, please refer to the relevant section within the 'Further Contacts' page found later in this document.

For your guidance:

- The Company is not generally responsible for rivers, watercourses, ponds, culverts or highway drains. If any of these are shown on the copy extract they are shown for information only.
- Any private sewers or lateral drains which are indicated on the extract of the public sewer map as being subject to an agreement under Section 104 of the Water Industry Act 1991 are not an 'as constructed' record. It is recommended these details be checked with the developer.

### Clean Water Services

**Please provide a copy extract from the public water main map.**

Enclosed is a map showing the approximate positions of our water mains and associated apparatus. Please note that records are not kept of the positions of individual domestic supplies.

For your information, there will be a pressure of at least 10m head at the outside stop valve. If you would like to know the static pressure, please contact our Customer



Centre on 0800 316 9800. The Customer Centre can also arrange for a full flow and pressure test to be carried out for a fee.

For your guidance:

- Assets other than vested water mains may be shown on the plan, for information only.
- If an extract of the public water main record is enclosed, this will show known public water mains in the vicinity of the property. It should be possible to estimate the likely length and route of any private water supply pipe connecting the property to the public water network.

### Further contacts:

#### Waste Water queries

Should you require verification of the invert levels of public sewers, by site measurement, you will need to approach the relevant Thames Water Area Network Office for permission to lift the appropriate covers. This permission will usually involve you completing a TWOSA form. You can do this by emailing [customer.feedback@thameswater.co.uk](mailto:customer.feedback@thameswater.co.uk) with the email subject header 'Enquiry – TWOSA', along with details of the request.

If you have any questions regarding sewer connections, budget estimates, diversions or building over issues please direct them to our service desk which can be contacted by writing to:

Developer Services (Waste Water)  
Thames Water  
Clearwater Court  
Vastern Road  
Reading  
RG1 8DB

Tel: 0800 009 3921  
Email: [developer.services@thameswater.co.uk](mailto:developer.services@thameswater.co.uk)


#### Clean Water queries

Should you require any advice concerning clean water connections, please contact:

Developer Services (Clean Water)  
Thames Water  
Clearwater Court  
Vastern Road  
Reading  
RG1 8DB

Tel: 0800 009 3921  
Email: [developer.services@thameswater.co.uk](mailto:developer.services@thameswater.co.uk)

Asset Location Search Sewer Map - ALS/ALS/24/2025\_5139555

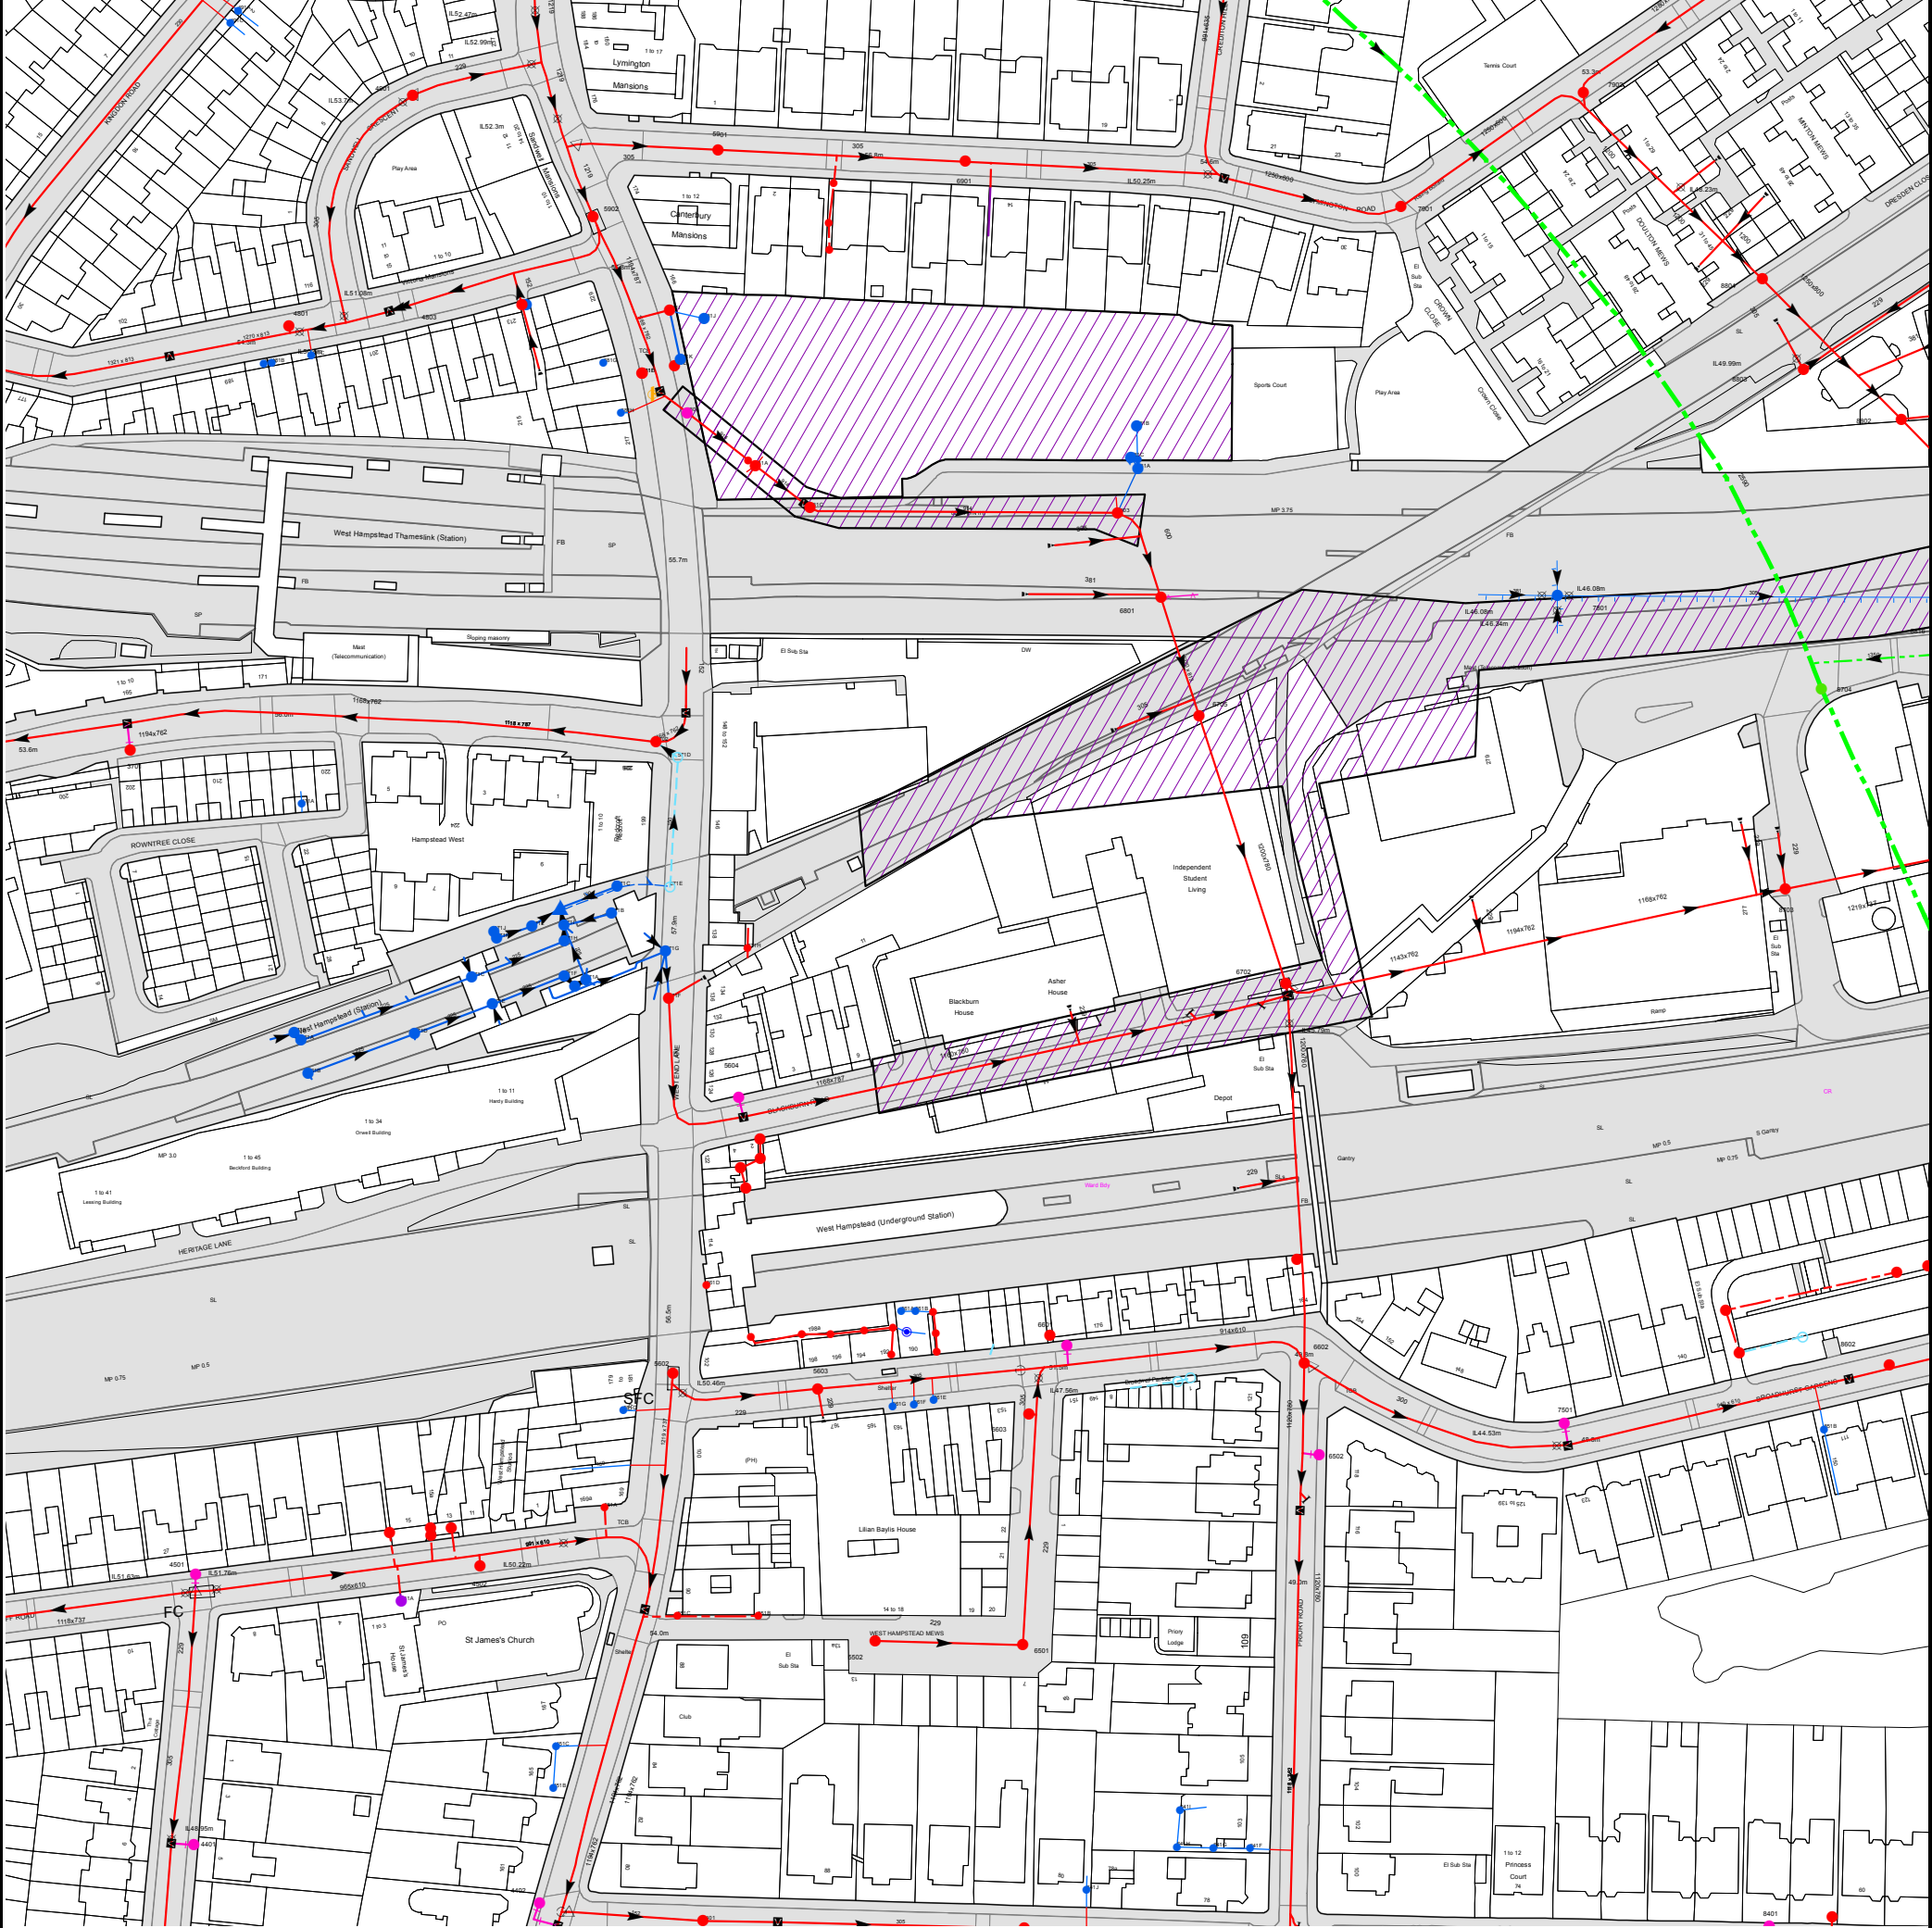

The width of the displayed area is 500 m and the centre of the map is located at OS coordinates 525602,184719  
The position of the apparatus shown on this plan is given without obligation and warranty, and the accuracy cannot be guaranteed. Service pipes are not shown but their presence should be anticipated. No liability of any kind whatsoever is accepted by Thames Water for any error or omission. The actual position of mains and services must be verified and established on site before any works are undertaken.

Based on the Ordnance Survey Map (2024) with the Sanction of the controller of H.M. Stationery Office, License no. AC0000849556 Crown Copyright Reserved.

NB. Levels quoted in metres Ordnance Newlyn Datum. The value -9999.00 indicates that no survey information is available

Manhole Reference	Manhole Cover Level	Manhole Invert Level
5902	56.84	52.16
5901	57.21	51.77
5907	n/a	n/a
5906	n/a	n/a
5908	n/a	n/a
6901	56.15	50.97
7901	53.34	49.07
7902	53.14	48.56
8804	n/a	n/a
8802	53.15	46.06
8602	47.38	43.41
86BC	n/a	n/a
86BB	n/a	n/a
6402	49.41	44.84
8401	n/a	n/a
8405	n/a	n/a
641J	n/a	n/a
641F	n/a	n/a
641G	n/a	n/a
641H	n/a	n/a
641I	n/a	n/a
6501	50.84	49.56
6502	n/a	n/a
851B	n/a	n/a
7501	n/a	n/a
6603	n/a	n/a
561F	n/a	n/a
561E	n/a	n/a
66BE	n/a	n/a
66BF	n/a	n/a
6602	49.87	45.06
76AC	n/a	n/a
56CD	n/a	n/a
6601	n/a	n/a
86BD	n/a	n/a
66DJ	n/a	n/a
56CC	n/a	n/a
56CB	n/a	n/a
561B	n/a	n/a
76AB	n/a	n/a
66CI	n/a	n/a
6702	50.83	46.18
8703	48.77	45.2
6705	n/a	46.25
8704	48.56	30.78
6801	48.05	46.42
7801	48.05	n/a
6803	48.34	46.65
681A	52.66	49.01
681C	52.9	48.11
681B	52.9	49.93
8803	52.01	49.2
451A	n/a	n/a
4502	n/a	n/a
4402	n/a	n/a
451B	n/a	n/a
451C	n/a	n/a
551C	n/a	n/a
5401	51.93	47.48
551B	n/a	n/a
5502	52.33	50.48
4507	n/a	n/a
4504	n/a	n/a
4505	n/a	n/a
4506	n/a	n/a
551A	n/a	n/a
561C	n/a	n/a
561G	n/a	n/a
5603	53.54	49.43
5602	55.89	49.55
56DD	n/a	n/a
56DC	n/a	n/a
56DA	n/a	n/a
56DB	n/a	n/a
56CJ	n/a	n/a
56CI	n/a	n/a
561A	n/a	n/a
561D	n/a	n/a
56BE	n/a	n/a
56BF	n/a	n/a
56BG	n/a	n/a
56BH	n/a	n/a
5604	n/a	n/a
461B	n/a	n/a
461A	n/a	n/a
471D	n/a	n/a
471B	n/a	n/a
471E	n/a	n/a
571E	n/a	n/a
571D	n/a	n/a
5702	155.96	151.43



Manhole Reference	Manhole Cover Level	Manhole Invert Level
481A	n/a	n/a
481B	n/a	n/a
581K	54.8	53.16
481C	n/a	n/a
581J	55.95	52.88
581I	56.21	52.81
4401	n/a	n/a
4501	55.34	n/a
4901	57.68	n/a
491C	n/a	n/a
491A	n/a	n/a
571F	n/a	n/a
471G	n/a	n/a
571A	n/a	n/a
471C	n/a	n/a
471F	n/a	n/a
571G	n/a	n/a
571H	n/a	n/a
471H	n/a	n/a
471K	n/a	n/a
471J	n/a	n/a
471L	n/a	n/a
471I	n/a	n/a
571B	n/a	n/a
571C	n/a	n/a
471A	n/a	n/a
581C	50.23	47.53
581A	55.17	47.62
581H	n/a	n/a
5803	55.64	51.24
581D	50.23	47.53
581F	50.23	47.53
581E	50.23	47.53
581G	n/a	n/a
4801	54.75	n/a
48AD	n/a	n/a
4803	n/a	n/a
3701	n/a	n/a
The position of the apparatus shown on this plan is given without obligation and warranty, and the accuracy cannot be guaranteed. Service pipes are not shown but their presence should be anticipated. No liability of any kind whatsoever is accepted by Thames Water for any error or omission. The actual position of mains and services must be verified and established on site before any works are undertaken.		



# Asset Location Search - Sewer Key

## Public Sewer Types (Operated and maintained by Thames Water)

	<b>Foul Sewer:</b> A sewer designed to convey waste water from domestic and industrial sources to a treatment works.
	<b>Surface Water Sewer:</b> A sewer designed to convey surface water (e.g. rain water from roofs, yards and car parks) to rivers or watercourses.
	<b>Combined Sewer:</b> A sewer designed to convey both waste water and surface water from domestic and industrial sources to a treatment works.
	<b>Storm Sewer</b>
	<b>Sludge Sewer</b>
	<b>Foul Trunk Sewer</b>
	<b>Surface Trunk Sewer</b>
	<b>Combined Trunk Sewer</b>
	<b>Foul Rising Main</b>
	<b>Surface Water Rising Main</b>
	<b>Combined Rising Main</b>
	<b>Vacuum</b>
	<b>Thames Water Proposed</b>
	<b>Vent Pipe</b>
	<b>Gallery</b>

## Other Sewer Types (Not operated and maintained by Thames Water)

	<b>Sewer</b>		<b>Culverted Watercourse</b>
	<b>Proposed</b>		<b>Decommissioned Sewer</b>
	<b>Content of this drainage network is currently unknown</b>		<b>Ownership of this drainage network is currently unknown</b>

### Notes:

- 1) All levels associated with the plans are to Ordnance Datum Newlyn.
- 2) All measurements on the plan are metric.
- 3) Arrows (on gravity fed sewers) or flecks (on rising mains) indicate the direction of flow.
- 4) Most private pipes are not shown on our plans, as in the past, this information has not been recorded.

## Sewer Fittings

A feature in a sewer that does not affect the flow in the pipe. Example: a vent is a fitting as the function of a vent is to release excess gas.

	<b>Air Valve</b>		<b>Meter</b>
	<b>Dam Chase</b>		<b>Vent</b>
	<b>Fitting</b>		

## Operational Controls

A feature in a sewer that changes or diverts the flow in the sewer. Example: A hydrobrake limits the flow passing downstream.

	<b>Ancillary</b>		<b>Drop Pipe</b>
	<b>Control Valve</b>		<b>Weir</b>

## End Items

End symbols appear at the start or end of a sewer pipe. Examples: an Undefined End at the start of a sewer indicates that Thames Water has no knowledge of the position of the sewer upstream of that symbol. Outfall on a surface water sewer indicates that the pipe discharges into a stream or river.

	<b>Inlet</b>		<b>Outfall</b>
	<b>Undefined End</b>		

## Other Symbols

Symbols used on maps which do not fall under other general categories.

	<b>Change of Characteristic Indicator</b>		<b>Public / Private Pumping Station</b>
	<b>Invert Level</b>		<b>Summit</b>

## Areas

Lines denoting areas of underground surveys, etc.

	<b>Agreement</b>
	<b>Chamber</b>
	<b>Operational Site</b>


## Ducts or Crossings

	<b>Casement</b>	Ducts may contain high voltage cables. Please check with Thames Water.
	<b>Conduit Bridge</b>	
	<b>Subway</b>	
	<b>Tunnel</b>	

5) 'na' or '0' on a manhole indicates that data is unavailable.

6) The text appearing alongside a sewer line indicates the internal diameter of the pipe in millimeters. Text next to a manhole indicates the manhole reference number and should not be taken as a measurement. If you are unsure about any text or symbology, please contact Property Searches on 0800 009 4540.

Asset Location Search Water Map - ALS/ALS/24/2025\_5139555

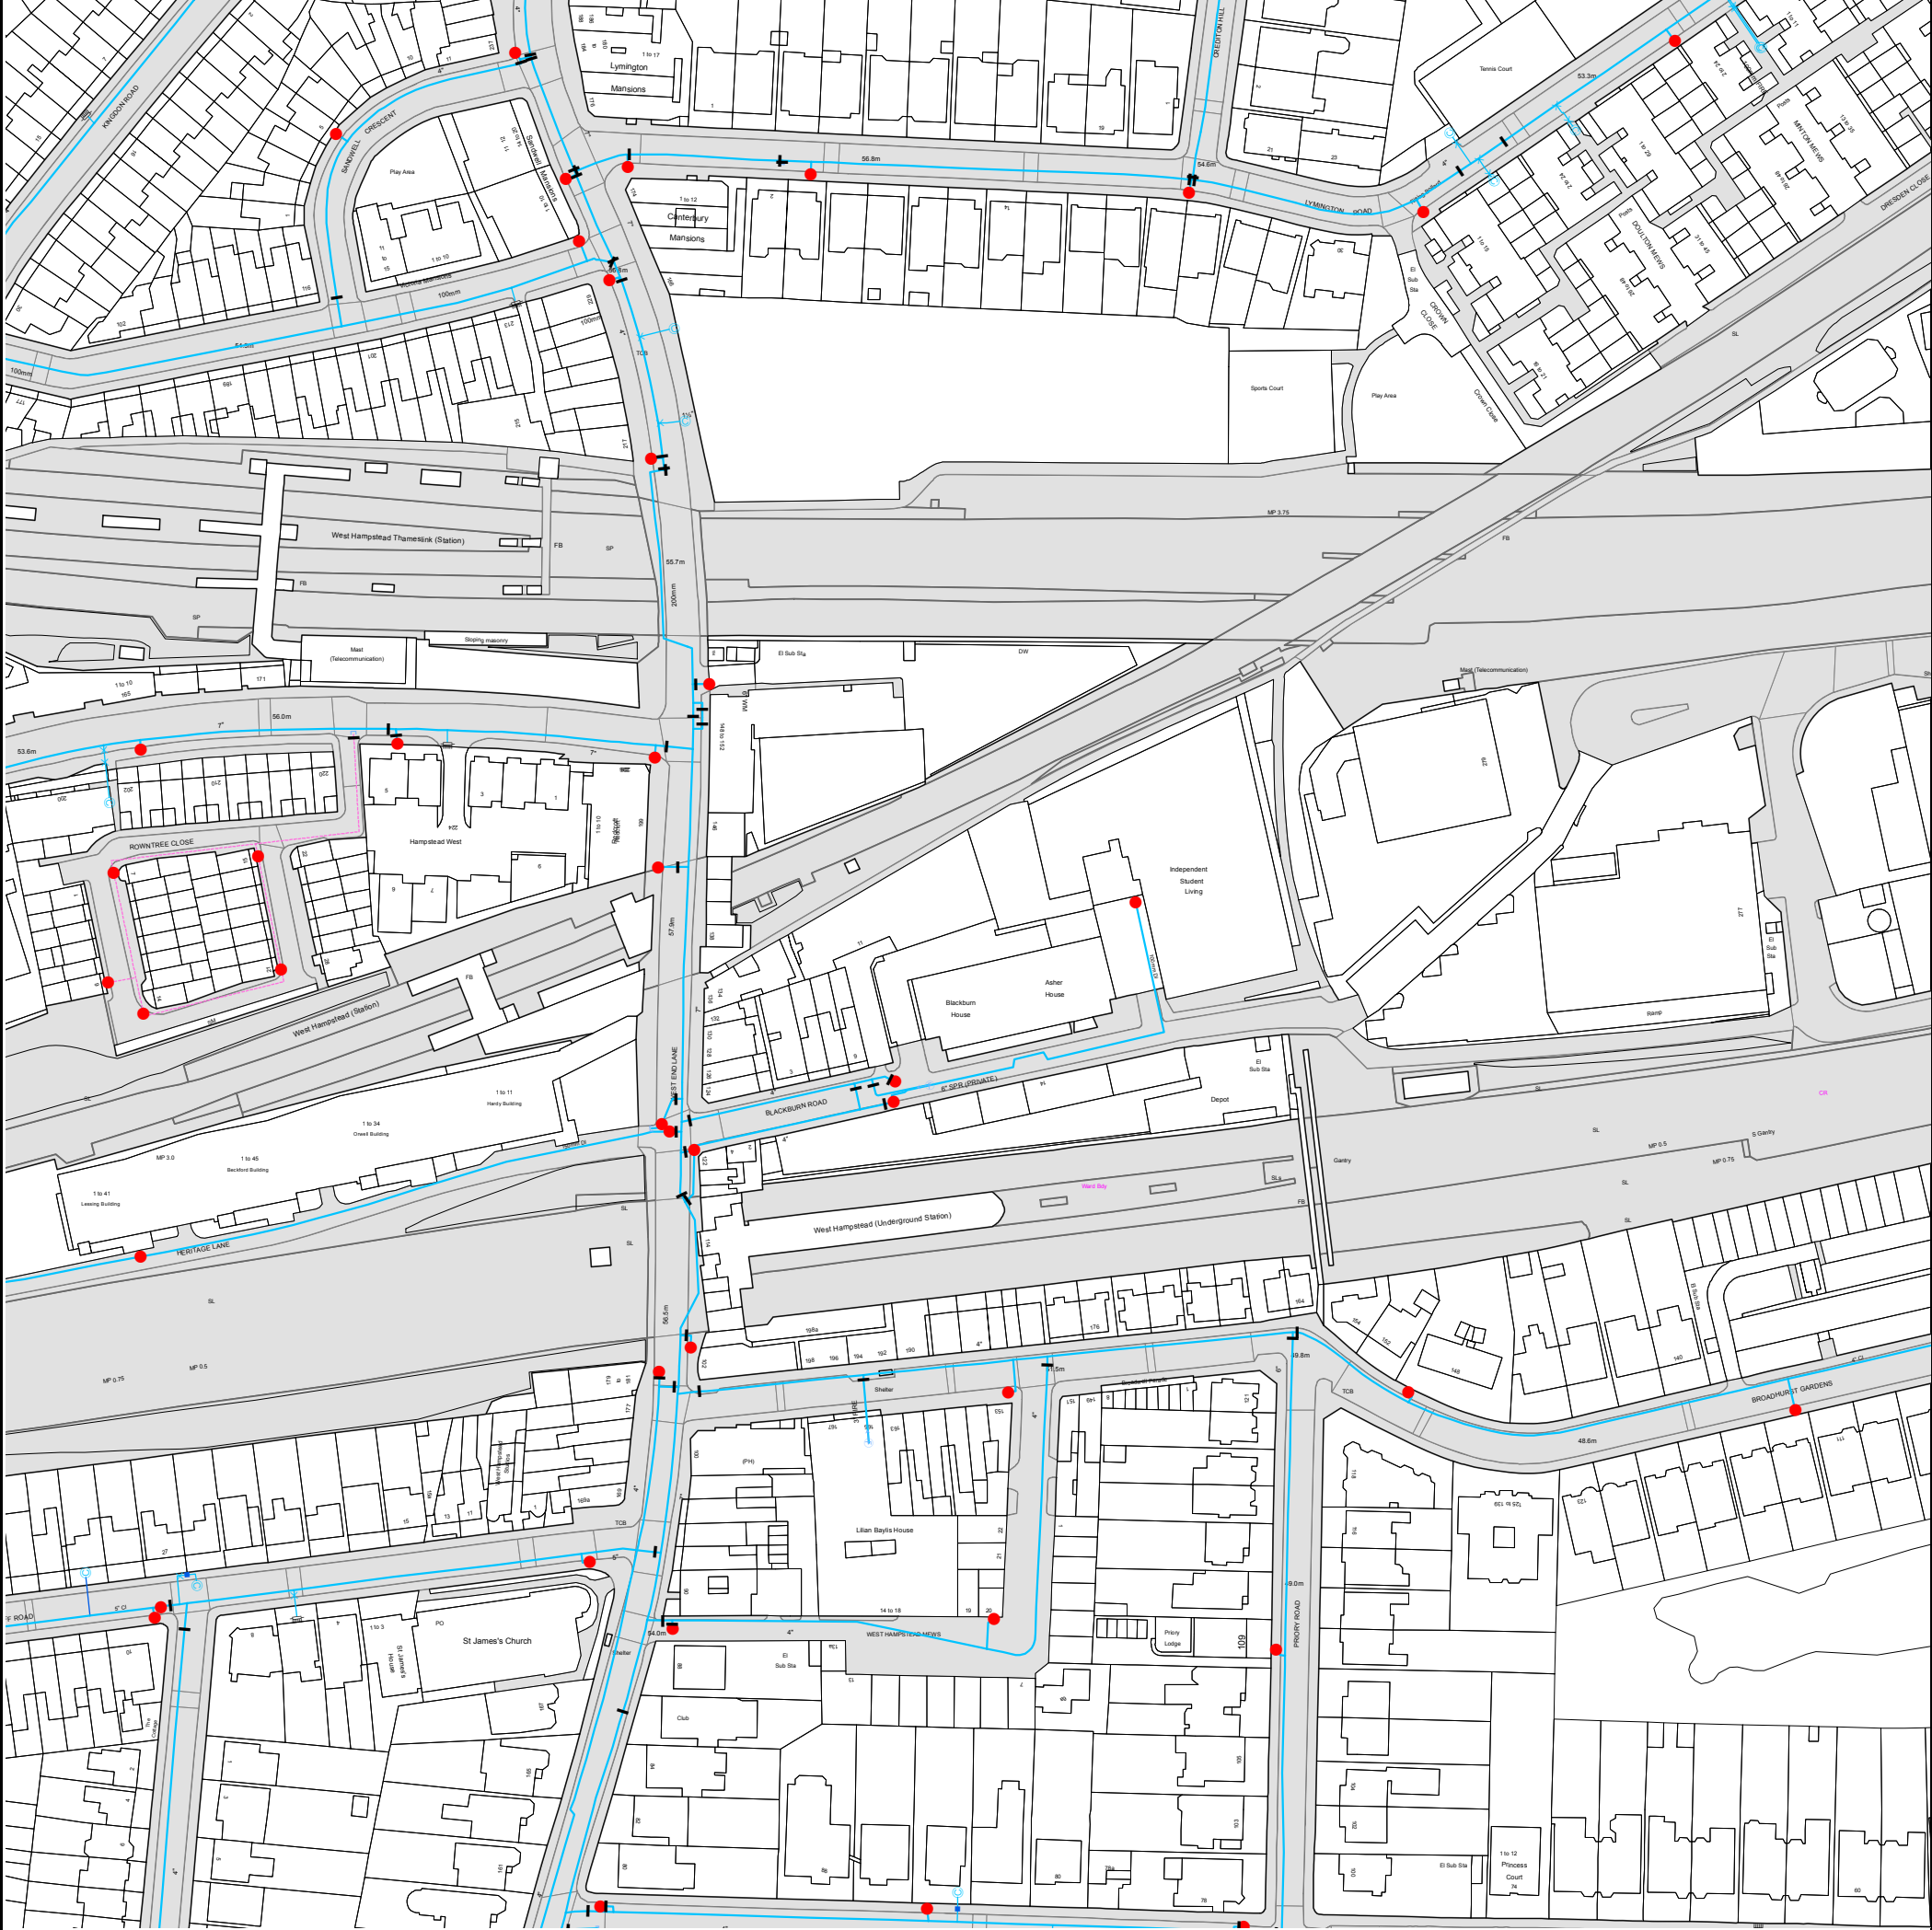

The width of the displayed area is 500 m and the centre of the map is located at OS coordinates 525602, 184719.  
The position of the apparatus shown on this plan is given without obligation and warranty, and the accuracy cannot be guaranteed. Service pipes are not shown but their presence should be anticipated. No liability of any kind whatsoever is accepted by Thames Water for any error or omission. The actual position of mains and services must be verified and established on site before any works are undertaken.

Based on the Ordnance Survey Map (2024) with the Sanction of the controller of H.M. Stationery Office, License no. AC0000849556 Crown Copyright Reserved.





# Asset Location Search - Water Key

## Water Pipes (Operated & Maintained by Thames Water)

- 4"** **Distribution Main:** The most common pipe shown on water maps. With few exceptions, domestic connections are only made to distribution mains.
- 16"** **Trunk Main:** A main carrying water from a source of supply to a treatment plant or reservoir, or from one treatment plant or reservoir to another. Also a main transferring water in bulk to smaller water mains used for supplying individual customers.
- 3" SUPPLY** **Supply Main:** A supply main indicates that the water main is used as a supply for a single property or group of properties.
- 3" FIRE** **Fire Main:** Where a pipe is used as a fire supply, the word FIRE will be displayed along the pipe.
- 3" METERED** **Metered Pipe:** A metered main indicates that the pipe in question supplies water for a single property or group of properties and that quantity of water passing through the pipe is metered even though there may be no meter symbol shown.
- Transmission Tunnel:** A very large diameter water pipe. Most tunnels are buried very deep underground. These pipes are not expected to affect the structural integrity of buildings shown on the map provided.
- Proposed Main:** A main that is still in the planning stages or in the process of being laid. More details of the proposed main and its reference number are generally included near the main.

PIPE DIAMETER	DEPTH BELOW GROUND
Up to 300mm (12")	900mm (3')
300mm - 600mm (12" - 24")	1100mm (3' 8")
600mm and bigger (24" plus)	1200mm (4')

## Valves

- General Purpose Valve
- Air Valve
- Pressure Control Valve
- Customer Valve

## Hydrants

- Single Hydrant

## Meters

- Meter

## End Items

Symbol indicating what happens at the end of a water main.

- Blank Flange
- Capped End
- Emptying Pit
- Undefined End
- Manifold
- Customer Supply
- Fire Supply

## Operational Sites

- Booster Station
- Other
- Other (Proposed)
- Pumping Station
- Service Reservoir
- Shaft Inspection
- Treatment Works
- Unknown
- Water Tower

## Other Symbols


- Data Logger
- Casement:** Ducts may contain high voltage cables. Please check with Thames Water.

## Other Water Pipes (Not Operated or Maintained by Thames Water)

- Other Water Company Main:** Occasionally other water company water pipes may overlap the border of our clean water coverage area. These mains are denoted in purple and in most cases have the owner of the pipe displayed along them.
- Private Main:** Indicates that the water main in question is not owned by Thames Water. These mains normally have text associated with them indicating the diameter and owner of the pipe.



# Maps on Demand Plant Information Reply

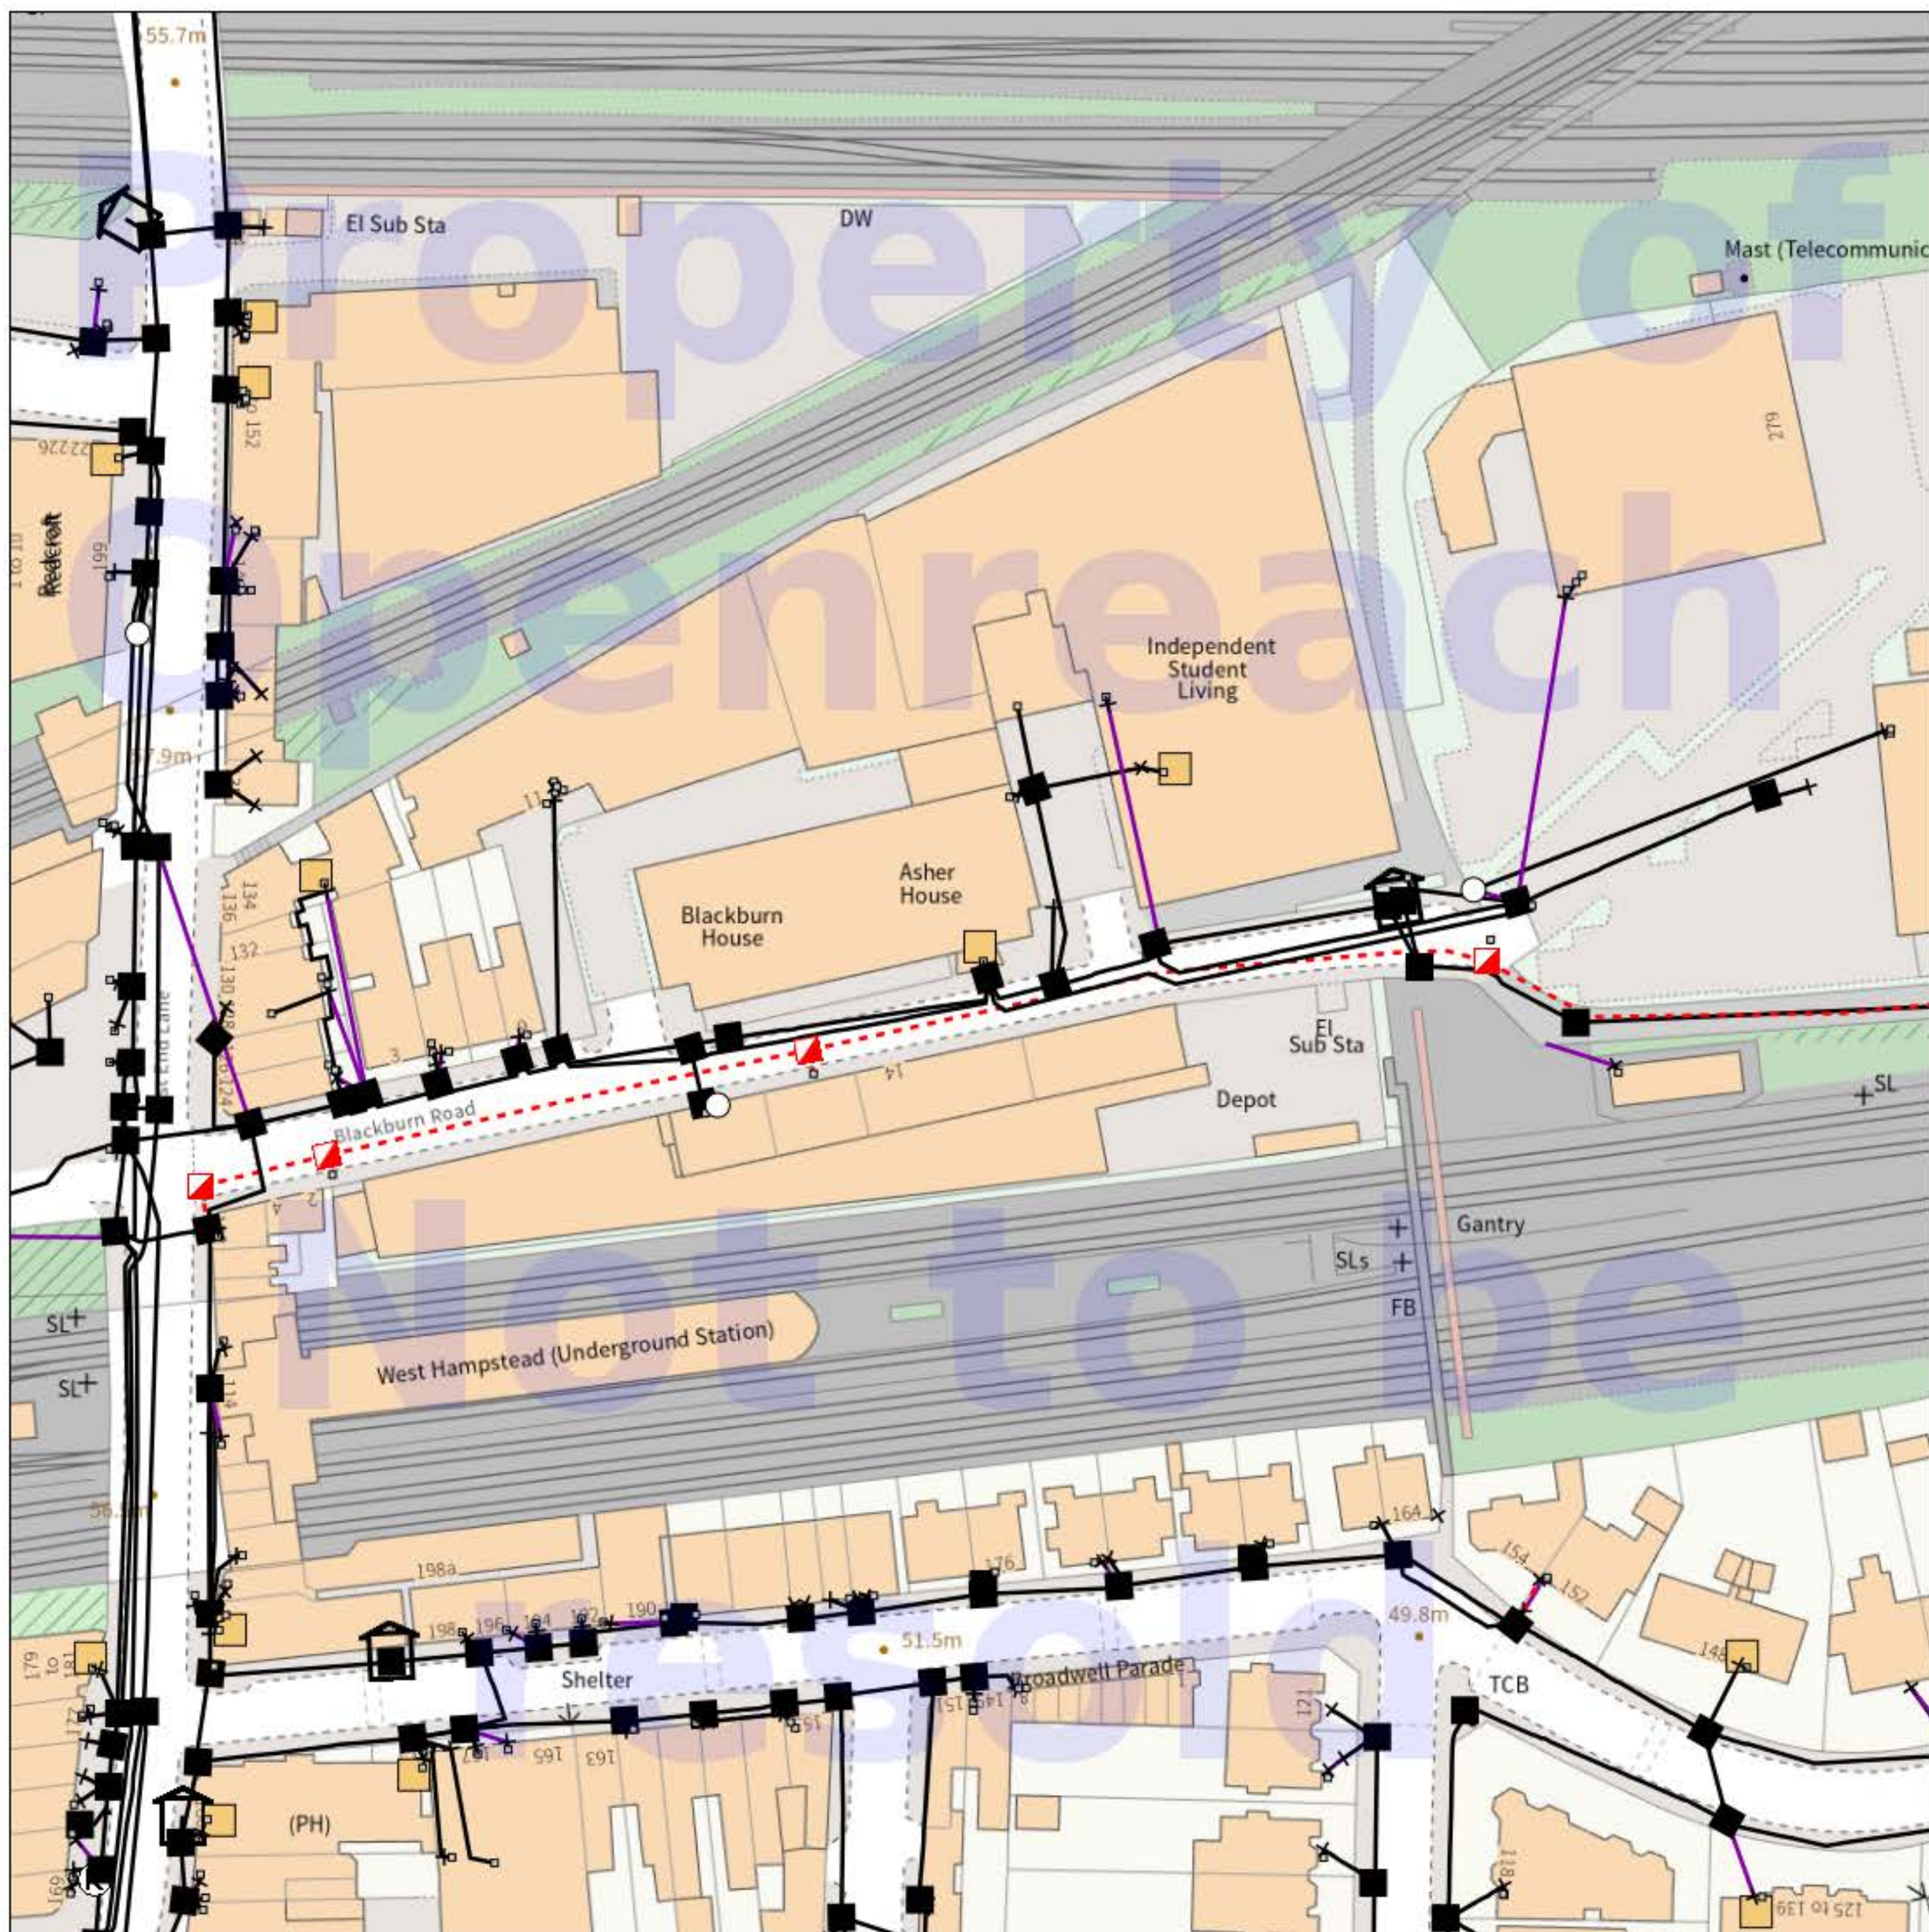

## IMPORTANT WARNING

Information regarding the location of BT apparatus is given for your assistance and is intended for general guidance only. No guarantee is given of its accuracy. It should not be relied upon in the event of excavations or other works being made near to BT apparatus which may exist at various depths and may deviate from the marked route.

**openreach**

## CLICK BEFORE YOU DIG

FOR PROFESSIONAL FREE ON SITE ASSISTANCE PRIOR TO COMMENCEMENT OF EXCAVATION WORKS INCLUDING LOCATE AND MARKING SERVICE

email [cbyd@openreach.co.uk](mailto:cbyd@openreach.co.uk)

ADVANCE NOTICE REQUIRED  
(Office hours: Monday - Friday 08.00 to 17.00)  
[www.openreach.co.uk/cbyd](http://www.openreach.co.uk/cbyd)

## Accidents happen

If you do damage any Openreach equipment please let us know by calling 0800 023 2023 (opt 1 + opt 1) and we can get it fixed ASAP

© Crown copyright 2023 OS 100028040. You are permitted to use this data solely to enable you to respond to, or interact with, the organisation that provided you with the data. You are not permitted to copy, sub-license, distribute or sell any of this data to third parties in any form.

## KEY TO BT SYMBOLS

	Planned	Live	Change Of State	+	Hatchings	
PCP			Split Coupling	×	Built	
Pole			Duct Tee	▲	Planned	
Box			Building		Inferred	
Manhole			Kiosk		Duct	
Cabinet			Other proposed plant is shown using dashed lines. BT Symbols not listed above may be disregarded. Existing BT Plant may not be recorded. Information valid at time of preparation. Maps are only valid for 90 days after the date of publication.			
	Pending Add	In Place	Pending Remove	Not In Use		
Power Cable						
Power Duct				N/A		

BT Ref : MLF14458S

Map Reference : (centre) TQ2563084701

Easting/Northing : (centre) 525630,184701

Scale : 1:250

Issued : 25/03/2025 14:45:53

**WARNING: IF PLANNED WORKS FALL INSIDE HATCHED AREA IT IS ESSENTIAL BEFORE PROCEEDING THAT YOU CONTACT THE NATIONAL NOTICE HANDLING CENTRE. PLEASE SEND E-MAIL TO: [nnhc@openreach.co.uk](mailto:nnhc@openreach.co.uk)**



---

LSBUD Job No: 36742219

---

From GNetwork@safedigs.co.uk <GNetwork@safedigs.co.uk>

Date Tue 2025-03-25 11:38 AM

To Bradley Inston <bradley.inston@apogeepropertyandutilityconsultants.com>

 1 attachment (154 KB)

LSBUD Job No 36742219 - G.Network Communication Plan.pdf;

**Caution:** This email originated from outside of the organisation. Do not click links or open attachments unless you recognise the sender and know the content is safe.



**G.Network Communications Limited**

69 Wilson Street

London

EC2A 2BB

Date: 25 Mar 2025

To: Mr Bradley Inston

---

**G.Network Enquiry Response**

**Please DO NOT SEND A REPLY to this email as it has been automatically generated and replies are not monitored.**

We acknowledge with thanks your LSBUD request (referenced below) dated 25 Mar 2025 11:37:04 AM for information on the location of our assets.

**LSBUD REFERENCE:**

36742219

**YOUR REFERENCE:**

428955

Enclosed is a plan showing the approximate position of G.Network assets within your area of interest. Our records indicate that network apparatus exists near to the area of your proposed works

**WARNING: When working in the vicinity of G.Network assets you have a legal Duty of Care that must be observed.**

The information shown on the attached plan is given without obligation or warranty and its accuracy cannot be guaranteed. Safe digging practices in accordance with HSE publication HSG47 "[Avoiding danger from underground services](#)" must be used to

verify and establish the actual position of the assets before any mechanical plant is used.

Please find enclosed a copy of our above referenced drawing, marked to show the approximate position of plant owned and operated by G.Network.

You will be aware that you have a duty to ensure that no damage is caused to this equipment as a result of your proposed works. Please note that this apparatus may contain Fibre Optics and, as such, special care must be taken when excavating this area.

If you require advice in connection with your search, please contact the relevant number below.

Yours sincerely,

**G.Network**

T: [0800 035 0708](tel:0800 035 0708)

E: [Gnetworkdiversions@jsmgroup.com](mailto:Gnetworkdiversions@jsmgroup.com)

LinesearchbeforeUdig:

If you have an enquiry relating to the use of the LinesearchbeforeUdig website, please contact LinesearchbeforeUdig using the following information:

Telephone: [345 437 7365](tel:345 437 7365)

Email: [enquiries@lsbud.co.uk](mailto:enquiries@lsbud.co.uk)

Website: [www.lsbud.co.uk](http://www.lsbud.co.uk)

---

### Important Notice


This enquiry response, including any associated documentation, has been assessed and compiled from the information detailed within the LSBUD enquiry outlined above. **Please ensure that the LSBUD enquiry details and this response accurately reflect your proposed works.**

This response is intended for use only by the addressee. If you have received the enquiry response in error, please let us know by telephone and delete all copies; you are advised that copying, distributing, disclosing or otherwise acting in reliance on the response is expressly prohibited. Full terms can be found at [www.lsbud.co.uk]www.lsbud.co.uk

**Disclaimer:** While reasonable measures have been taken to ensure the accuracy of the information contained in this plan response, neither G.Network nor PelicanCorp shall have any liability whatsoever in relation to any loss, damage, cost or expense arising from the use of this plan response or the information contained in it or the completeness or accuracy of such information. Use of such information is subject to and constitutes acceptance of these terms. Full terms can be found at [www.lsbud.co.uk]www.lsbud.co.uk

If you are unable to launch any of the files for viewing and printing, you may need to download and install free viewing and printing software such as [Adobe Acrobat Reader \(for PDF files\)](#).



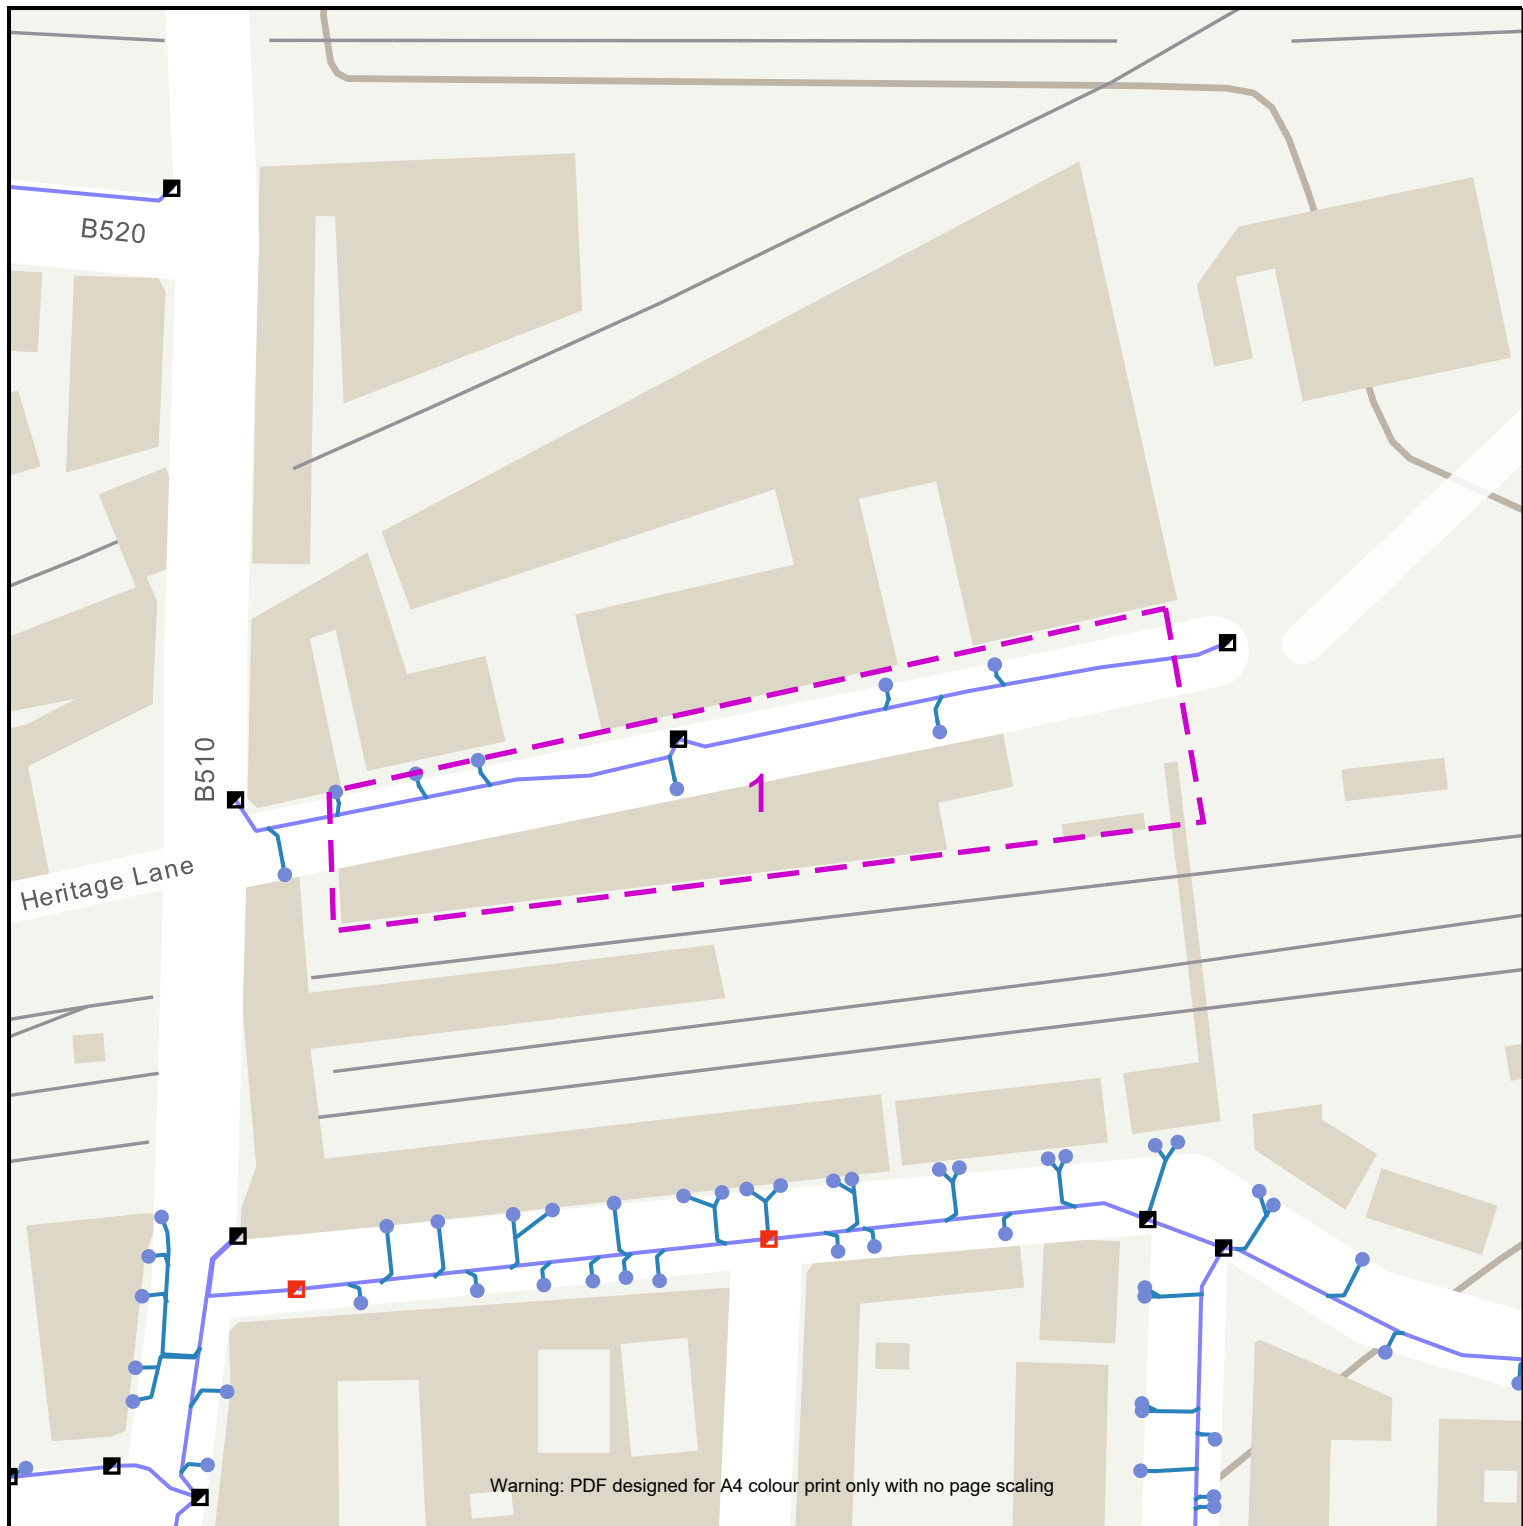

Warning: PDF designed for A4 colour print only with no page scaling

**G.Network**  
100% FIBRE CONNECTIVITY

0 100m Dig Sites Line: Area:

- |                |                        |                      |                      |           |
|----------------|------------------------|----------------------|----------------------|-----------|
| Lateral        | Access Chamber 300x300 | CW3 Chamber 675x1800 | FW3 Chamber 740x2267 | Built Cab |
| Main Duct      | BT Chamber (PIA)       | FW1 Chamber 445x914  | COLT                 |           |
| <b>Chamber</b> | CW1 Chamber 675x675    | FW2 Chamber 610x1310 | Toby                 |           |
| 500x500 Infil  | CW2 Chamber 675x1200   |                      |                      |           |

#### IMPORTANT WARNING

The information supplied is given in good faith as a guide to locating underground apparatus. Its accuracy cannot be guaranteed, nor does it include comprehensive information about the existence or location of service pipes or cables to individual premises. The responsibility for locating and avoiding damage to apparatus on site shall be that of the persons proposing to excavate in the street shall be liable to the apparatus owner and any third party who may be affected in any way for any loss or damage caused by their failure to do so.

**IF IN DOUBT PLEASE ASK!**  
**PHONE: 0800 538 5542**

Date Requested: 25/03/2025  
Job Reference: 36742219  
Site Location: 525651 184701  
Requested by: Mr Bradley Inston

Your Scheme/Reference:  
428955

Scale: 1:1250 (When plotted on A4)

Ordnance Survey, OS, the OS Logos and the Product are registered trademarks of Ordnance Survey.

Contact us:  
Tel: 0800 035 0708  
Email: [Gnetworkdiversions@jsmgroup.com](mailto:Gnetworkdiversions@jsmgroup.com)

## Enquirer

Name	Mr Bradley Inston	Phone	01952686570
Company	Apogee Property and Utility Consultants	Mobile	07425237322
Address	Hadley Park East Hadley Park East Telford SHR TF1 6QJ		
Email	bradley.inston@apogeeutilityconsultants.co.uk		


## Enquiry Details

Enquiry type	Initial Enquiry
Work category	Utility Works
Work type	Multiple excavations site (1.5m or shallower)
Work type buffer*	25 metres
Start date	26/03/2025
End date	26/03/2025
Scheme/Reference	428955
Search location	NW61RZ
Confirmed location	525651 184701
Site size	4196 metres square
Site Contact Name	Not Supplied
Site Phone No.	Not Supplied

### Description of Works

\* The WORK TYPE BUFFER is a distance added to your search area based on the Work type you have chosen.

## Site Map

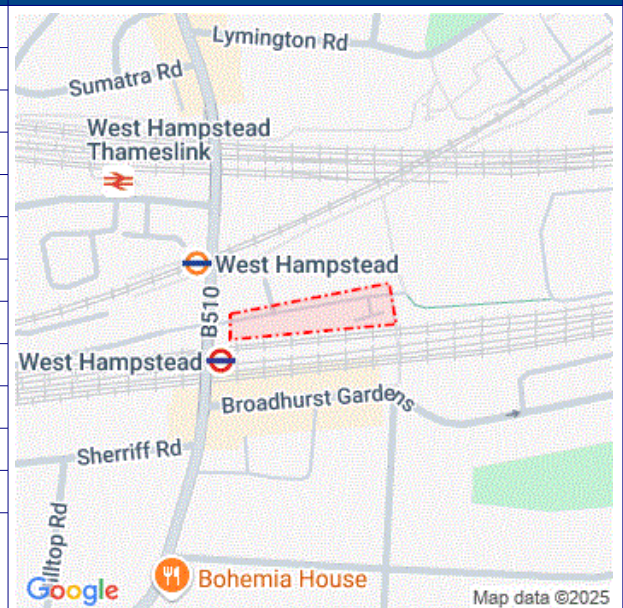

Please note that the above map only displays the location of the proposed work site and will not display any of the Members' pipes and cables. It is imperative that this area accurately reflects the proposed work site.

## Affected LSBUD members

(LSBUD Members who have assets registered on LSBUD within the vicinity of your search area.)

Do not proceed until all Members listed below have confirmed that your works can continue.

Asset Owner	Phone/Email	Emergency Only	Status
Cadent Gas	0800688588	0800111999	Await response
ESP Utilities Group	01372227560	01372227560	Await response
G.Network Communication Ltd c/o JSM Group Ltd	08000350708	08000350708	Await response
National Grid Electricity Transmission	08000014282	0800404090	Await response
TfL – London Underground HV Cables (Road & Track Side Cables)			Await response
UK Power Networks	08000565866	08000565866	Await response
Zayo Group UK Ltd c/o JSM Group Ltd	01992 655 919	0800 169 1646	Await response

## Status explanation

**Await Response** means that the asset owner will contact you. This is typically by sending the plan response but they may ask for further information before being able to do so, particularly if any payments or authorisations are required.

**Email Additional Info** means that the asset owner needs further information about your works to assess your enquiry before providing a response. Please provide any details you have available including plans, method statements etc. if available.

## Important notices

It is very important that you correctly understand what the service does and the procedures in order for you to work safely. Please refer to the LSBUD Support Page ([www.lsbud.co.uk/lineasearchbeforeudig-support](http://www.lsbud.co.uk/lineasearchbeforeudig-support)) for further guidance.

This information includes how to provide additional information to the LSBUD Members who request it to provide a response to your enquiry.

**Validity and search criteria.** The results of this enquiry are based on the confirmed information you entered and are valid only as at the date and time of the enquiry. It is your responsibility to ensure that the Enquiry Details are correct, and LineasearchbeforeUdig (LSBUD) accepts no responsibility for any errors or omissions in the Enquiry Details or any consequences thereof. LSBUD Members update their asset information on a regular basis so you are advised to consider this when undertaking any works. It is your responsibility to choose the period of time after which you need to resubmit any enquiry but the maximum time (after which your enquiry will no longer be dealt with by the LSBUD Helpdesk and LSBUD Members) is 28 days. If any details of the enquiry change, particularly including, but not limited to, the location of the work, then a further enquiry must be made.

**Terms and Conditions.** Please note that this enquiry is subject always to our standard terms and conditions available at [www.lsbud.co.uk](http://www.lsbud.co.uk) ("Terms of Use") and the disclaimer at the end of this document. Please note that in the event of any conflict or ambiguity between the terms of this Enquiry Confirmation and the Terms of Use, the Terms of Use shall take precedence.

## List of not affected LSBUD members

(LSBUD Members who do not have assets registered on the LSBUD service within the vicinity of your search area.)

AllPoints Fibre	Angus Energy	AWE Pipeline
B & D Energy Limited	Balfour Beatty Investments Limited	BOC Limited (A Member of the Linde Group)
Box Broadband	BP Exploration Operating Company Limited	BPA
Cambridge Water	Cambridgeshire County Council Climate Change and Energy Services	CATS Pipeline c/o Wood Group PSN
Cemex	Centrica Storage Ltd	CNG Services Ltd
Concept Solutions People Ltd	ConocoPhillips (UK) Teesside Operator Ltd	D.S.Smith
Diamond Transmission Corporation	DIO (MOD Live Pipelines)	Drax Power Limited
EDF Energy Renewables Ltd	EET Fuels	EirGrid
Eleclink Limited	Electricity North West Limited	Energy Assets Networks
ENI & Himor c/o Penspen Ltd	EnQuest NNS Limited	EP Langage Limited
ESB CCGT Power station (Carrington Gas Pipeline)	Esso Petroleum Company Limited	euNetworks Fiber UK Ltd
EXA Infrastructure	Exolum Pipeline System	Fulcrum Electricity Assets Limited
Fulcrum Pipelines Limited	Gamma	Gas Networks Ireland (UK)
Gateshead Energy Company	Gigaclear Ltd	Greenlink Interconnector Ltd
Harbour Energy	Heathrow Airport LTD	Humbly Grove Energy
IGas Energy	Impala Terminals Infrastructure Ltd	INEOS FPS Pipelines
INEOS Manufacturing (Scotland and TSEP)	INOVYN ChlorVinyls Limited	INOVYN Enterprises Limited
Intergen (Coryton Energy or Spalding Energy)	Kensa Utilities	Last Mile
Liverpool City Region Connect	Mainline Pipelines Limited	Manchester Jetline Limited
Manx Cable Company	Marchwood Power Ltd (Gas Pipeline)	Melbourn Solar Limited
MUA Group Limited	National Gas Transmission	National Grid Electricity Distribution
National Grid Ventures	Neos Networks	Northern Gas Networks Limited
Northumbrian Water Group	NPower CHP Pipelines	NTT Global Data Centers EMEA UK Ltd
NYnet Ltd	Ogi	Oikos Storage Limited
Ørsted	Palm Paper Ltd	Perenco UK Limited (Purbeck Southampton Pipeline)
Petroineos	Phillips 66	Portsmouth Water
Premier Transmission Ltd (SNIP)	Redundant Pipelines - LPDA	RWE - Great Yarmouth Pipeline (Bacton to Great Yarmouth Power Station)
RWEnpower (Little Barford and South Haven)	SABIC UK Petrochemicals	SAS Utility Services Ltd
Scottish and Southern Electricity Networks	Scottish Power Generation	Seabank Power Ltd
SES Water	SGN	Shell
Shell NOP	South Staffs Water	SP Energy Networks
Spring Fibre Limited	Squire Energy Networks	SSE Generation Ltd










 








## Location Search

Enter Location


Search

## Marker Visibility

-  EE (Orange)
-  EE (T-Mobile)
-  EE
-  O2
-  Three
-  Vodafone
-  BT TE
-  Airwaves
-  MBNL
-  Network Rail
-  LPA Apvd < 4y
-  LPA Apvd < 10y
-  LPA Apvd +
-  LPA Ref/Wdn
-  LPA Other
-  Centre Point

 Show All Hide All

Use the panel above to select which marker types you want visible on the map.

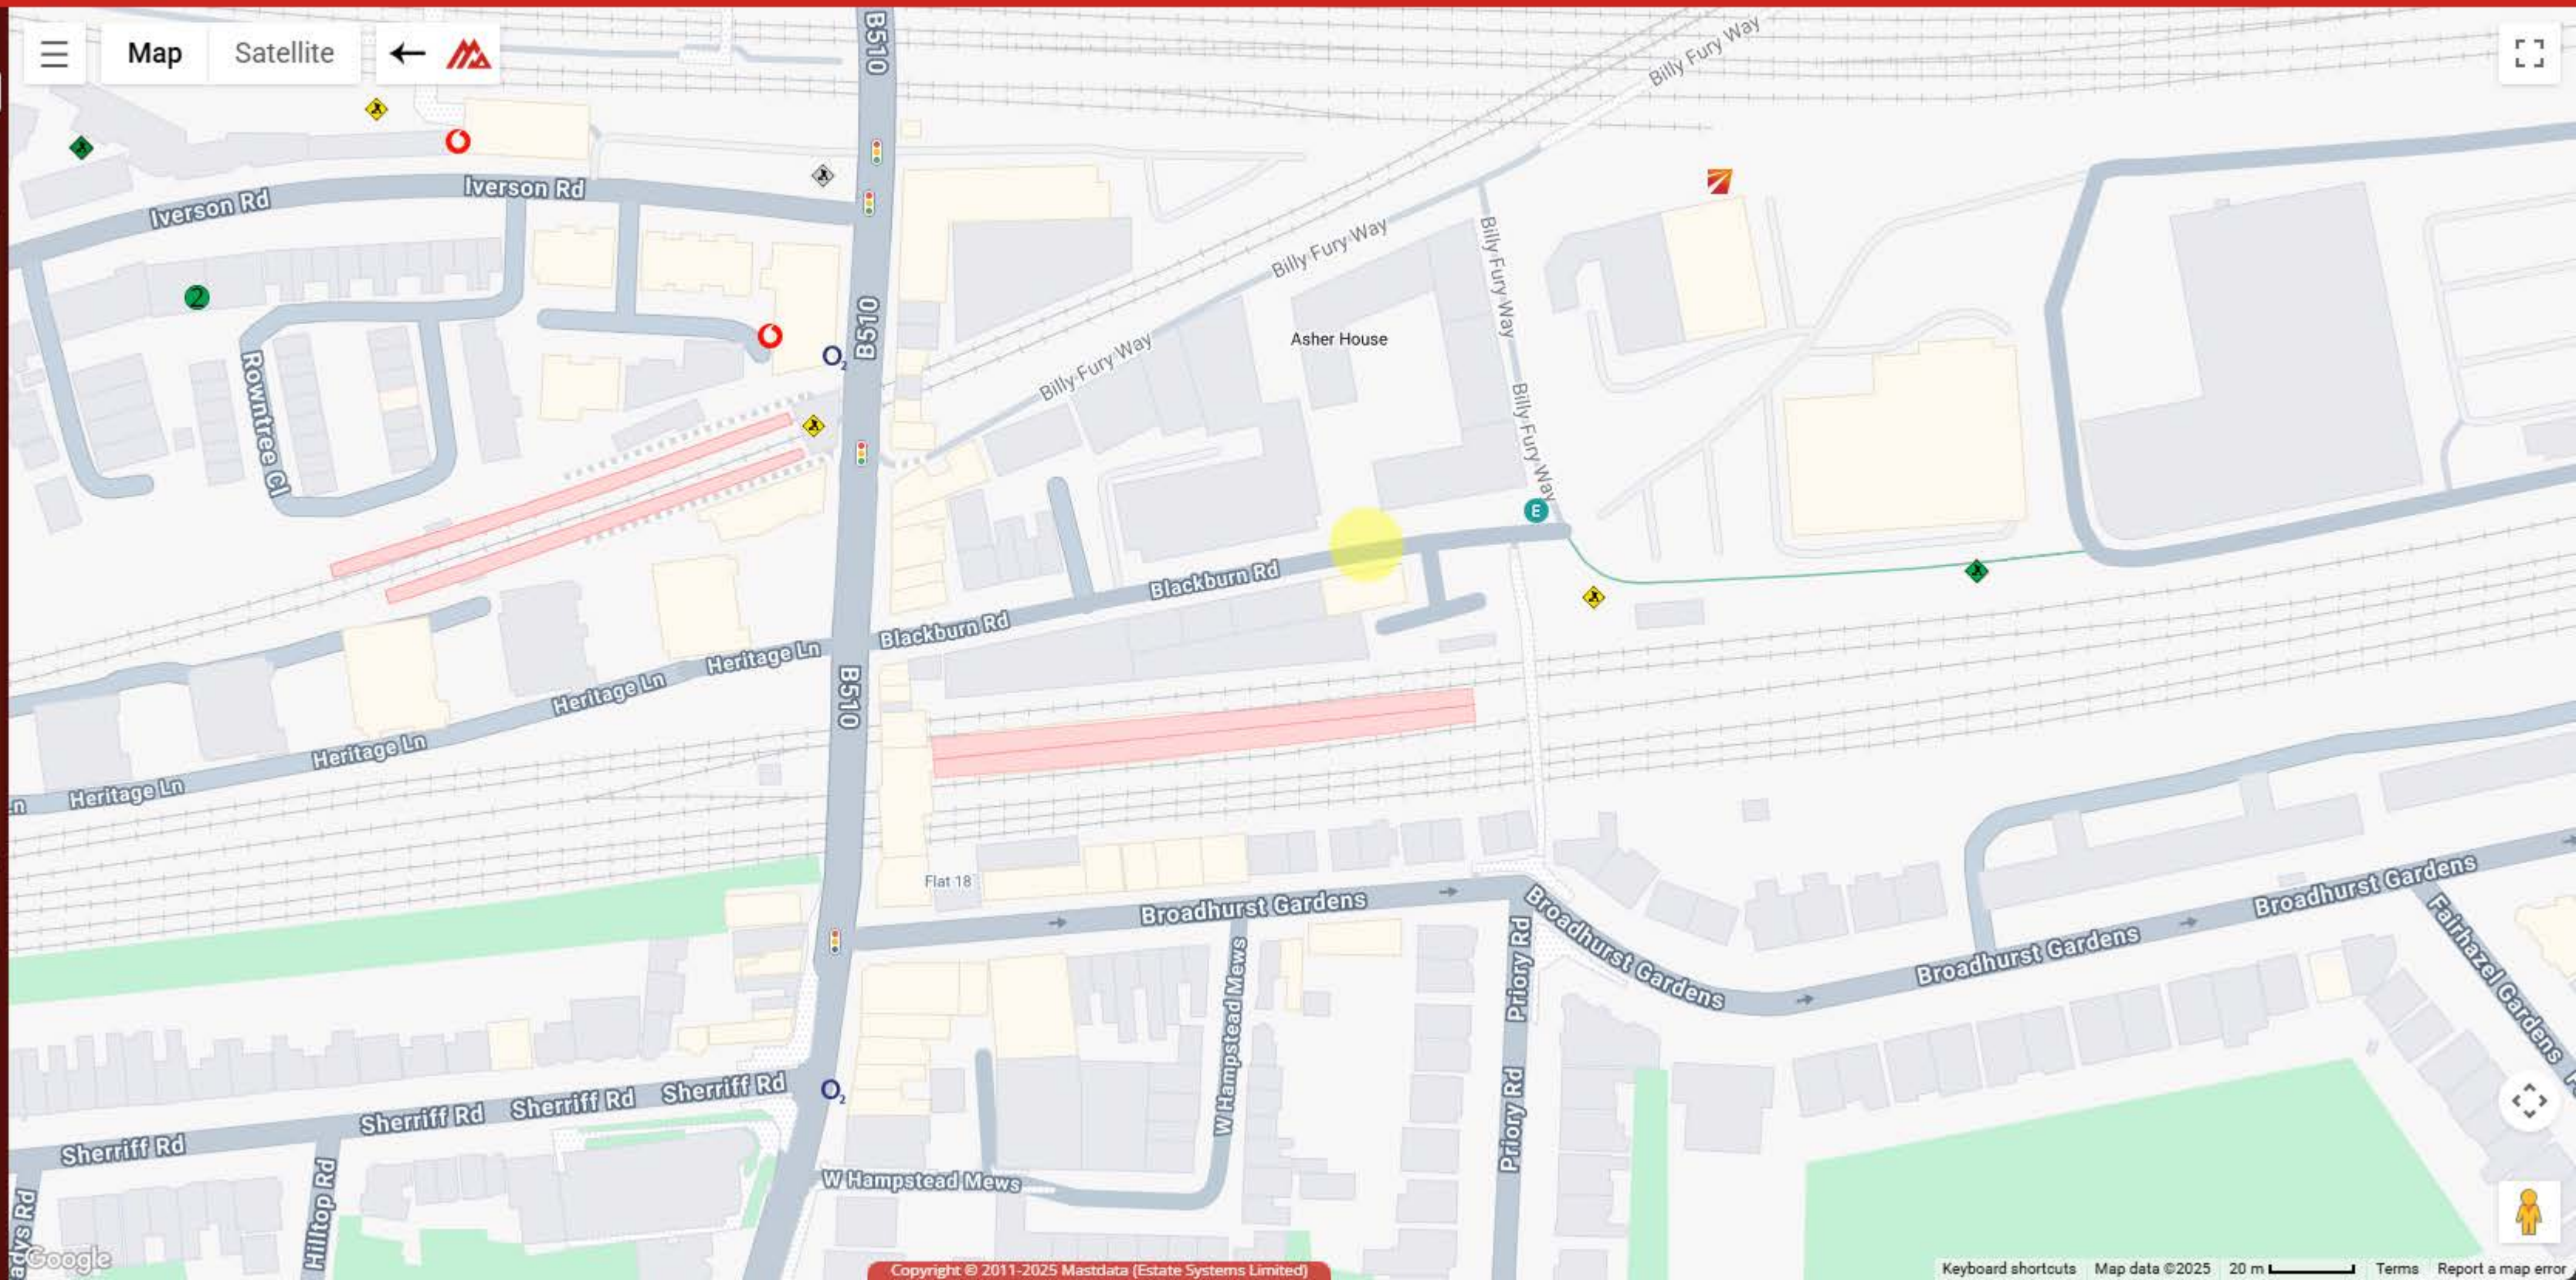



---

**TfL – London Underground HV Cables LSBUD Ref. 36742219**

---

**From** tfl\_lu\_hvcables@safedigs.co.uk <tfl\_lu\_hvcables@safedigs.co.uk>

**Date** Tue 2025-03-25 11:40 AM

**To** Bradley Inston <bradley.inston@apogeepropertyandutilityconsultants.com>

 8 attachments (3 MB)

LUA-24-6102.pdf; LUA-24-6103.pdf; MPW-BBES-POW-A001\_0-DR-W-5014.pdf; MPW-BBES-POW-A001\_0-DR-W-5015.pdf; R2511\_14.pdf; R2511\_14A.pdf; R2511\_14B.pdf; R2511\_14C.pdf;

**Caution:** This email originated from outside of the organisation. Do not click links or open attachments unless you recognise the sender and know the content is safe.

25/03/2025

LSBUD ref: 36742219

Your ref: 428955

Dear Sir/Madam,

**TfL – London Underground HV Cables**

We acknowledge receipt of your New Roads & Street Works Act Enquiry dated 25/03/2025.

After a review our records, we can confirm that London Underground does have assets within the specified search area of your enquiry detailed in the location provided.

For your reference, please find attached the relevant drawings:

Drawing No(s): LUA-24-6102.pdf, LUA-24-6103.pdf, MPW-BBES-POW-A001\_0-DR-W-5014.pdf, MPW-BBES-POW-A001\_0-DR-W-5015.pdf, R2511\_14.pdf, R2511\_14A.pdf, R2511\_14B.pdf, R2511\_14C.pdf

It is important to note that the attached drawings may indicate approximate locations and their accuracy cannot be guaranteed.

When conducting excavation work near our assets, we strongly recommend a cautious approach, utilising exclusively hand-digging methods. We emphasise the importance of adhering to safe digging practices, as outlined in the HSE publication HSG47.

We kindly request that you share this information with any contractors or subcontractors involved in your planned works. Please be aware that some of our cable ducts may be utilised by third parties, and detailed records for such usage may be unavailable.

For all C3 and C4 diversionary estimate requests related to diversionary works under the New Roads and Street Works Act 1991, please direct your enquiries to the London Underground, Drawing Services Team at [LULHVPowerassets@tfl.gov.uk](mailto:LULHVPowerassets@tfl.gov.uk)

In the event of a cable strike, please contact our Shift Supply Engineer immediately for assistance on 0207 0276833. Please note this is an emergency number and must only be used for cable strikes.

Please be advised that this information is valid for a period of three months. If your planned works are scheduled to commence three months or more from the date of this communication, we kindly request that you reapply for any updated information.


Yours sincerely,

**Drawing Services Team**

DENOTES EXPOSED CABLE ROUTE

DENOTES BURIED/HIDDEN CABLE ROUTE

- NOTE:
- 1. ALL DIMENSIONS ARE IN METRES UNLESS OTHERWISE NOTED
  - 2. FOR SECTION DETAILS REFER TO DWG. Nos. LUA-24-6102/A.
  - 3. CONCESSION CR 821X "SHEATH MARKING AND CORE IDENTIFICATION"

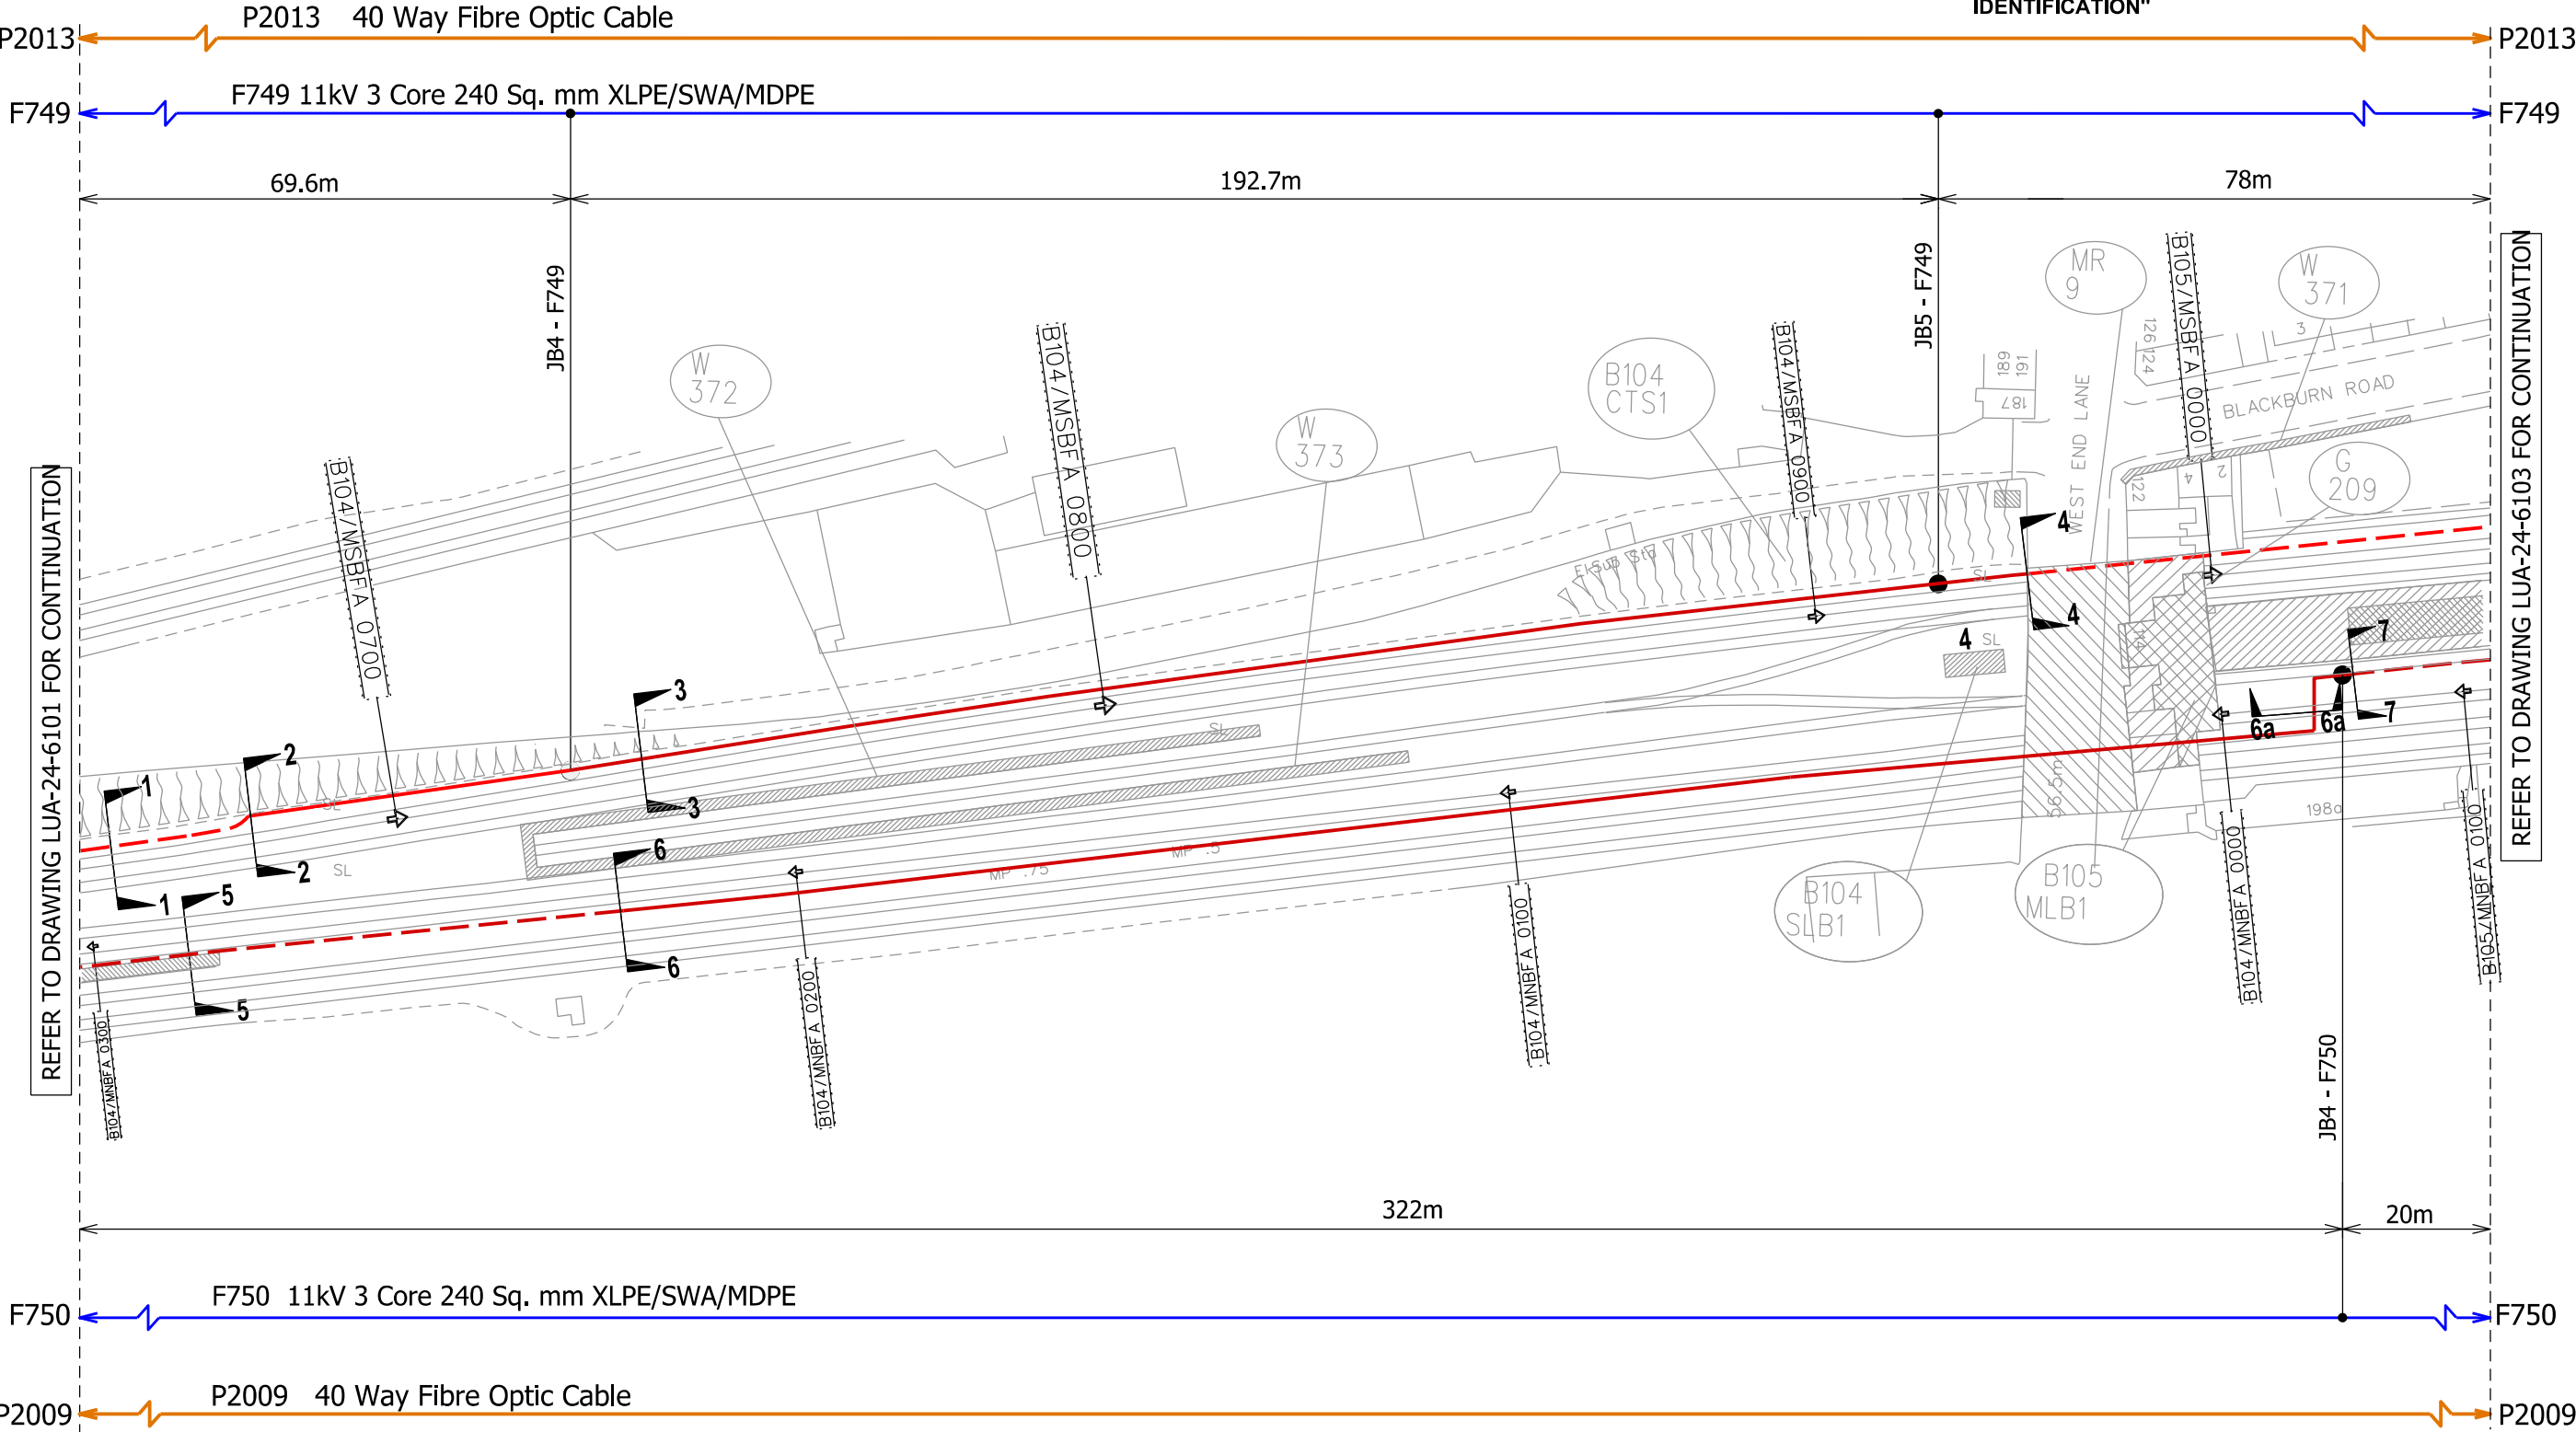

REFER TO DRAWING LUA-24-6101 FOR CONTINUATION

REFER TO DRAWING LUA-24-6103 FOR CONTINUATION

OS Reference

Where applicable: This map is based upon the Ordnance Survey on behalf of the Controller of Her Majesty's Stationary Office. © Crown copyright. Unauthorised reproduction infringes Crown copyright and may lead to prosecution or civil proceedings. London Underground Ltd. Licence number 100032379 2009

Rev	Description	CHK	Date	Rev	Description	CHK	Date
				Z02	LU COMMENTS INCORPORATED	VLJ	12/11/14
				Z01	LU COMMENTS INCORPORATED	VLJ	09/10/14
				00	AS BUILT ISSUE	VLJ	05/09/13

Client:

LONDON UNDERGROUND

Project:

METROPOLITAN LINE POWER UPGRADE PACKAGE 1A

Enterprise

28 Bridge Road East, Welwyn Garden City Hertfordshire, AL7 1HX

TEL: +44(0)1707 292 200 email:info@enterprise.plc.uk

FAX: +44(0)1772 818 068 www.enterprise.plc.uk

Drawing Status:

AS BUILT

Drawing Title:

LCS CODE: B104

ROUTE SUMMARY FOR EXETER ROAD SUBSTATION TO MARLBOROUGH ROAD SUBSTATION

Site:

CABLE ROUTE FOR F749, F750, P2009 & P2013


Scale:	Drawn By:	CHK By:	Date:
1:1000 @A3	ST	VLJ	05/09/13

Drawing Number:

LUA-24-6102

REV:

Z02

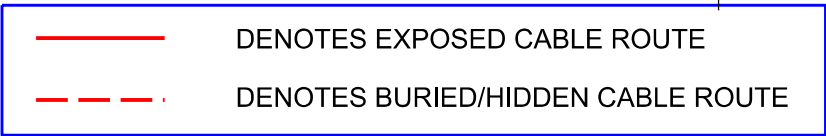


NOTE:

1. ALL DIMENSIONS ARE IN METRES UNLESS OTHERWISE NOTED

2. FOR SECTION DETAILS REFER TO DWG. Nos. LUA-24-6103/A.

3. CONCESSION CR 821X "SHEATH MARKING AND CORE IDENTIFICATION"

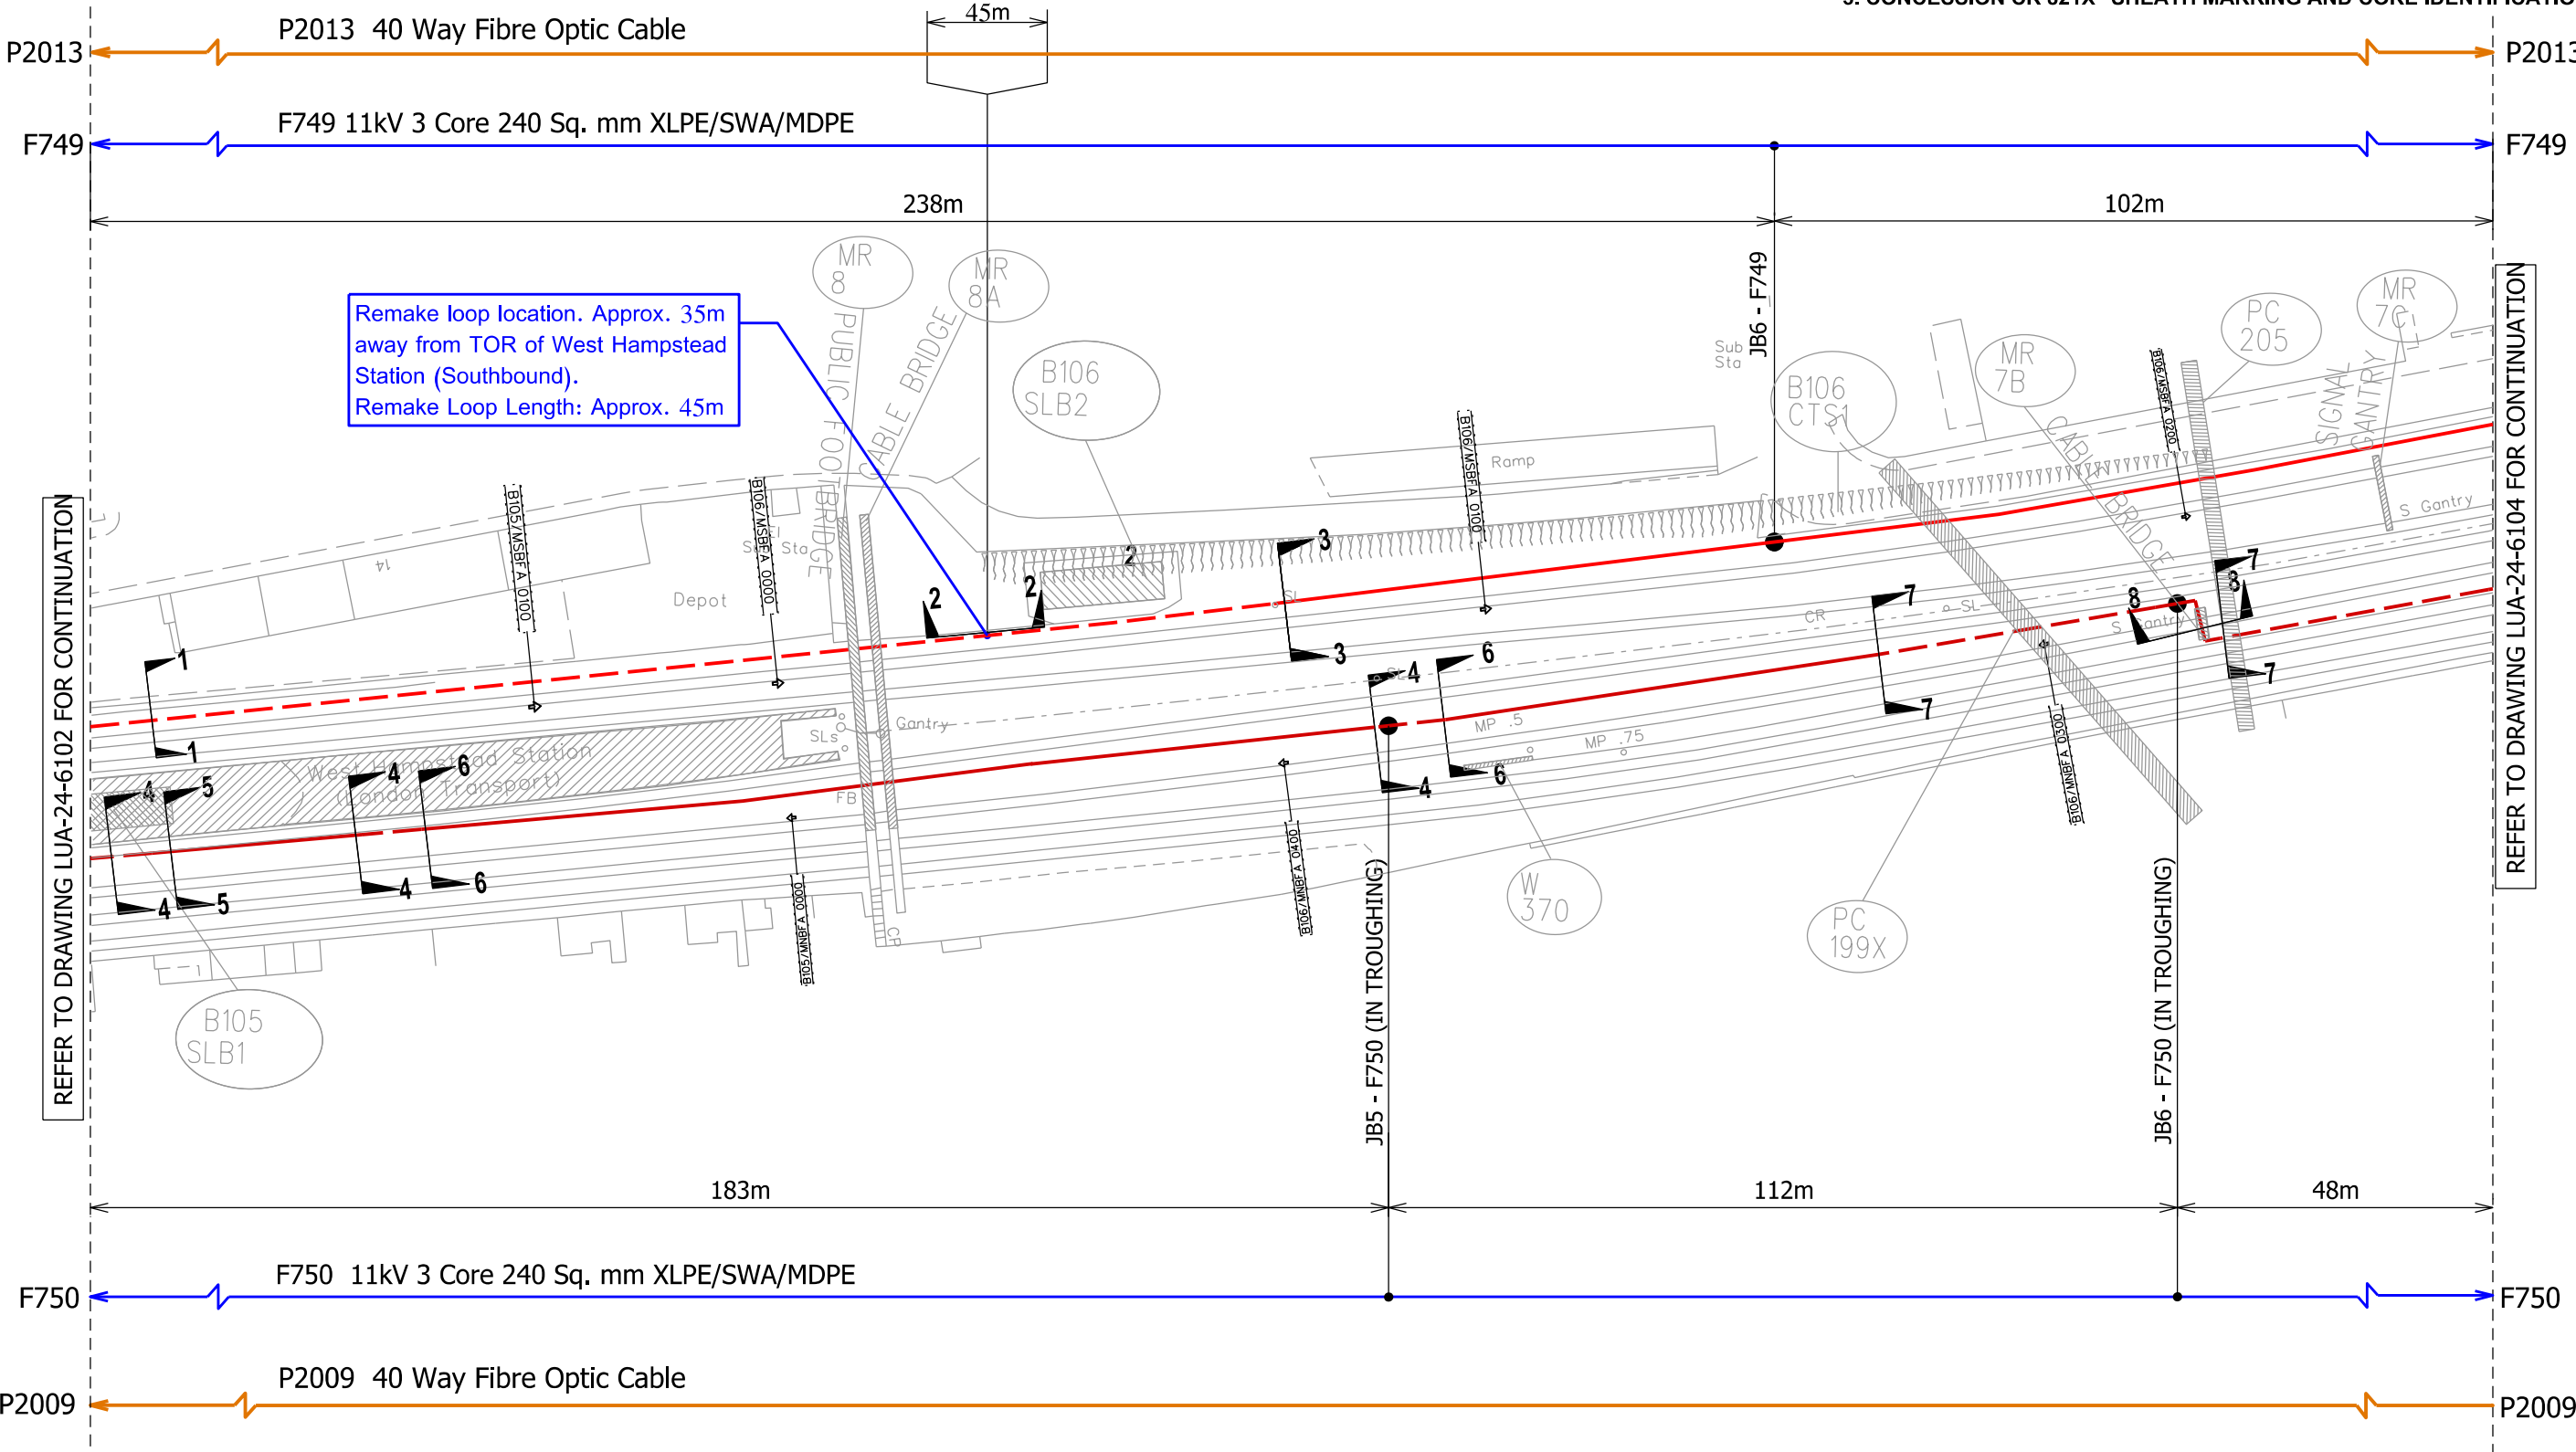

OS Reference

Where applicable: This map is based upon the Ordnance Survey on behalf of the Controller of Her Majesty's Stationary Office. © Crown copyright. Unauthorised reproduction infringes Crown copyright and may lead to prosecution or civil proceedings. London Underground Ltd. Licence number 100032379 2009

Rev	Description	CHK	Date

Z02	LU COMMENTS INCORPORATED	VLJ	12/11/14
Z01	LU COMMENTS INCORPORATED	VLJ	09/10/14
00	AS BUILT ISSUE	VLJ	05/09/13
Rev	Description	CHK	Date

Client: LONDON UNDERGROUND

Project: METROPOLITAN LINE POWER UPGRADE PACKAGE 1A

Enterprise

28 Bridge Road East, Welwyn Garden City Hertfordshire, AL7 1HX

TEL: +44(0)1707 292 200 FAX: +44(0)1772 818 068

email: info@enterprise.plc.uk www.enterprise.plc.uk

Drawing Status: AS BUILT



Drawing Title: ROUTE SUMMARY FOR EXETER ROAD SUBSTATION TO MARLBOROUGH ROAD SUBSTATION

LCS CODE: B106

Site: CABLE ROUTE FOR F749, F750, P2009 & P2013

Scale: 1:1000 @A3	Drawn By: ST	CHK By: VLJ	Date: 05/09/13
Drawing Number: LUA-24-6103			REV: Z02



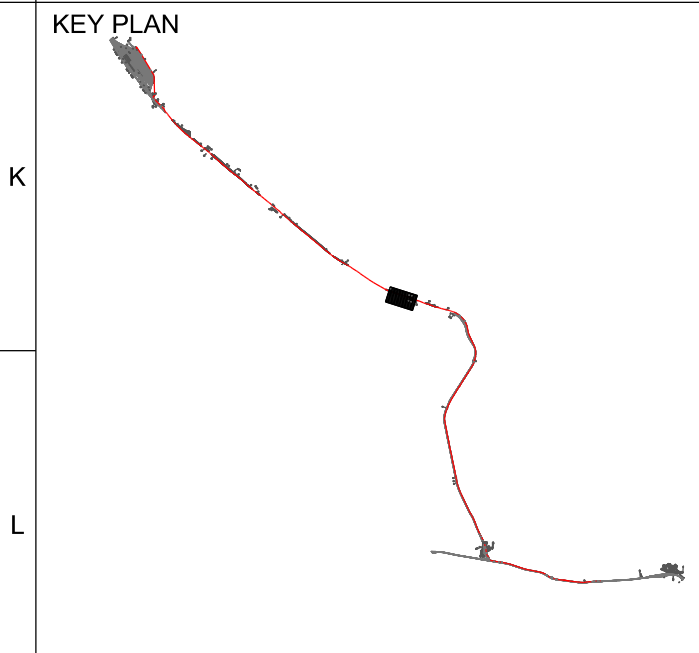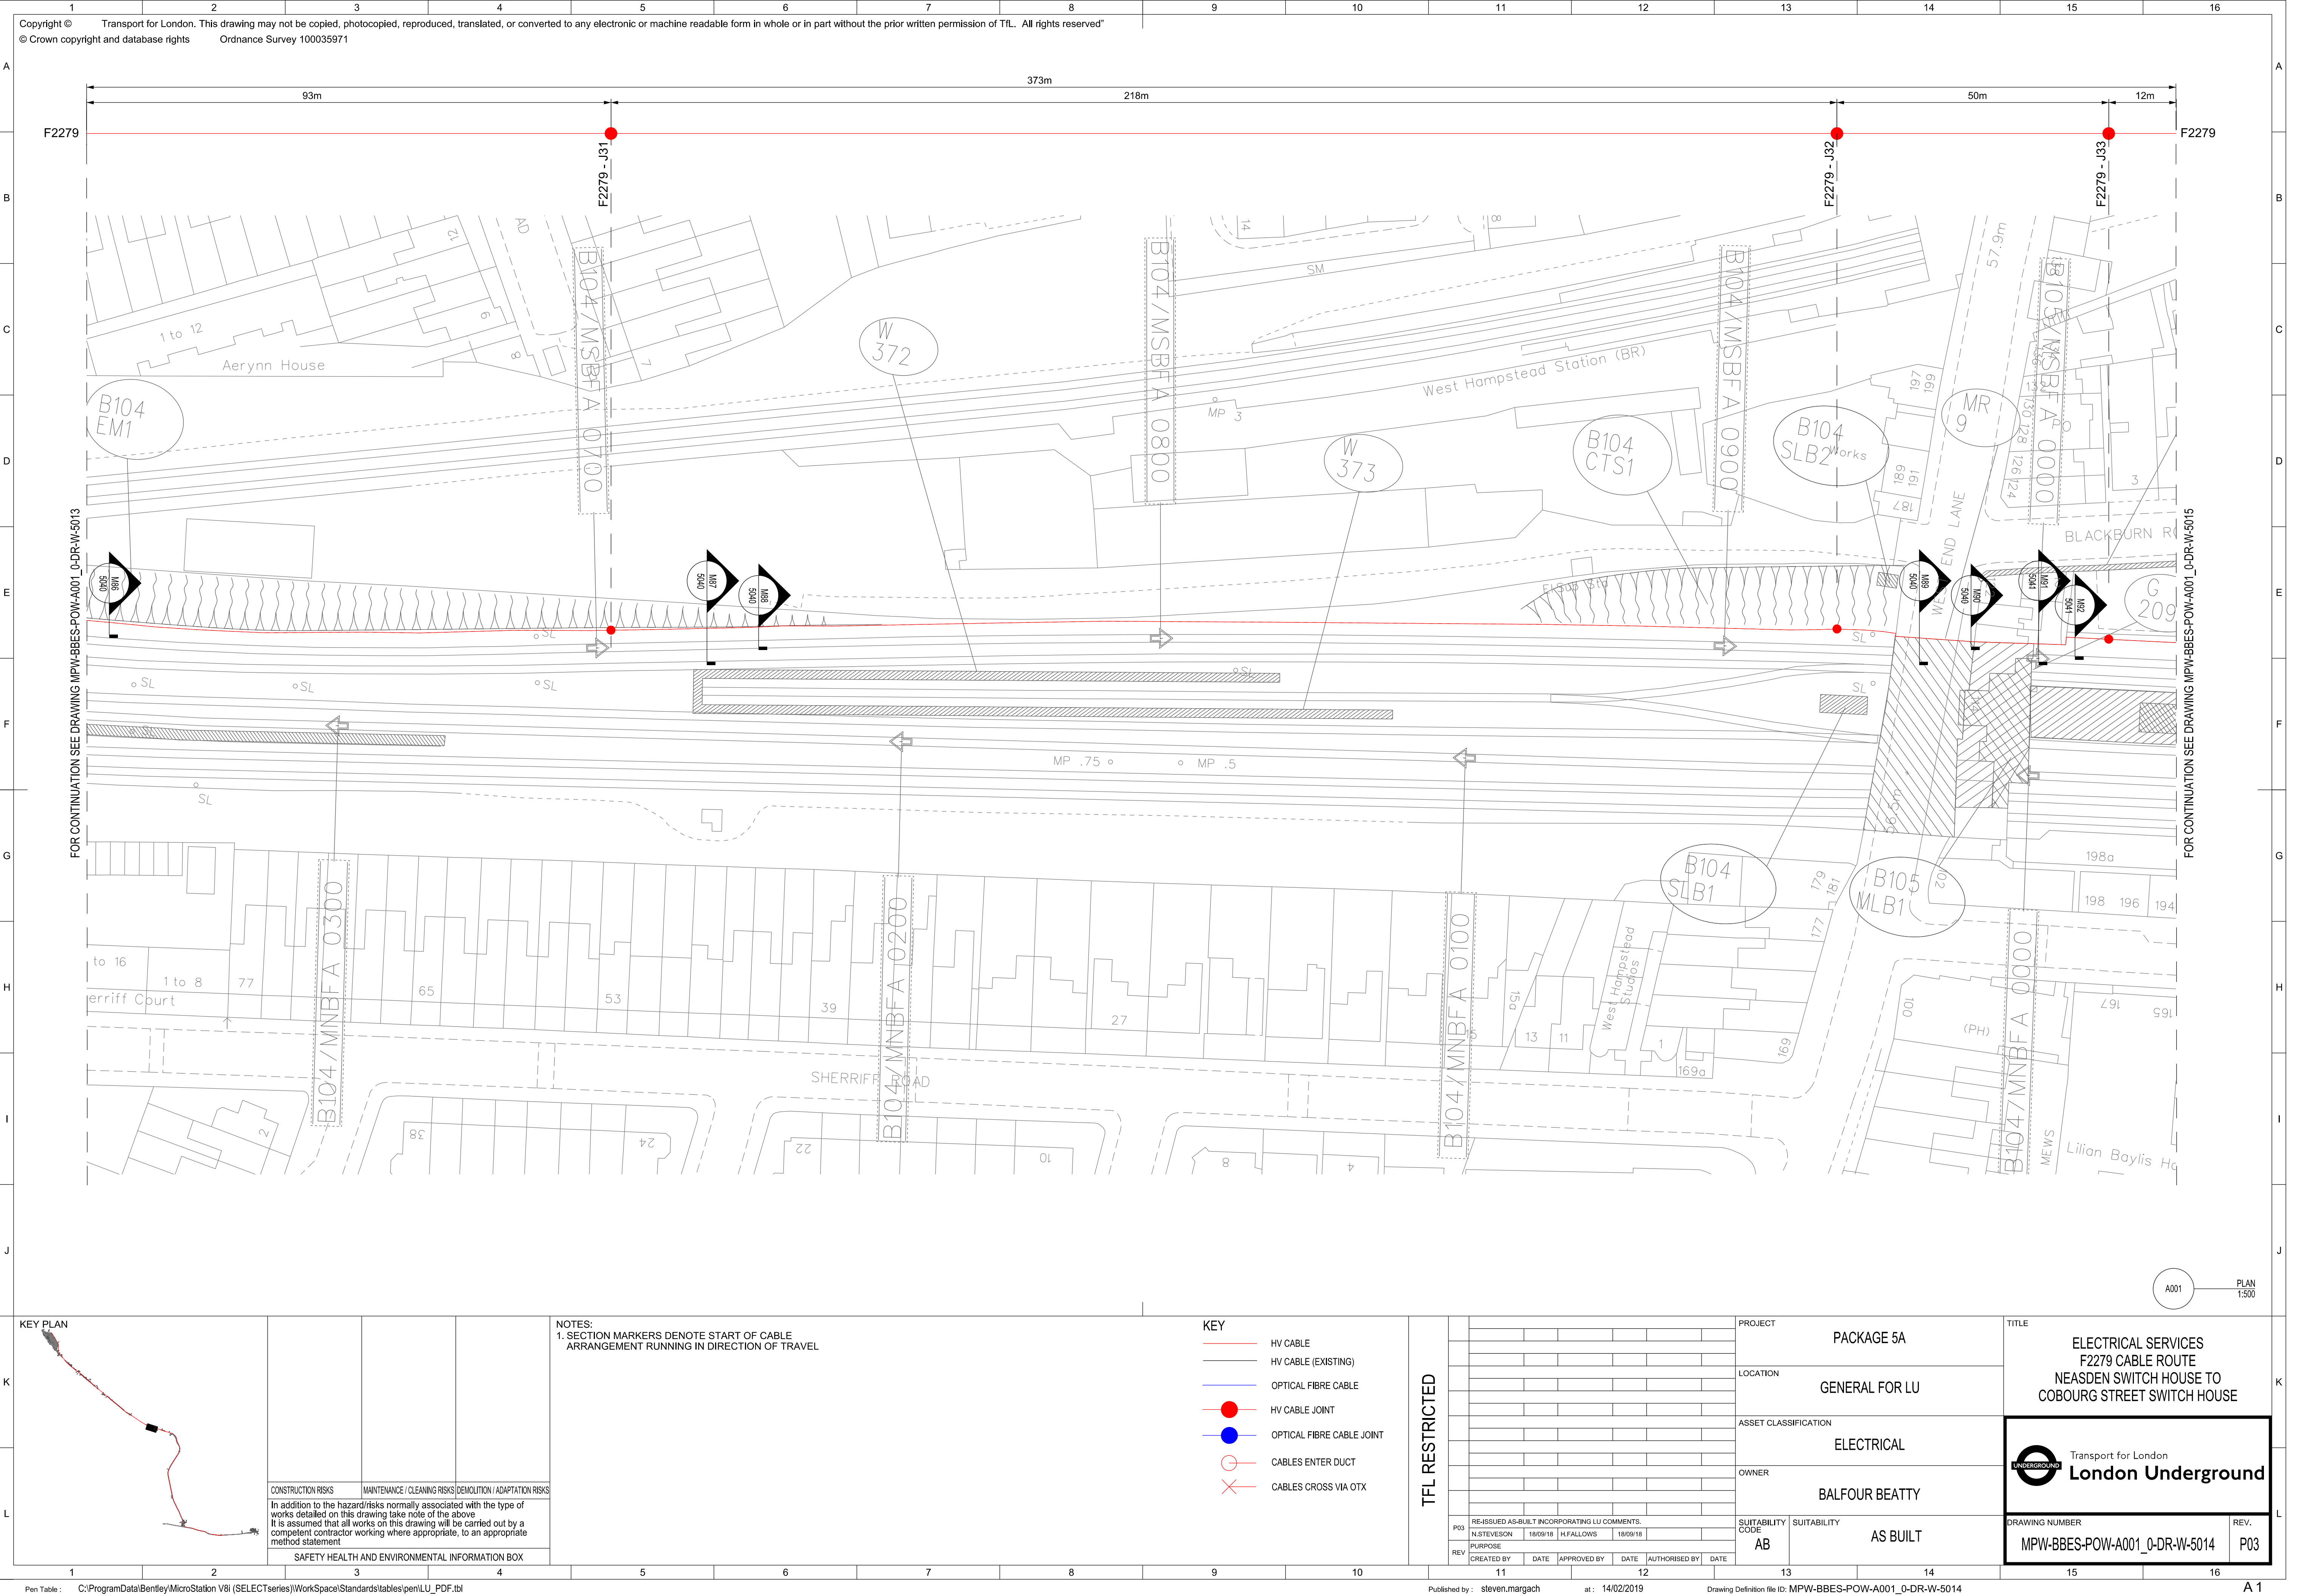

CONSTRUCTION RISKS	MAINTENANCE / CLEANING RISKS	DEMOLITION / ADAPTATION RISKS
In addition to the hazard/risks normally associated with the type of works detailed on this drawing take note of the above. It is assumed that all works on this drawing will be carried out by a competent contractor working where appropriate, to an appropriate method statement.		
SAFETY HEALTH AND ENVIRONMENTAL INFORMATION BOX		

NOTES:  
1. SECTION MARKERS DENOTE START OF CABLE ARRANGEMENT RUNNING IN DIRECTION OF TRAVEL

- KEY
- HV CABLE
  - HV CABLE (EXISTING)
  - OPTICAL FIBRE CABLE
  - HV CABLE JOINT
  - OPTICAL FIBRE CABLE JOINT
  - CABLES ENTER DUCT
  - CABLES CROSS VIA OTX

TFL RESTRICTED			
REV	DATE	APPROVED BY	AUTHORISED BY
P03	18/09/19	H.FALLOWS	18/09/19
RE-ISSUED AS-BUILT INCORPORATING LU COMMENTS.			
PURPOSE			
CREATED BY			
DATE			
APPROVED BY			
DATE			

PROJECT	PACKAGE 5A
LOCATION	GENERAL FOR LU
ASSET CLASSIFICATION	ELECTRICAL
OWNER	BALFOUR BEATTY
SUITABILITY CODE	AS BUILT

TITLE

ELECTRICAL SERVICES  
F2279 CABLE ROUTE  
NEASDEN SWITCH HOUSE TO  
COBOURG STREET SWITCH HOUSE

Transport for London  
**London Underground**


DRAWING NUMBER

MPW-BBES-POW-A001\_0-DR-W-5014




REV.

P03



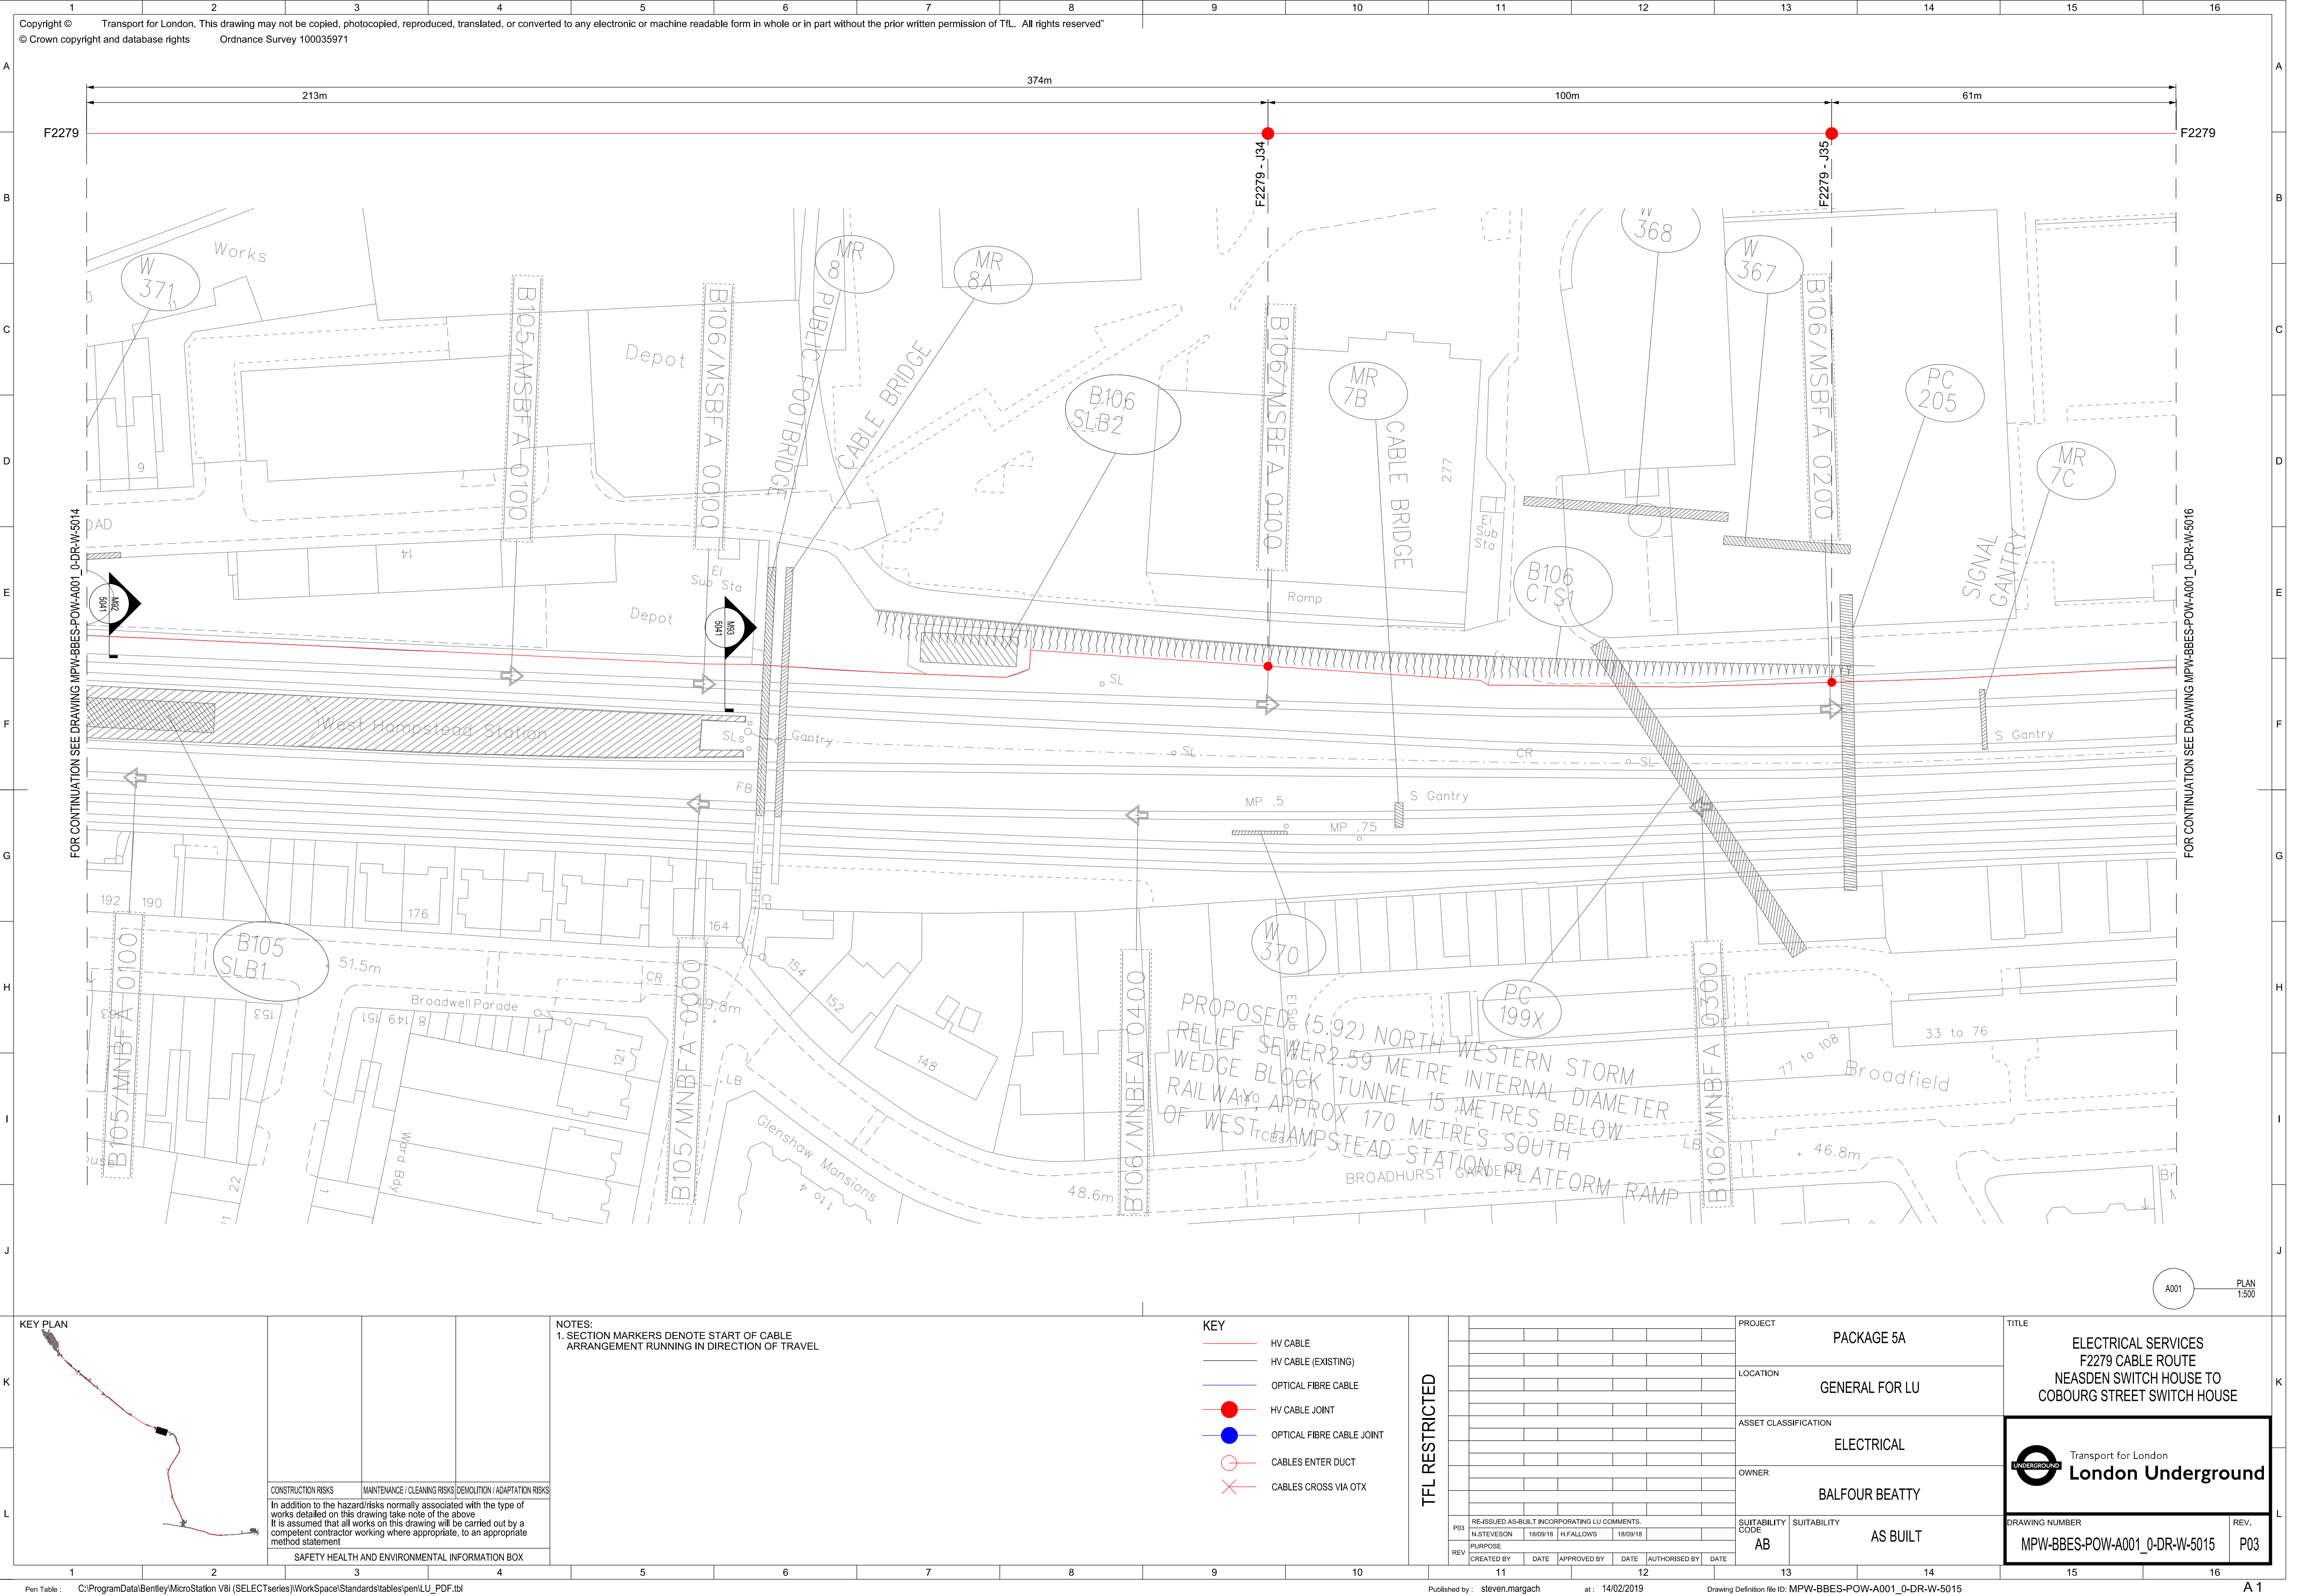

# R2511/14

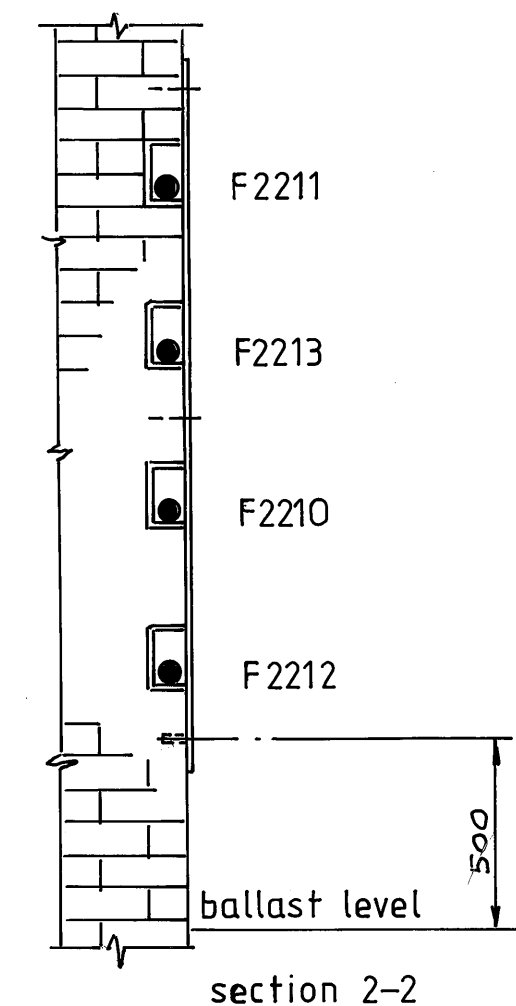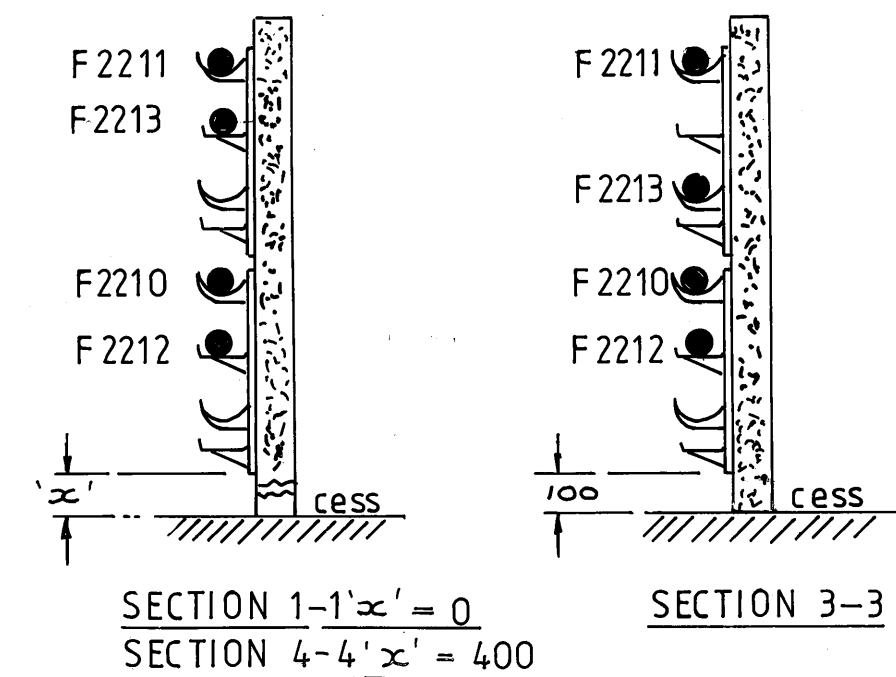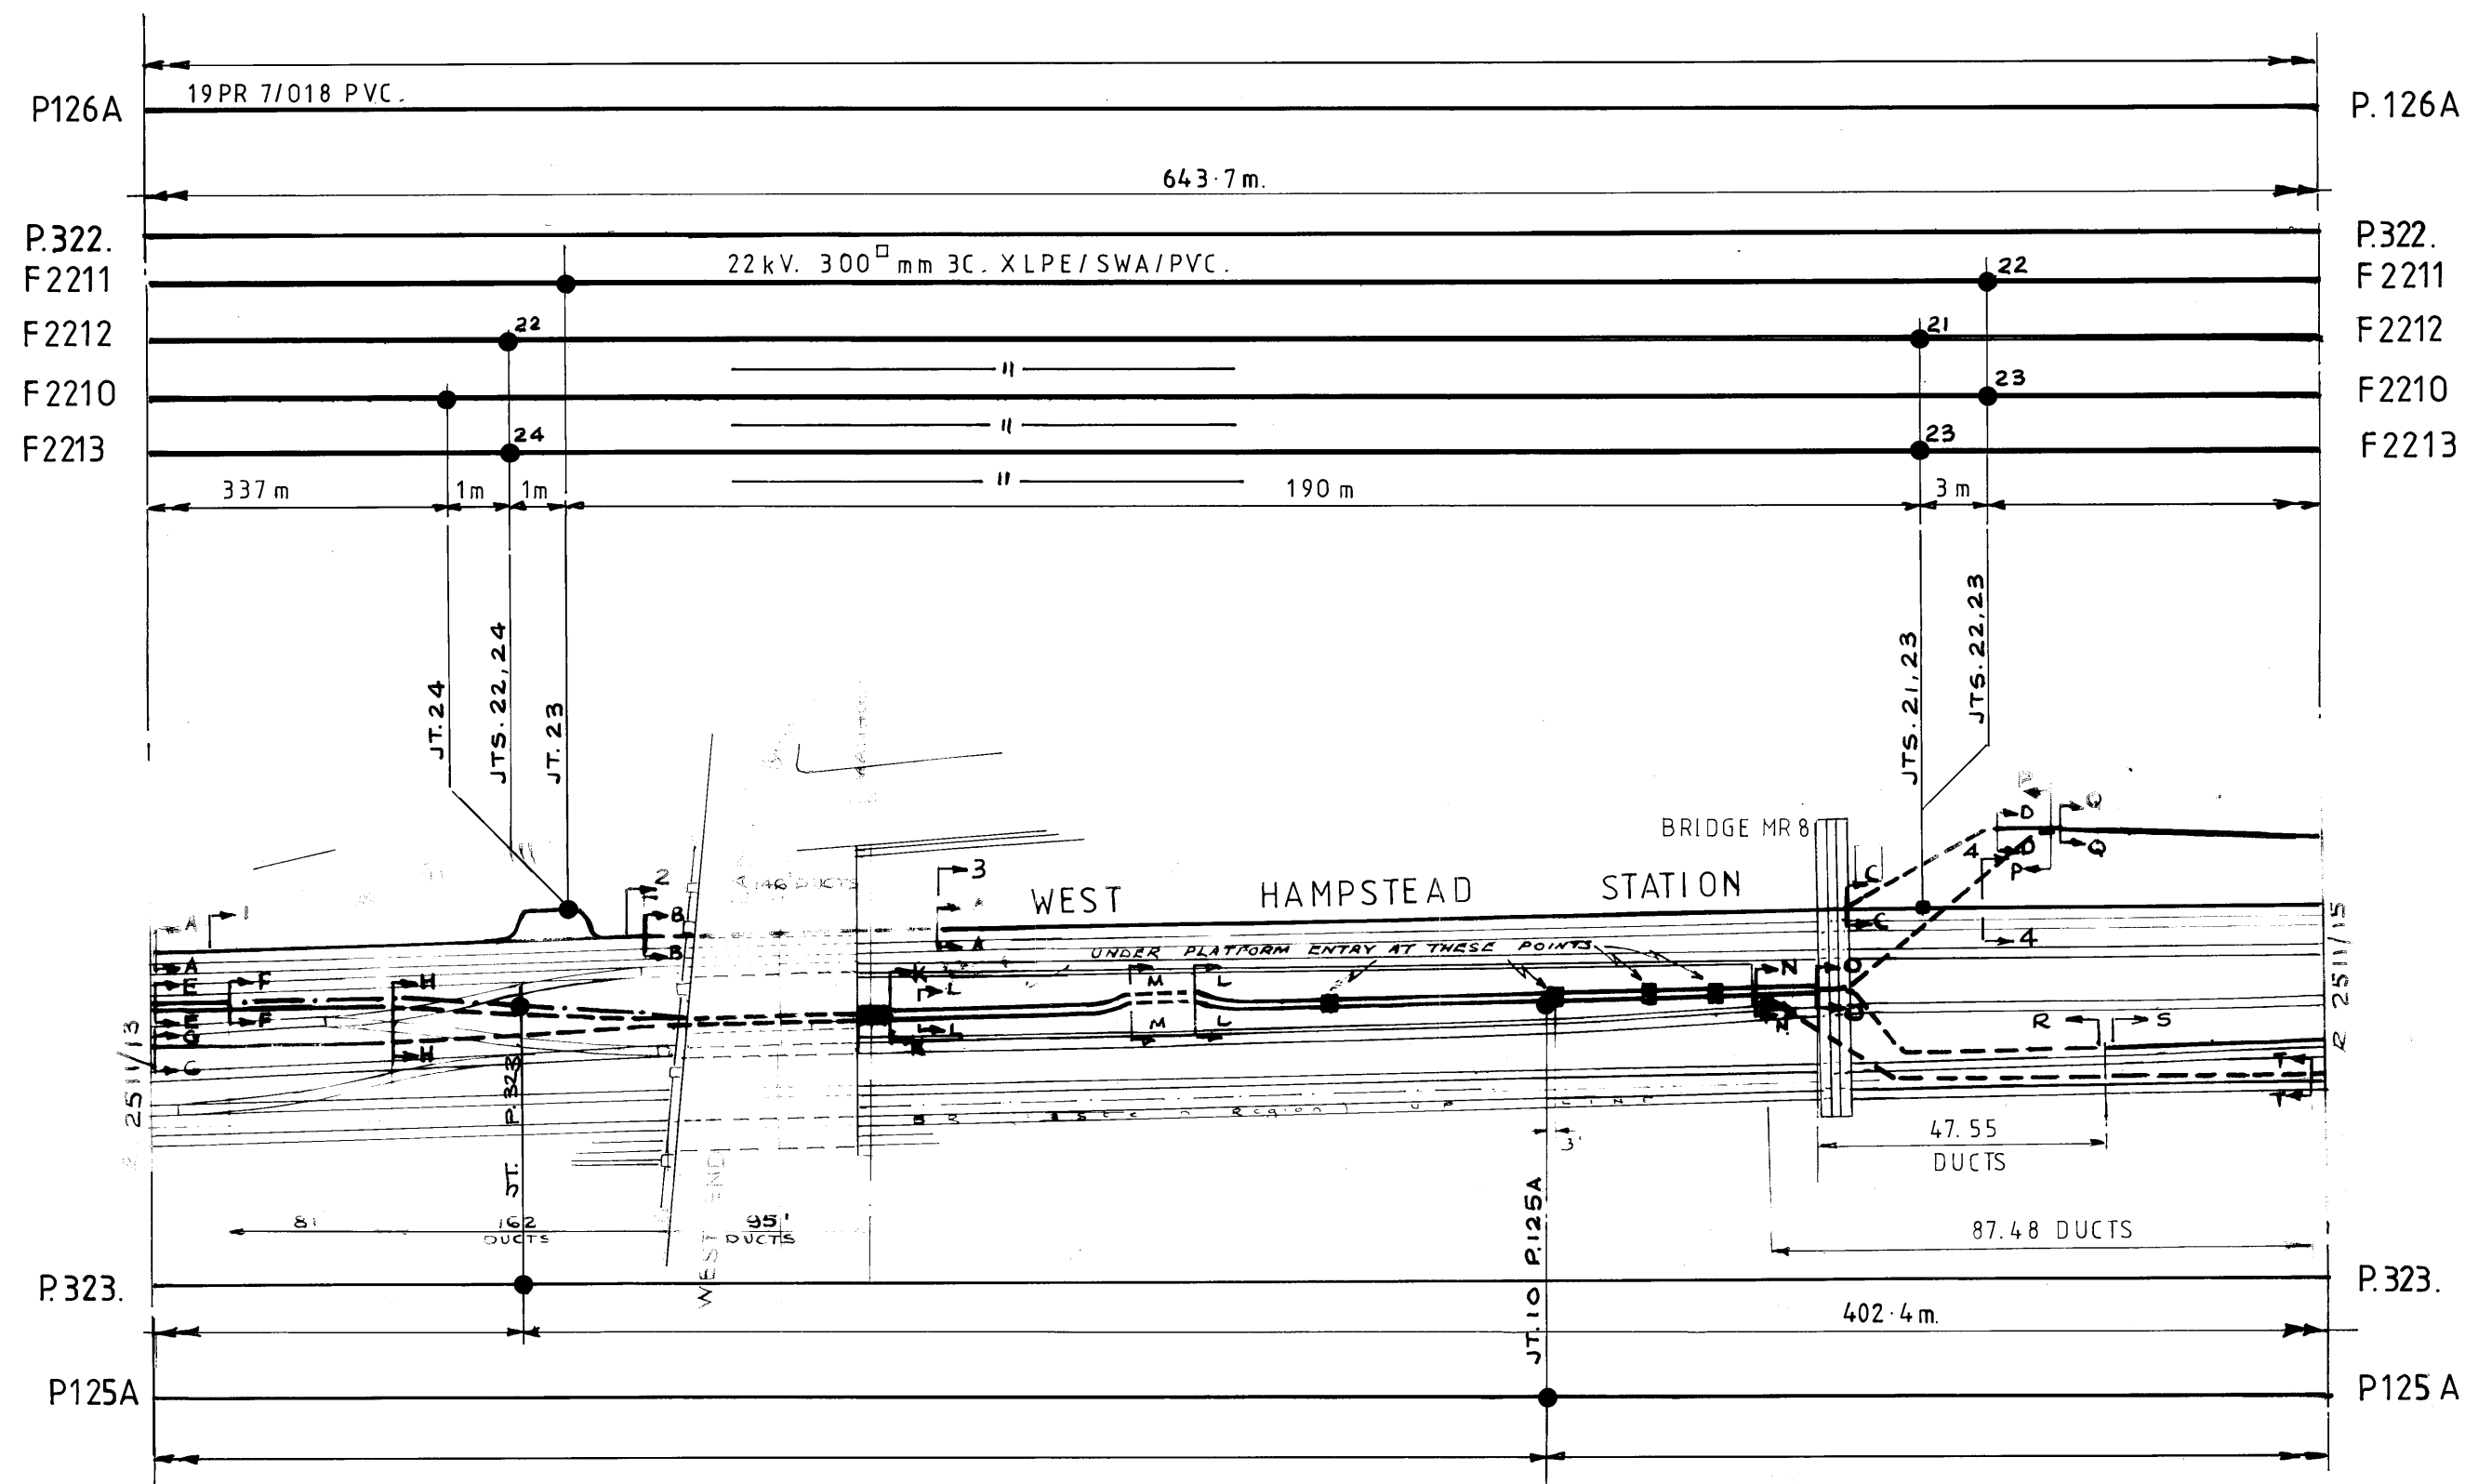

FOR CROSS SECTIONS SEE R2511/14A&B


8	6-9-93					
FDRS. 2210/11 2/3 ADDED.						
9	21/7/94					
Pilots P.322 & P.323 added. <i>pe</i>						

## METROPOLITAN LINE NEASDEN-BAKER STREET


Scale: 88'-0" = 1"	
Drawn: R. M.	LONDON UNDERGROUND Ltd. Electrical & Mechanical Eng. Generating Station Cottage, 10 Hoskins Street, London. SE10 9PB. Tel: 081 293 5548.
Checked:	
Approved: <i>RB</i>	
Date: 6-9-93	
Drg No: R2511/14	Rev: 9.




R2511/14A

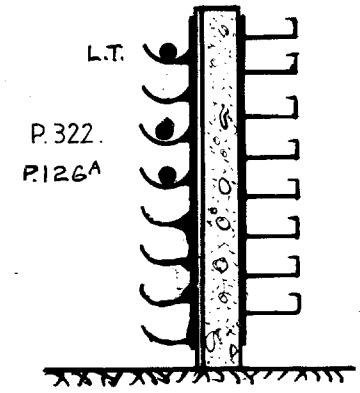


SECTION A-A

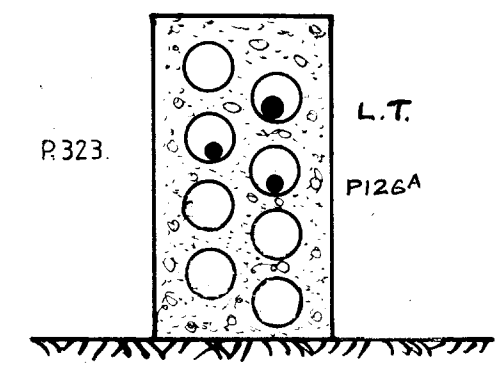


SECTION B-B

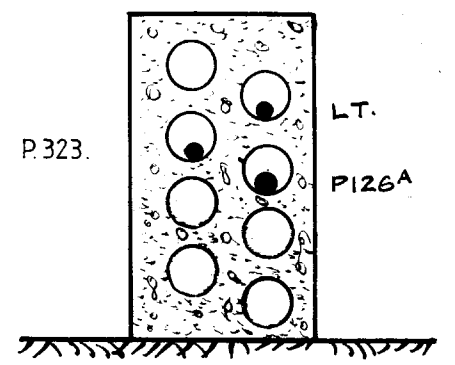


SECTION C-C

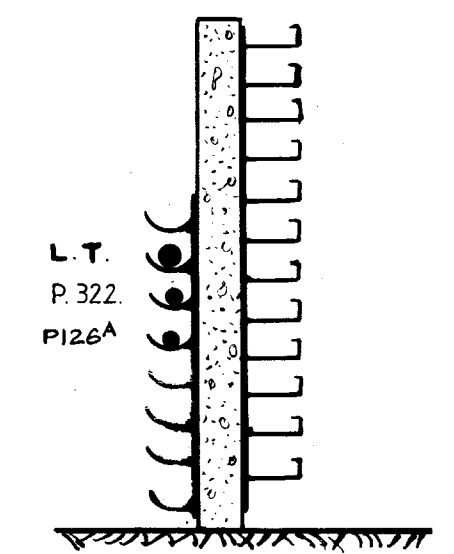


SECTION D-D

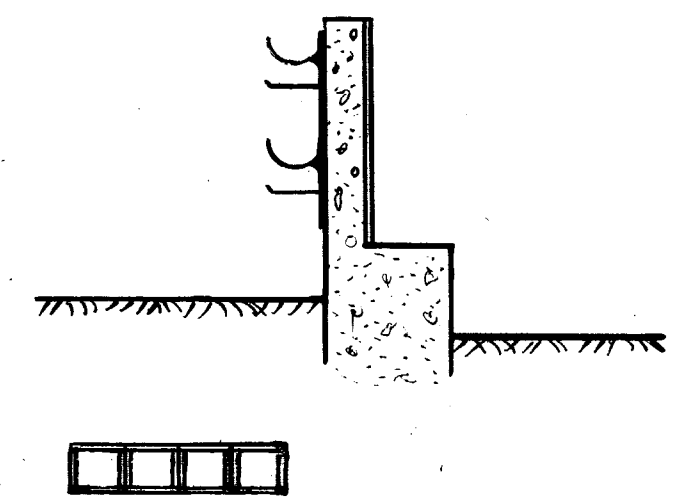


SECTION E-E

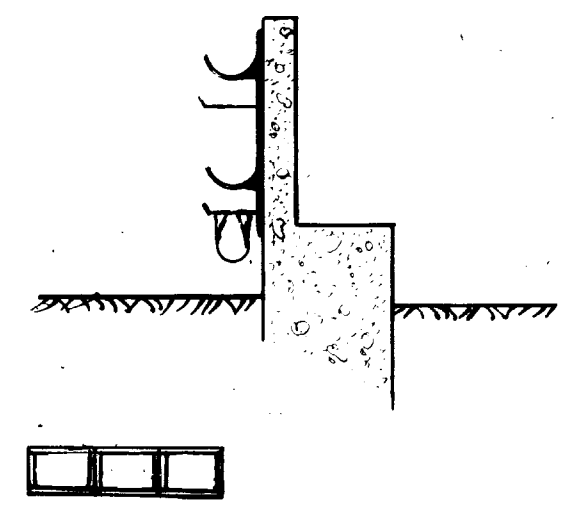


SECTION F-F

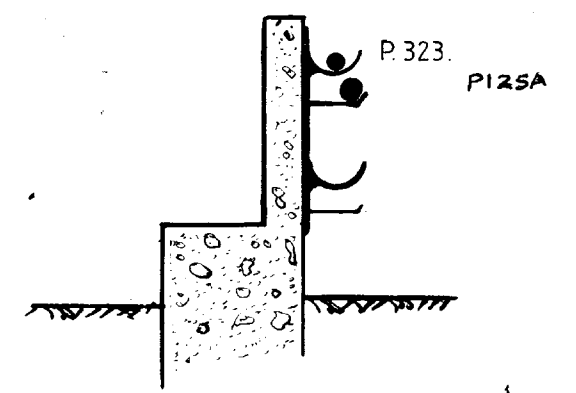


SECTION G-G

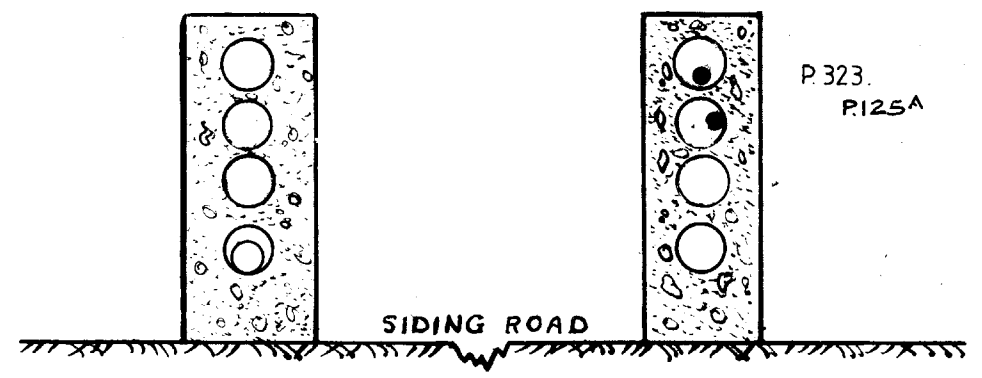


SECTION H-H

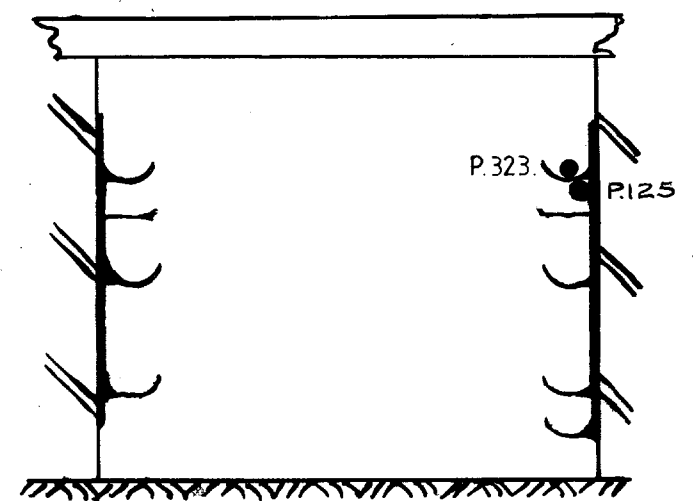


SECTION K-K

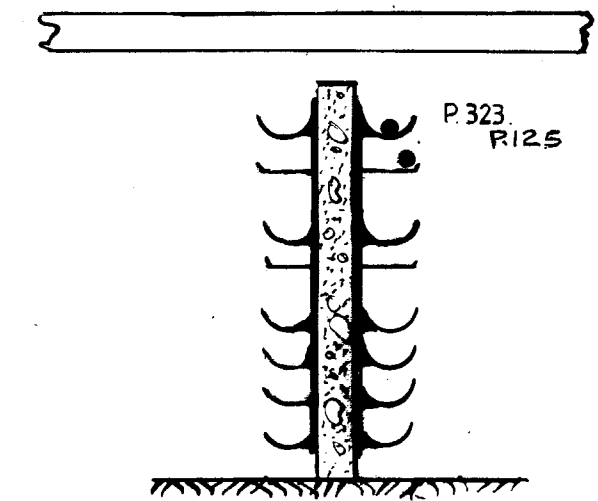


SECTION L-L

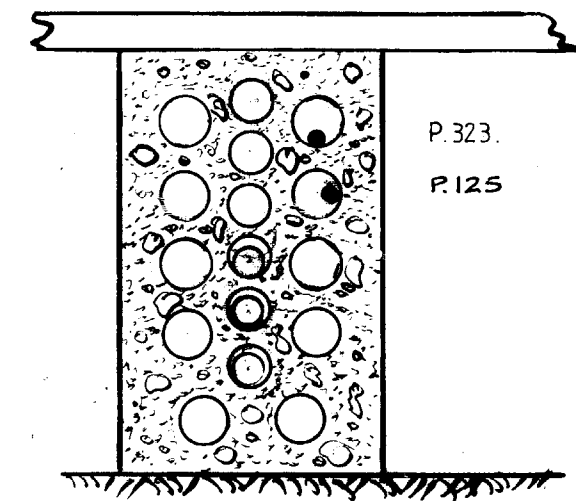

SECTION M-M

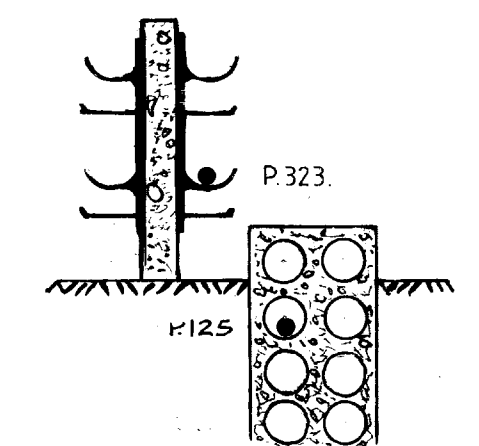

SECTION N-N

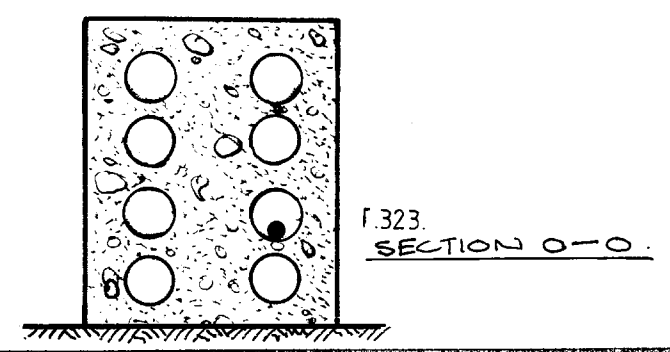

SECTION O-O


FOR ROUTE PLAN SEE R2511/14

1	18-1-62	3	4-7-68	5	16-8-91	7	13-9-94
Revised.	F.11, F.8, F.7, F.2, F.21 ALL O.O.S.	F.2266, F.2265, F.2264, F.2263 REMOVED.	P.322 & P.323 ADDED TO DRAWING-AR				
2	18-2-64	4	28-11-90	6	8-11-91		
P125A, P126A added.	formerly NO D2511/14A.	P.265, P.263, REMOVED-AR.					


METROPOLITAN LINE  
NEASDEN—BAKER STREET  
CABLE SECTIONS

SCALE :	
DRAWN: Ah.	LONDON UNDERGROUND Ltd.
CHECKED :	POWER & ELECTRICAL ENG.
APPROVED: [Signature]	139 Long Acre,
DATE: 16/5/91	London WC 2E 9AD.
No. R.2511/14a.	REV. 7...


R2511/14B

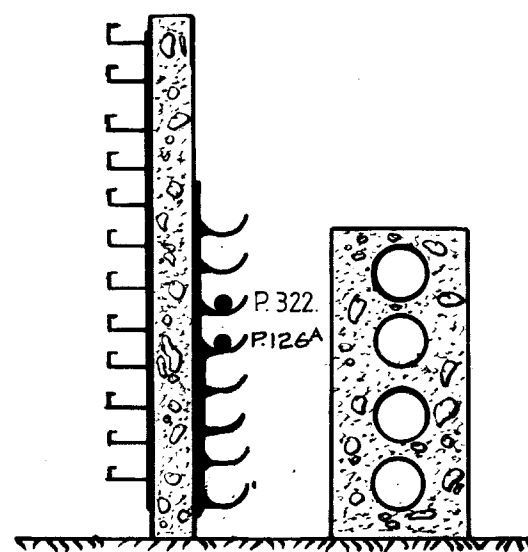


SECTION P-P

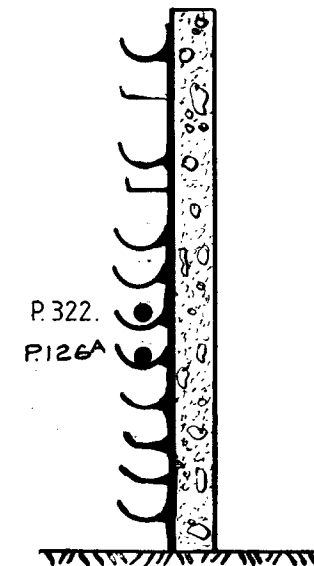


SECTION Q-Q

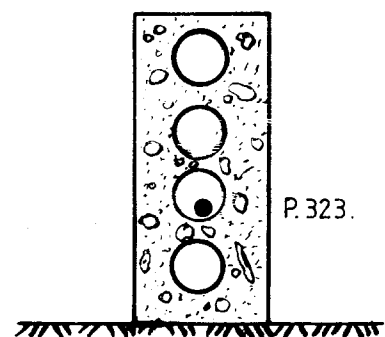

SECTION R-R

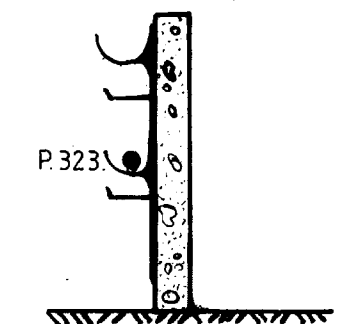

SECTION S-S

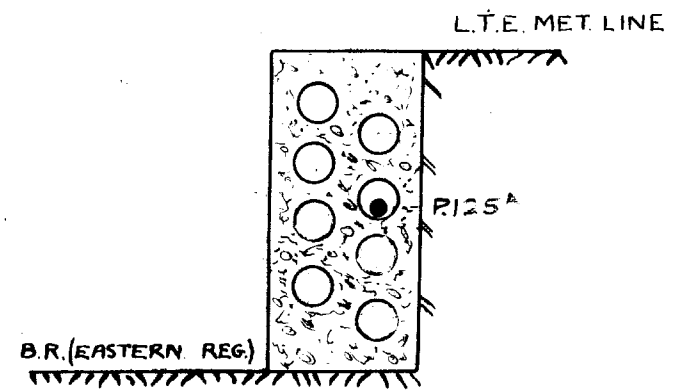

SECTION T-T

FOR ROUTE PLAN SEE R2511/14

1	18-1-62	3	4-7-68 <sup>AM</sup>	5	16-5-91	7	7-9-93		
Section T-T Added		F.21, F.11, F.8, F.7, AND F.2 AM O.O.S.		F.2266, F.2265 F.2264, F.2263 REMOVED.		DRG. NO. WAS R2511/14A1			
18-2-64 <sup>AM</sup>		4	28-11-90	6	8-11-91	8	13-9-94		
P.125A-P.126A added.		FORMERLY D.2511/14A1		P.265, P.263 REMOVED. <i>AR</i>		P.322 & P.323 ADDED TO DRAWING. <i>AR</i>			


METROPOLITAN LINE  
NEASDEN-BAKER STREET  
CABLE SECTIONS

SCALE :	
DRAWN: <i>AW</i>	LONDON UNDERGROUND Ltd.
CHECKED :	POWER & ELECTRICAL ENG.
APPROVED: <i>AB</i>	139 Long Acre,
DATE: 16/5/91	London WC 2E 9AD.
No R.2511/14 B	
REV.	8.


Client Maintenance Eng (Power).



MATCH LINE Drg. No. R2511/13C

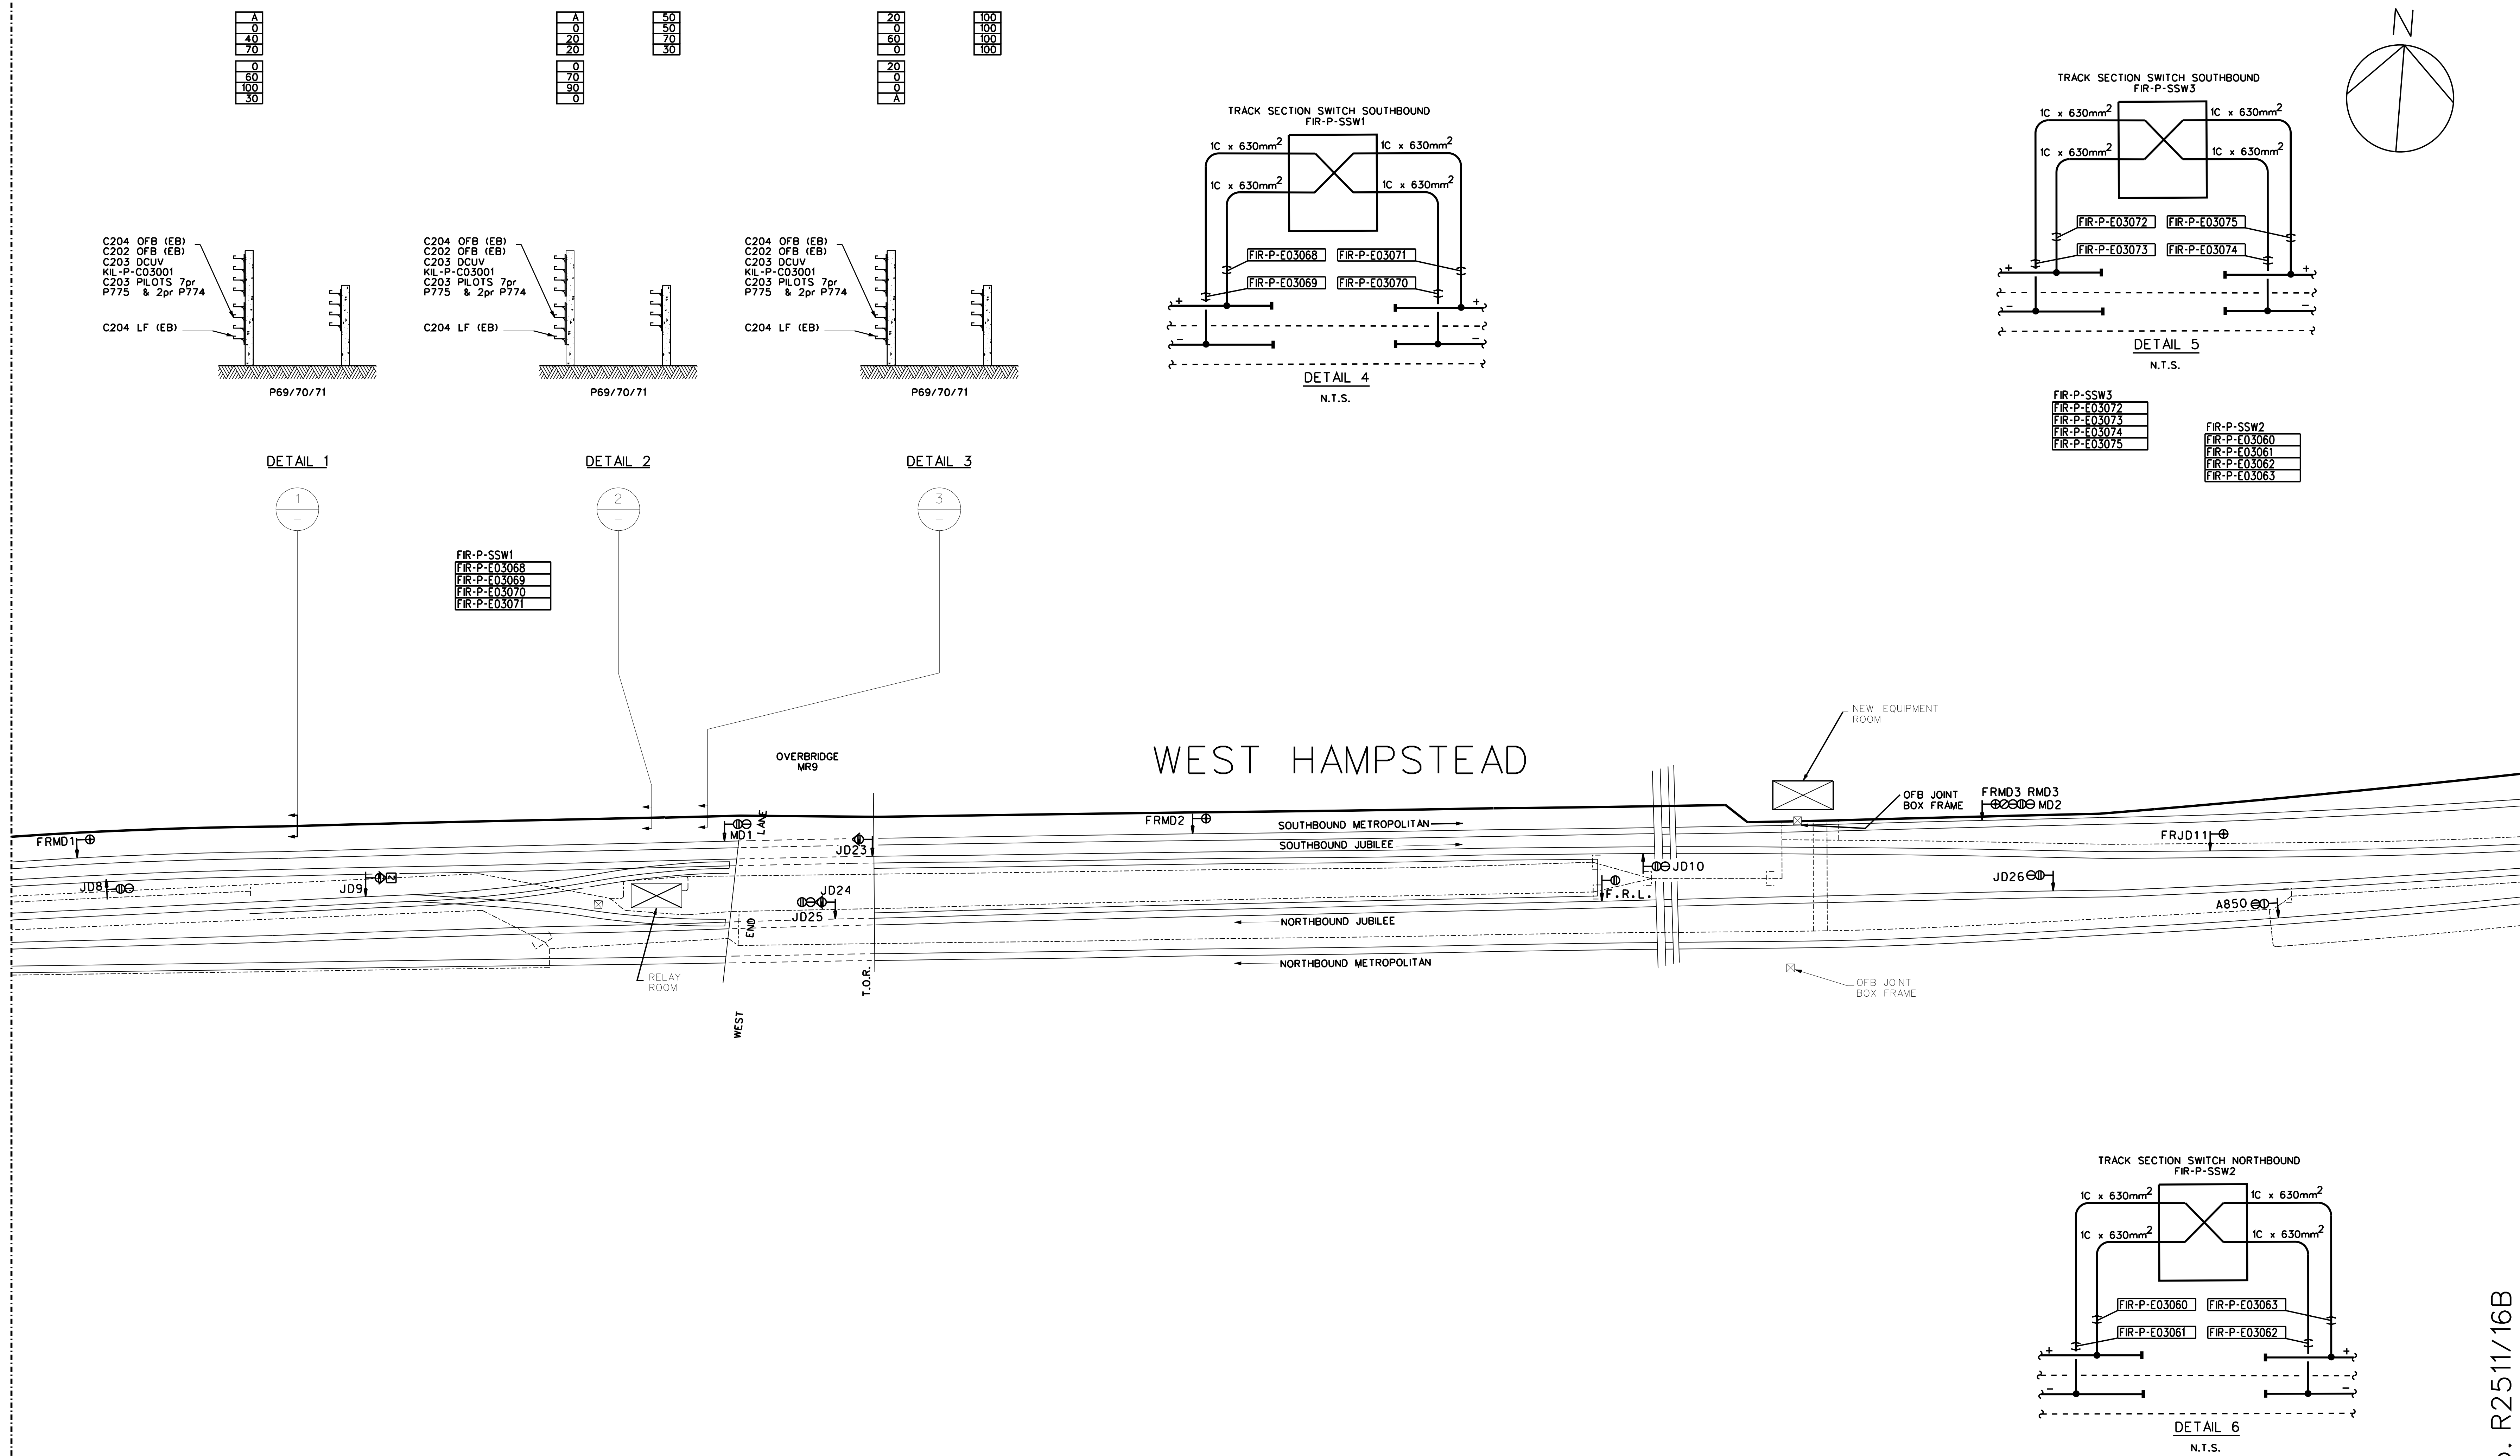

MATCH LINE Drg. No. R2511/16B

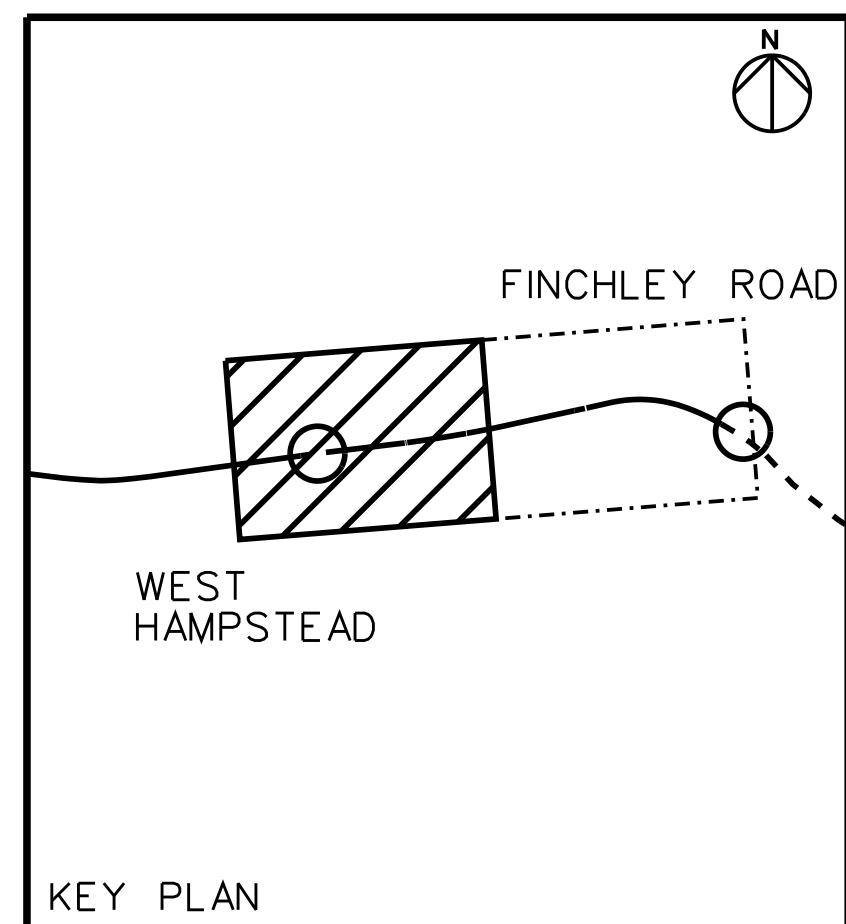

NOTES:-

1. AT SURFACE STATIONS REDUNDANT C202 AND C204 CABLES ARE PLACED ON BALATA STRAPS.
2. C202 ATP LEAKY FEEDER MOUNTED ON STAND OFF BRACKET IN CENTRE RUN.
3. DIMENSION NOTATION :-+/-+/-+/-  
THE FIRST DIGITS REFER TO THE HORIZONTAL POSITION OF THE CABLE FROM ZERO STOP OF RAMP. THE SECOND DIGITS REFER TO THE VERTICAL POSITION OF THE POST ROUTE (TAKEN FROM THE INSIDE OF THE RUNNING RAIL) ALL DIMENSIONS ARE IN METRE.
4. EXISTING SOUTHBOUND LINE (SB) HAS BECOME JUBILEE LINE EASTBOUND (EB).
5. EXISTING NORTHBOUND LINE (NB) HAS BECOME JUBILEE LINE WESTBOUND (WB).
6. MINIMUM SEPARATION BETWEEN C202 AND C204 LF IS 250mm.
7. WHERE C202 OR C204 LF CABLES ARE ALLOCATED TO FULL BRACKETS THE LF IS PLACED IN STAND-OFF CLIPS.

KEY: ☒ OFB JOINT BOX

NEW CABLE ROUTE(S)

EXISTING CABLE ROUTE(S)

A	BRACKET - SPARE CAPACITY
0	(SEE NOTE 6)
50	
100	

A - AIR MAIN (NO CAPACITY).

0 - NO CAPACITY (100% FULL).

50 - 50% CAPACITY.

100 - 100% CAPACITY - SEE NOTE 5

P69/  
T71/  
S20/  
S22/

- BRACKET POST OR CLEAT

TYPE/IDENTIFICATION NUMBER.

**LEGEND:-**

C202	—	CONTRACT 202 CABLES.
C203 DCUV	—	CONTRACT 203 DC UNDERVOLTAGE CABLES
C203 PILOTS	—	CONTRACT 203 PILOT CABLES.
C203 1KV	—	CONTRACT 203 1kV SC CABLES.
C204	—	CONTRACT 204 CABLES.
CER	—	COMMUNICATIONS EQUIPMENT ROOM.
S/S	—	SUBSTATION.
LF	—	LEAKY FEEDER LINE.
MC	—	MULTICORE CABLE.
LL	—	LOW LOSS COAX CABLE.
OFB	—	OPTICAL FIBRE BACKBONE.
PEP	—	PLATFORM EMERGENCY FLUNGER.
PIT	—	PLATFORM TO TRAC (CCTV).
SCC	—	SERVICE CONTROL CENTRE.
SER	—	SIGNALLING EQUIPMENT ROOM.
(EB)	—	EASTBOUND LINE (FUTURE).
(WB)	—	WESTBOUND LINE (FUTURE).


THIS DRAWING PREVIOUSLY  
KNOWN AS:  
203/B/35/22/201

<p>Confirmation of all survey data must be obtained from the Survey Section of the J.L.E.P.O.          All levels refer to J.L.E. Project Datum which is 100 metres below O.D.Newlyn          All measurements are in metres unless otherwise stated          All dimensions to be checked on site</p>										<p>where applicable, mapping is based upon          Ordnance Survey's digital 1:2500          map data with permission of the Controller          of Her Majesty's Stationery Office          (c) Crown copyright Ltd. "NA273066</p>										
B	04/03/07	DRAWING RENUMBERED & TITLE CHANGED																		
A	07-03-00	TRACK SECTION SWITCH DETAIL ADDED																		
-	31/07/98	AS FITTED																		
Rev.	Date	Description								By	Chkd	App	App							

<b>Jubilee Line Extension Project</b>
CEGELEC PROJECTS LIMITED

METROPOLITAN / JUBILEE LINE

Scale: 1:500	Date: 01:04:98	Drawn: PCCo	CAD File Name: t352220
-----------------	-------------------	----------------	---------------------------



London Underground Limited  
Jubilee Line Extension Project  
30 The South Colonnade  
London E14 5ET  
Tel 0171-599 4000

Ref:	Approved:
H14/W/35/22/201	
Checked:	Approved:

Drawing No:	Rev
R2511/14C	B

Our Ref: 36742219      428955

Tuesday, 25 March 2025

Bradley Inston  
Hadley Park East Hadley Park East

SHR  
TF1 6QJ

National Grid House  
Warwick Technology Park  
Gallows Hill, Warwick  
CV34 6DA

**Electricity Emergency Number:**  
**0800 40 40 90\***  
\*Available 24 hours, 7 days/week.  
Calls may be recorded and monitored.  
[www.nationalgrid.com](http://www.nationalgrid.com)

Asset Protection  
Gas Transmission  
National Grid  
Warwick  
Email: [assetprotection@nationalgrid.com](mailto:assetprotection@nationalgrid.com)

## National Grid Electricity – No Assets Affected

Dear Sir/ Madam,

An assessment has been carried out with respect to NGET apparatus and the proposed work location. Based on the search area entered in the LSBUD system for assessment the search area has been found to not affect any NGET apparatus.

Please note this response and any attached map(s) are valid for 28 days

Yours sincerely

**Asset Protection Team**

## Your Responsibilities and Obligations

It is your responsibility to ensure that the information you have submitted is accurate and that all relevant documents including links are provided to all persons (either direct labour or contractors) working for you near National Grid Electricity Transmission plc's apparatus, as legally required including under the Construction (Design and Management) Regulations 2015.


The assessment solely relates to the physical apparatus of National Grid Electricity Transmission plc (NGET)  
It does **NOT** cover:

- Apparatus owned by other people or organisations, e.g., Cadent, other gas distribution operators, local electricity companies, other utilities, landowners etc
- Apparatus owned by National Grid Gas plc.
- NGET's legal rights and interests (such as those contained in easements or wayleaves) in or concerning the land, which restrict activity in proximity to NGET's assets in private land. You must obtain details of any such restrictions from the landowner in the first instance and/or from HM Land Registry and/or you should seek legal advice. If in doubt, contact Asset Protection.






It is **YOUR** responsibility to consider whether any of the items or factors listed above may be present or relevant and if they could be affected by your proposed activities.

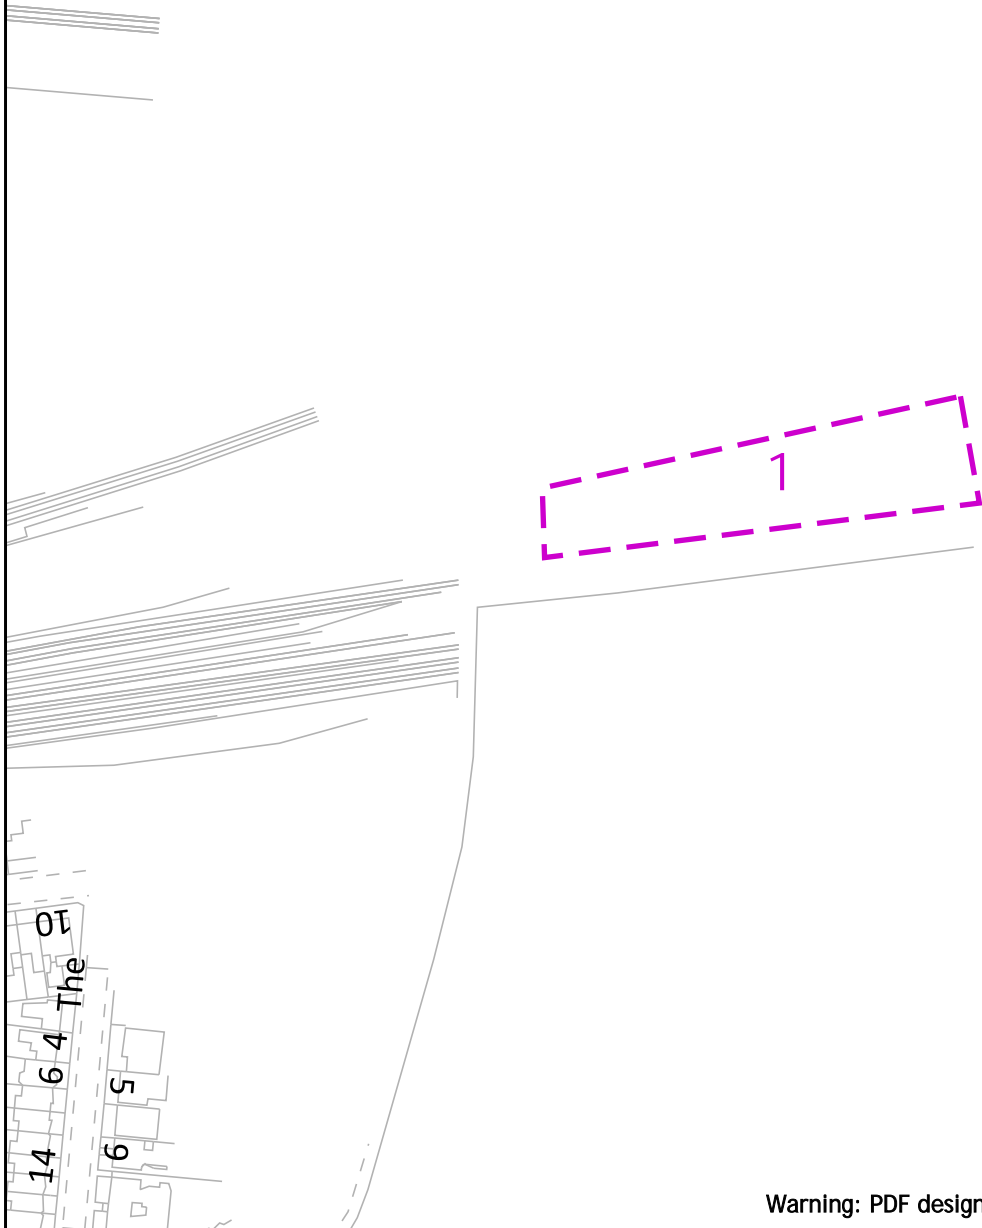NGET or its agents, servants or contractors do not accept any liability for any losses arising under or in connection with this information. This limit on liability applies to all and any claims in contract, tort (including negligence), misrepresentation (excluding fraudulent misrepresentation), breach of statutory duty or otherwise. This limit on liability does not exclude or restrict liability, which is prohibited by law, nor does it supersede the express terms of any related agreements.





Warning: PDF designed for A4 colour print only with no page scaling

<div data-bbox="55 1556 343 1624">nationalgrid</div> <div data-bbox="103 1668 303 1780">NationalGrid House Warwick Technology Park Gallows Hill Warwick CV34 6DA</div> <div data-bbox="63 1803 343 1825">AssetProtection@NationalGrid.com</div>	<div data-bbox="375 1579 1053 1608">0 200</div> <div data-bbox="1061 1556 1556 1624">EXTREME CAUTION - HIGH VOLTAGE **RISK OF DEATH OR SERIOUS INJURY**</div> <div data-bbox="422 1630 989 1825"><div>Dig Sites</div><div>Area:  Line: </div><div> Underground Cables</div><div> Overhead Lines</div><div> Fibre Cables</div></div>
<div data-bbox="55 1865 343 2004">Date Requested: 25/03/2025 Job Reference: 36742219 Site Location: 525651 184701 Requested by: Mr Bradley Inston Your Scheme/Reference: 428955</div> <div data-bbox="55 2157 343 2179">Scale: 1:2500 (When plotted at A4)</div>	<div data-bbox="375 1877 1556 2078"><b>IMPORTANT NOTICES</b> This plan shows those pipes owned by National Grid Electricity Transmission plc in its role as a Licensed Electricity Transporter (ET). Electricity cables owned by other ETs, or otherwise privately owned, may be present in this area. Information with regards to such cables should be obtained from the relevant owners. The information shown on this plan is given without warranty, the accuracy thereof cannot be guaranteed. Ancillary equipment such as cooling systems and communication cables are not shown but their presence should be anticipated. No liability of any kind whatsoever is accepted by National Grid Electricity Transmission plc or their agents, servants or contractors for any error or omission. Safe digging practices, in accordance with HS(G)47, must be used to verify and establish the actual position of cables and other apparatus on site before any mechanical plant is used. It is your responsibility to ensure that this information is provided to all persons (either direct labour or contractors) working for you on or near electricity apparatus. The information included on this plan should not be referred to beyond a period of 28 days from the date of issue.</div> <div data-bbox="683 2089 1248 2145"><b>National Grid Electricity Emergency Number: 0800 40 40 90</b> Available 24 hours, 7 days/week. Calls may be recorded and monitored</div> <div data-bbox="422 2168 1508 2179">Crown Copyright © - Reproduced by permission of Ordnance Survey on behalf of HMSO. And database right 2023. All rights reserved. Ordnance Survey Licence number 0100059731.</div>

# ENQUIRY SUMMARY

## Received Date

25/03/2025 11:37

## Work Start Date

26/03/2025

## Your Reference

428955

## Location

Centre Point: 525651 184701

X Extent:

Y Extent:

Postcode: NW6 3AY

## Map Options

Paper Size: A4

Orientation: PORTRAIT

Scale: 1:2500

Real World Extents: 145m x 53m

## Enquirer Details

Organisation Name: Apogee Property and Utility Consultants

Contact Name: Bradley Inston

Email Address: bradley.inston@apogeeutilityconsultants.co.uk

Telephone: 01952686570

Address: Hadley Park East Hadley Park East, , SHR, TF1 6QJ

## Enquiry Type

Initial Enquiry

## Activity Type

Utility Works

## Work Types

Multiple excavations site (1.5m or shallower)

## Notes/Works Description (if supplied)

## Site Contact Name (if supplied)

## Site Contact Number (if supplied)



## Location Search / C2 Utility Stats Searches

Our Network Asset Search platform will highlight where we may have plant or apparatus within the vicinity of the co-ordinates you enter.

It is important to note that the search result information provided is to be used as a guide only. To ensure safety during the activity, your organisation must follow HSG47 guidelines to locate any buried services in the vicinity and follow a safe system of work during the work activity.

Eastings X	525651
------------	--------

Northings Y	184701
-------------	--------

Project Reference	428955
-------------------	--------

Message/Comment

Submit

**Note:** Please search with a minimum of 5 digits to get the nearby Power network locations.

We have identified that we do not have any network assets within 500m of your searched location.

### Asset Search Disclaimer

Thank you for using Eclipse Power's Location asset search tool. Before you continue, kindly note the following advice:

This information is to be used solely for the purpose for which it was requested and the copyright and other intellectual property rights in all material on our website is owned by us and may not be reproduced, online or offline, without Eclipse Power Networks prior written consent.

Please ensure a full search of area required as the search parameters provide results within 500m only. Should you require a search covering a larger area e.g. 600m, please submit additional alternative reference points to fully cover the area of the plan.

Whilst Eclipse Power Networks takes all reasonable steps to ensure that the information available is correct, we do not guarantee the correctness nor completeness of material on this website as the material is supplied by others.

If Eclipse Power Networks suspects any wrongful or suspicious activity, we hold the right to remove accounts from the website and will require an appeal process for this to be rectified.